




33+75

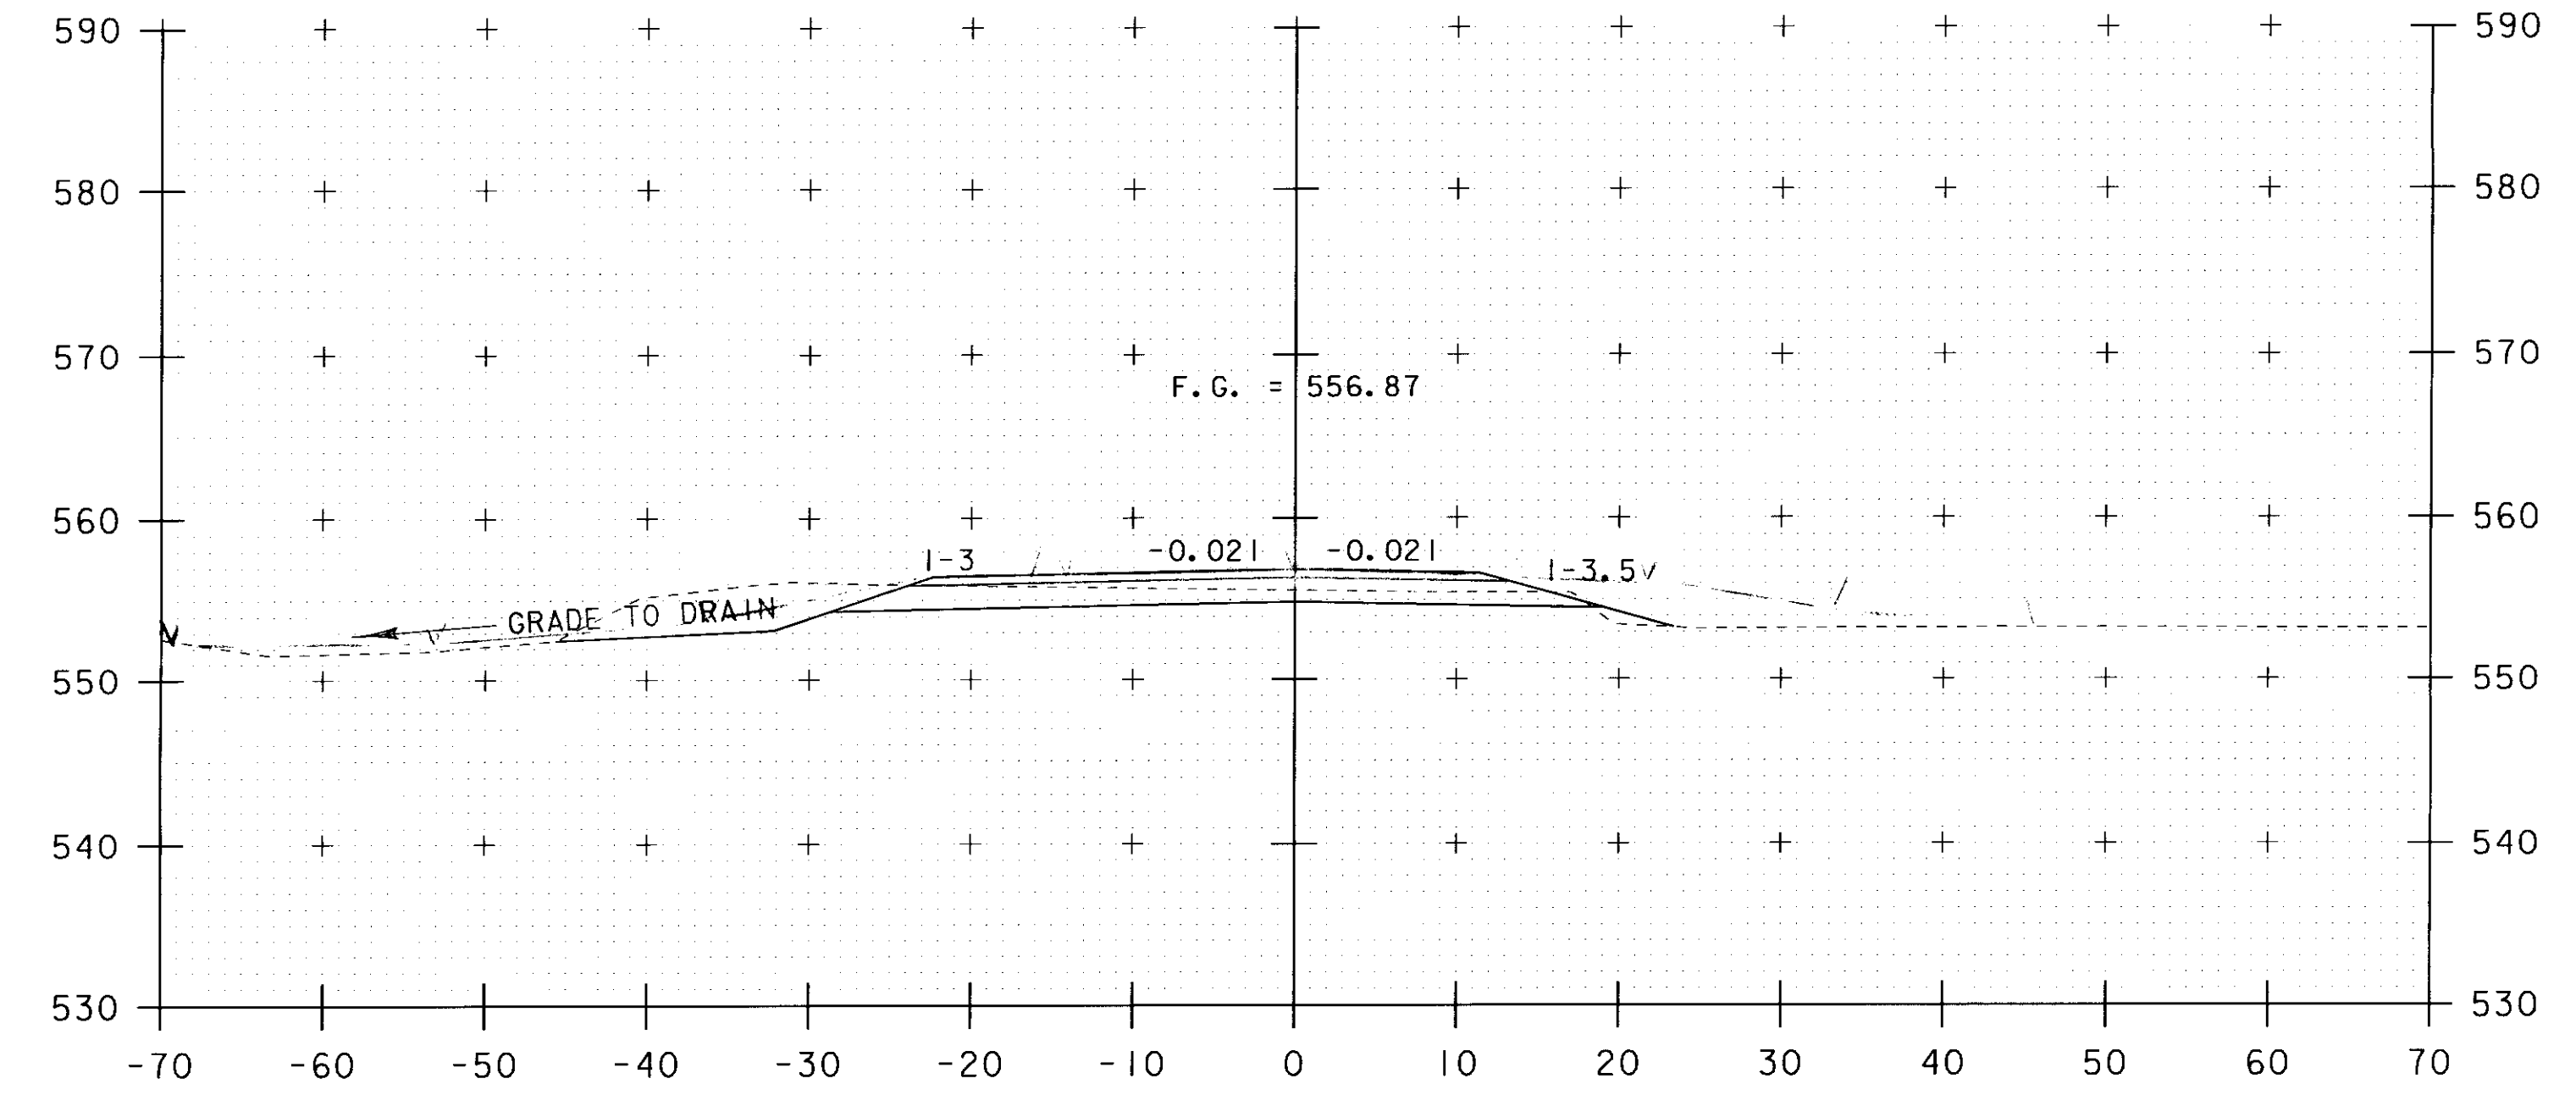

34+25
BEGIN PROJECT

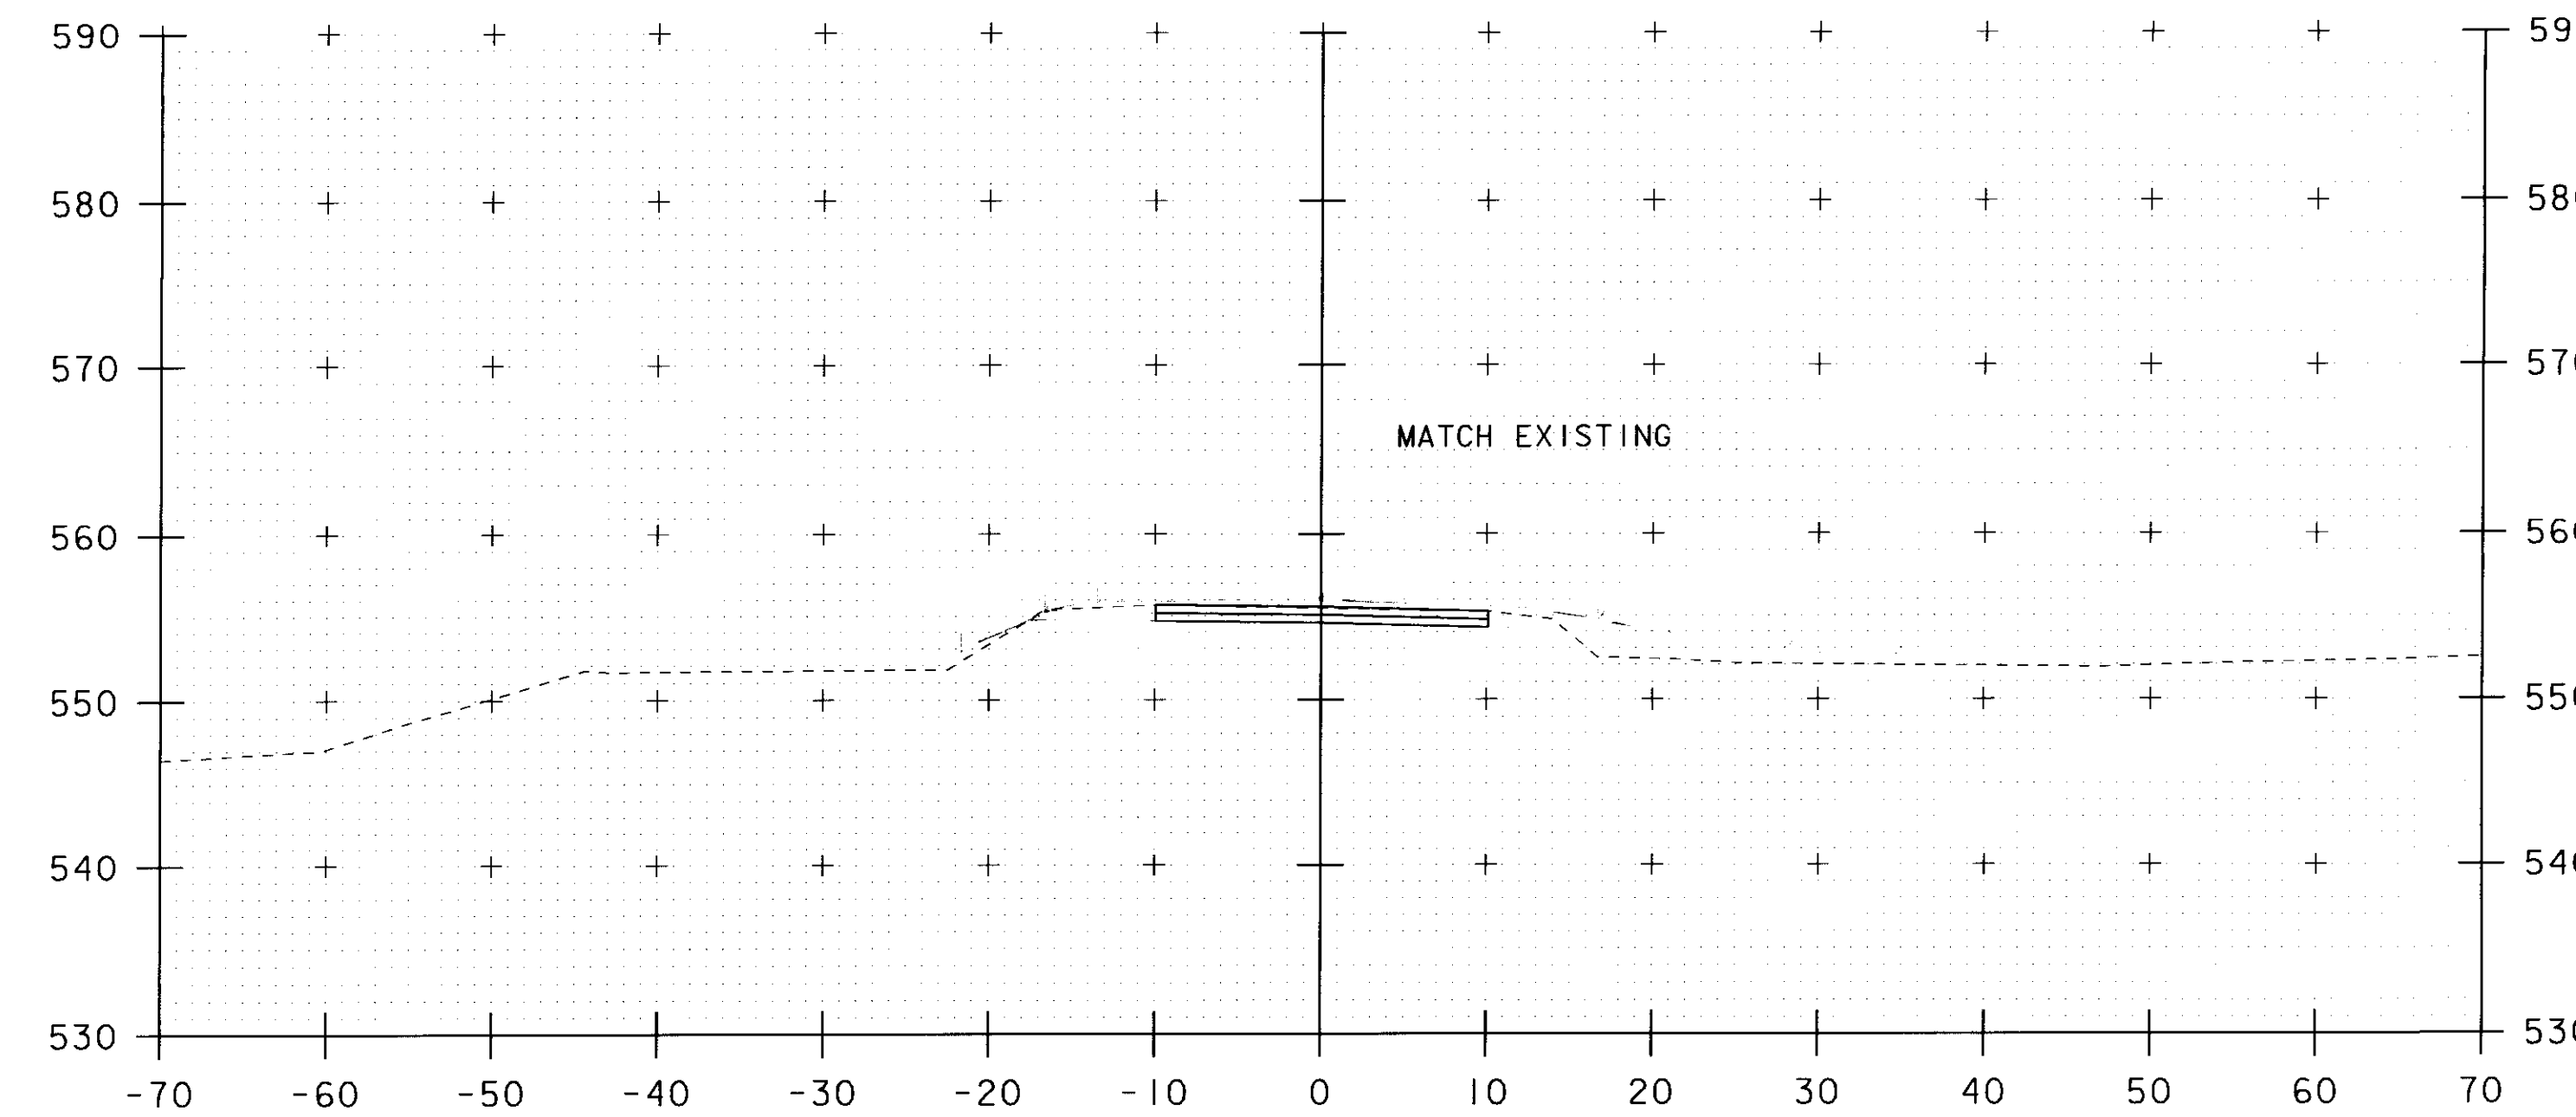

33+50
BEGIN APPROACH

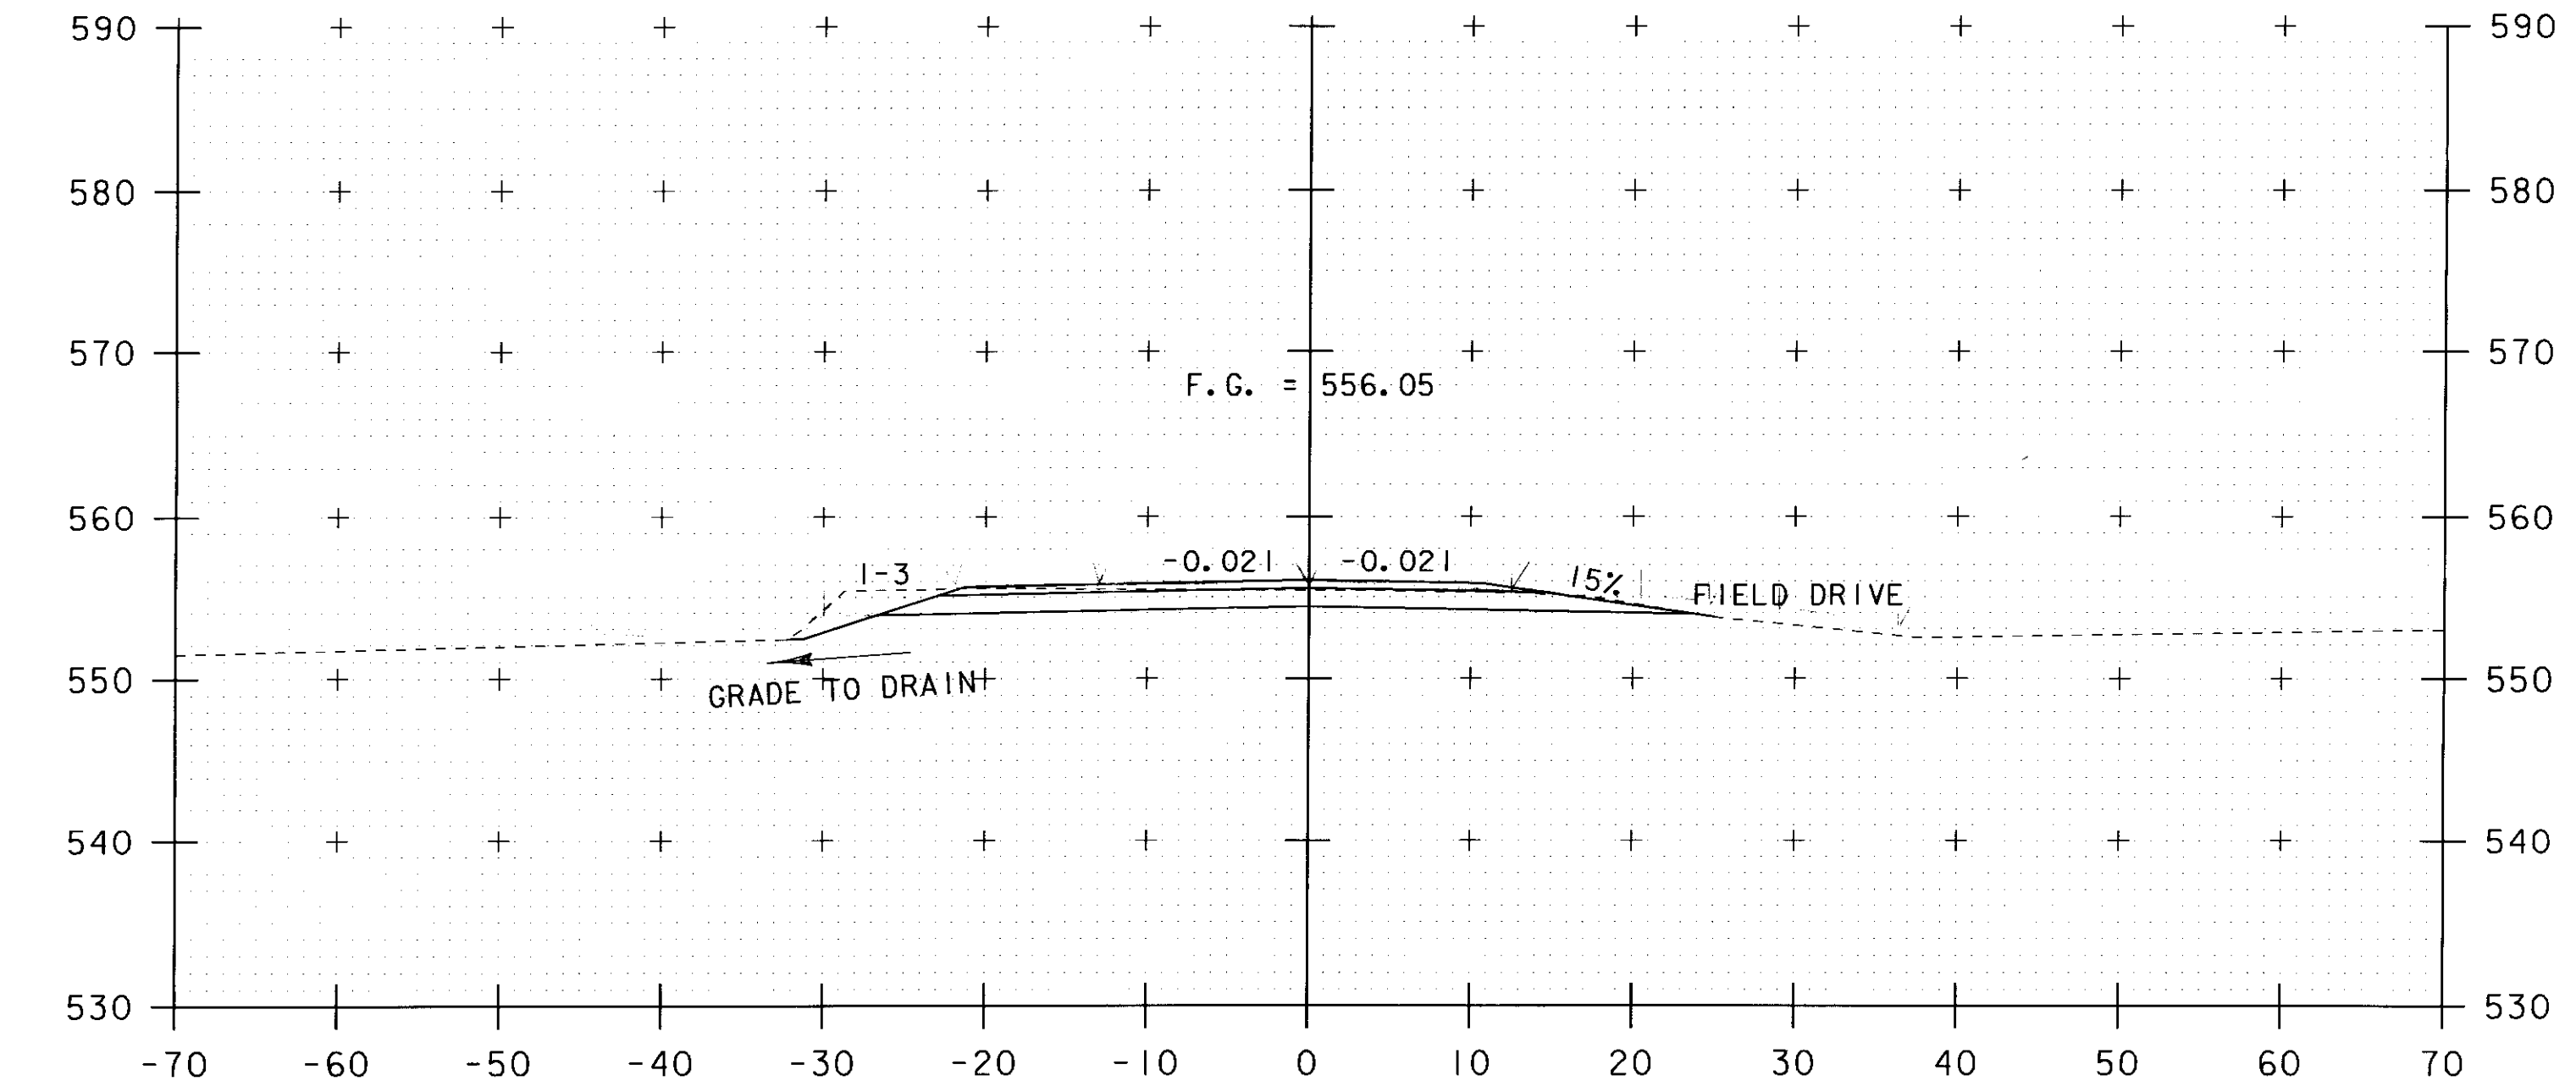

34+00

STA. 33+50 TO STA. 34+25

SCALE 1" = 10'-0"
10 0 10

PROJECT NAME: JAMAICA
PROJECT NUMBER: BRO 1442(27)

FILE NAME: s96J068xsl.dgn
PROJECT LEADER: K. HIGGINS
DESIGNED BY: J. LACROIX
ROADWAY CROSS SECTIONS #2

PLOT DATE: 23-SEP-2010
DRAWN BY: R. PELLETT
CHECKED BY: J. LACROIX
SHEET 35 OF 45