



36+10.50

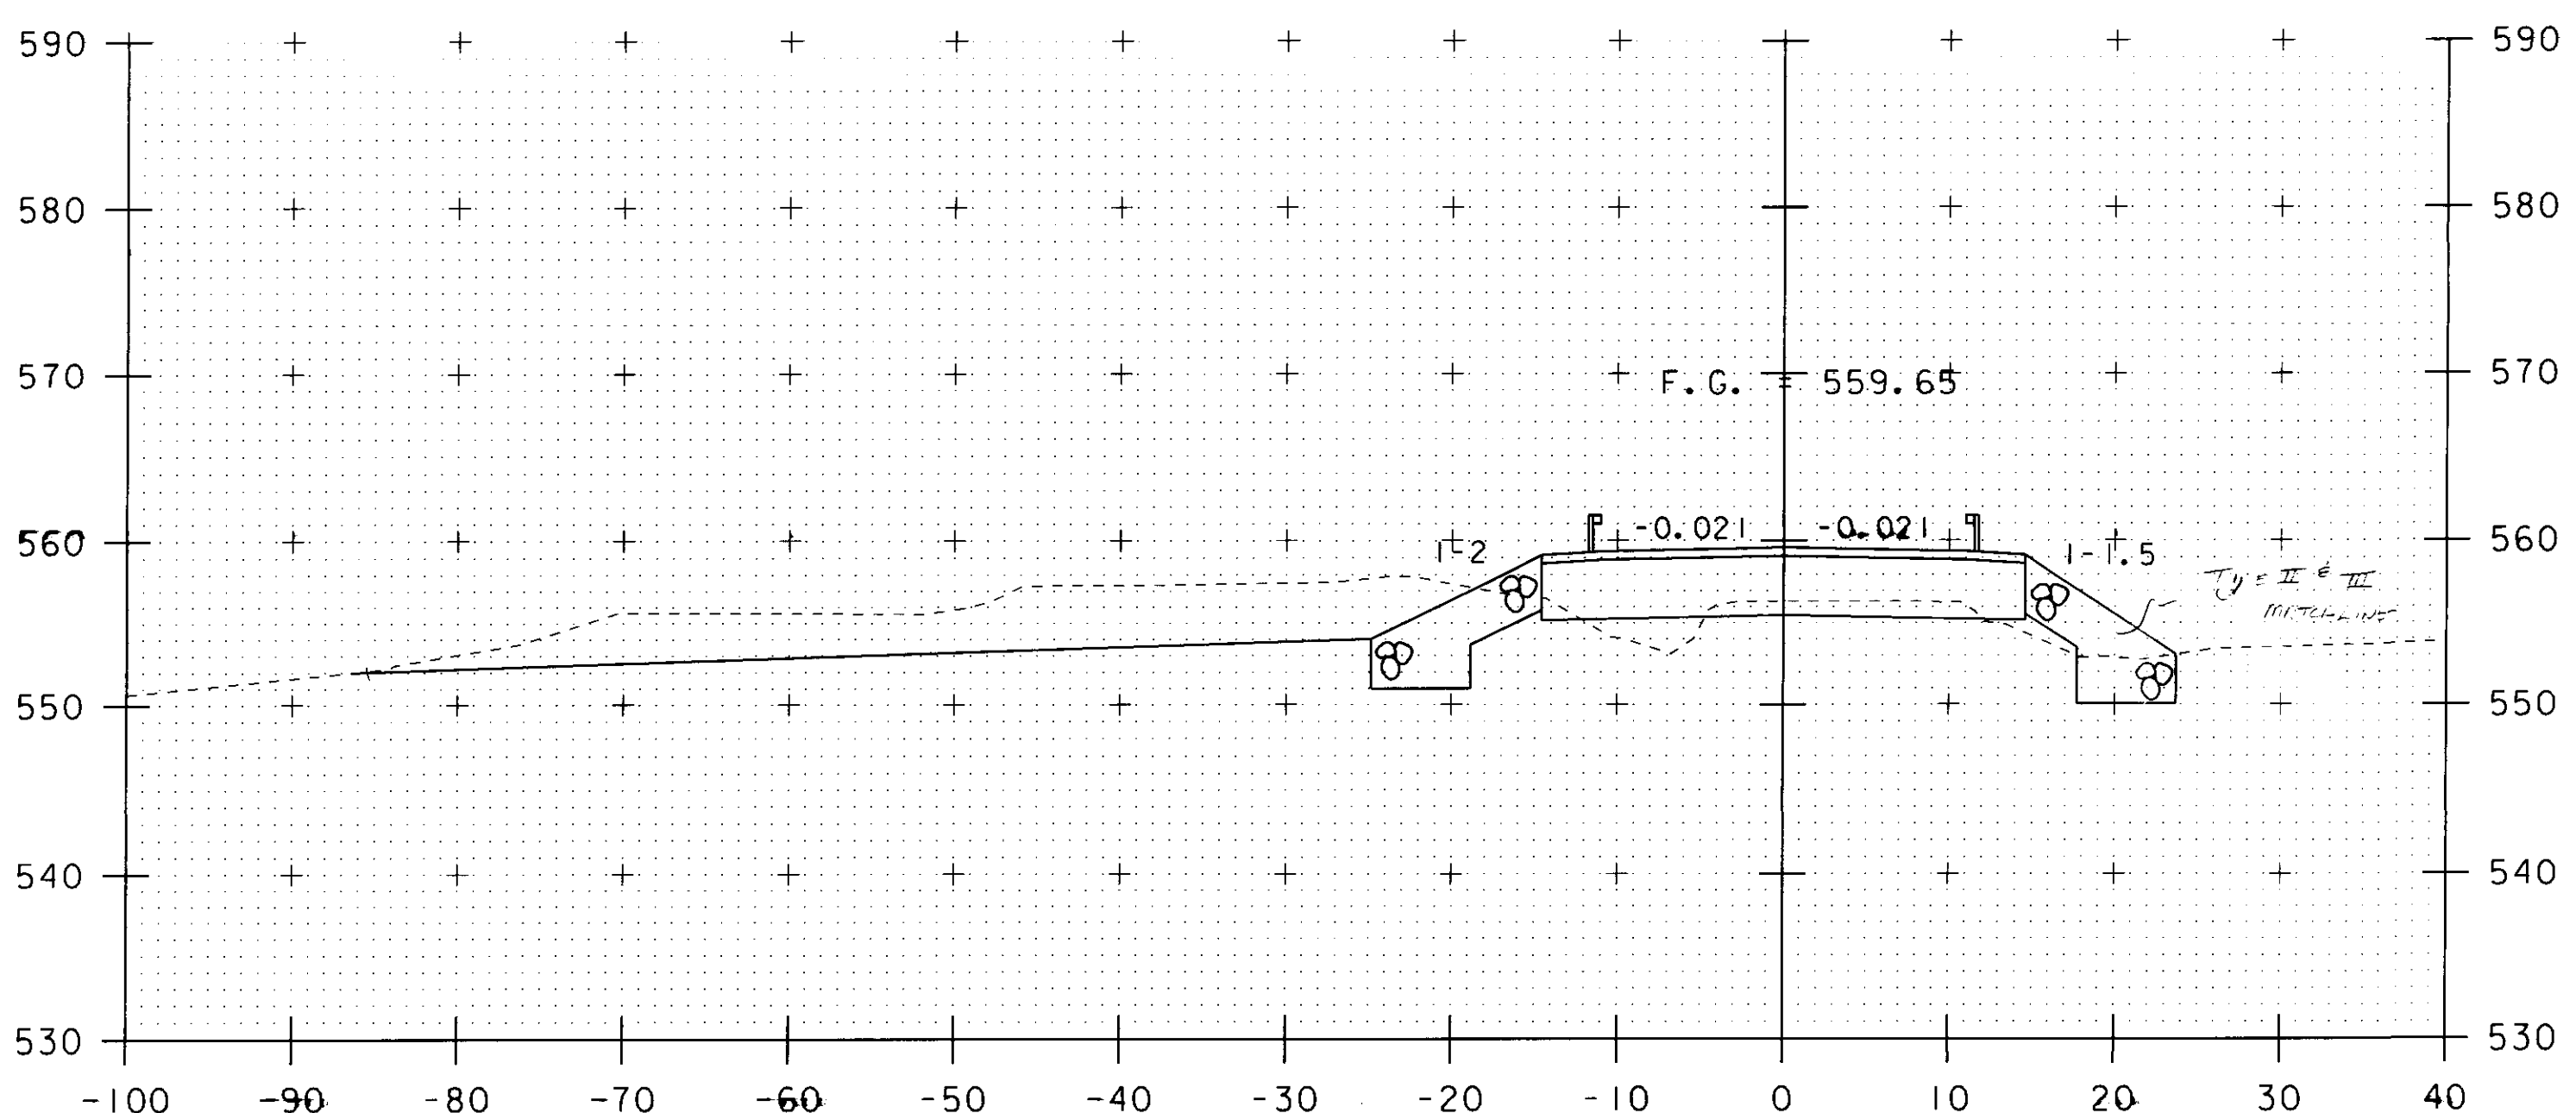

34+93

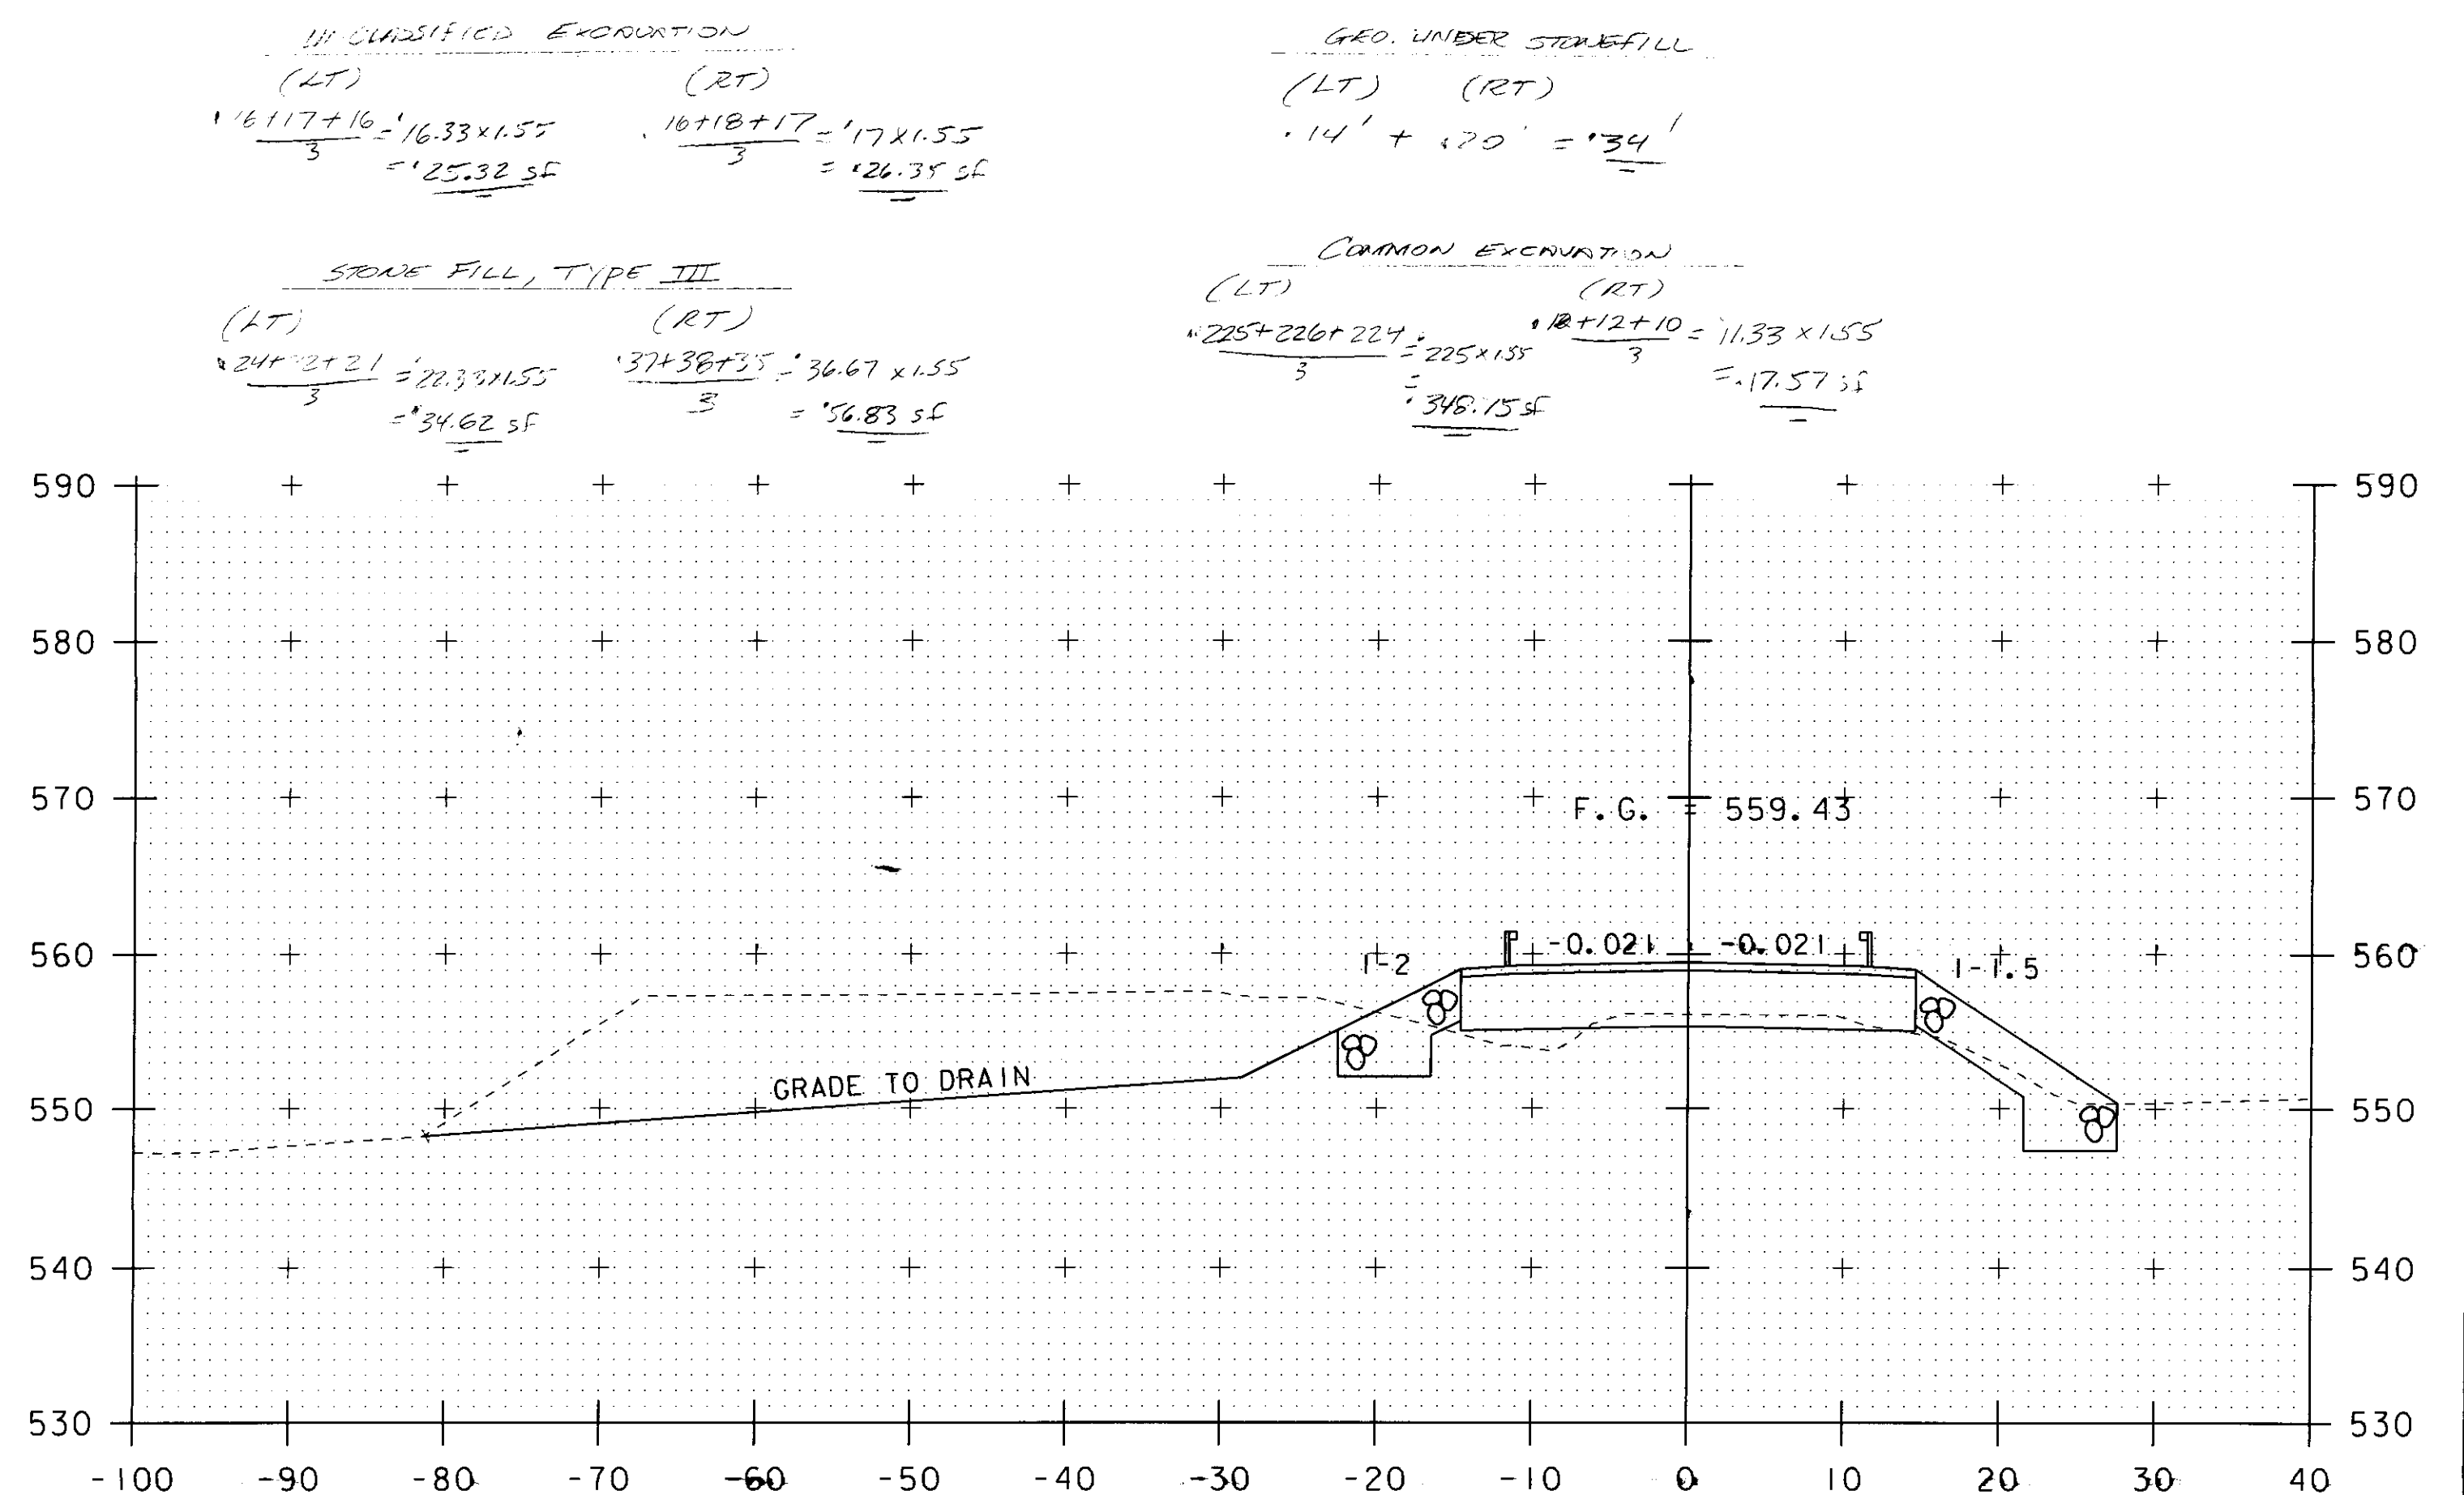

36+20

UNDERSIZED EXCAVATION
(LT) $\frac{38+38+41}{3} = 39 \times 1.55 = 60.45 \text{ SF}$
(RT) $\frac{41+41+38}{3} = 40 \times 1.55 = 62.00 \text{ SF}$
COMMON EXCAVATION
(LT) $\frac{250+252+250}{3} = 250.67 \times 1.55 = 388.53 \text{ SF}$

STONE FILL, TYPE III
(LT) $\frac{38+38+41}{3} = 39 \times 1.55 = 60.45 \text{ SF}$
(RT) $\frac{41+41+38}{3} = 40 \times 1.55 = 62.00 \text{ SF}$
GEO. UNDER STONE FILL
(LT) $\frac{250+252+250}{3} = 250.67 \times 1.55 = 388.53 \text{ SF}$

UNDERSIZED EXCAVATION
(LT) $\frac{16+17+16}{3} = 16.33 \times 1.55 = 25.32 \text{ SF}$
(RT) $\frac{16+18+17}{3} = 17 \times 1.55 = 26.35 \text{ SF}$
GEO. UNDER STONE FILL
(LT) $\frac{14' + 170'}{3} = 34'$
STONE FILL, TYPE III
(LT) $\frac{24+24+21}{3} = 22.33 \times 1.55 = 34.62 \text{ SF}$
(RT) $\frac{37+38+35}{3} = 36.67 \times 1.55 = 56.83 \text{ SF}$
COMMON EXCAVATION
(LT) $\frac{225+226+224}{3} = 225 \times 1.55 = 348.75 \text{ SF}$
(RT) $\frac{18+12+10}{3} = 13.33 \times 1.55 = 20.66 \text{ SF}$

UNDERSIZED EXCAVATION
(LT) $\frac{23+23+24}{3} = 23.33 \times 1.55 = 36.16 \text{ SF}$
(RT) $\frac{24+24+23}{3} = 23.67 \times 1.55 = 36.69 \text{ SF}$
COMMON EXCAVATION
(LT) $\frac{17+18+12}{3} = 15.67 \times 1.55 = 24.29 \text{ SF}$
(RT) $\frac{7+6+8}{3} = 7 \times 1.55 = 10.85 \text{ SF}$
STONE FILL, TYPE II & III
(LT) $\frac{23+23+24}{3} = 23.33 \times 1.55 = 36.16 \text{ SF}$
(RT) $\frac{24+24+23}{3} = 23.67 \times 1.55 = 36.69 \text{ SF}$
GEO. UNDER STONE FILL
(LT) $\frac{17+18+12}{3} = 15.67 \times 1.55 = 24.29 \text{ SF}$
(RT) $\frac{7+6+8}{3} = 7 \times 1.55 = 10.85 \text{ SF}$

UNDERSIZED EXCAVATION
(LT) $\frac{17+18+12}{3} = 15.67 \times 1.55 = 24.29 \text{ SF}$
(RT) $\frac{7+6+8}{3} = 7 \times 1.55 = 10.85 \text{ SF}$
STONE FILL, TYPE II & III
(LT) $\frac{26+28+27}{3} = 27 \times 1.55 = 41.85 \text{ SF}$
(RT) $\frac{36+28+26}{3} = 30 \times 1.55 = 46.50 \text{ SF}$
GEO. UNDER STONE FILL
(LT) $\frac{15+14+12}{3} = 13.67 \times 1.55 = 21.19 \text{ SF}$
(RT) $\frac{15+14+12}{3} = 13.67 \times 1.55 = 21.19 \text{ SF}$

SCALE 1" = 10' - 0
0 10

PROJECT NAME: JAMAICA
PROJECT NUMBER: BRO 1442(27)
FILE NAME: s96j068xsl.dgn
PROJECT LEADER: K. HIGGINS
DESIGNED BY: J. LACROIX
ADDITIONAL SECTIONS

PLOT DATE: 04-JAN-2011
DRAWN BY: J. SALVATORI
CHECKED BY: J. SALVATORI
SHEET 1 OF 1

STA. 34+93 TO STA. 36+20