




34+75

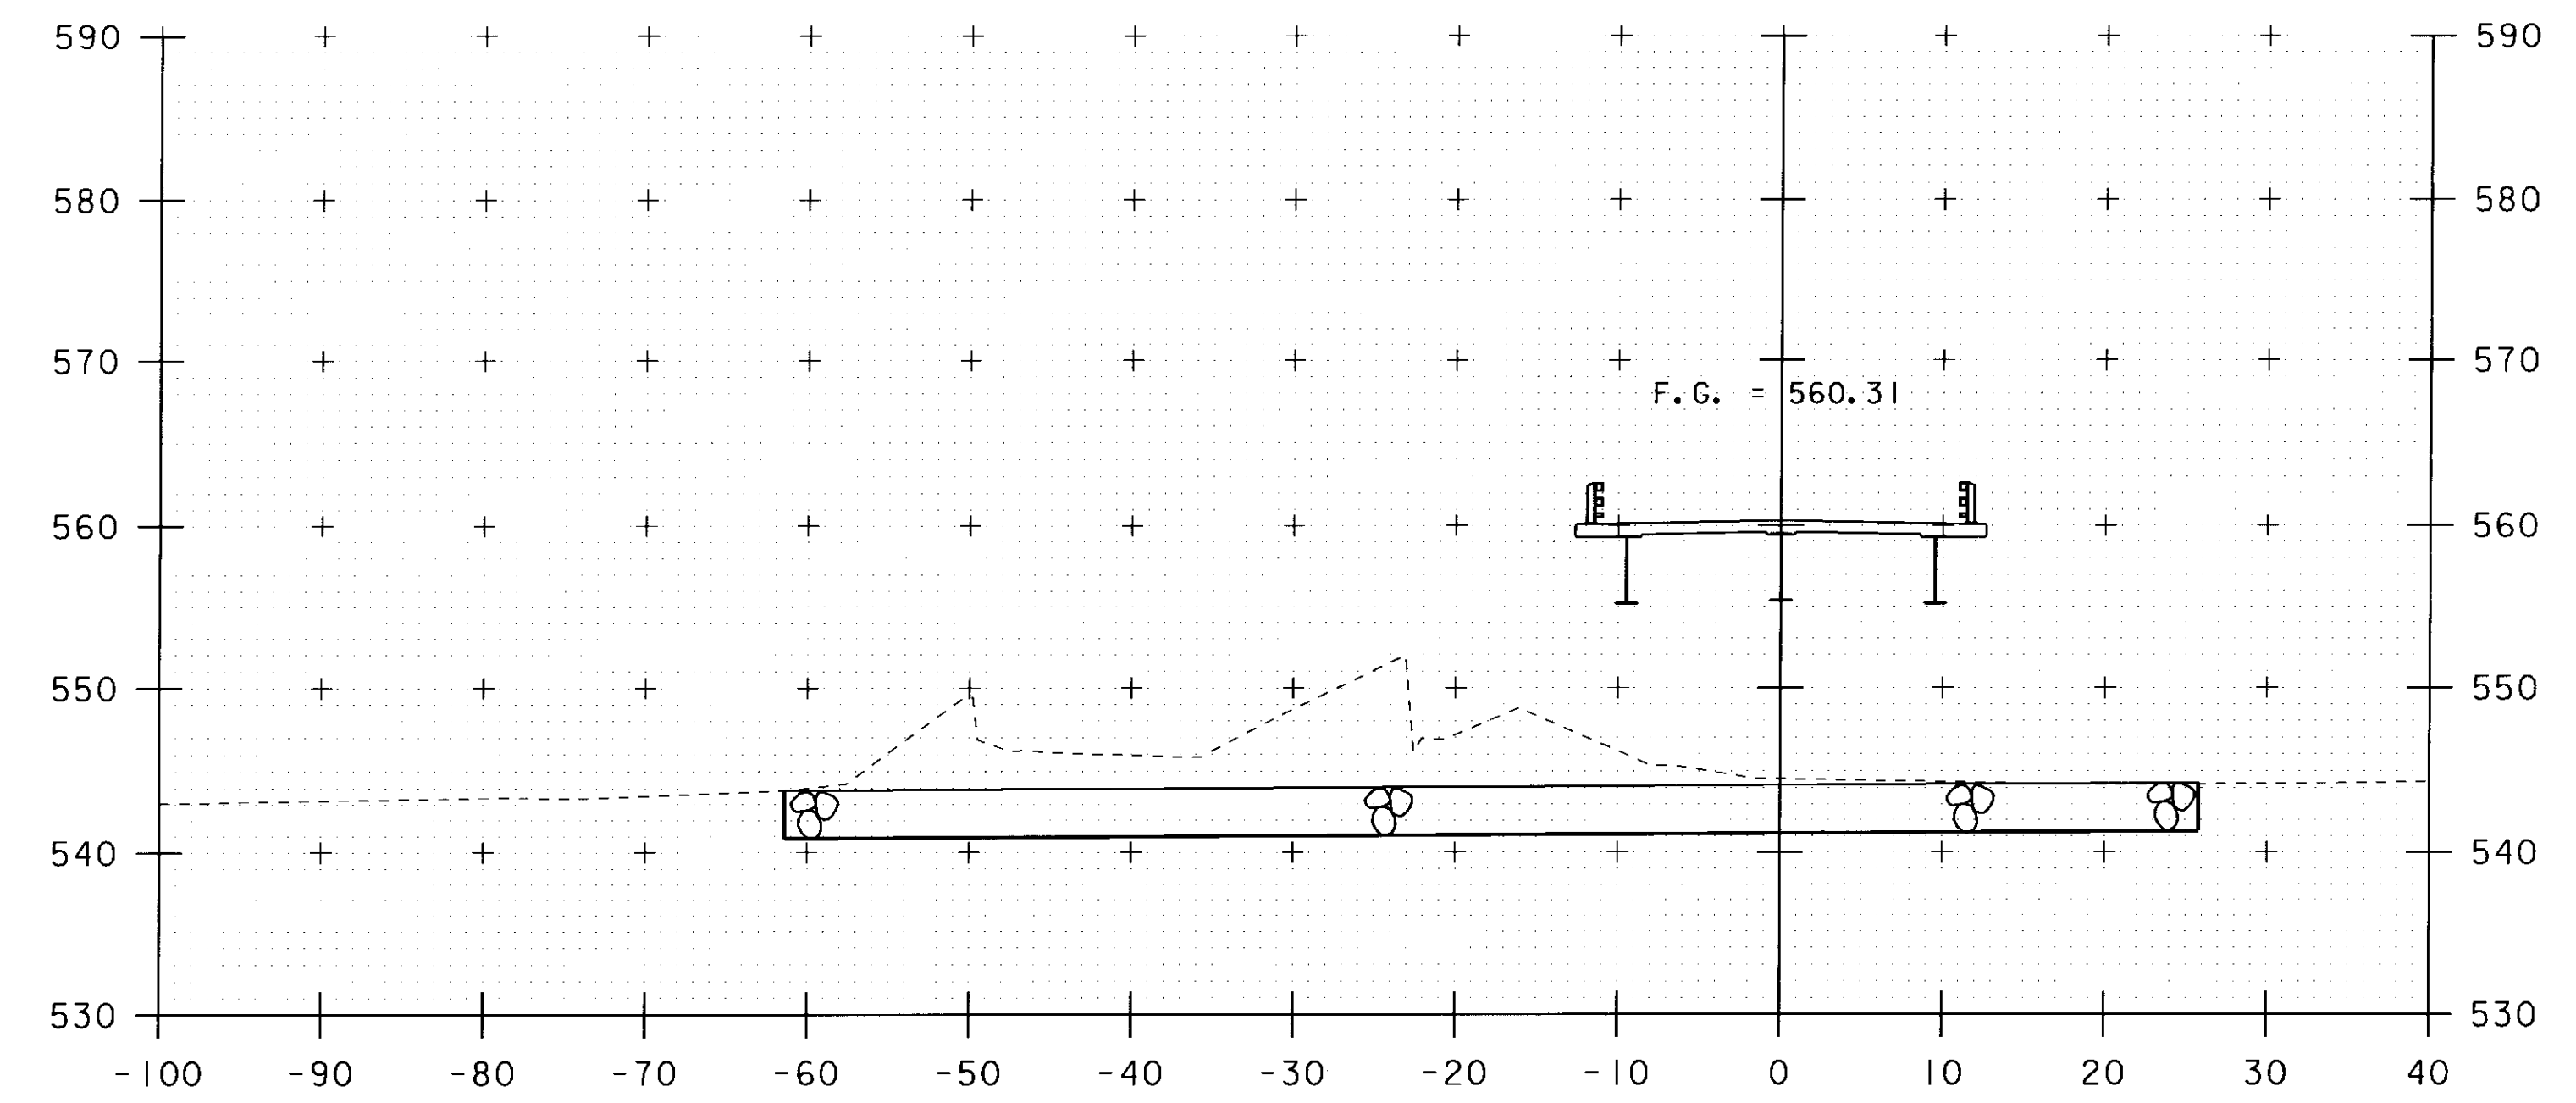

35+25
BEGIN BRIDGE 35+02.50

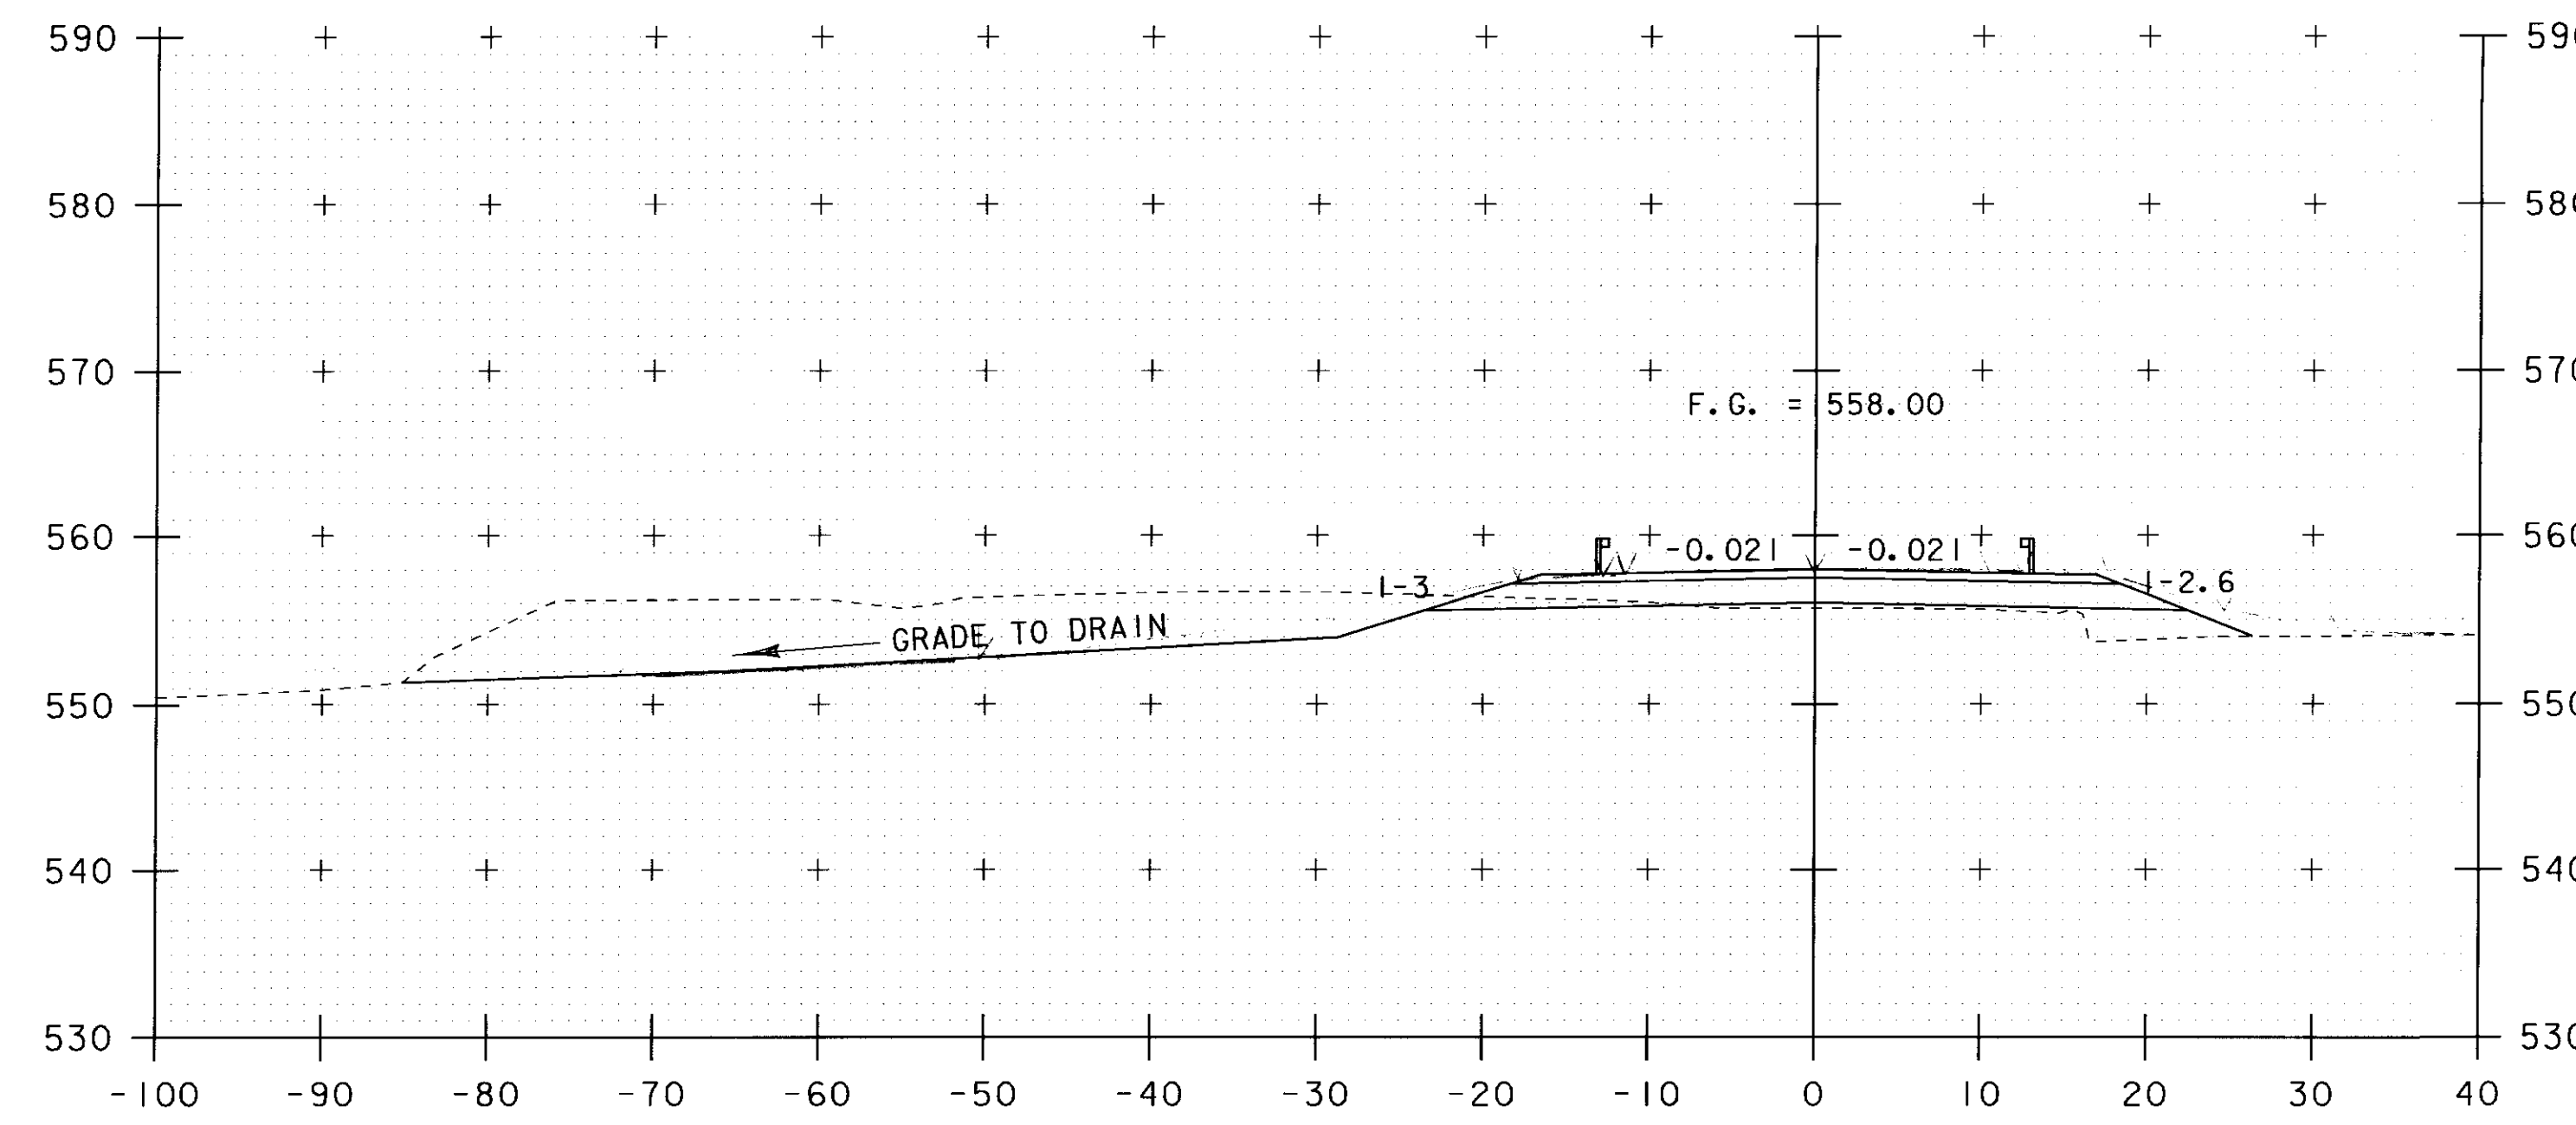


34+50

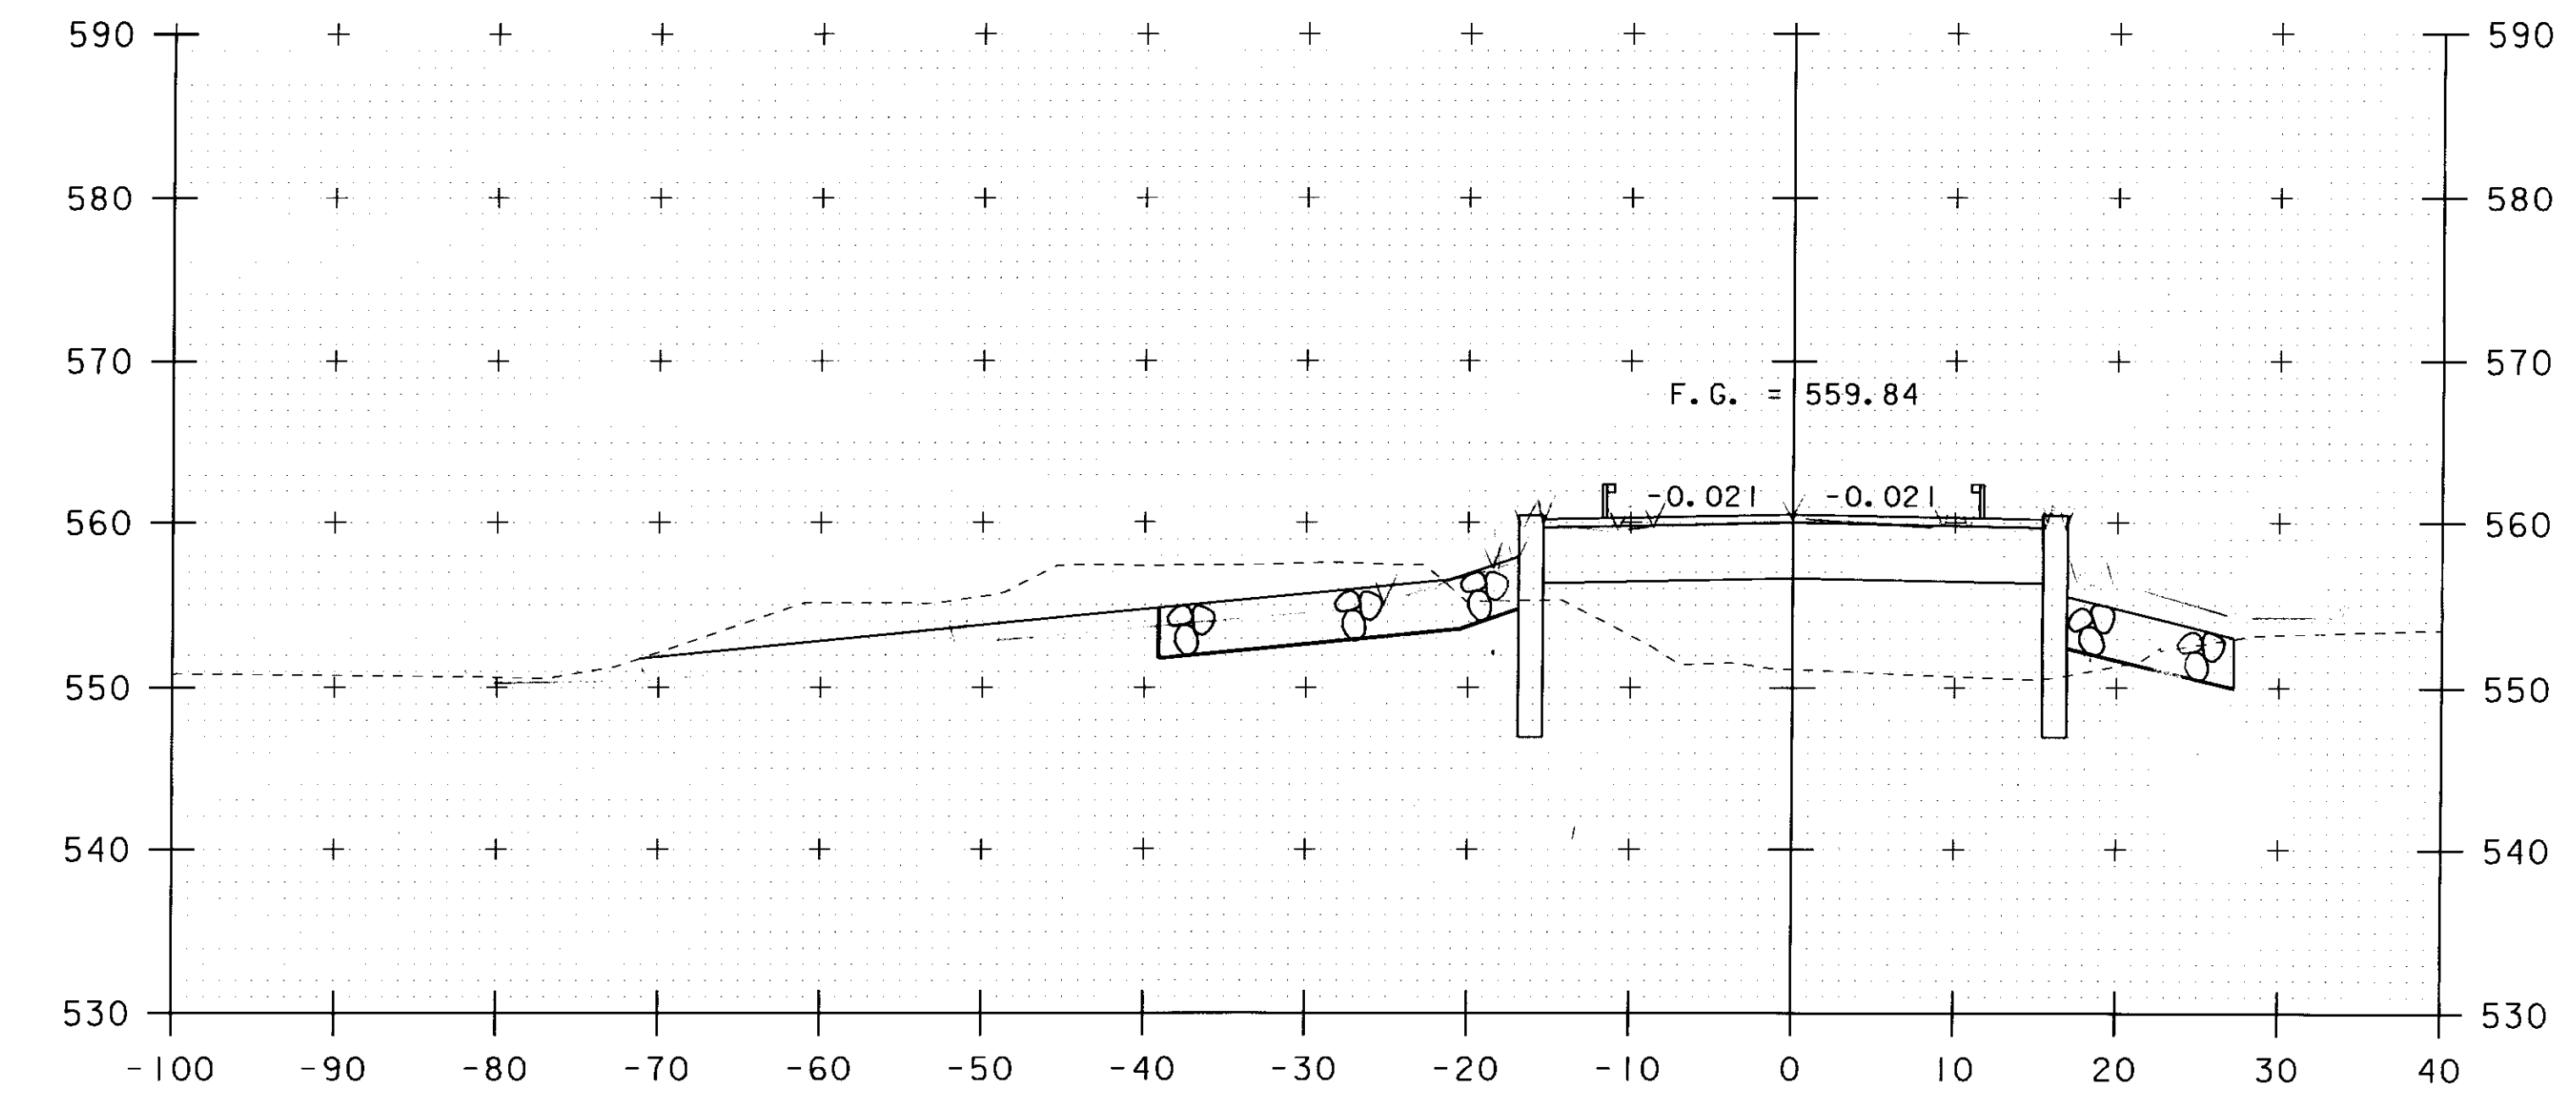

35+00

STA. 34+50 TO STA. 35+25

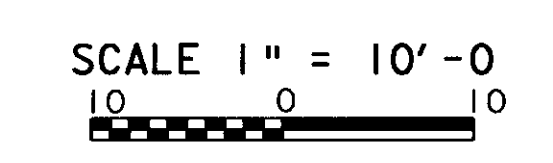

Common Excavation:
(1) 34+61+80 = 18' x 3' = 60' x 155' = 93,000
(2) 0
(3) 0

PROJECT NAME:	JAMAICA	PLOT DATE:	23-SEP-2010
PROJECT NUMBER:	BRO 1442(27)	DRAWN BY:	R. PELLETT
FILE NAME:	s96J068xsl.dgn	CHECKED BY:	J. LACROIX
PROJECT LEADER:	K. HIGGINS	ROADWAY CROSS SECTIONS #3	SHEET 36 OF 45
DESIGNED BY:	J. LACROIX		