



36+75

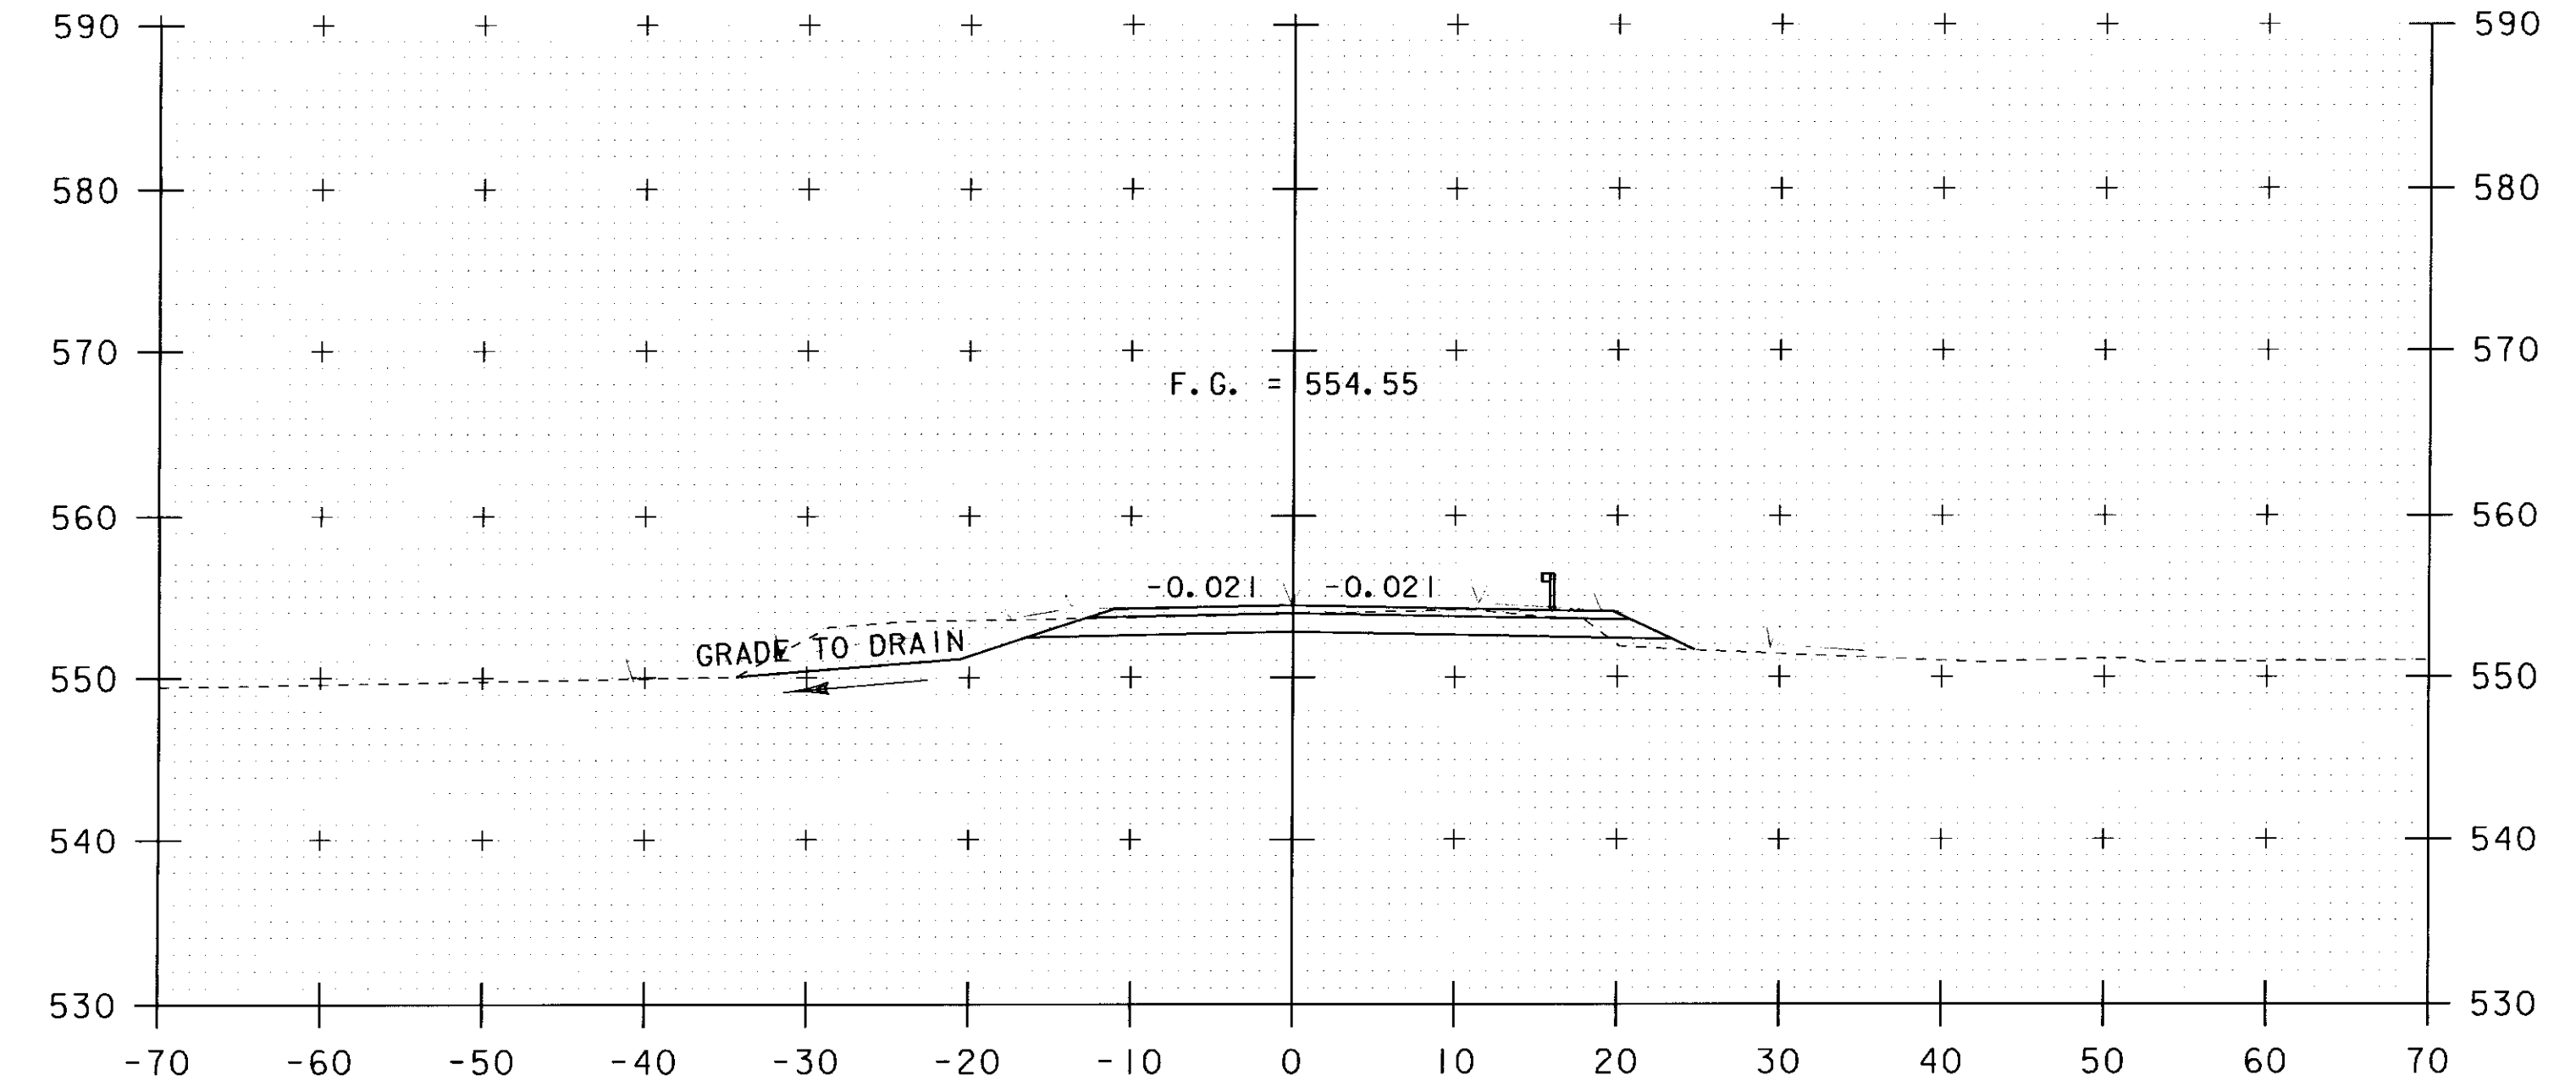


37+25

STA. 36+50 RT.
END SLOPE STABILIZATION
WITH 2' STONE FILL, TYPE II
WITH 12" GRUBBING MATERIAL

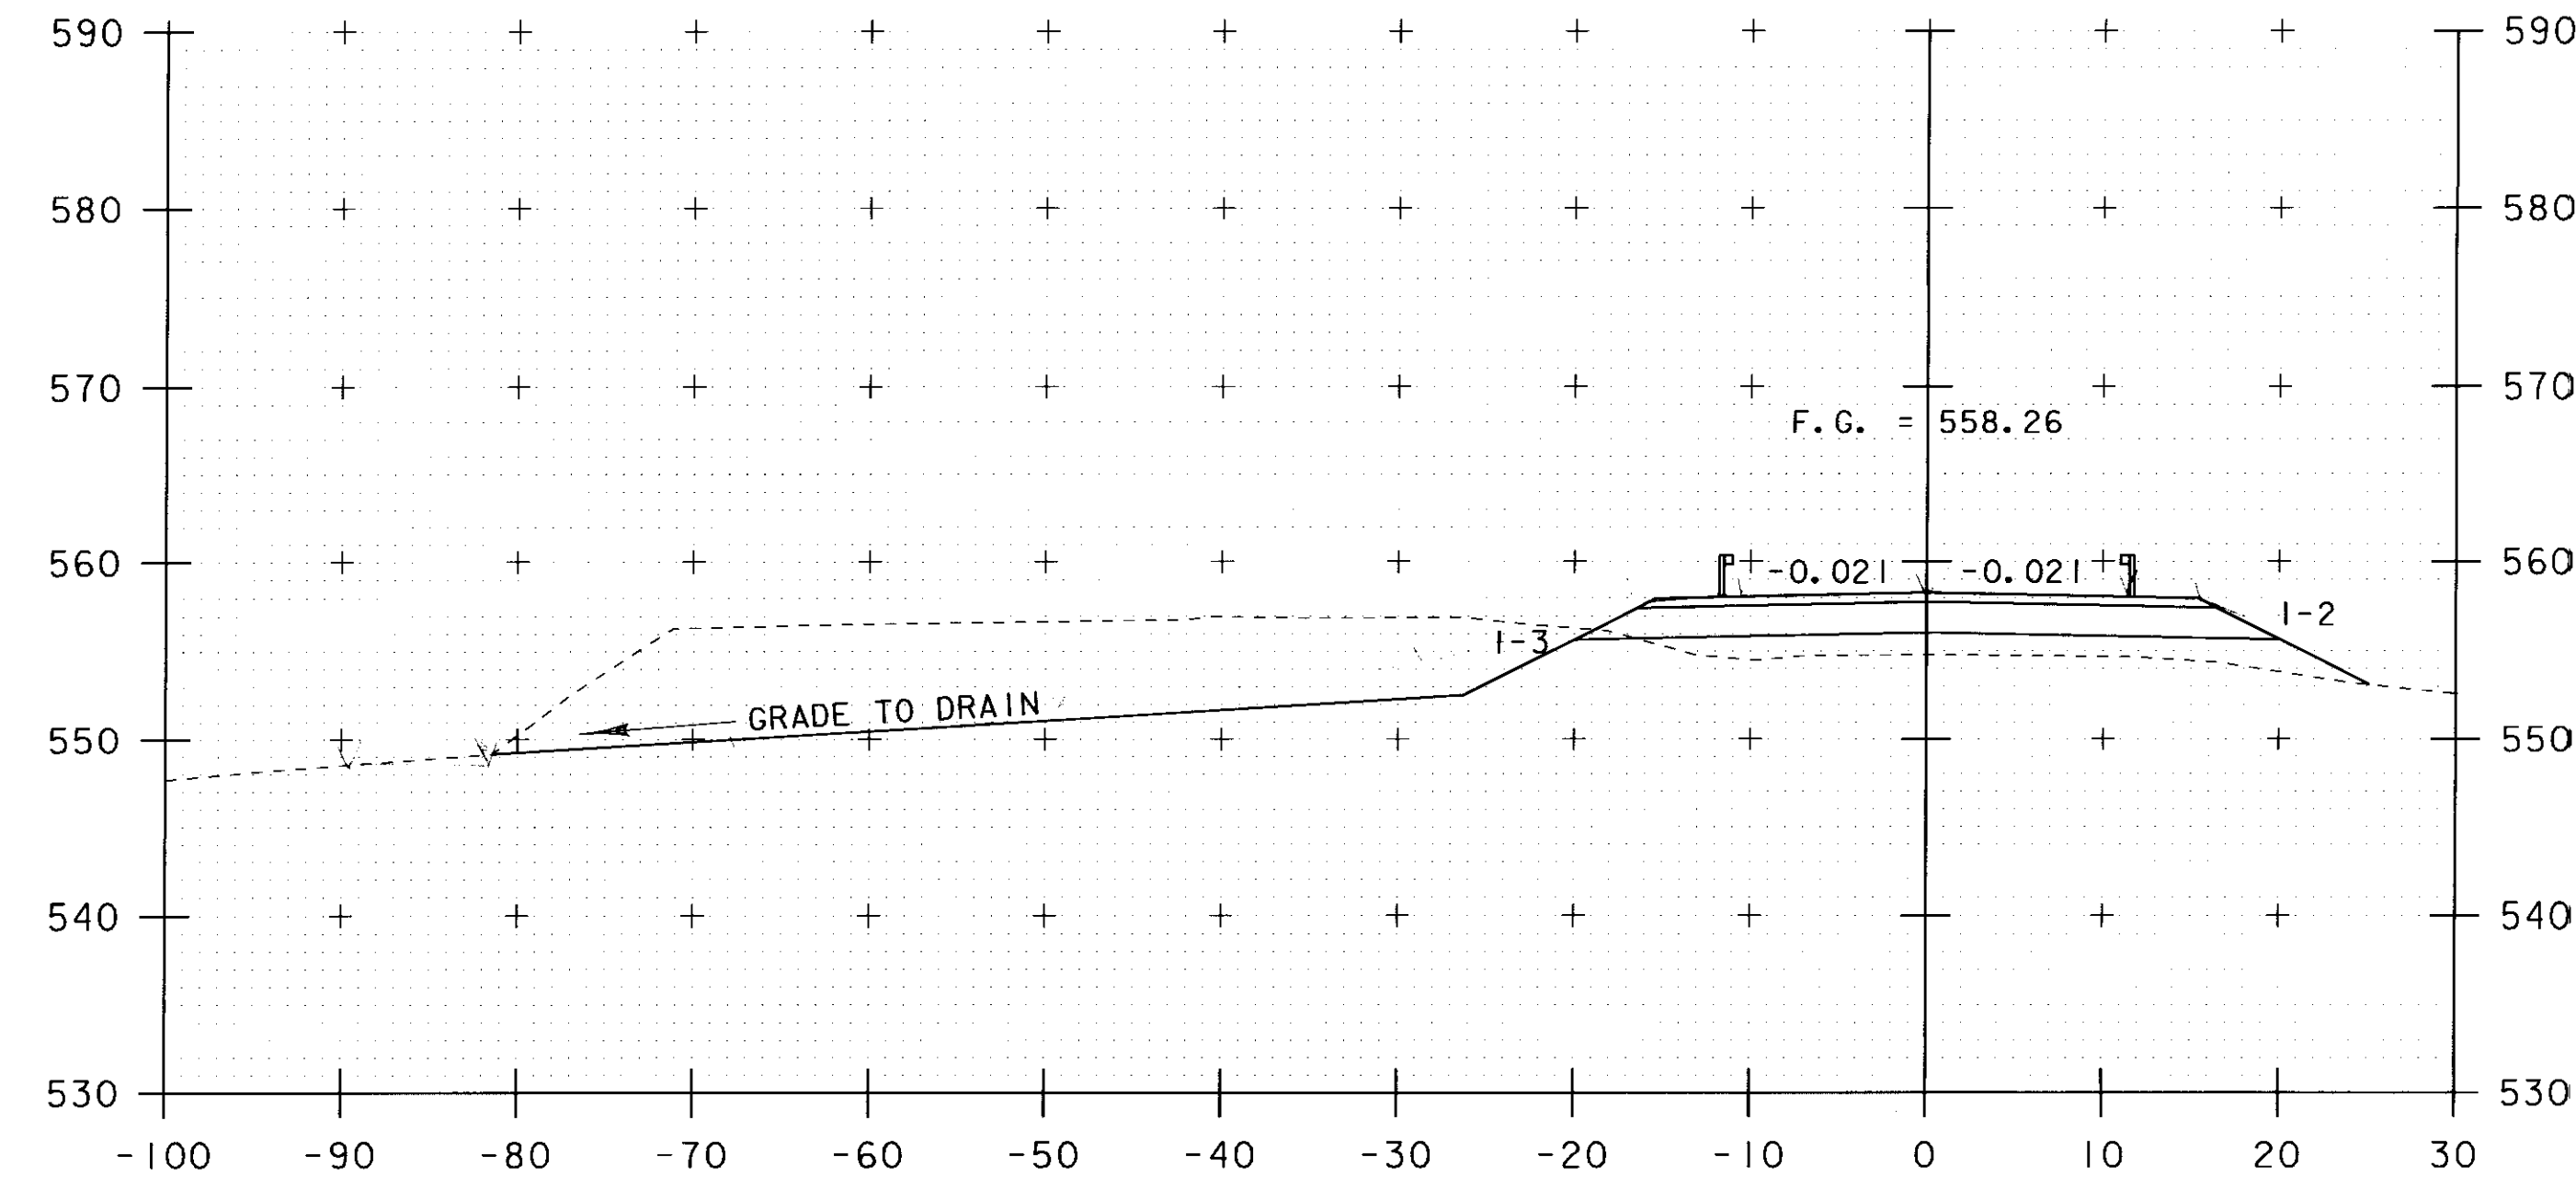


36+50

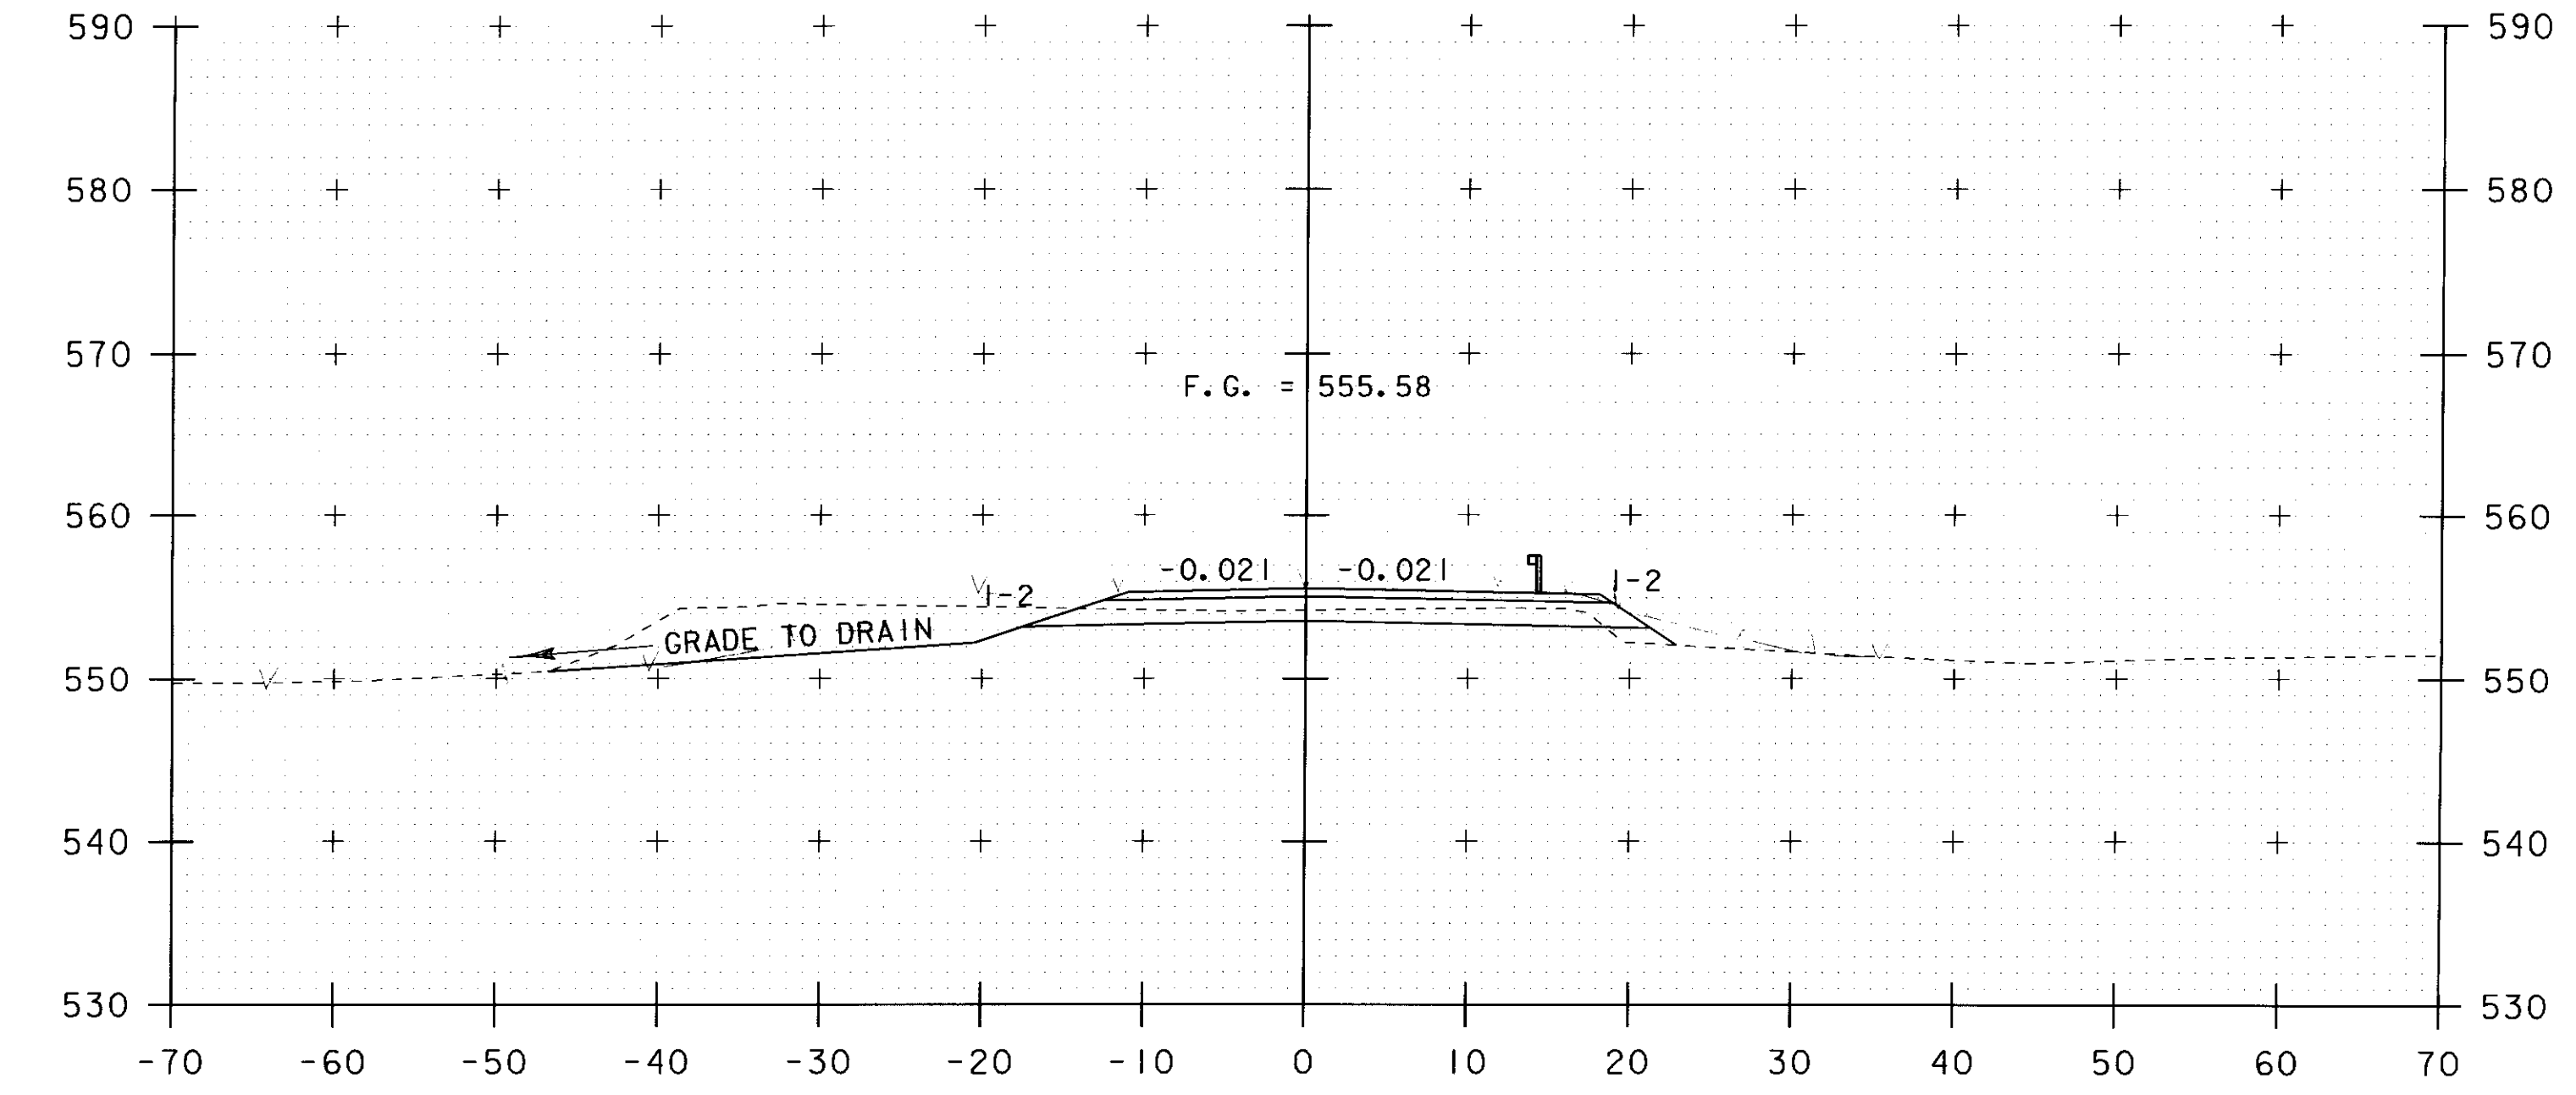

37+00
END PROJECT

STA. 36+50 TO STA. 37+25

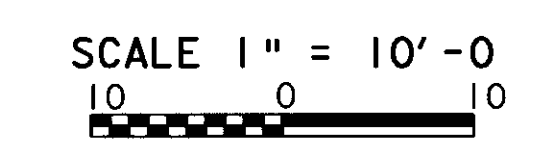

PROJECT NAME:	JAMAICA	PLOT DATE:	23-SEP-2010
PROJECT NUMBER:	BRO 1442(27)	DRAWN BY:	R. PELLETT
FILE NAME:	s96j068xsl.dgn	CHECKED BY:	J. LACROIX
PROJECT LEADER:	K. HIGGINS	ROADWAY CROSS SECTIONS #5	SHEET 38 OF 45
DESIGNED BY:	J. LACROIX		