




37+75
END APPROACH

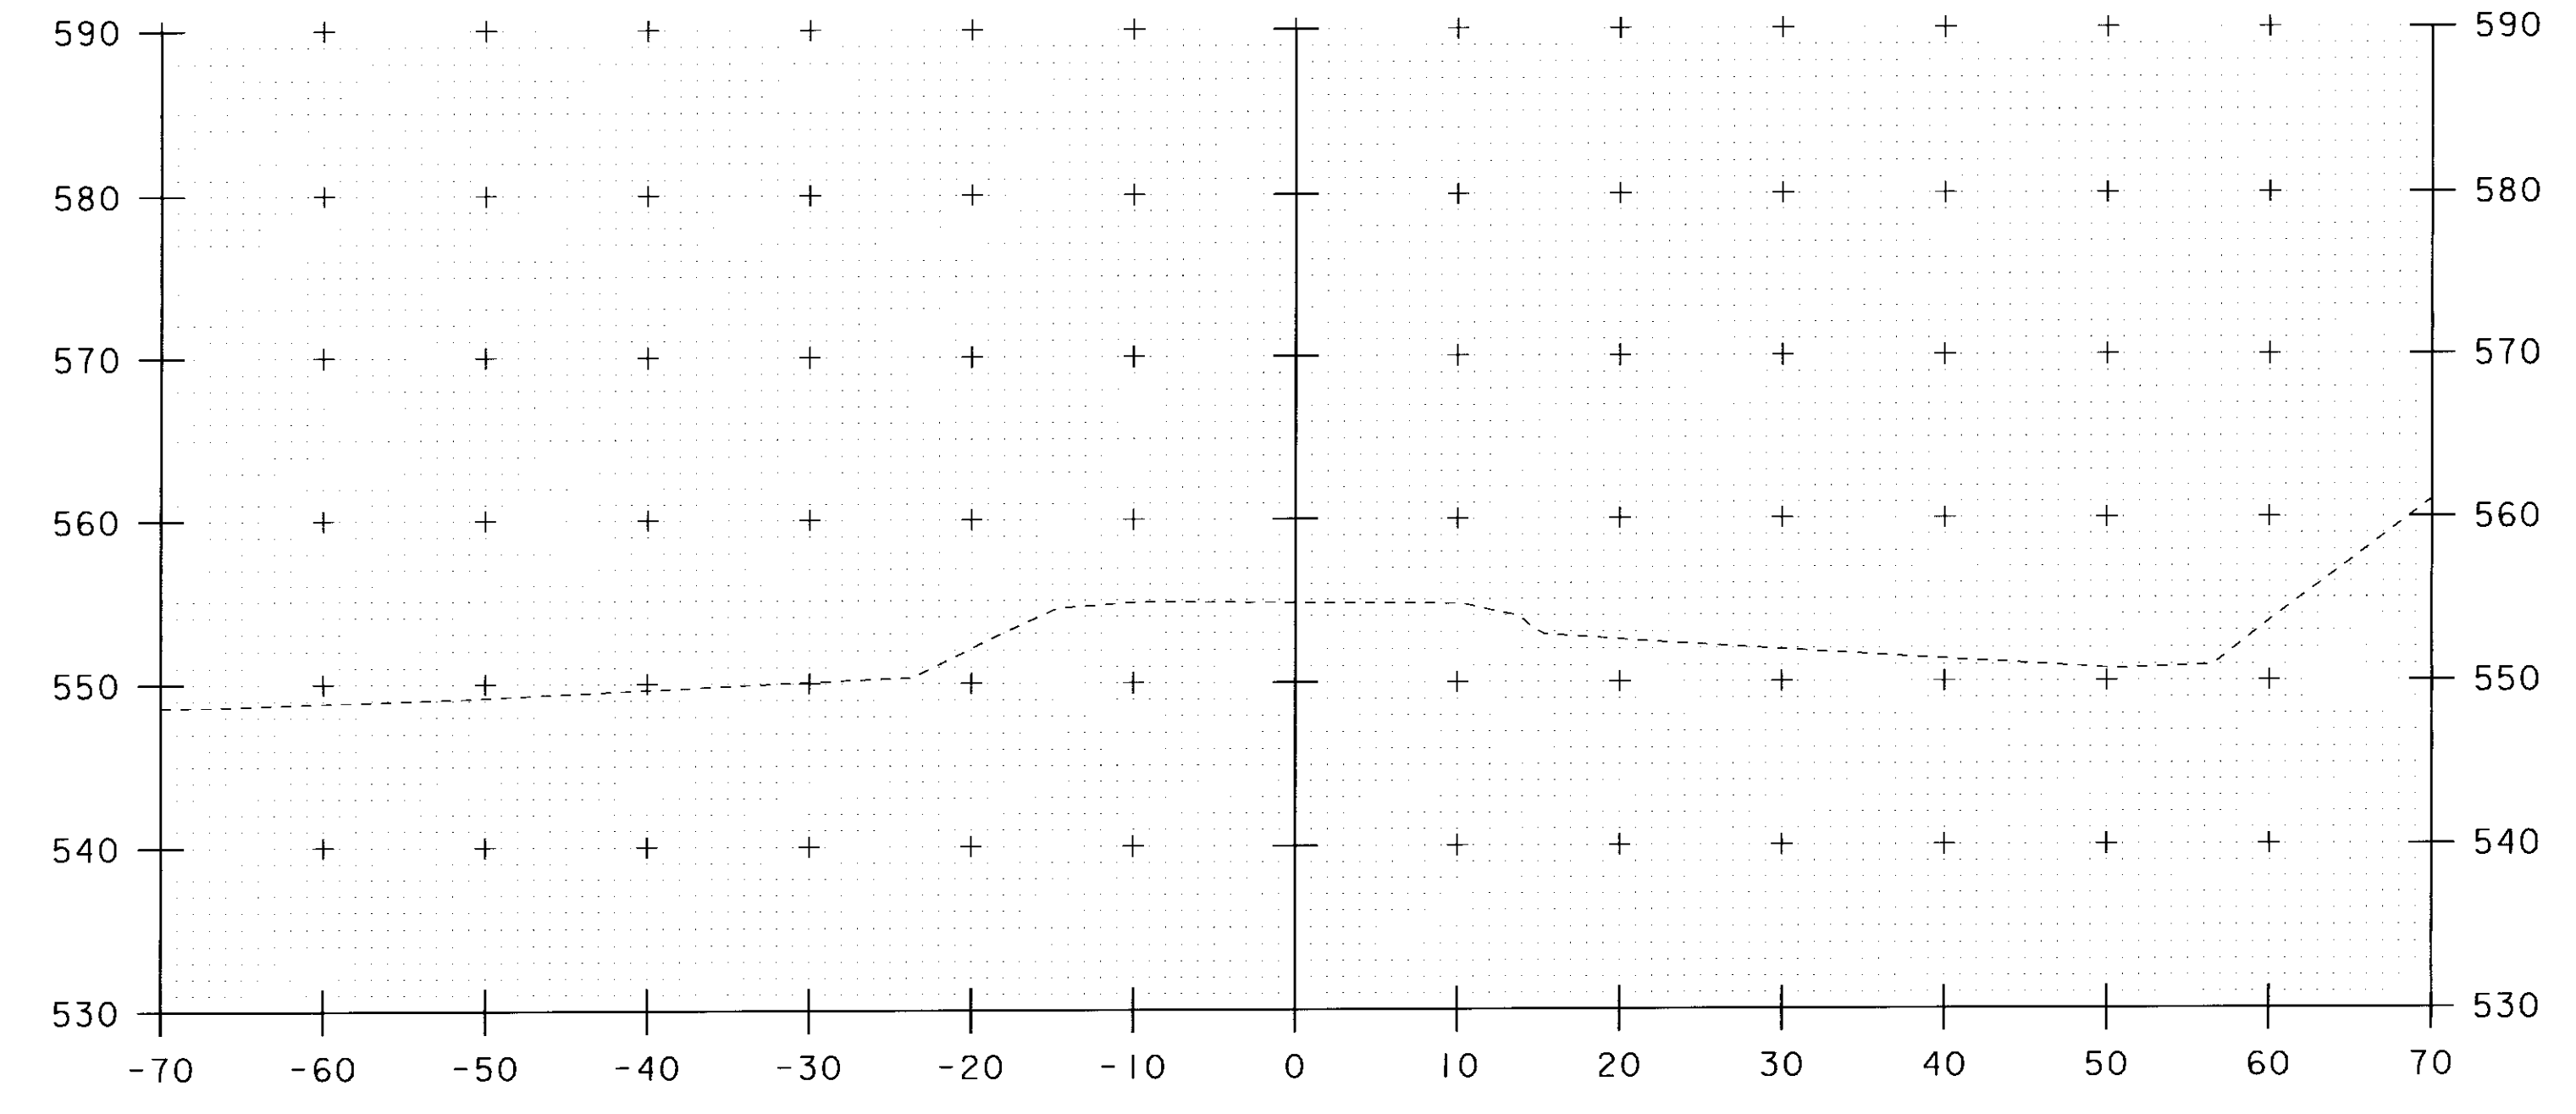

38+25

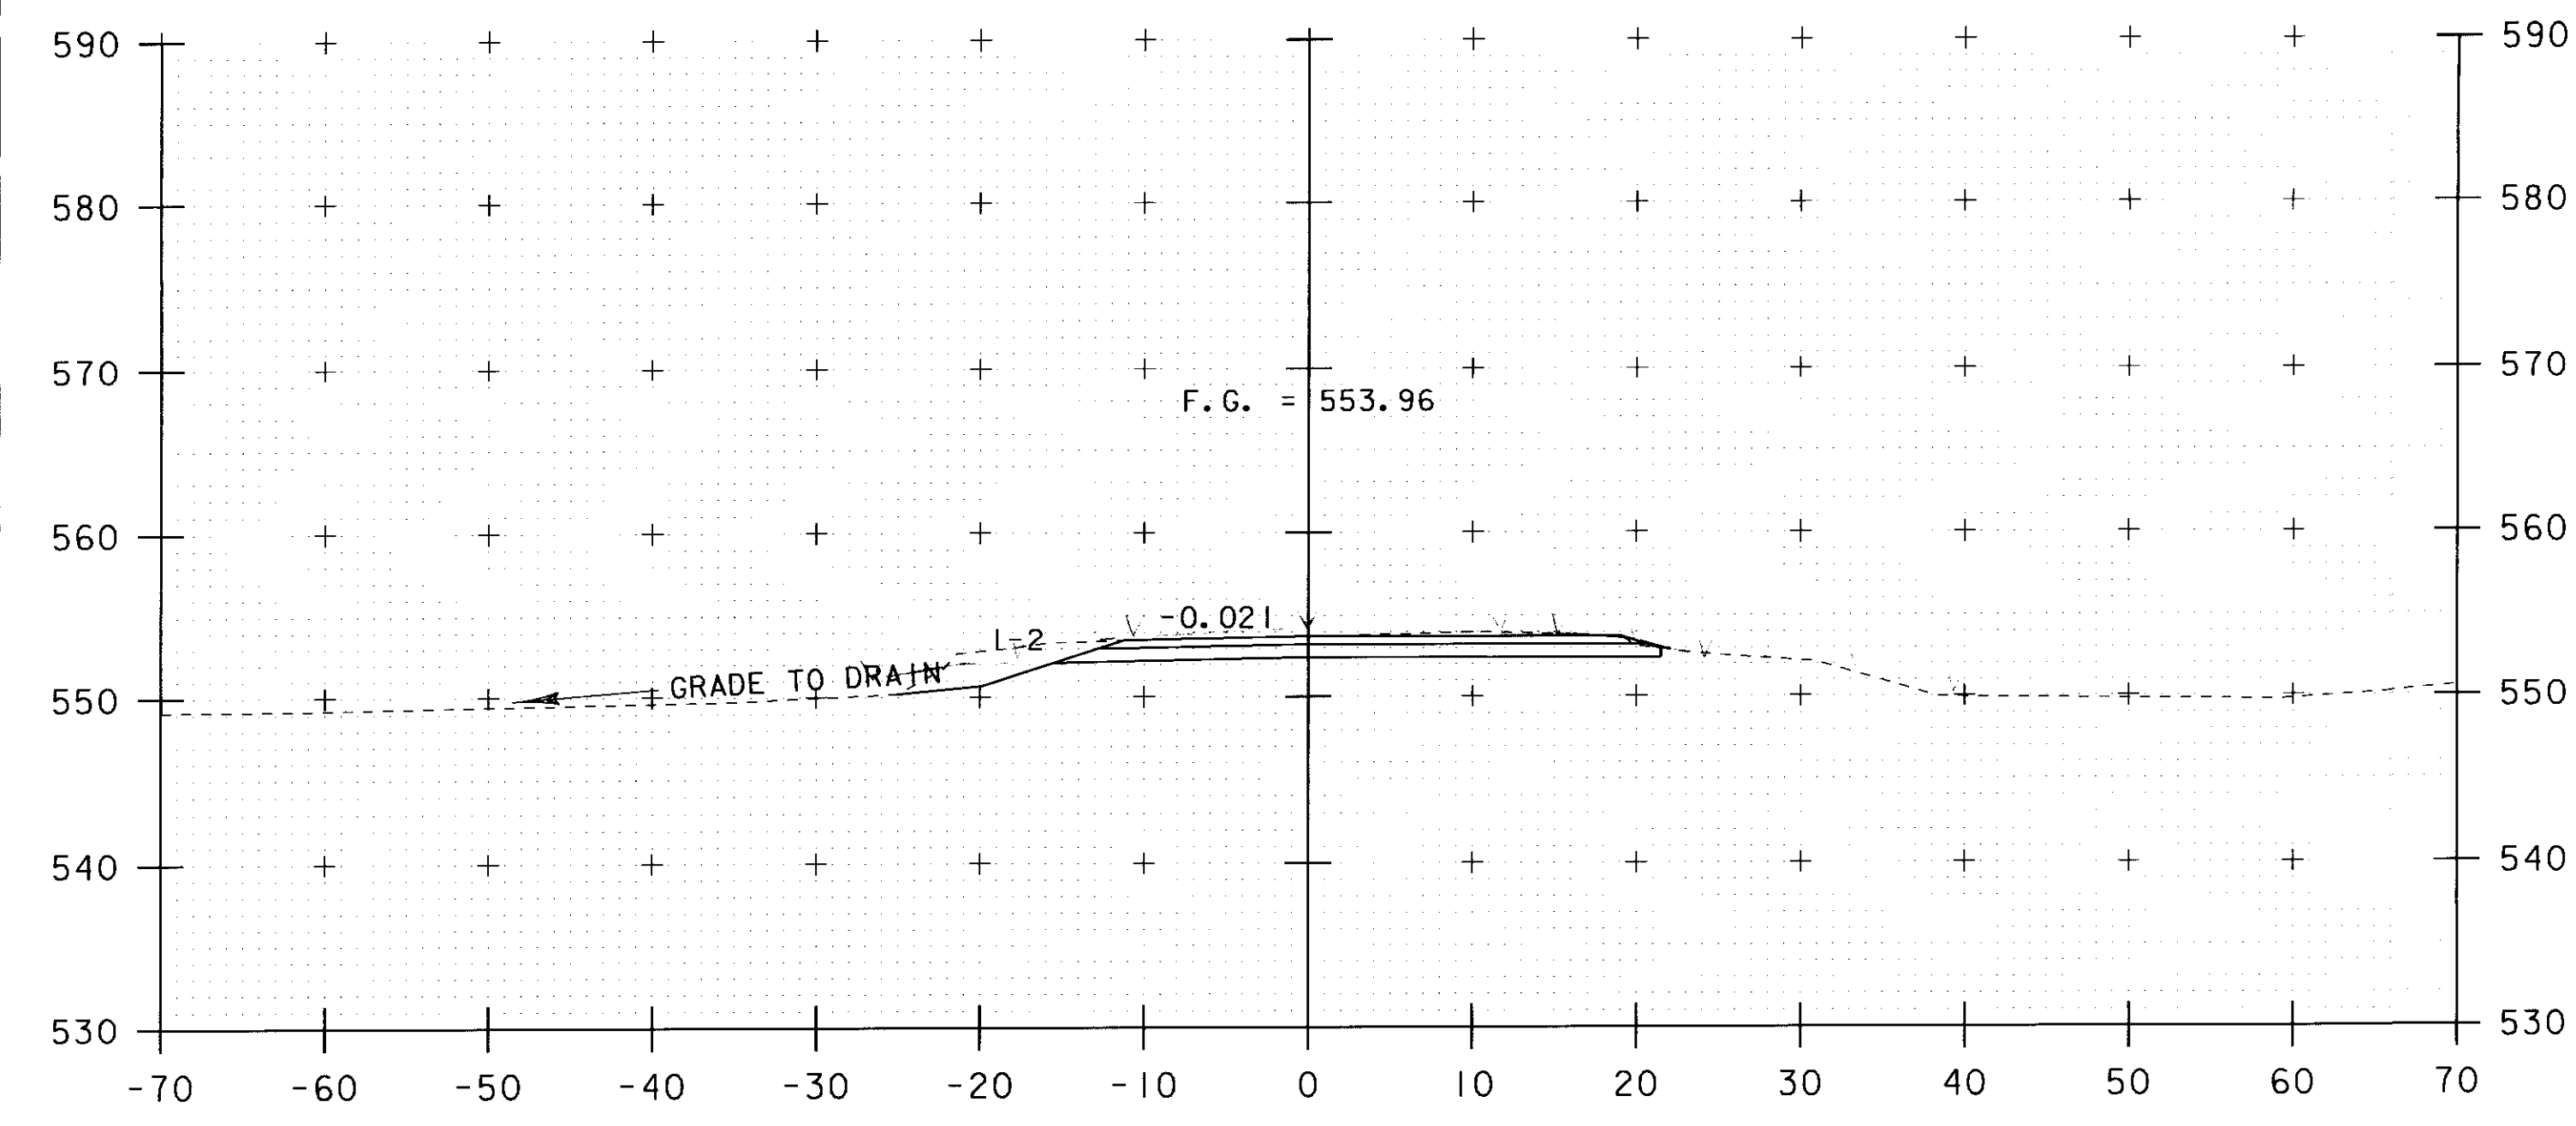


37+50

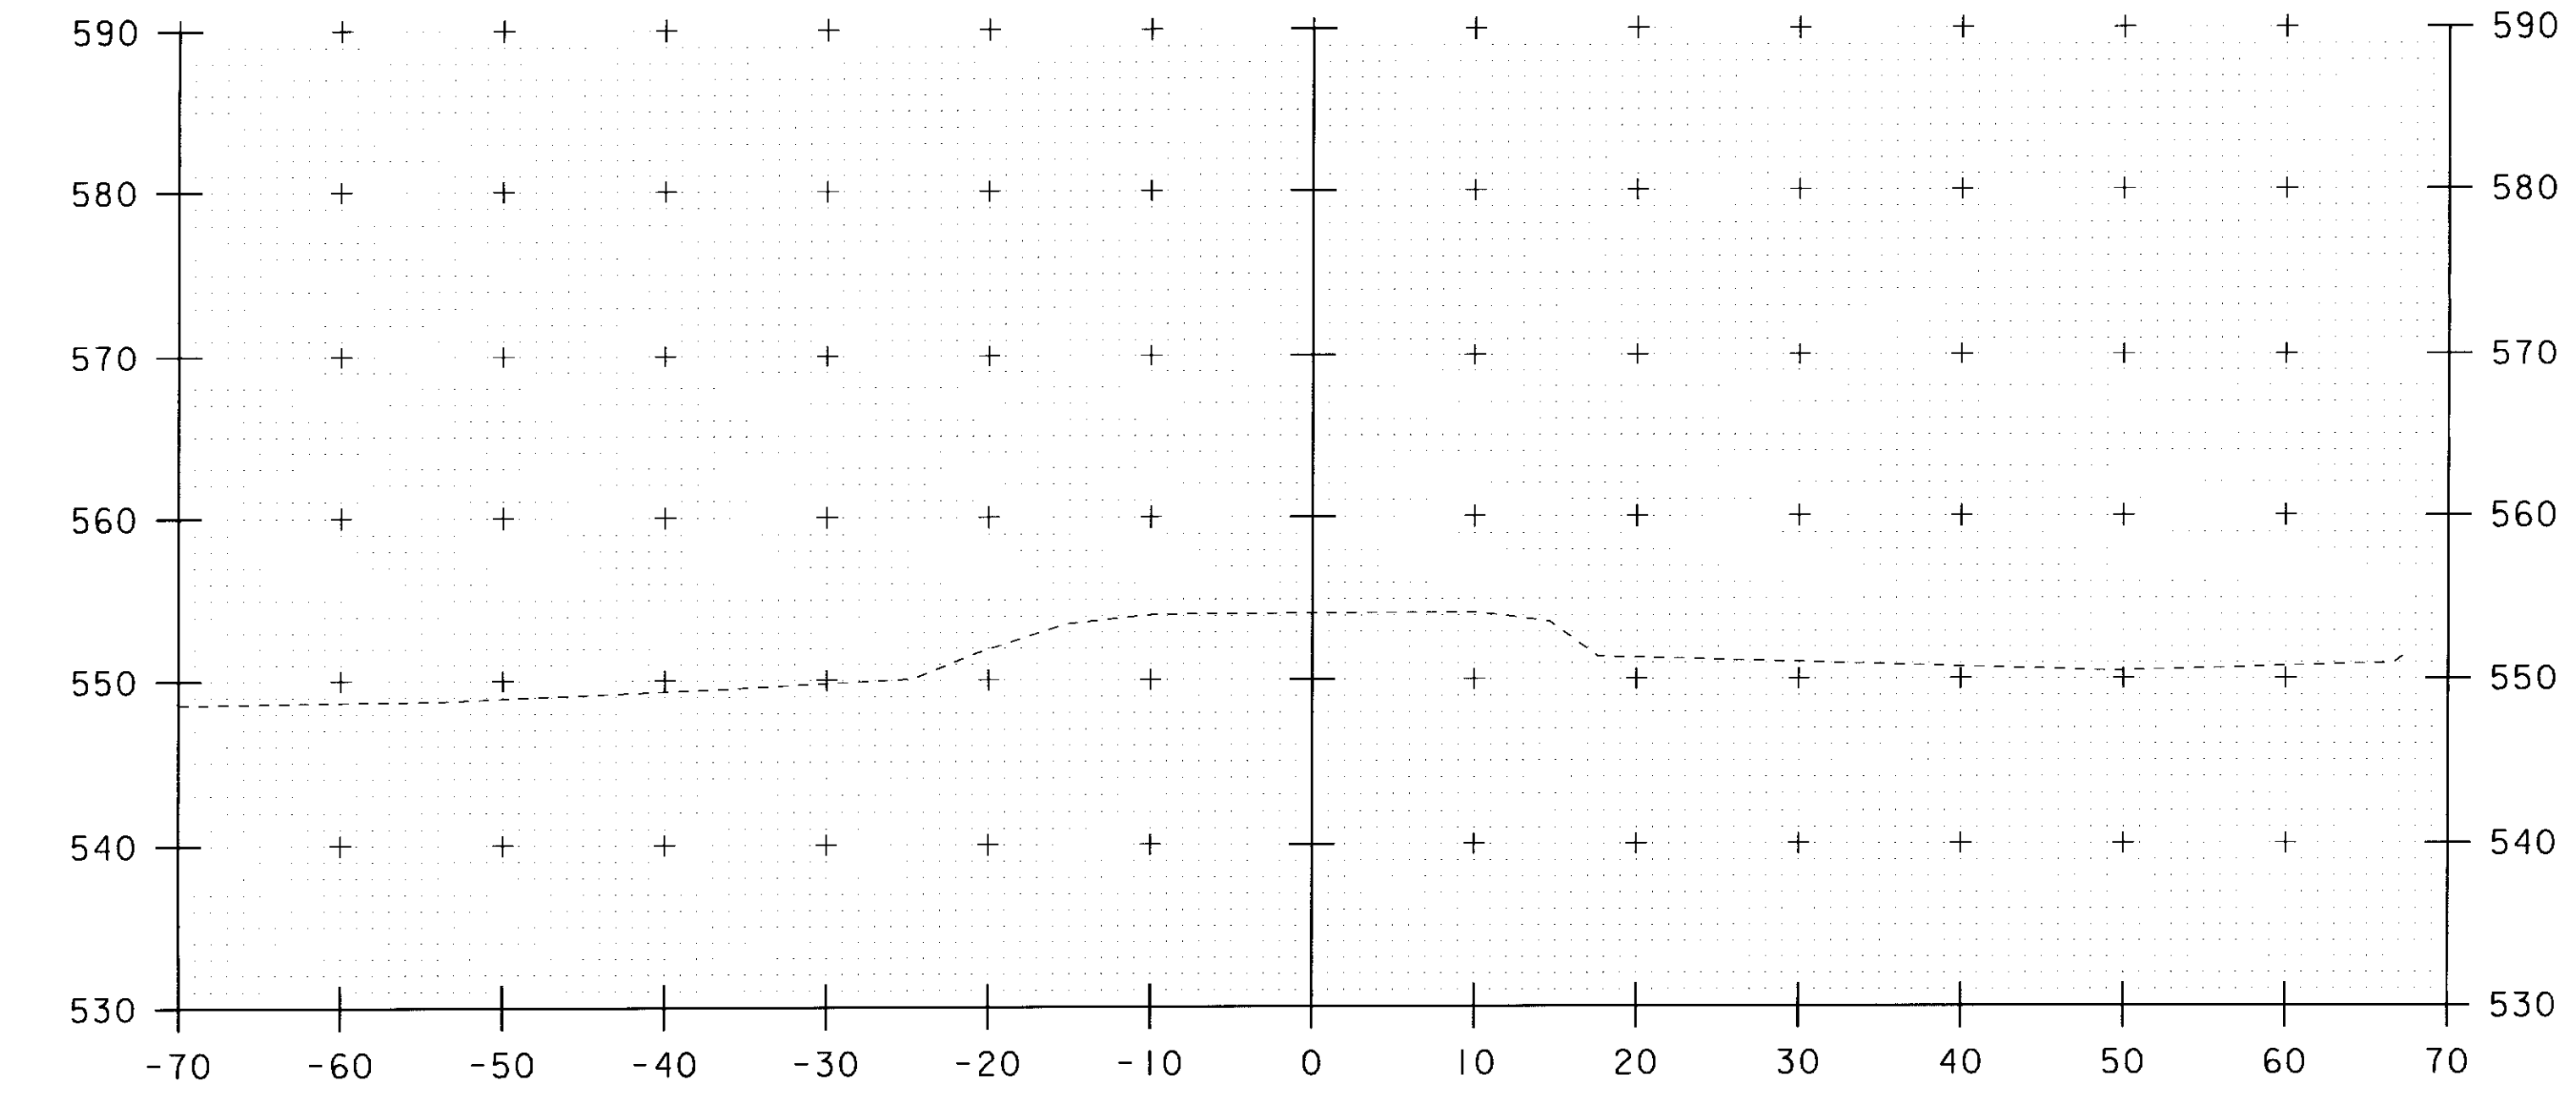

38+00

STA. 37+50 TO STA. 38+25

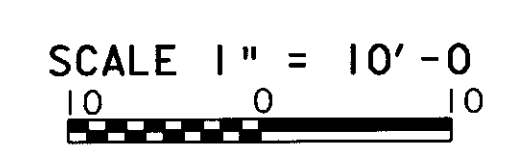

PROJECT NAME: JAMAICA	PLOT DATE: 23-SEP-2010
PROJECT NUMBER: BRO 1442(27)	DRAWN BY: R. PELLETT
FILE NAME: s96j068xsl.dgn	CHECKED BY: J. LACROIX
PROJECT LEADER: K. HIGGINS	ROADWAY CROSS SECTIONS #6
DESIGNED BY: J. LACROIX	SHEET 39 OF 45