



STA 3+72.50 LT & RT  
 BEGIN UNCLASSIFIED CHANNEL EXCAVATION  
 BEGIN GEOTEXTILE UNDER STONE FILL  
 BEGIN STONE FILL TYPE III  
 BEGIN GRUBBING MATERIAL (END 3+88)


3+80

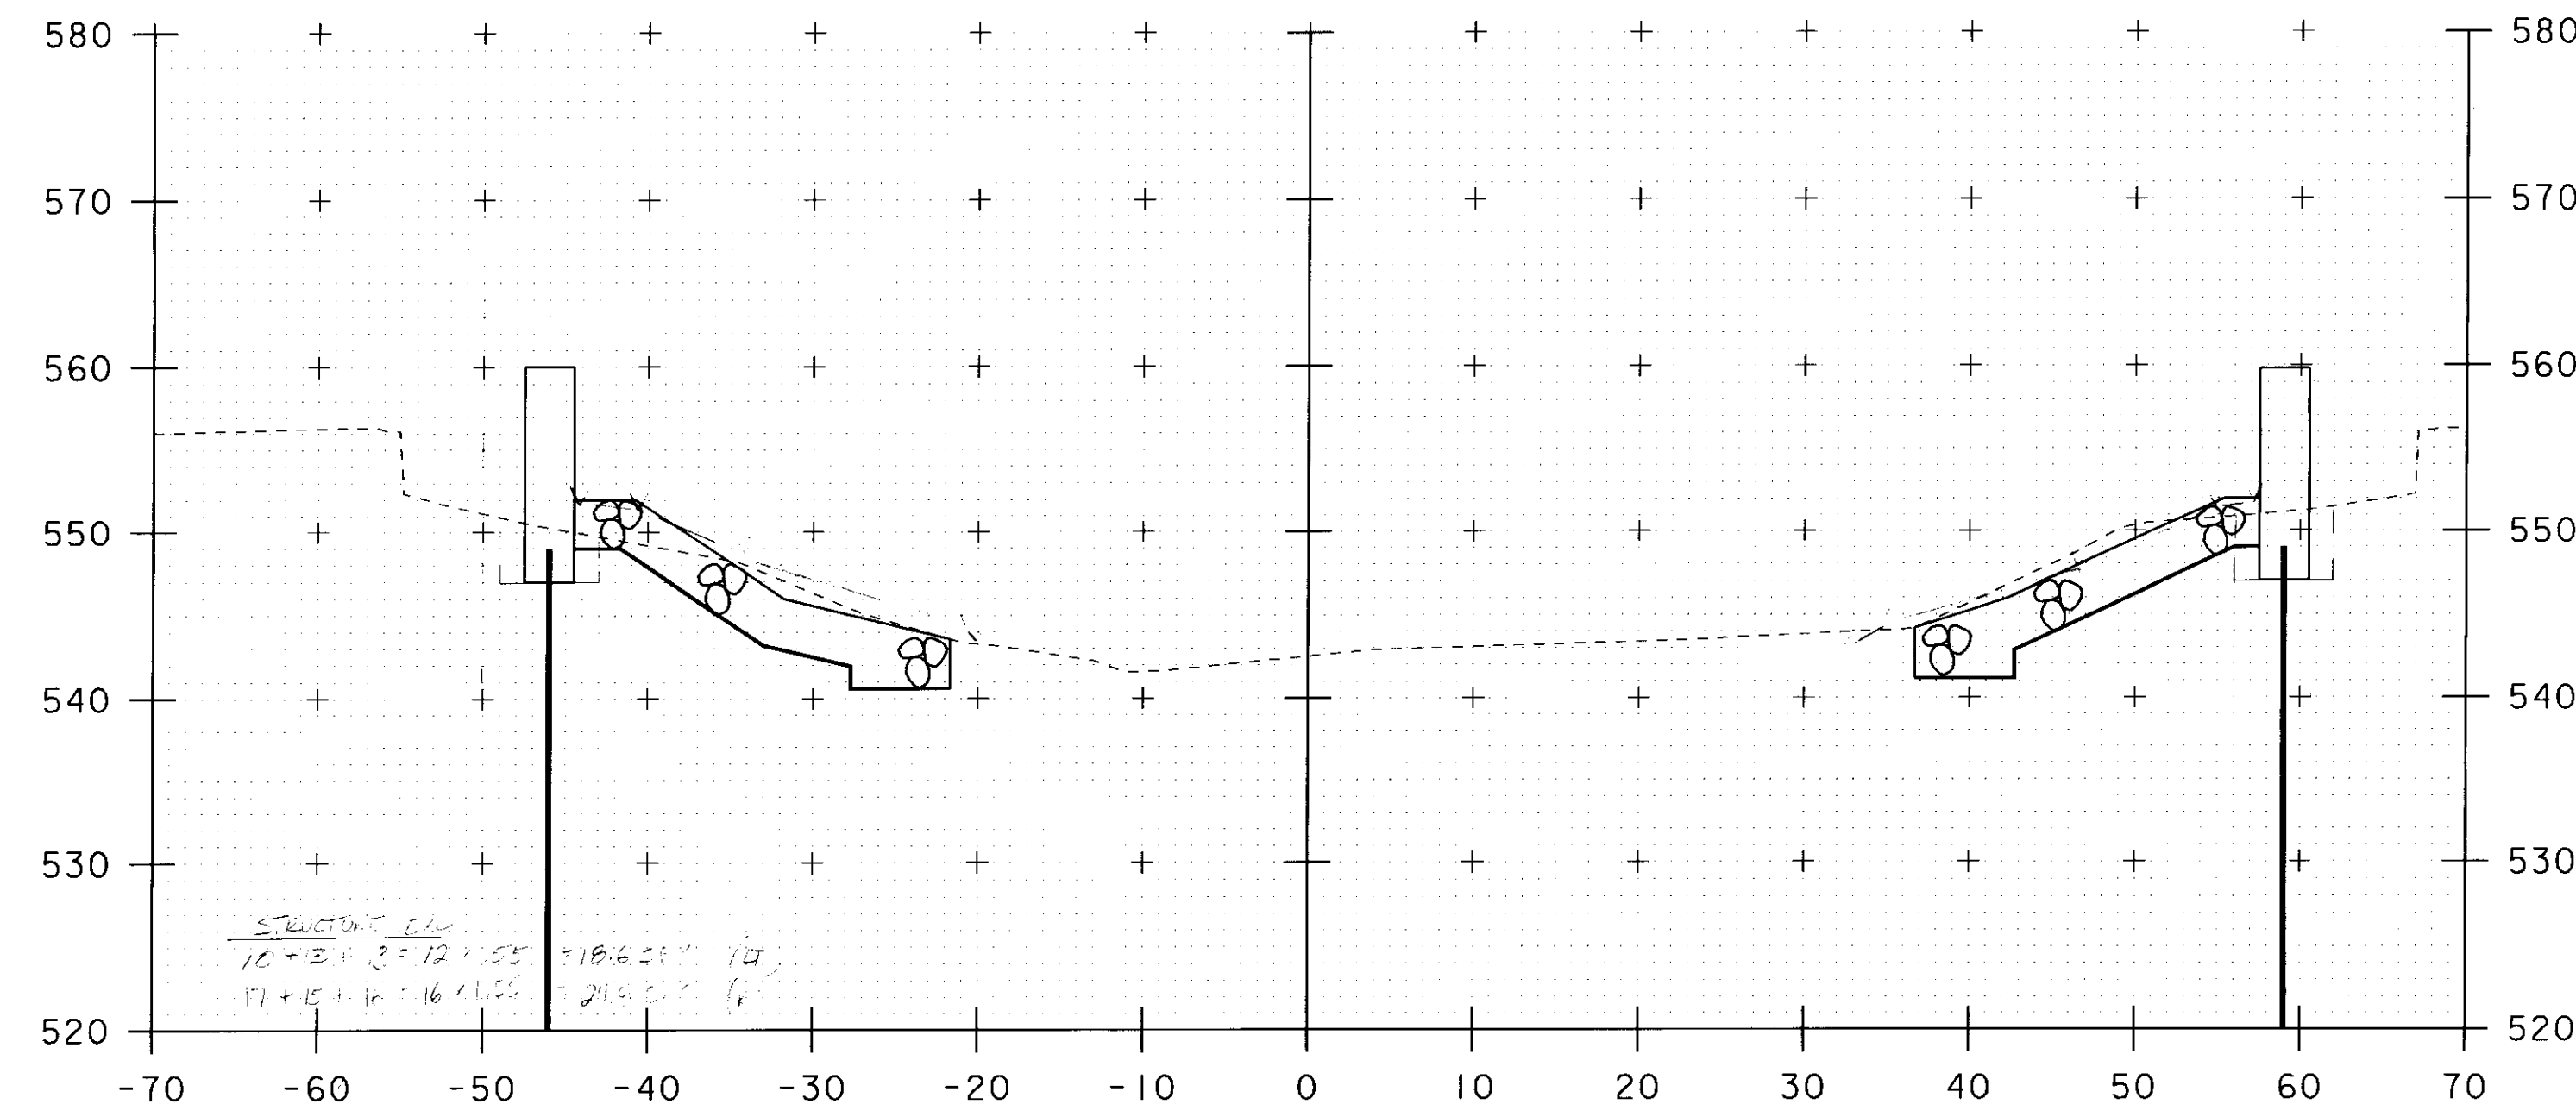

4+00

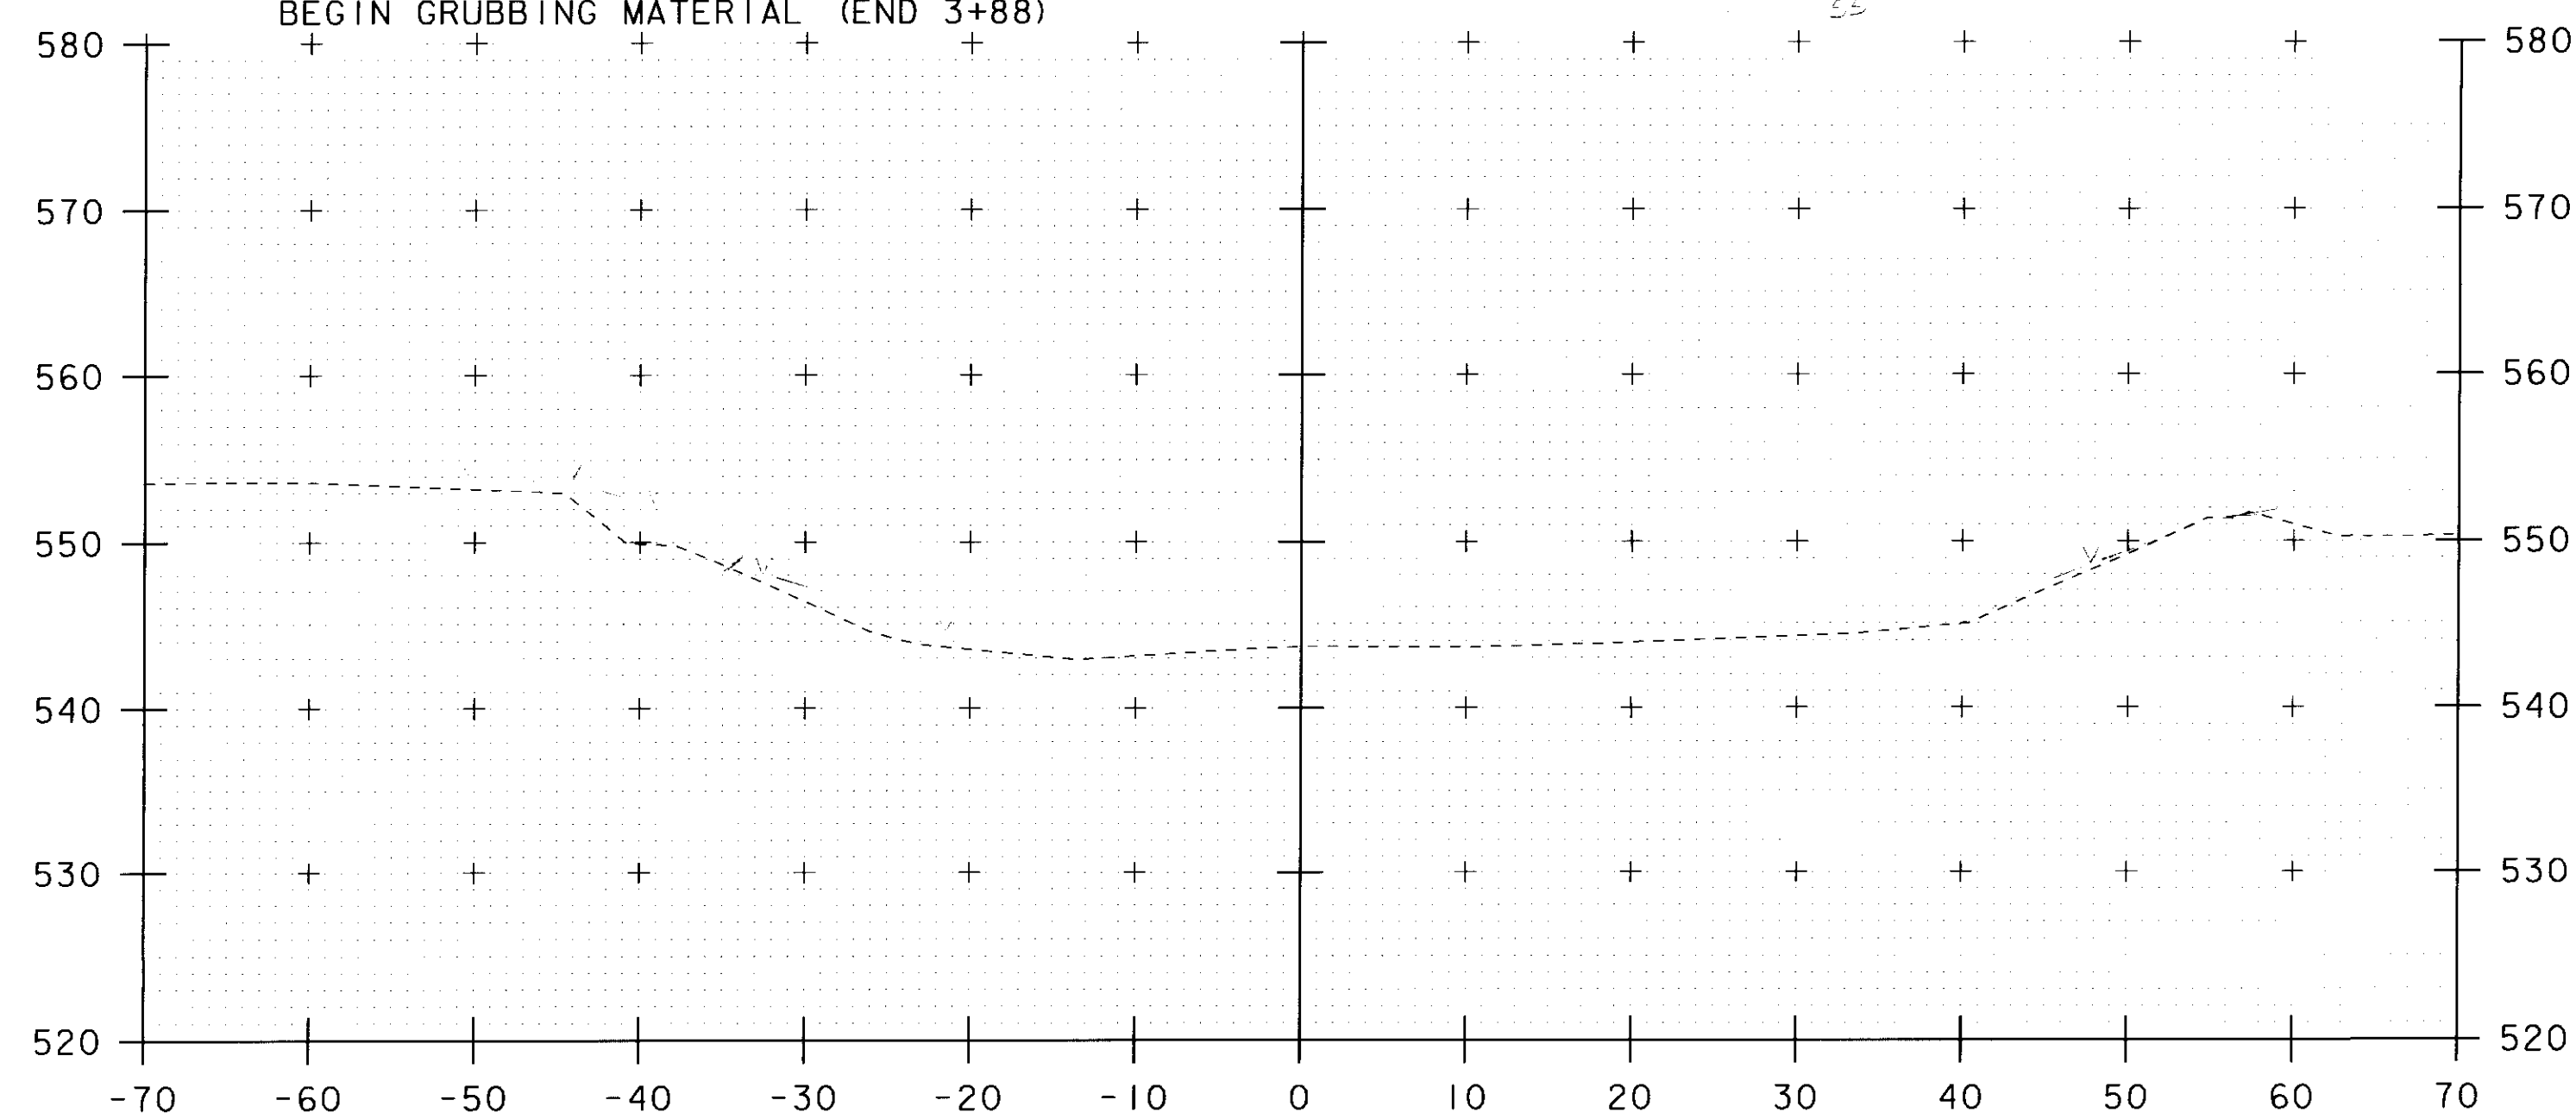

3+70

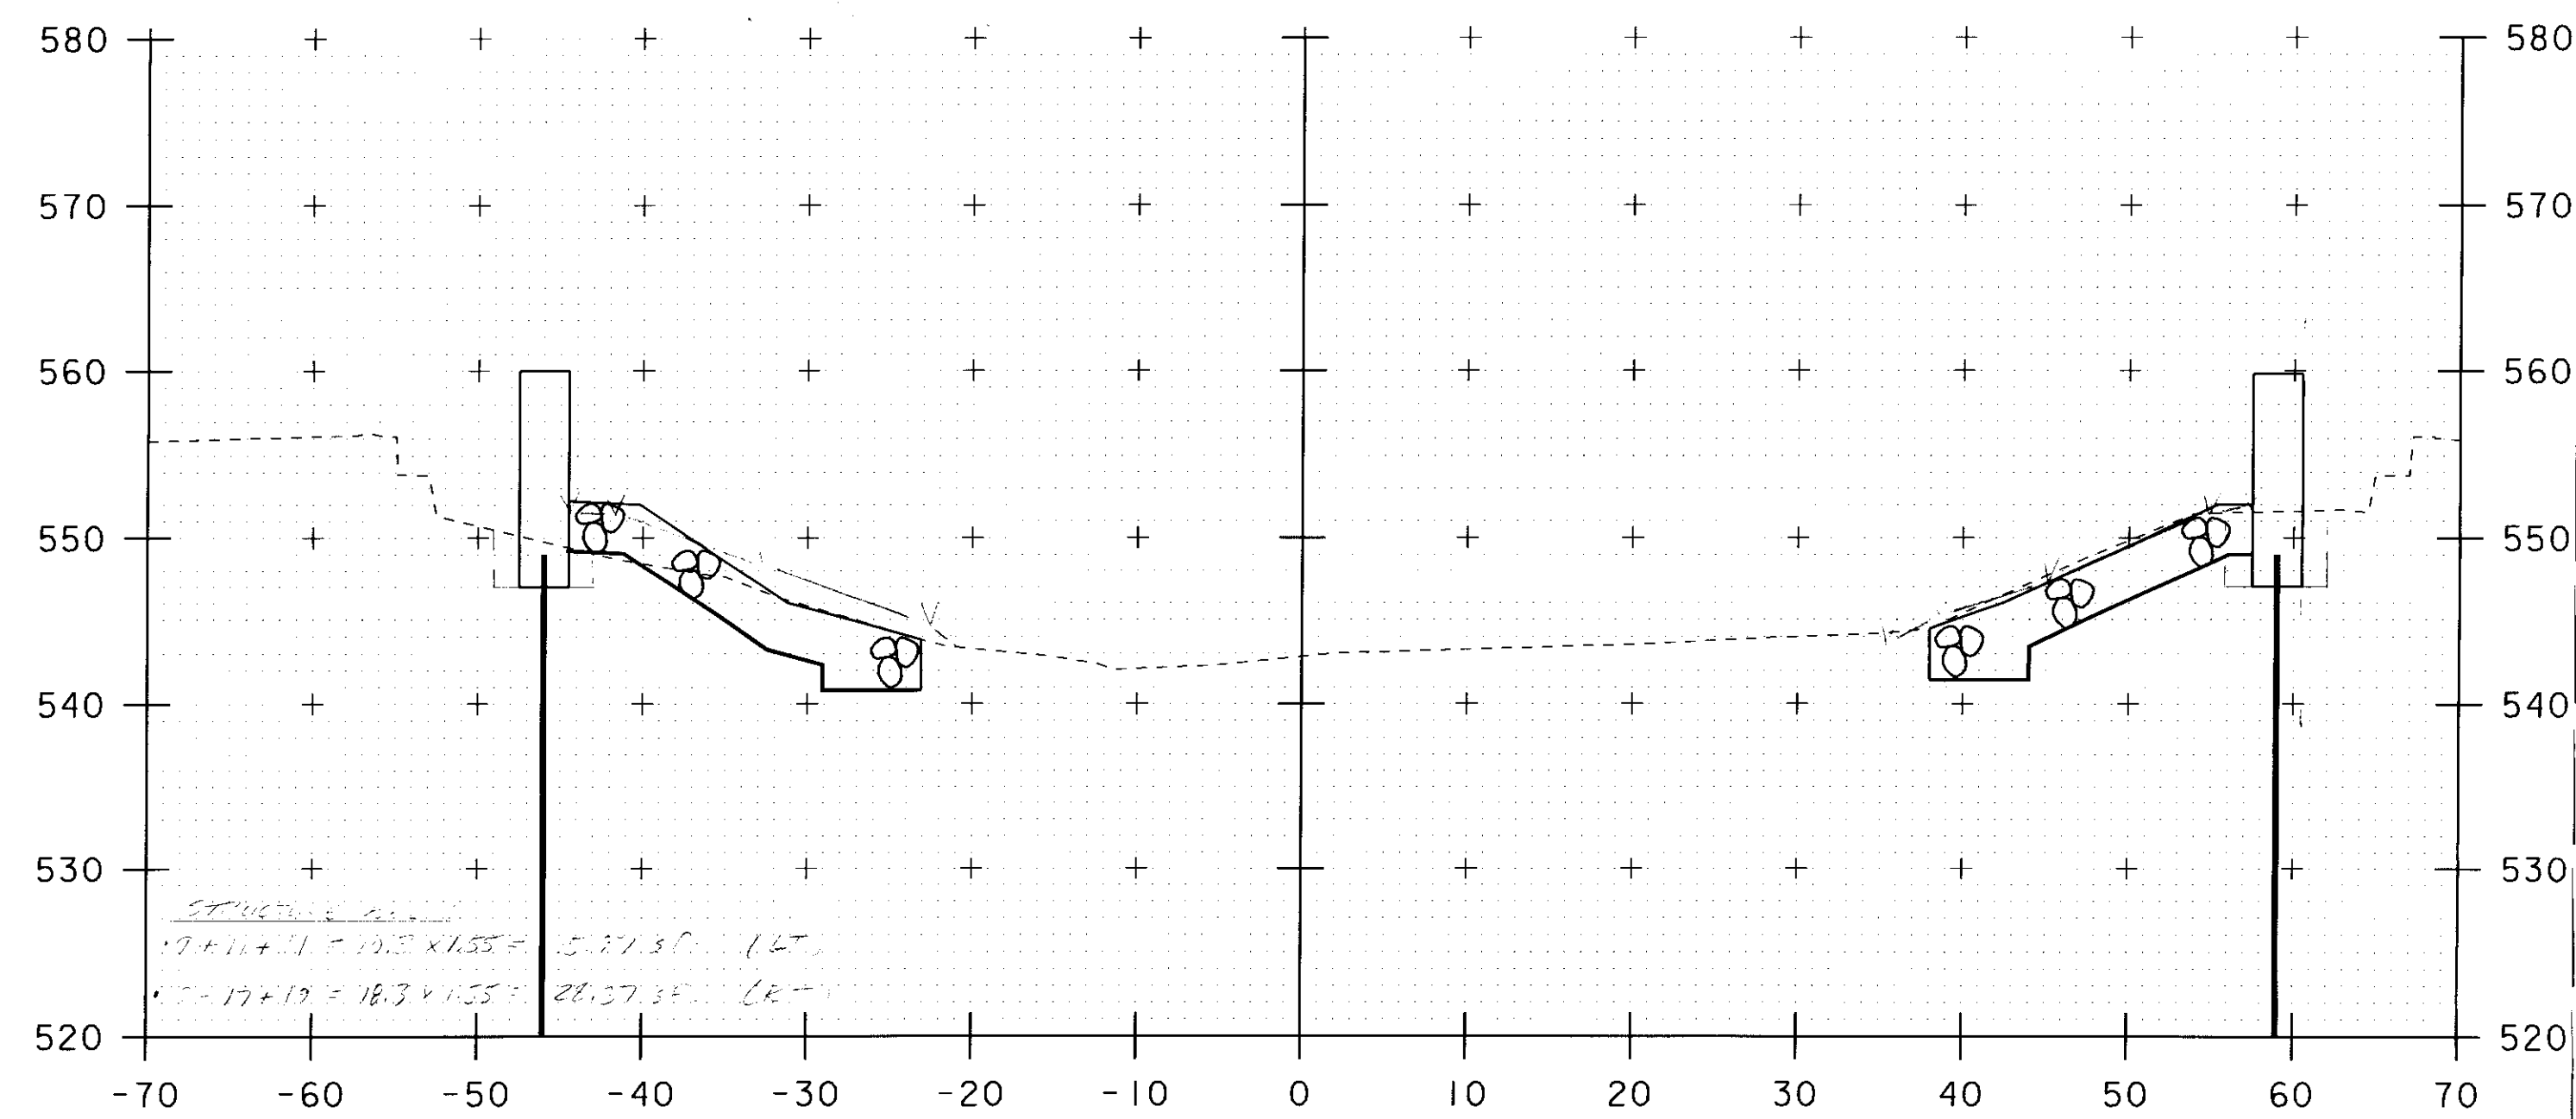

3+90

STA. 3+70 TO STA. 4+00

SCALE 1" = 10'-0"

PROJECT NAME: JAMAICA  
 PROJECT NUMBER: BRO 1442(27)

FILE NAME: s96J068xsl.dgn  
 PROJECT LEADER: K. HIGGINS  
 DESIGNED BY: J. LACROIX  
 CHANNEL CROSS SECTIONS #2

PLOT DATE: 23-SEP-2010  
 DRAWN BY: R. PELLETT  
 CHECKED BY: J. LACROIX  
 SHEET 41 OF 45