



STA 4+12 LT & RT
BEGIN GRUBBING MATERIAL


4+20

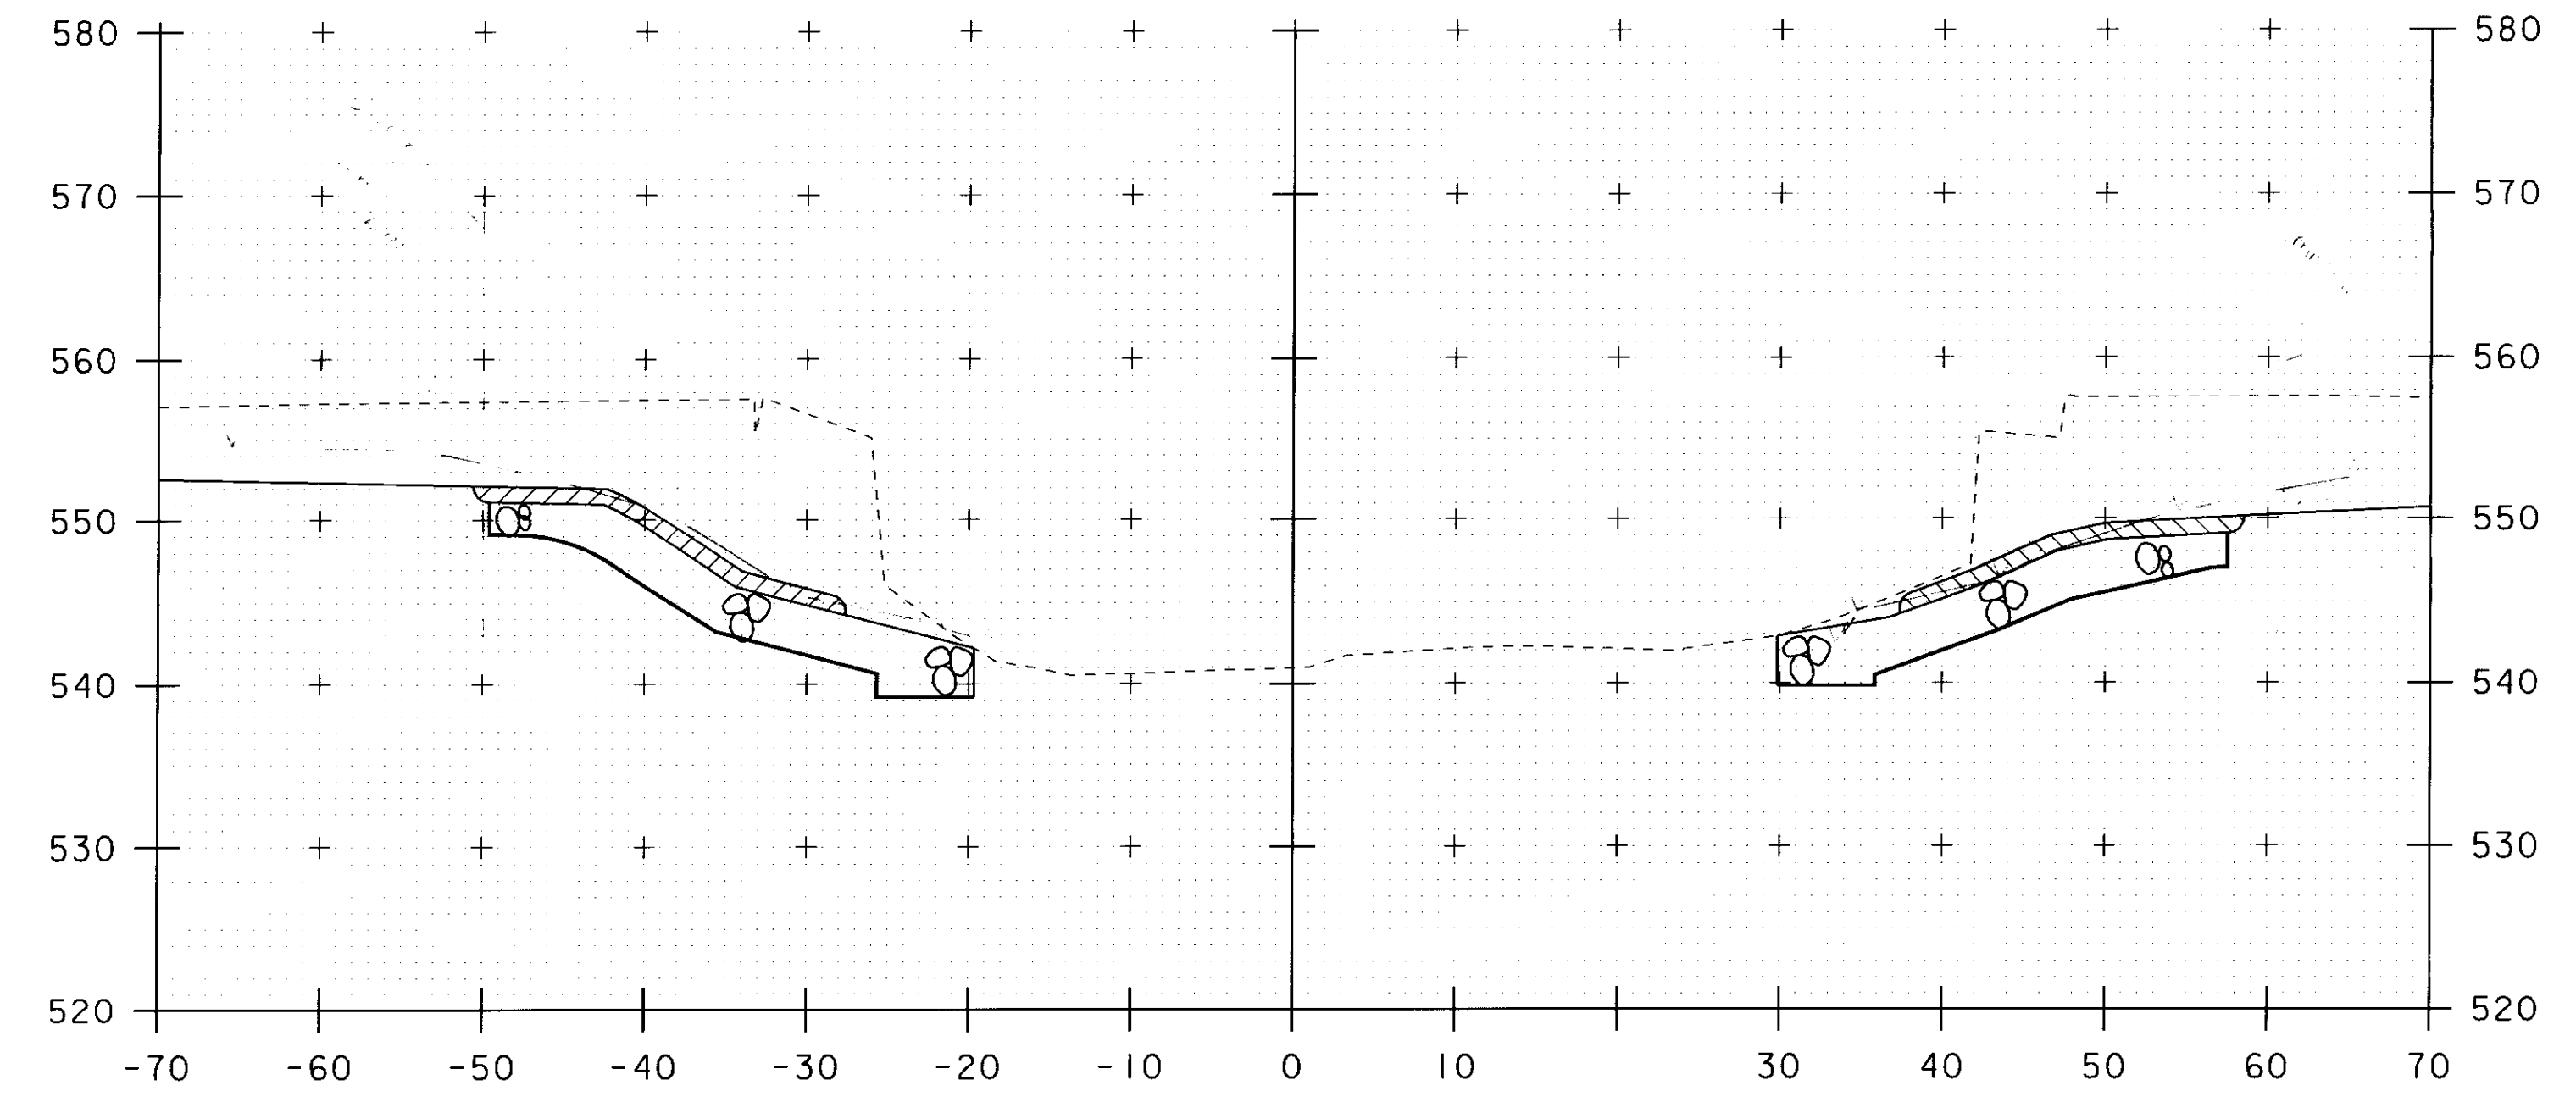

4+40

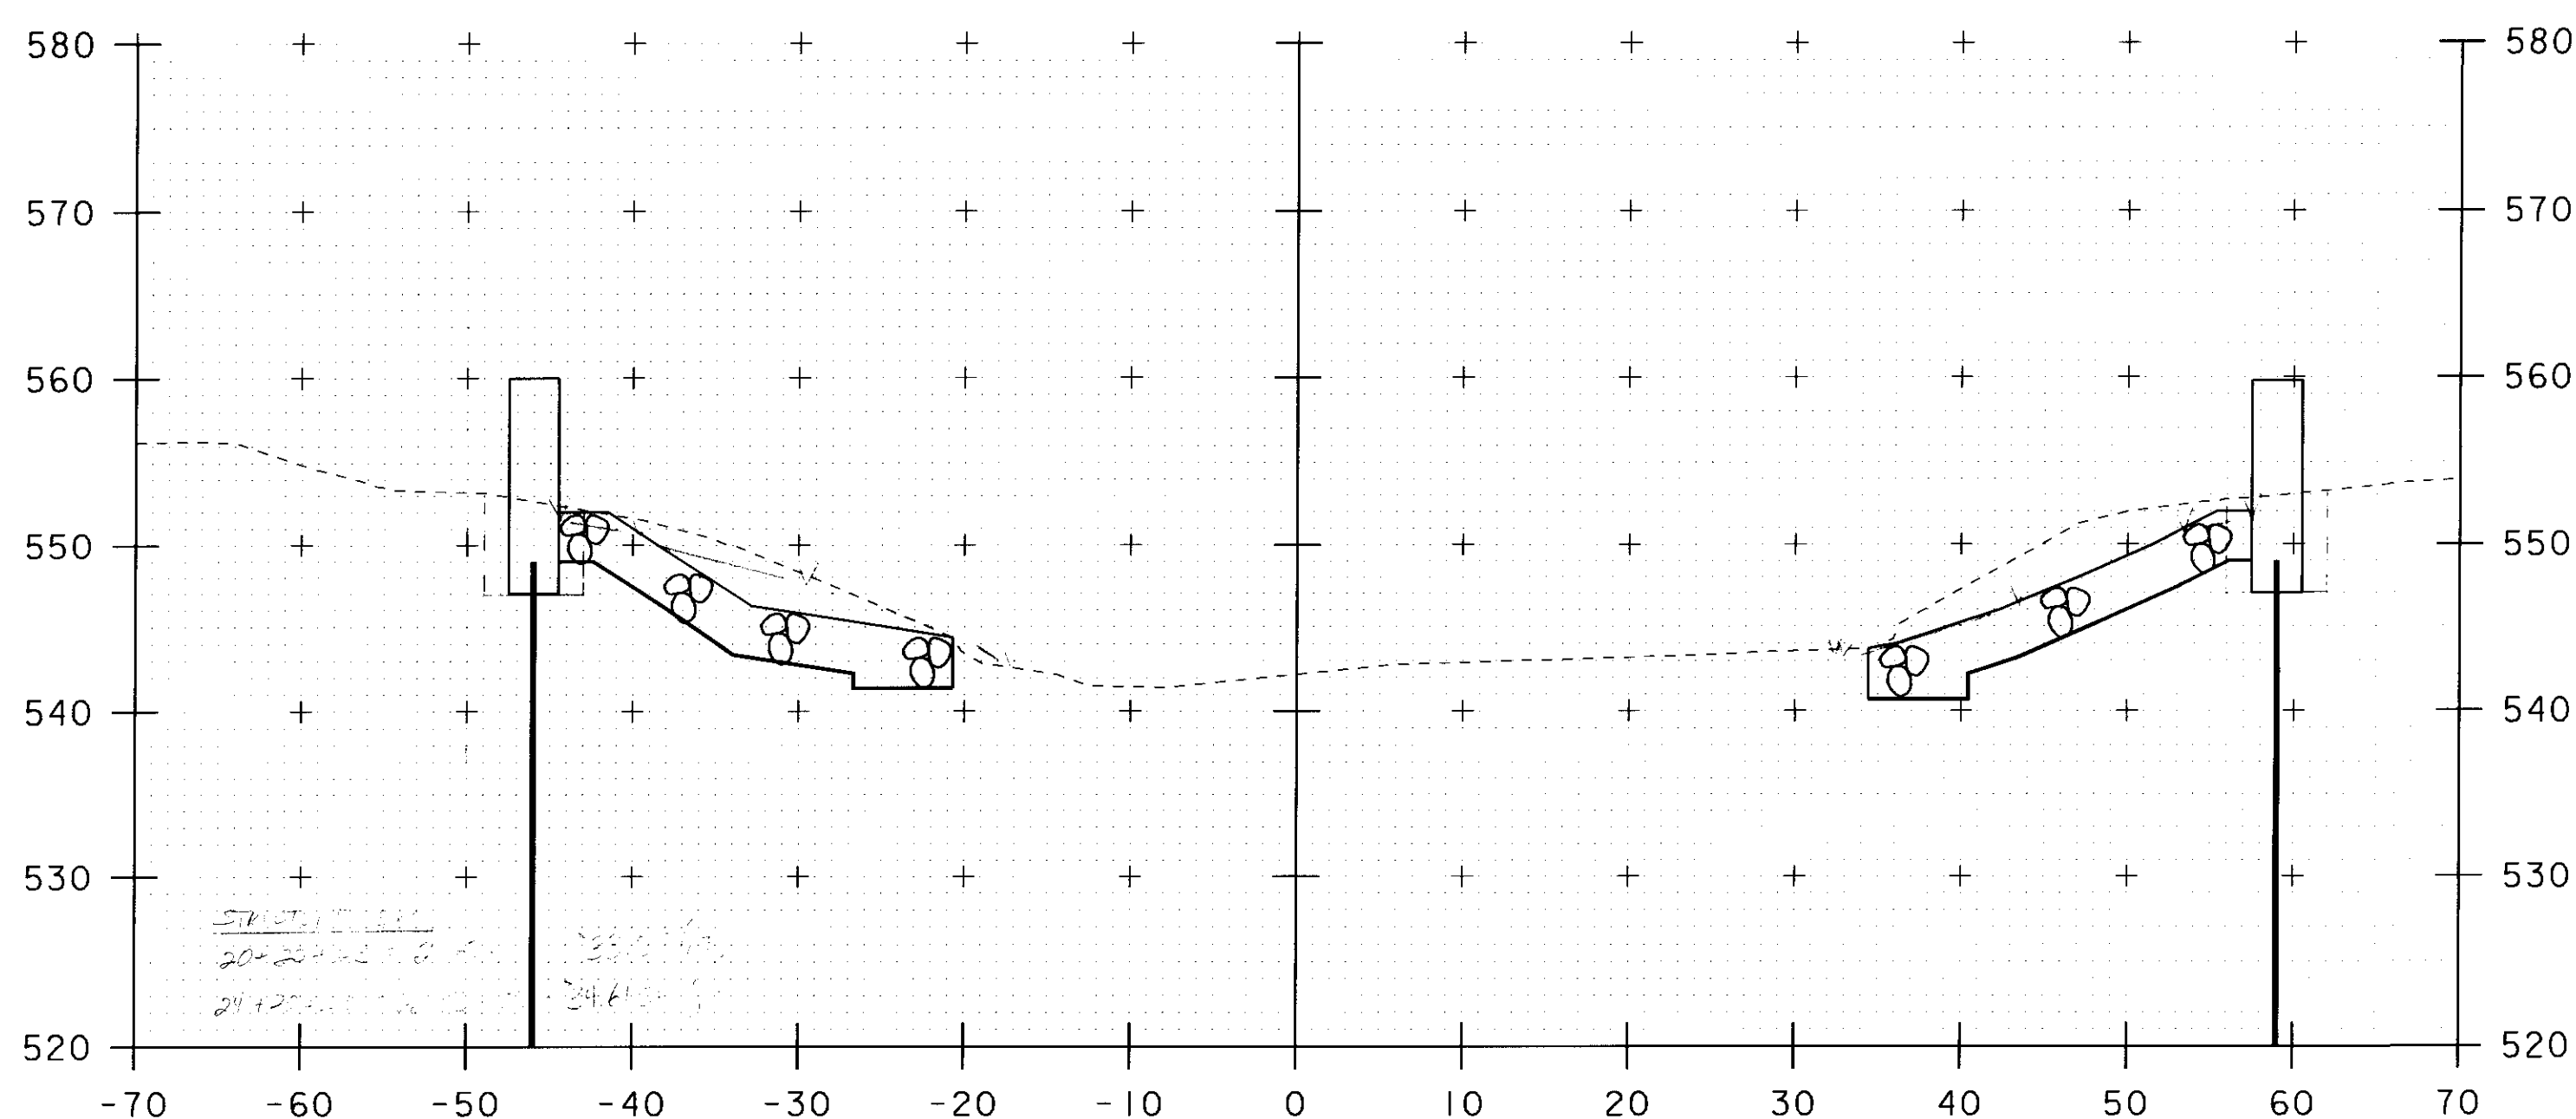


4+10

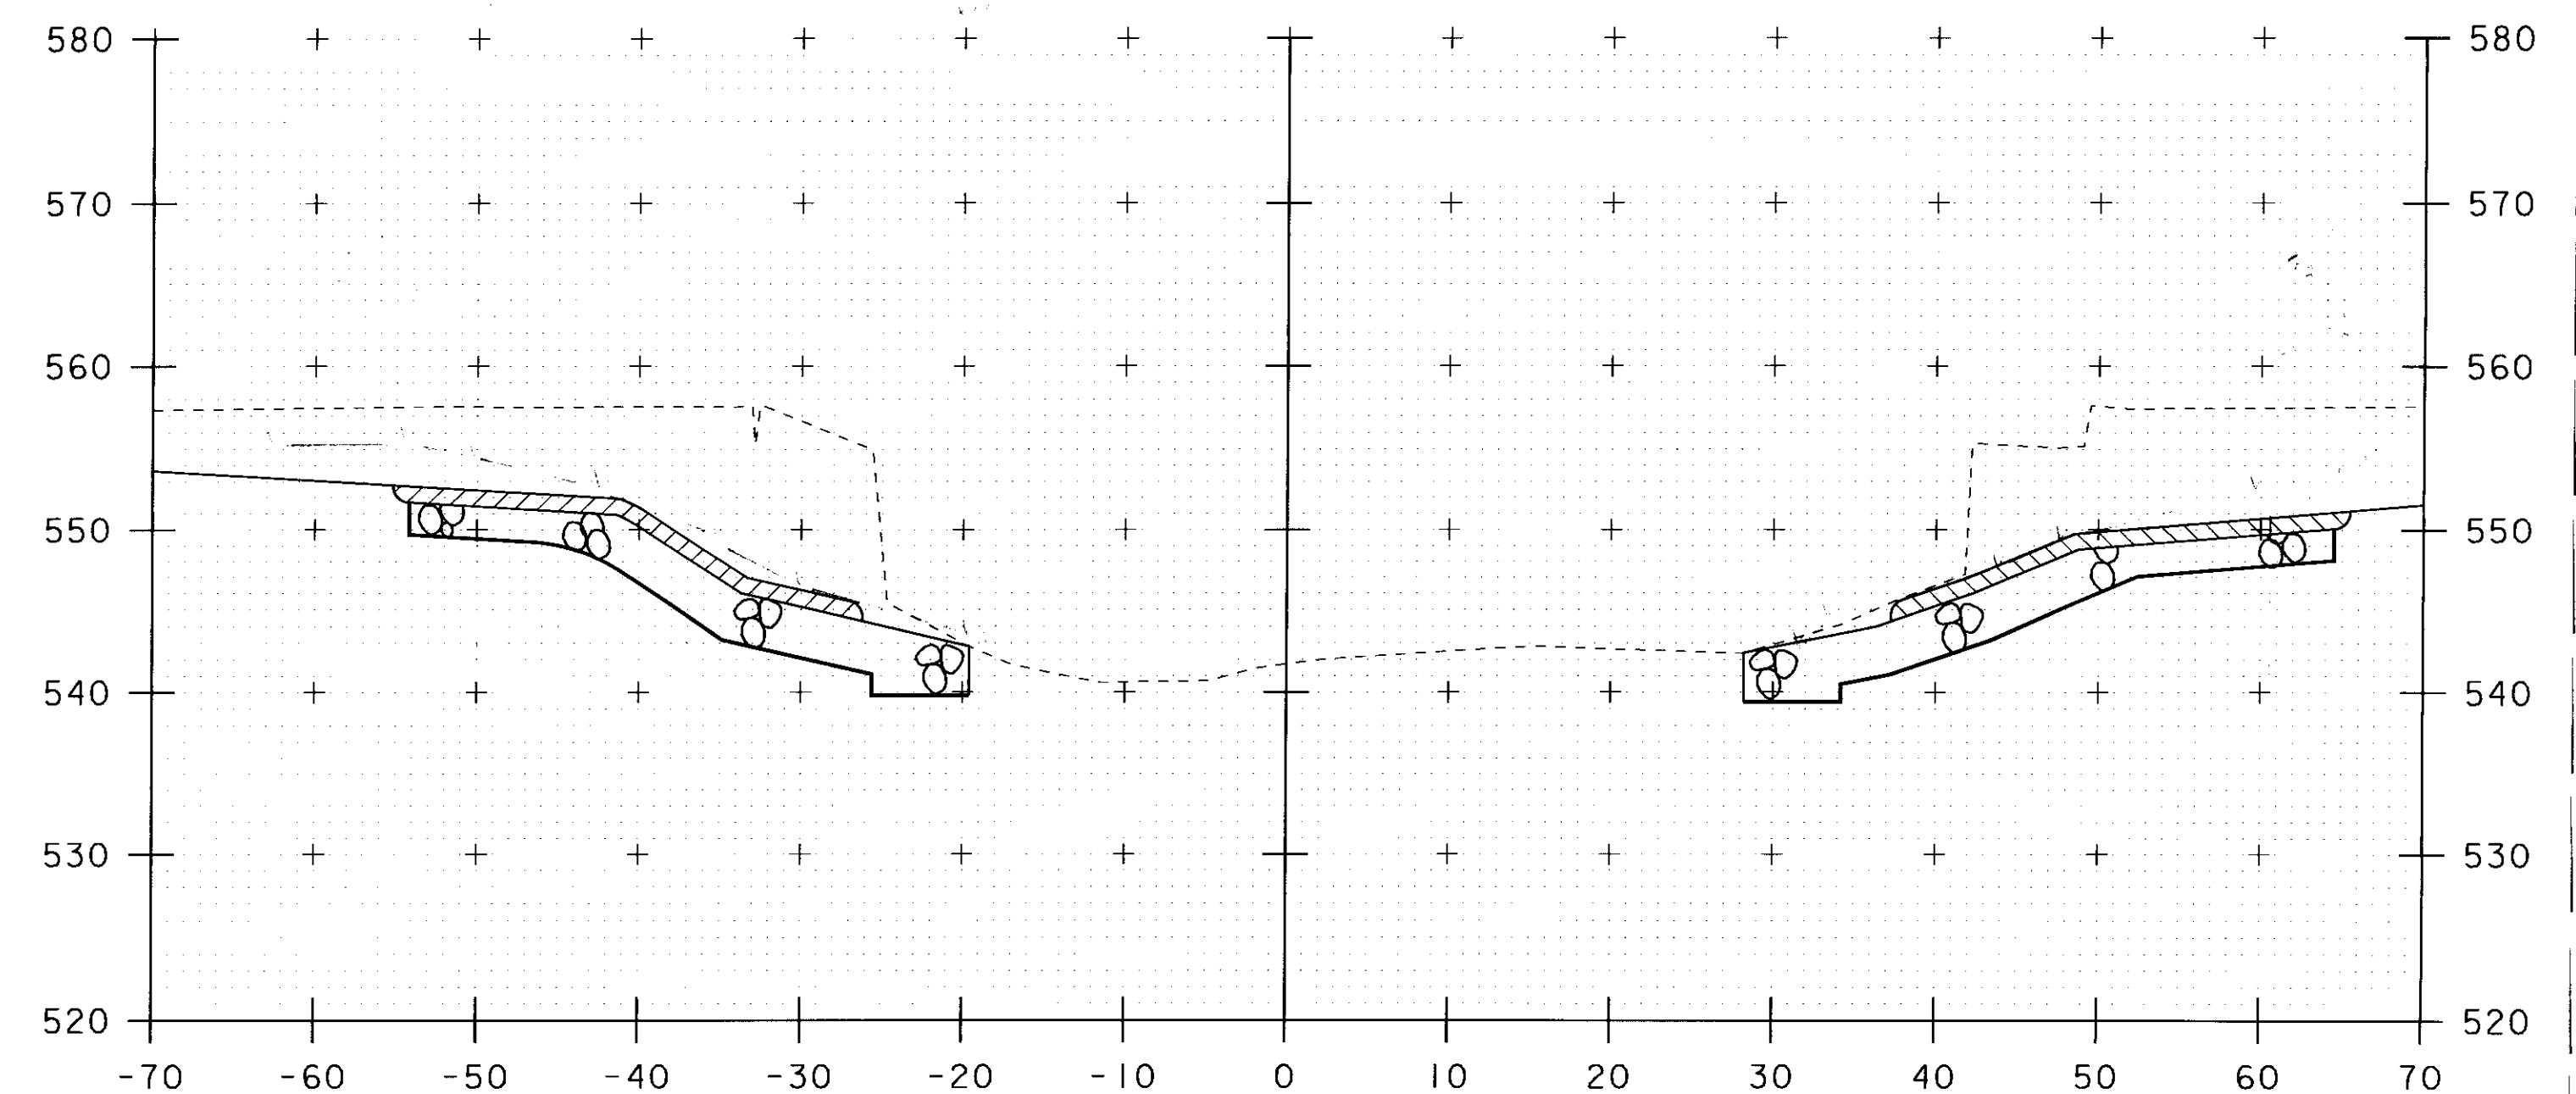

4+30

STA. 4+10 TO STA. 4+40

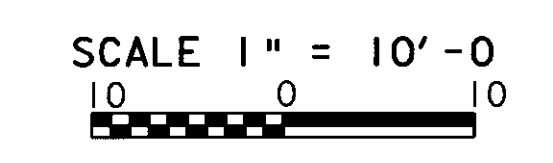

PROJECT NAME: JAMAICA	PLOT DATE: 23-SEP-2010
PROJECT NUMBER: BRO 1442(27)	DRAWN BY: R. PELLETT
FILE NAME: s96j068xsl.dgn	CHECKED BY: J. LACROIX
PROJECT LEADER: K. HIGGINS	SHEET 42 OF 45
DESIGNED BY: J. LACROIX	
CHANNEL CROSS SECTIONS #3	