



4+60

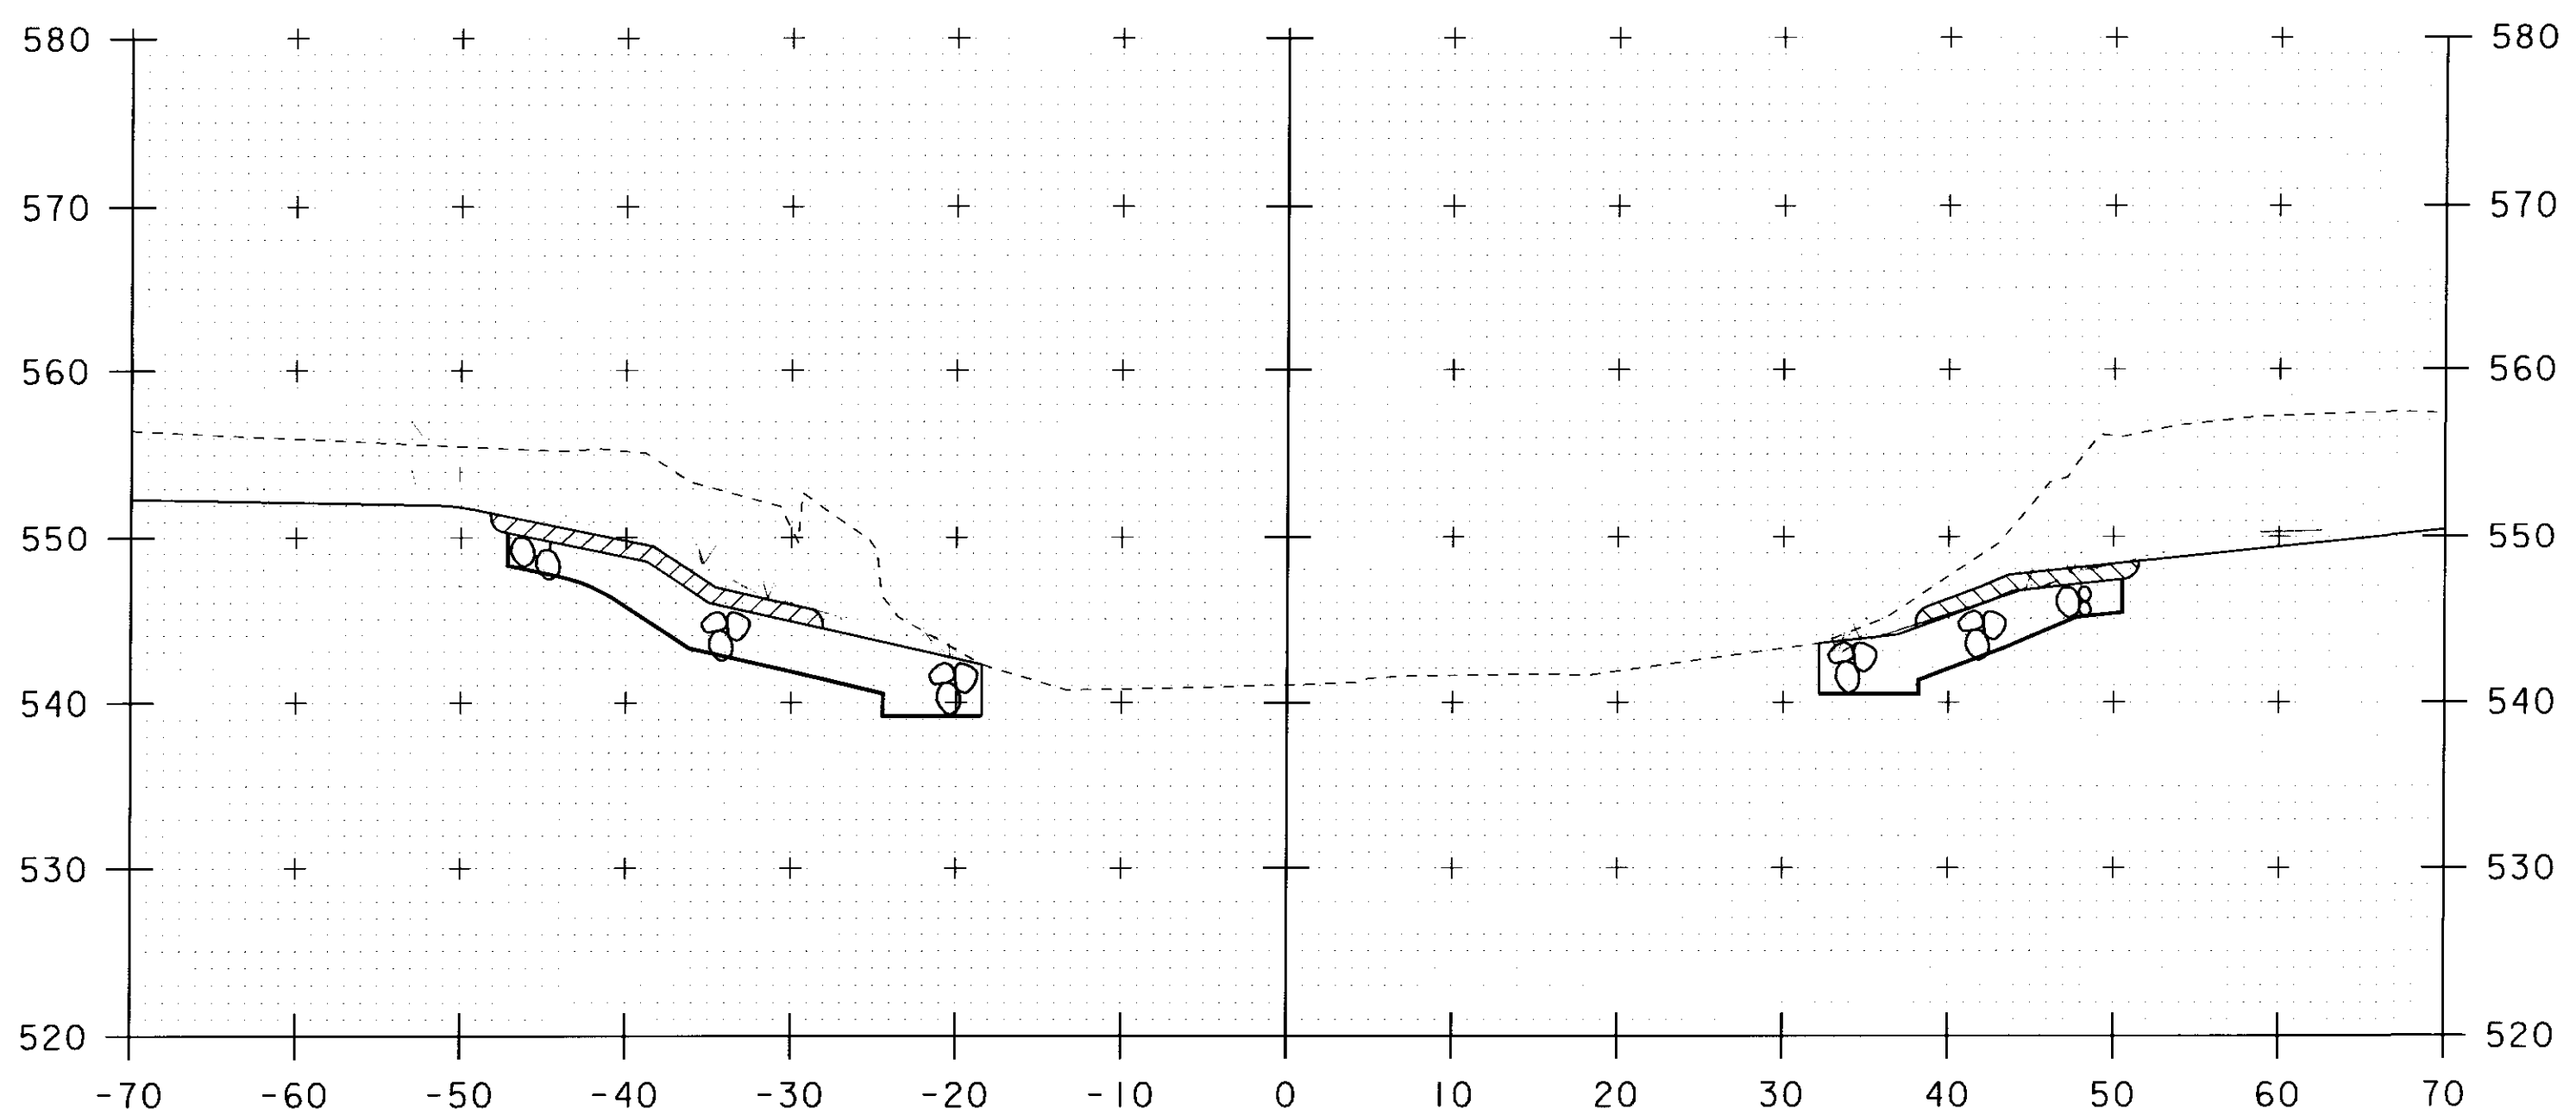


4+50

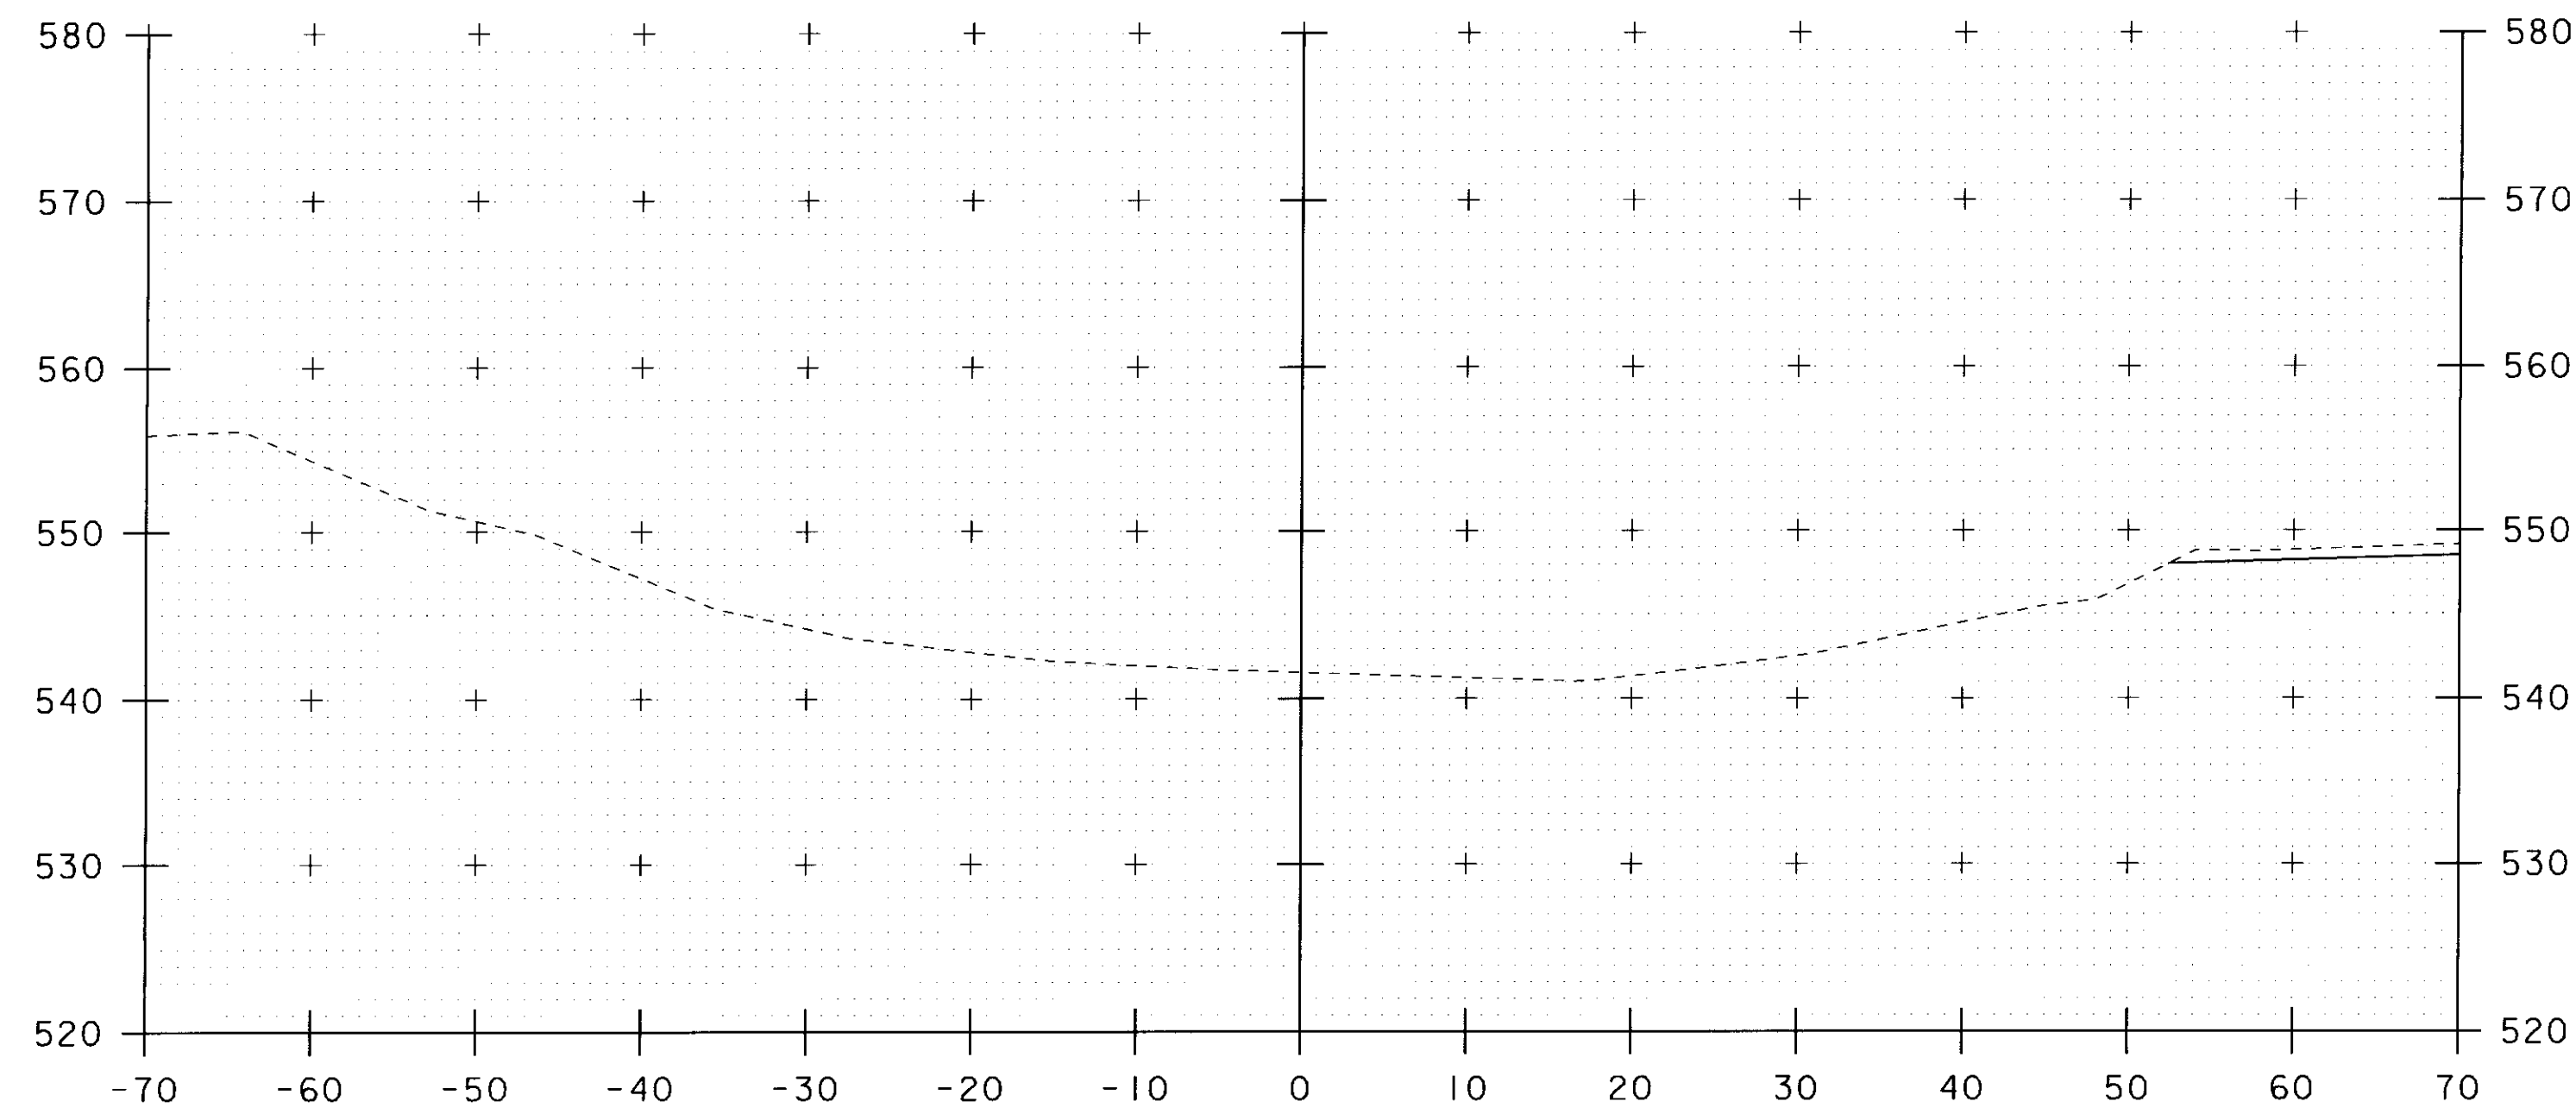

4+80

STA 4+75 RT
 END UNCLASSIFIED CHANNEL EXCAVATION
 END GEOTEXTILE UNDER STONE FILL
 END STONE FILL TYPE III
 END GRUBBING MATERIAL

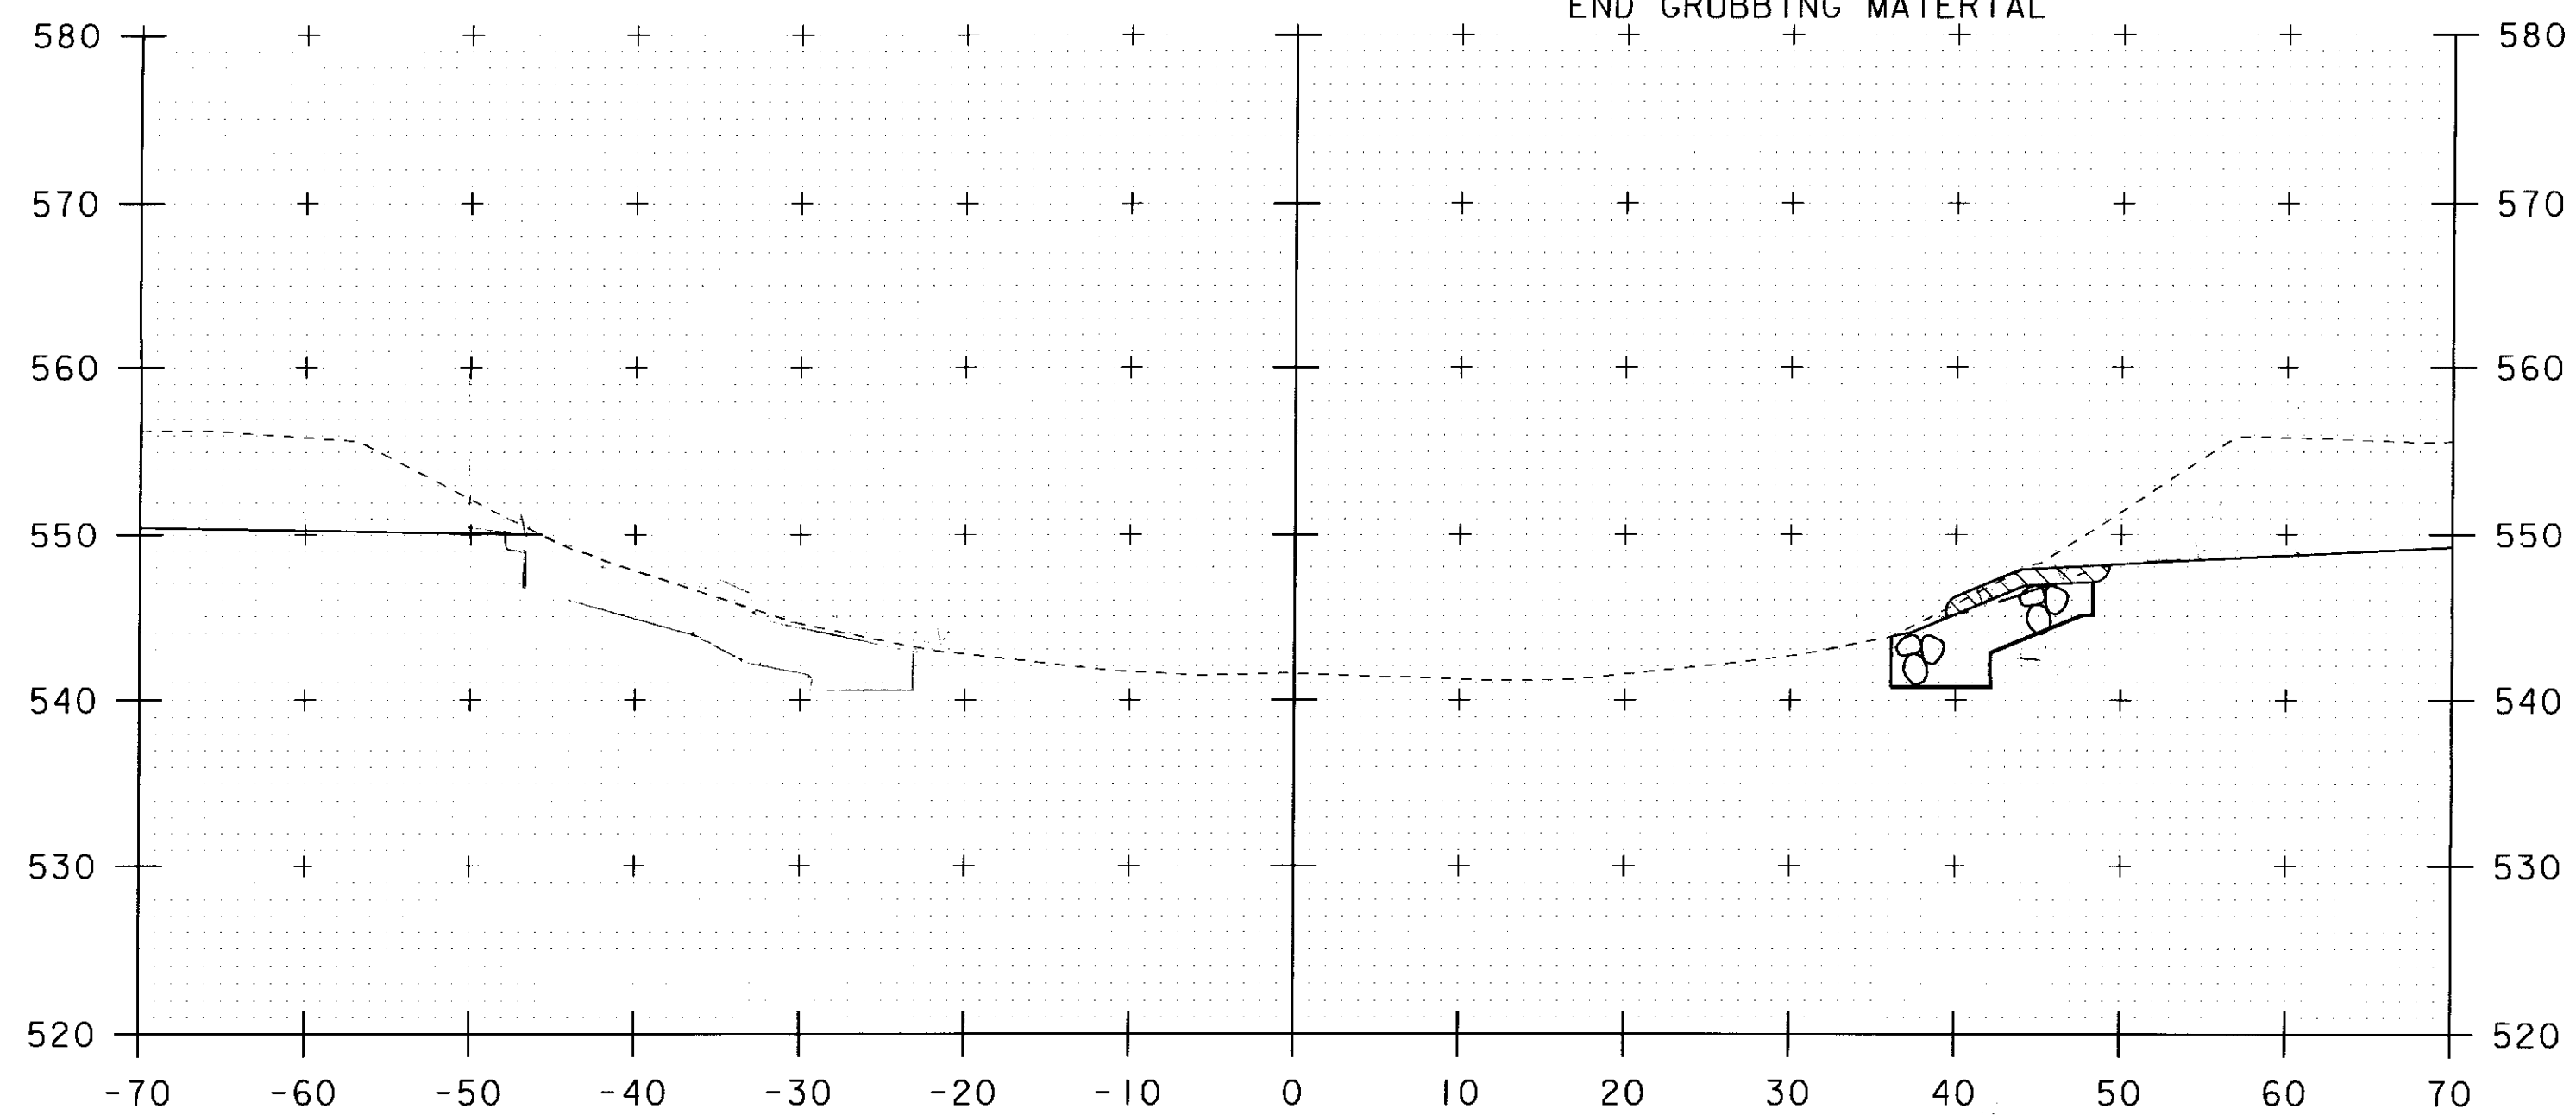

4+70

STA 4+66 LT
 END UNCLASSIFIED CHANNEL EXCAVATION
 END GEOTEXTILE UNDER STONE FILL
 END STONE FILL TYPE III
 END GRUBBING MATERIAL

STA. 4+50 TO STA. 4+80

SCALE 1" = 10'-0"
 10 0 10

PROJECT NAME: JAMAICA	PLOT DATE: 23-SEP-2010
PROJECT NUMBER: BRO 1442(27)	DRAWN BY: R. PELLETT
FILE NAME: s96j068xsl.dgn	CHECKED BY: J. LACROIX
PROJECT LEADER: K. HIGGINS	SHEET 43 OF 45
DESIGNED BY: J. LACROIX	
CHANNEL CROSS SECTIONS *4	