


STATE OF VERMONT AGENCY OF TRANSPORTATION



PROPOSED IMPROVEMENT BRIDGE PROJECT TOWN OF STAMFORD COUNTY OF BENNINGTON

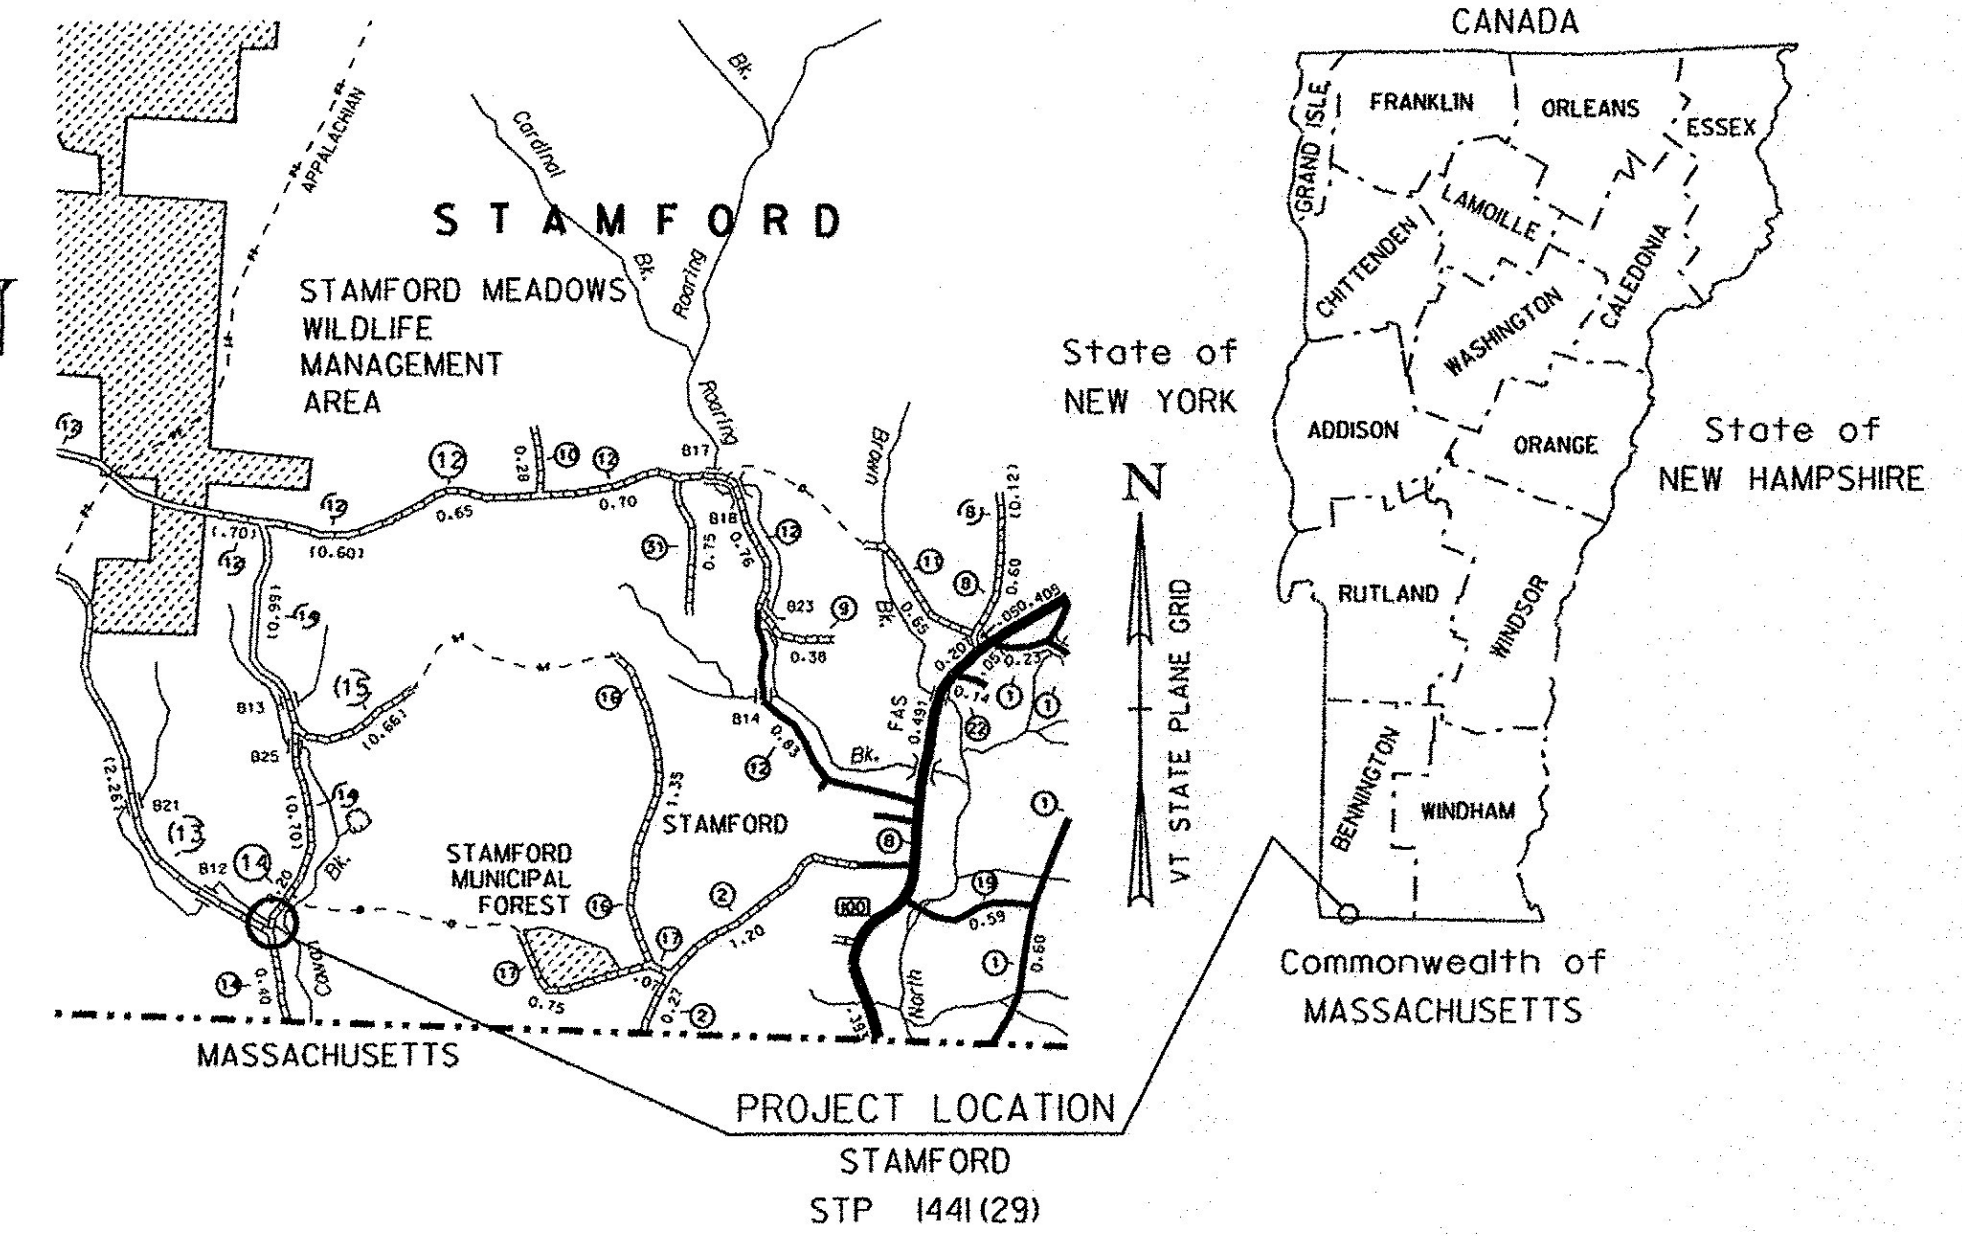


RECORD PLANS	
CONTRACTOR:	NORTHERN CONSTRUCTION SERVICE - WEYMOUTH, MA
RESIDENT ENGINEER:	RON LEMAIRE
CONSTRUCTION BEGAN:	JUNE 17, 2016
CONSTRUCTION COMPLETE:	JUNE 21, 2017
RECORD PLANS BY:	RON LEMAIRE & AARON WEAVER
I HEREBY CERTIFY THAT ALL THE CONSTRUCTION REQUIRED BY THIS SET OF DRAWINGS HAS BEEN ACCOMPLISHED AS INDICATED HEREIN.	
BY <u>Judy A. Lemaire</u>	RESIDENT ENGINEER
DATE <u>7/1/18</u>	
NOTE: Any further information concerning final quantities, amounts or other details relative to this project may be found at Central Files in the electronic archives.	

ROUTE NO : TH 14 CLASS III BRIDGE NO : 26

PROJECT LOCATION : BEGINNING AT A POINT ON TH 14 APPROXIMATELY 650 FEET NORTH OF THE INTERSECTION OF TOWN HIGHWAY 13 AND TOWN HIGHWAY 14 OVER AN UNNAMED BROOK.

PROJECT DESCRIPTION : THIS PROJECT WILL CONSIST OF THE REPLACEMENT OF THE EXISTING STRUCTURE WITH RELATED ROADWAY APPROACH AND CHANNEL WORK.

LENGTH OF STRUCTURE : 32.5 FEET.
 LENGTH OF ROADWAY : 192.5 FEET.
 LENGTH OF PROJECT : 225.0 FEET.

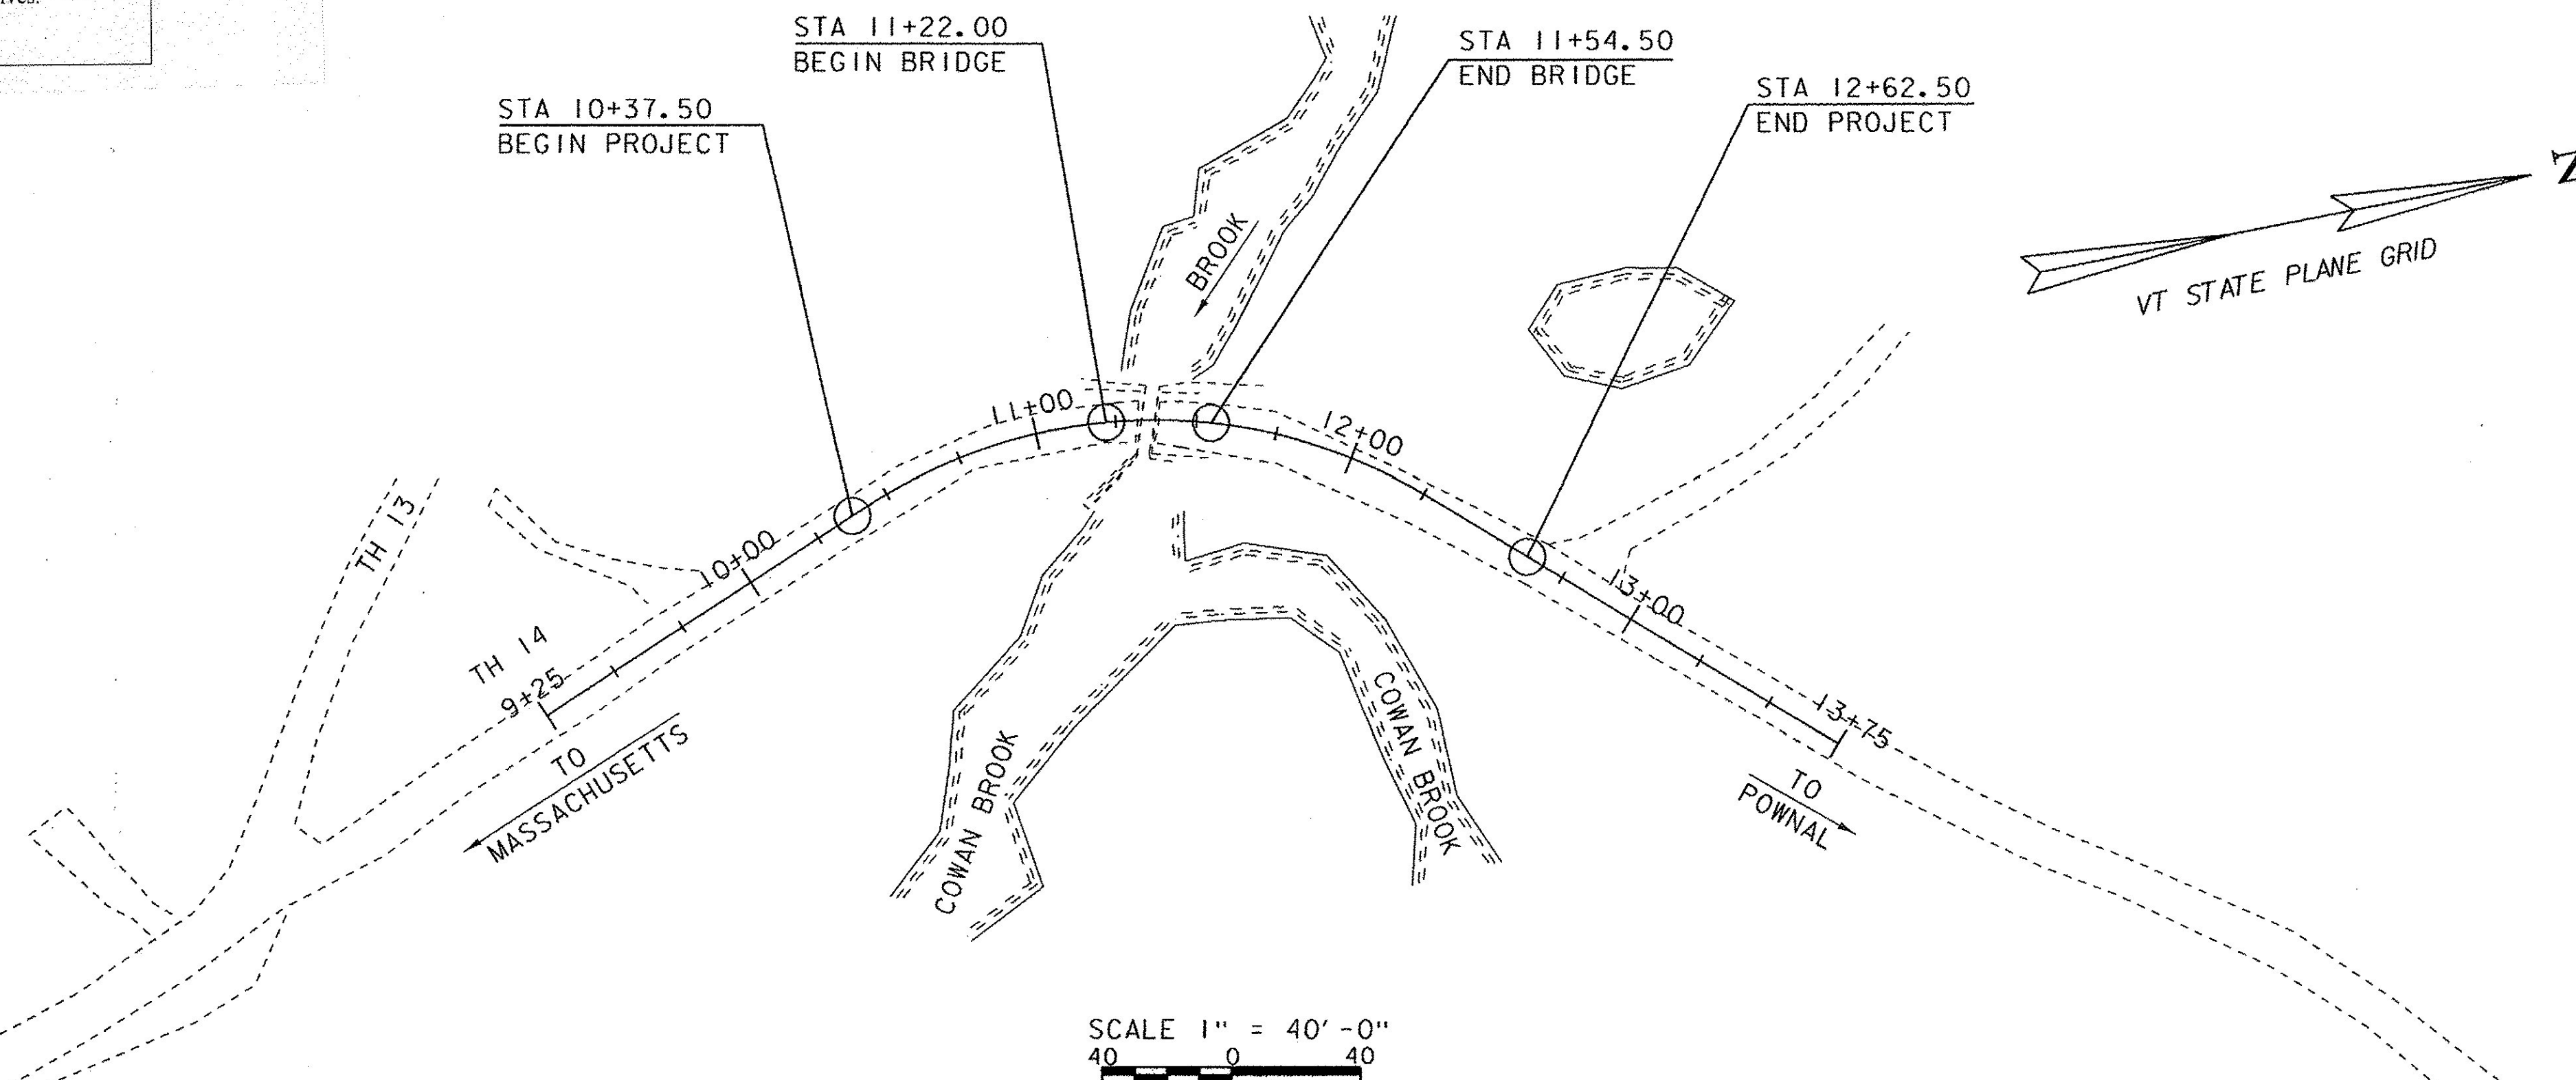

CONSTRUCTION IS TO BE CARRIED ON IN ACCORDANCE WITH THESE PLANS AND THE STANDARD SPECIFICATIONS FOR CONSTRUCTION DATED 2011, AS APPROVED BY THE FEDERAL HIGHWAY ADMINISTRATION ON JULY 20, 2011 FOR USE ON THIS PROJECT, INCLUDING ALL SUBSEQUENT REVISIONS AND SUCH REVISED SPECIFICATIONS AND SPECIAL PROVISIONS AS ARE INCORPORATED IN THESE PLANS.

QUALITY ASSURANCE PROGRAM : LEVEL 2	
SURVEYED BY :	L. ORVIS
SURVEYED DATE :	AUGUST 1997
DATUM	
VERTICAL	NAVD 88
HORIZONTAL	NAD 83 (1992)

DIRECTOR OF PROJECT DELIVERY	
APPROVED <u>[Signature]</u>	DATE <u>12/7/2015</u>
PROJECT MANAGER : CAROLYN W. CARLSON, P. E.	
PROJECT NAME : STAMFORD	
PROJECT NUMBER : STP 1441 (29)	
SHEET 1 OF 44 SHEETS	