

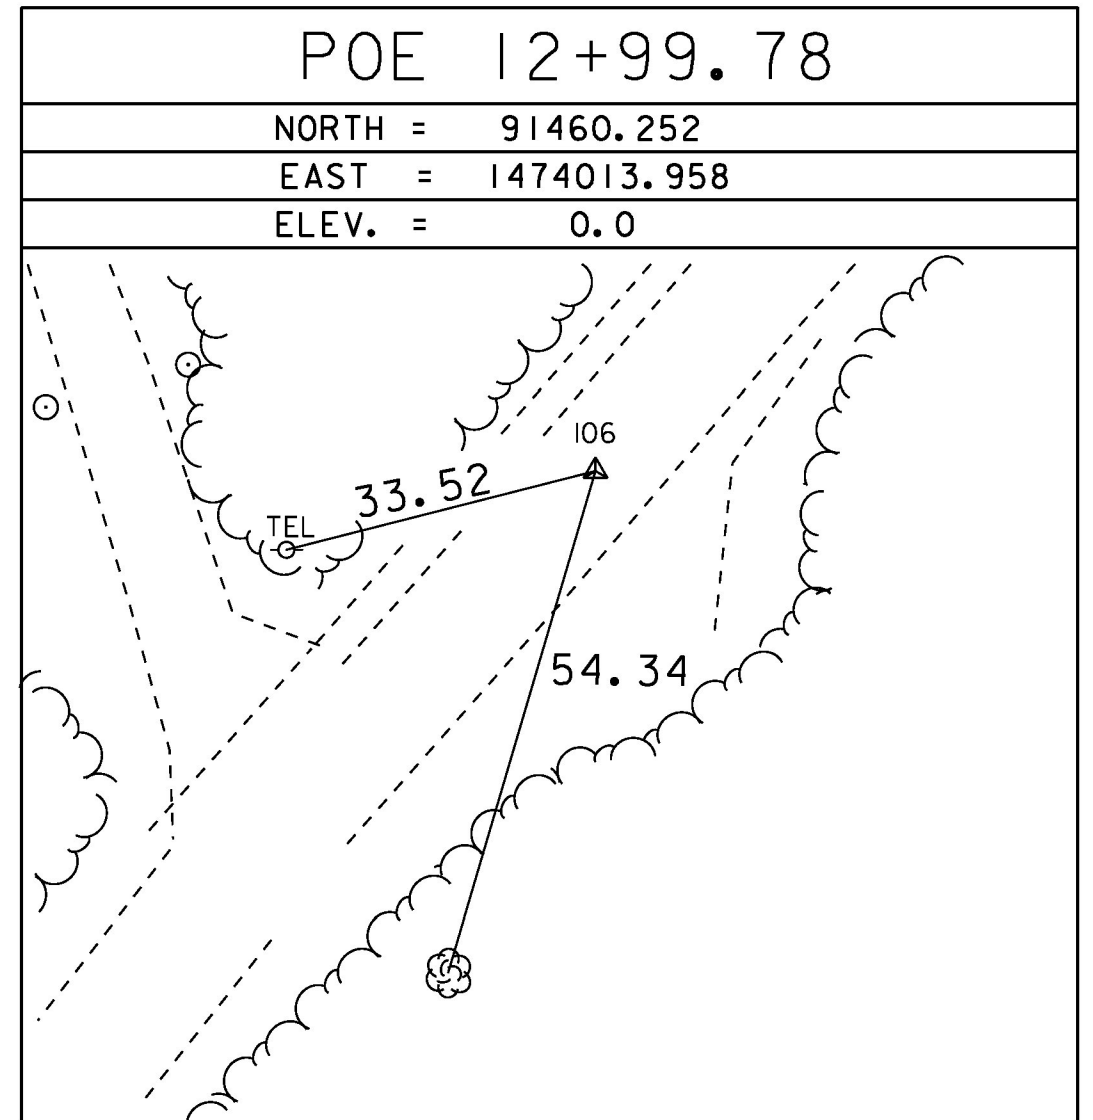
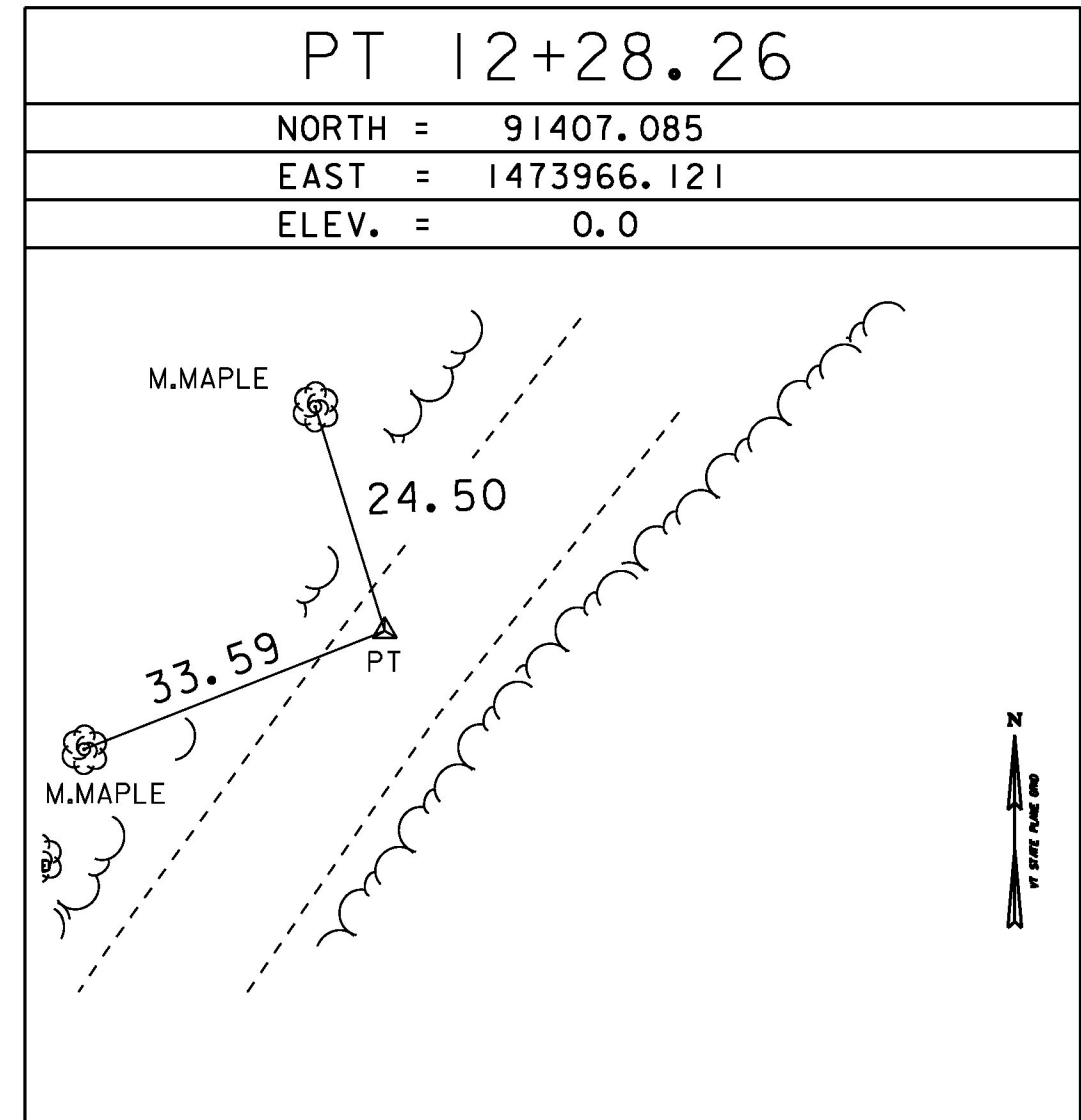
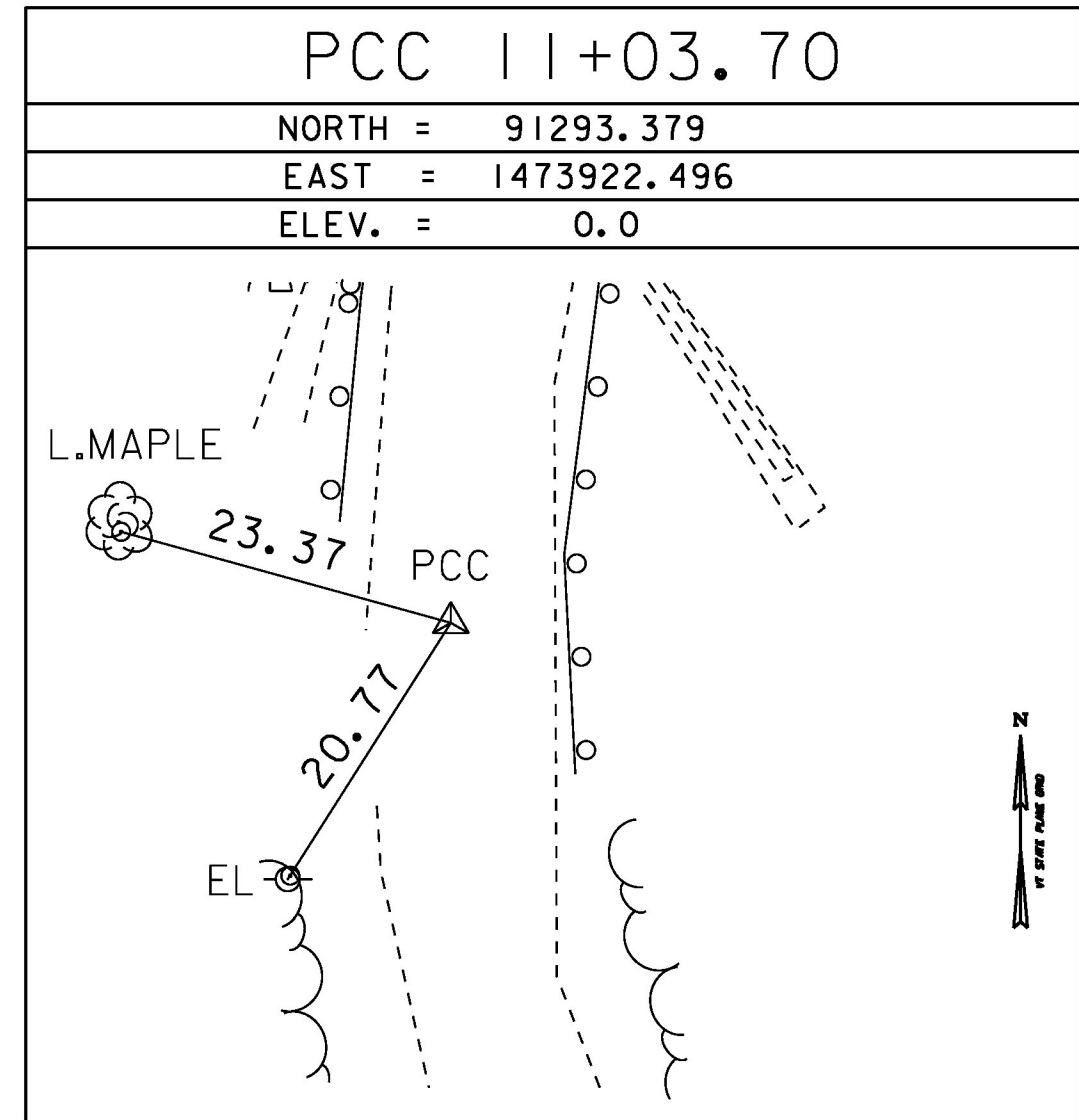
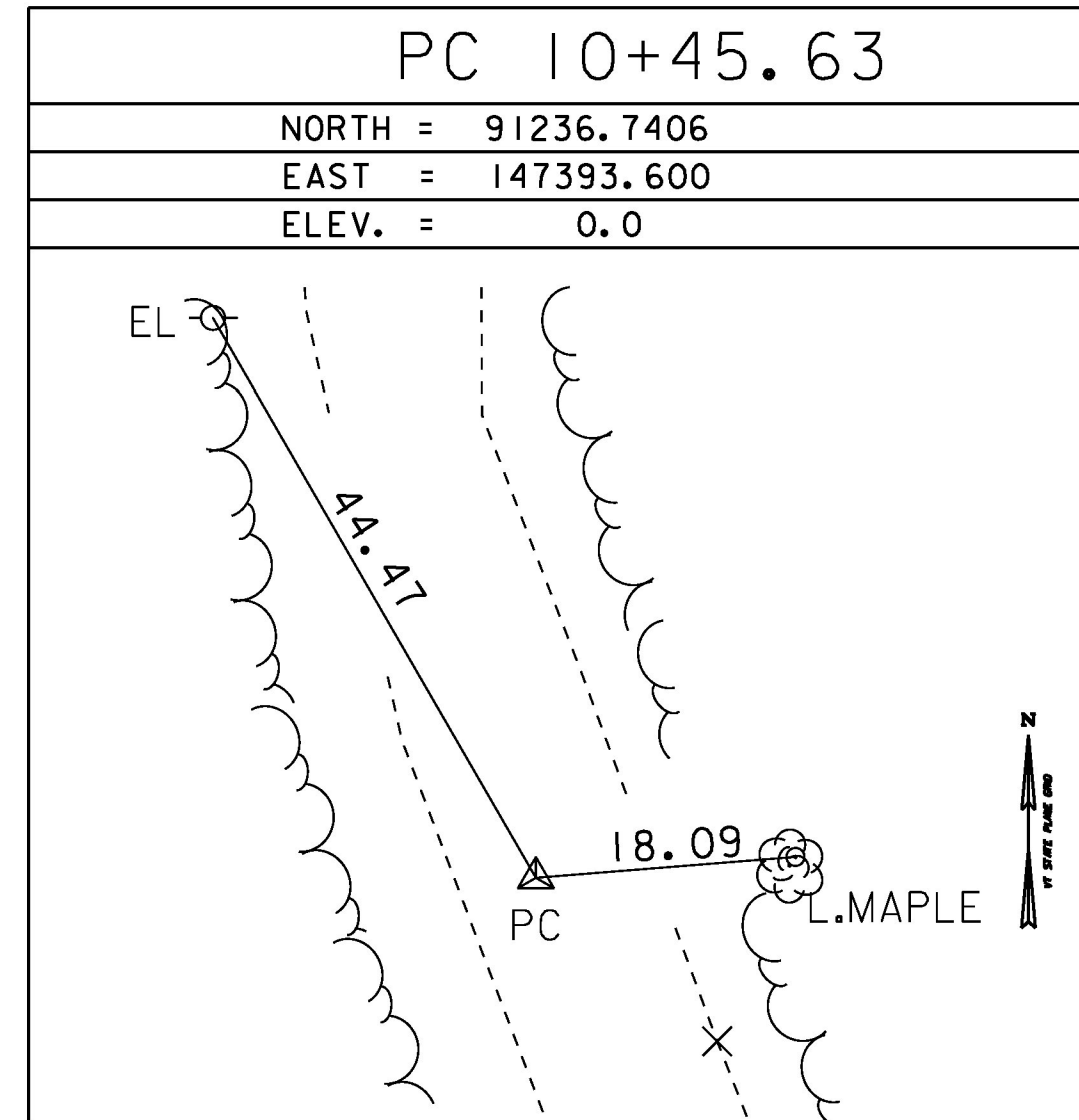
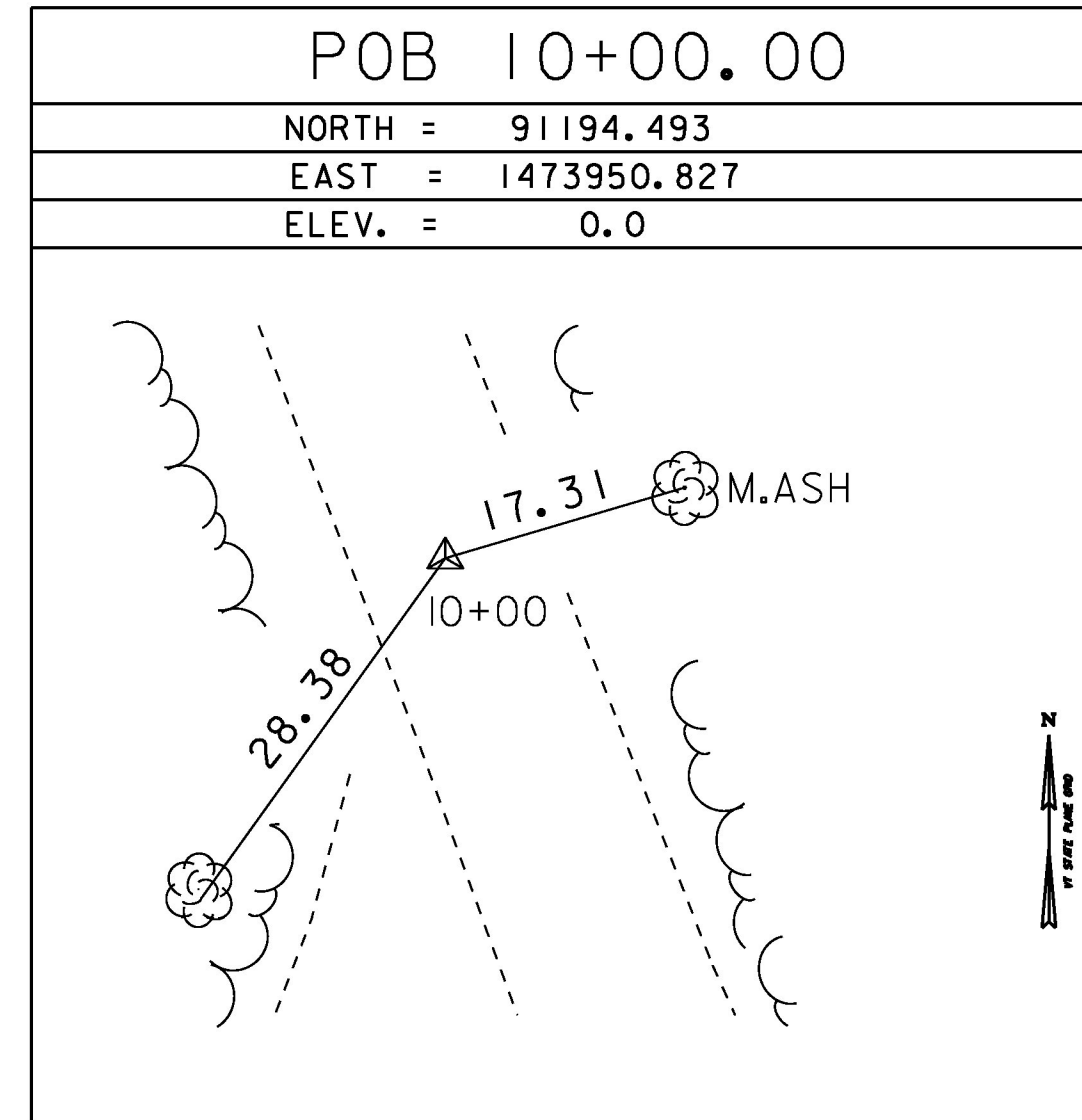
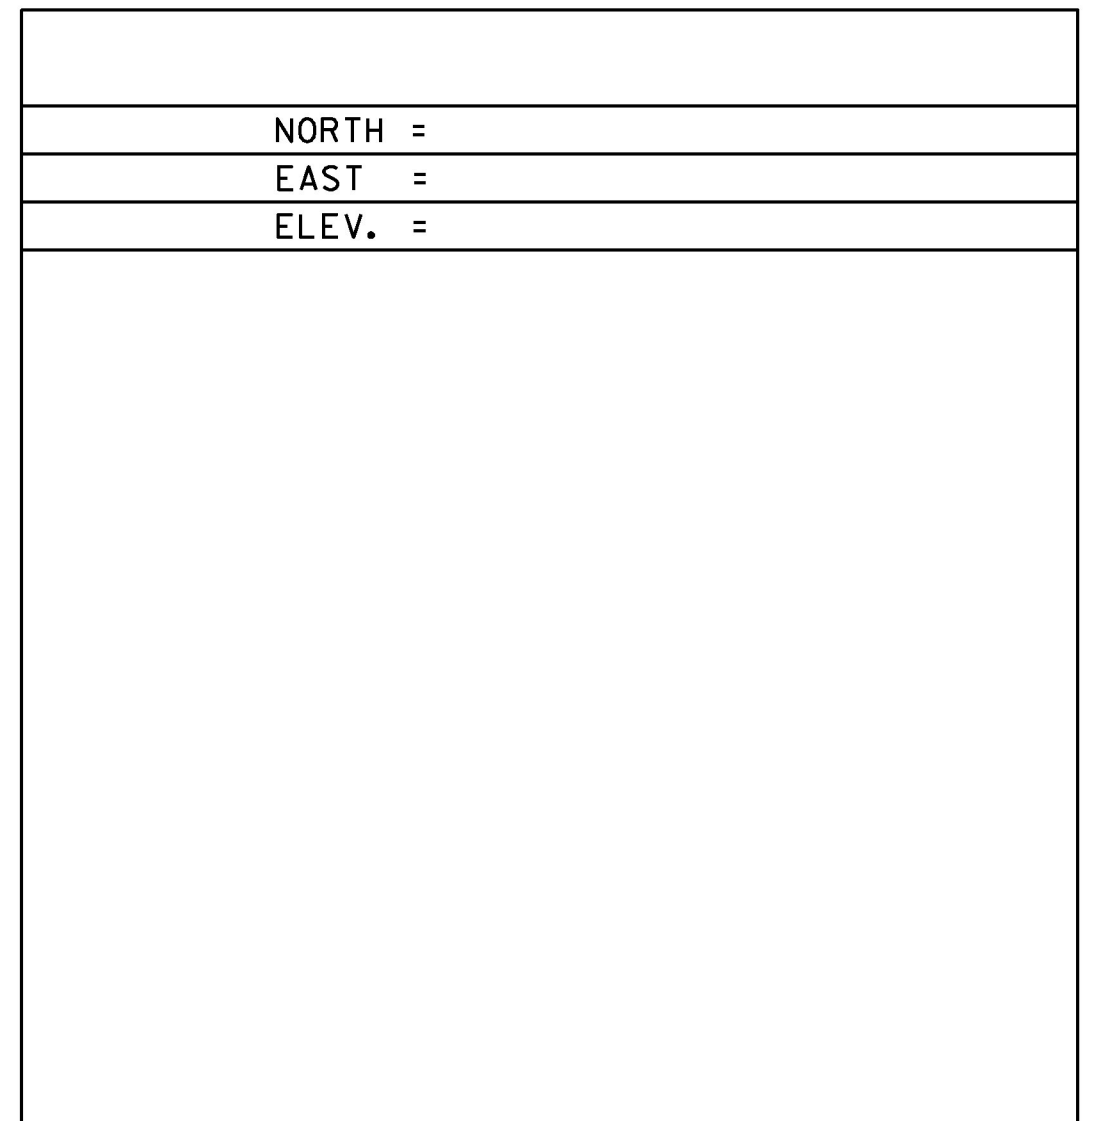
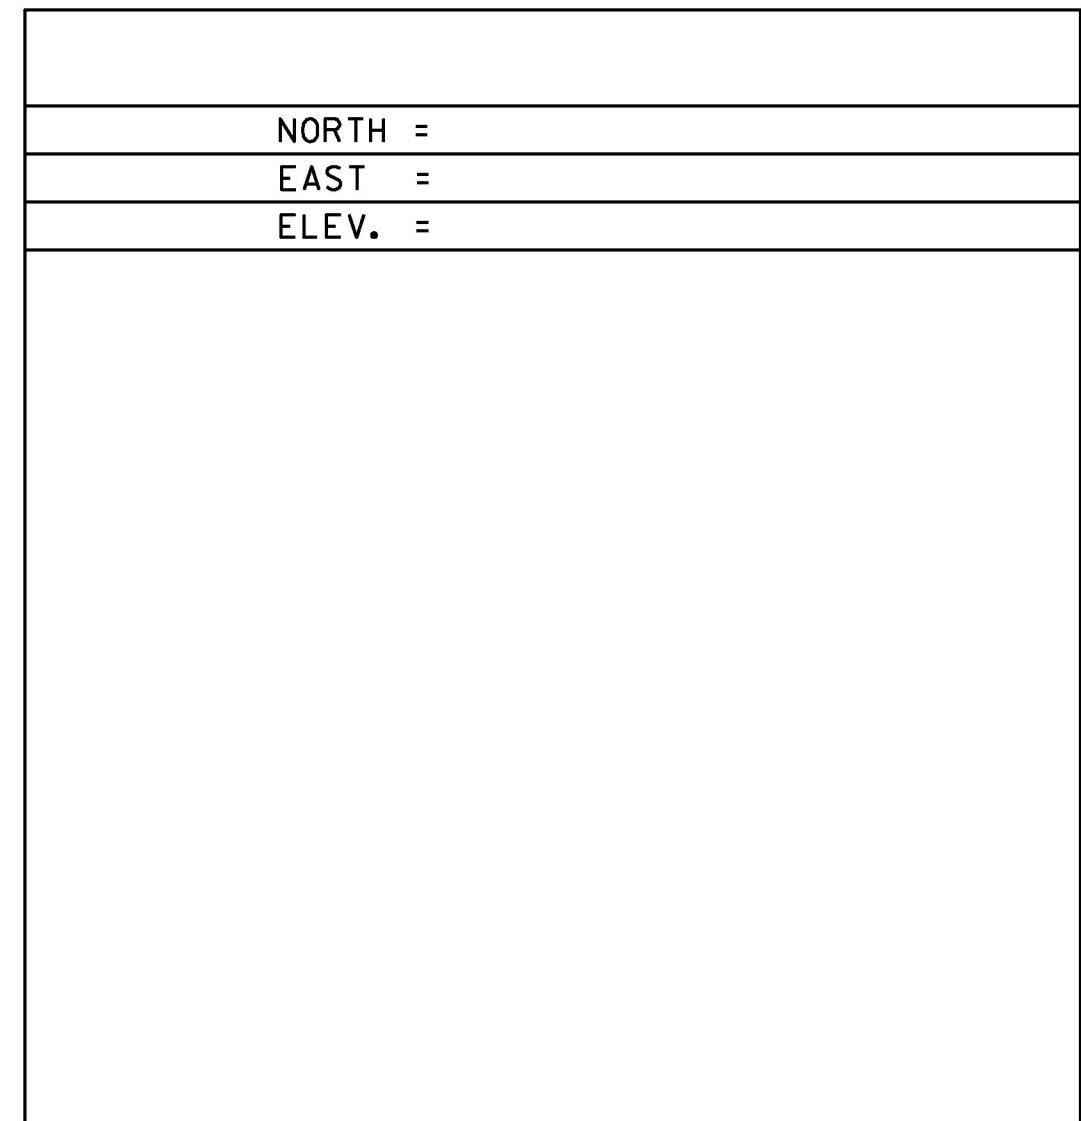
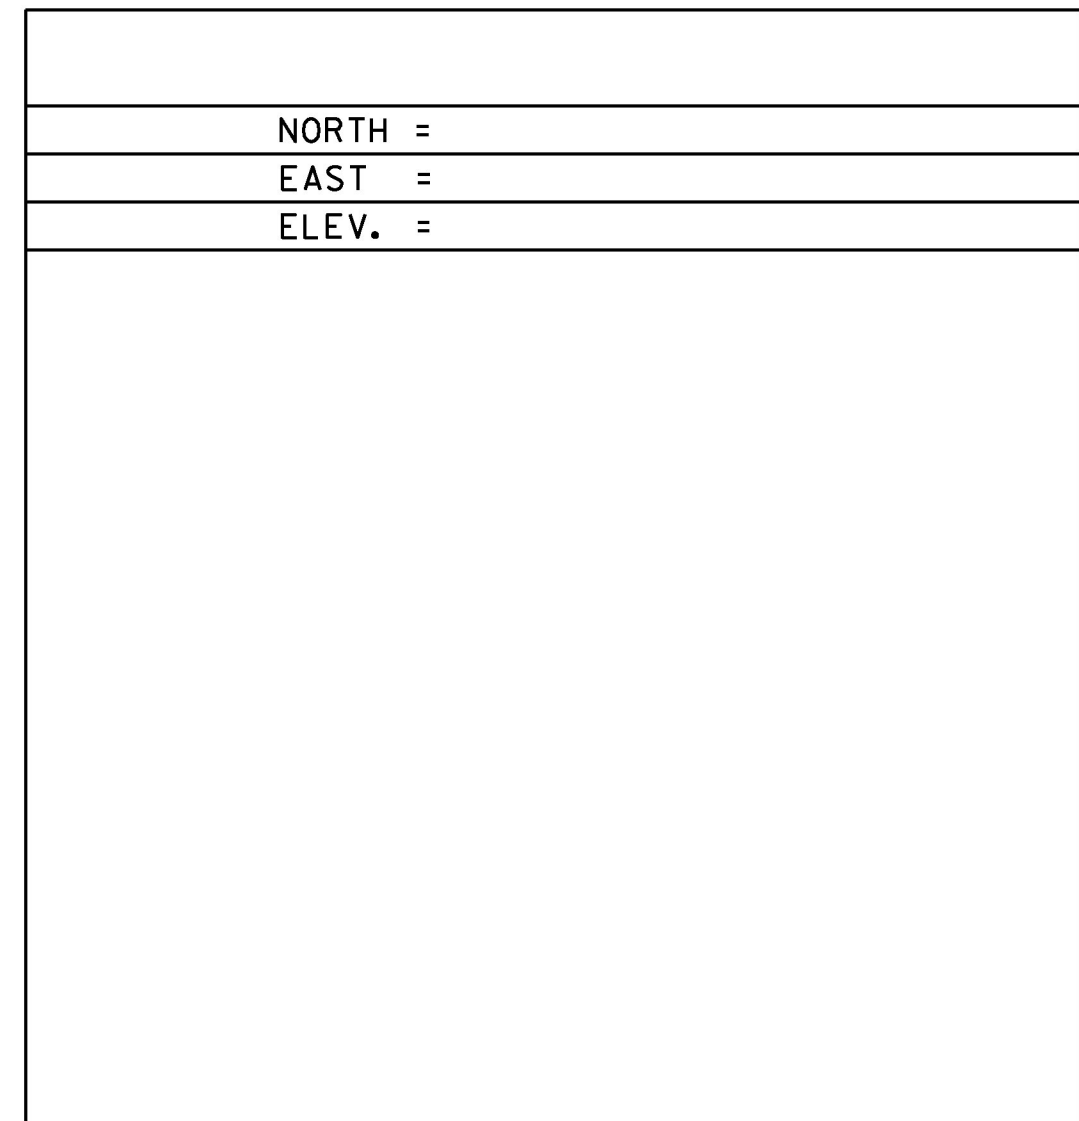







ALIGNMENT TIES

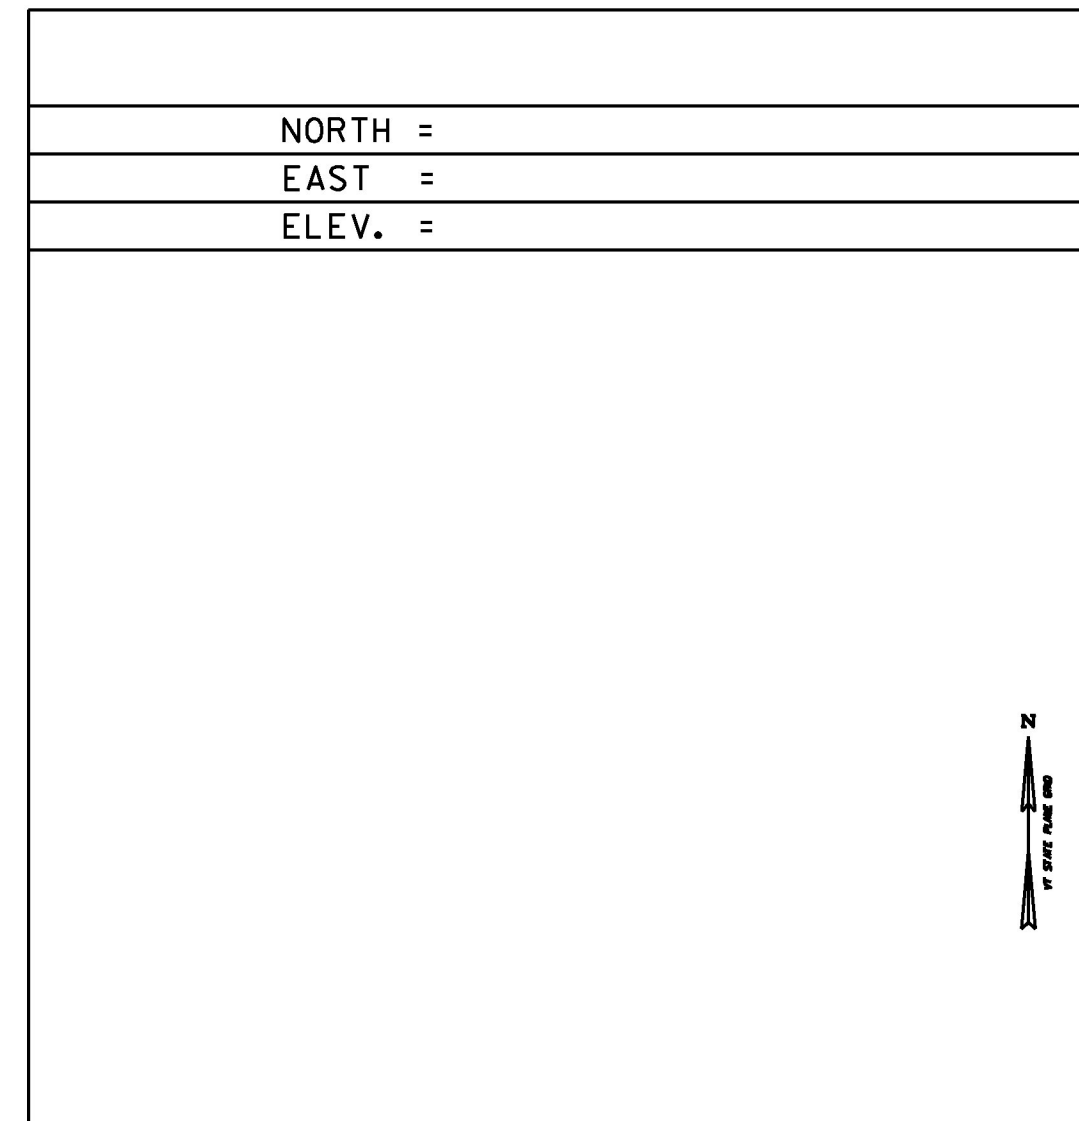

ALIGNMENT TIES

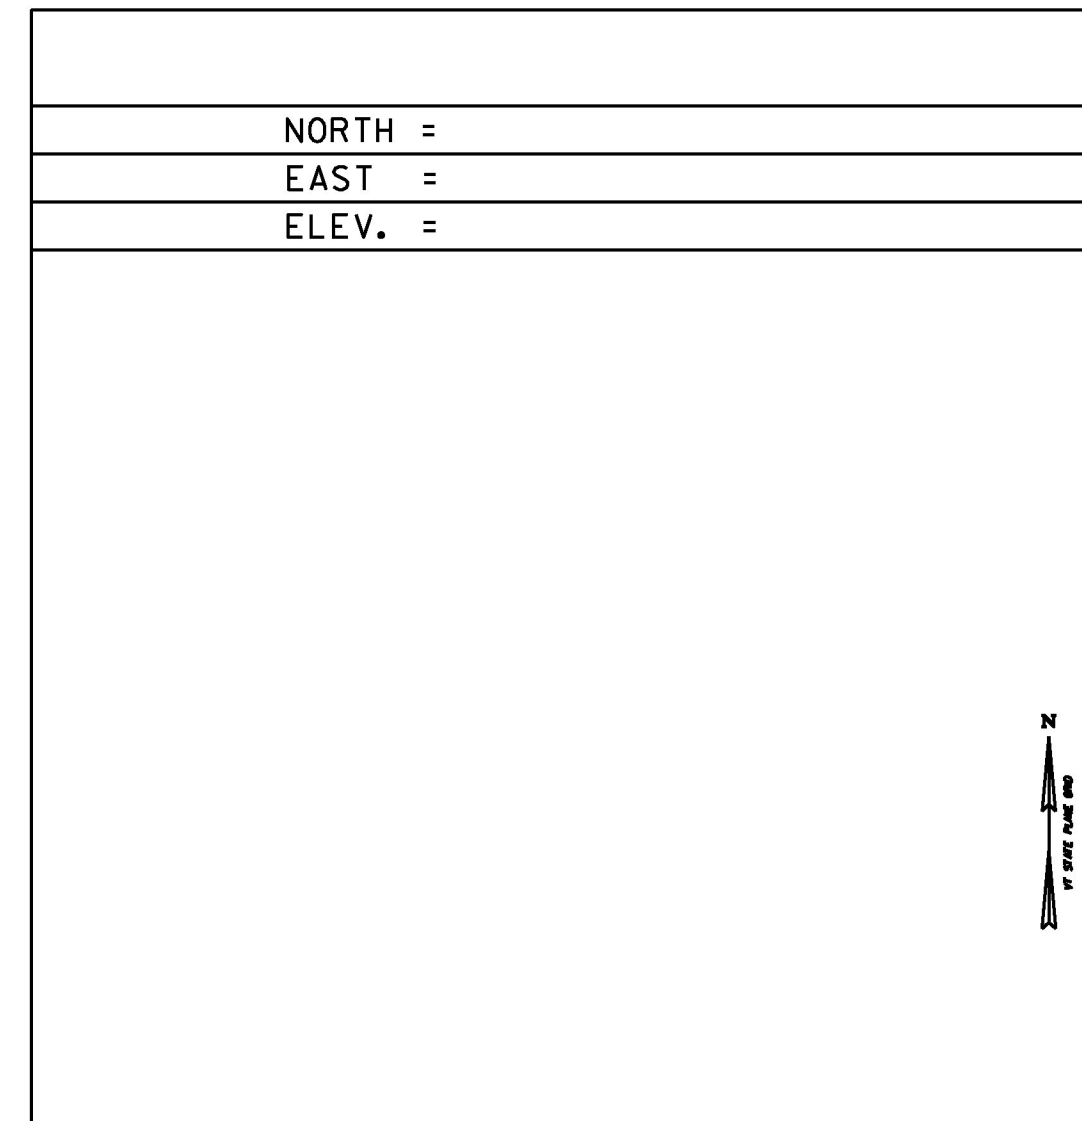

ALIGNMENT TIES

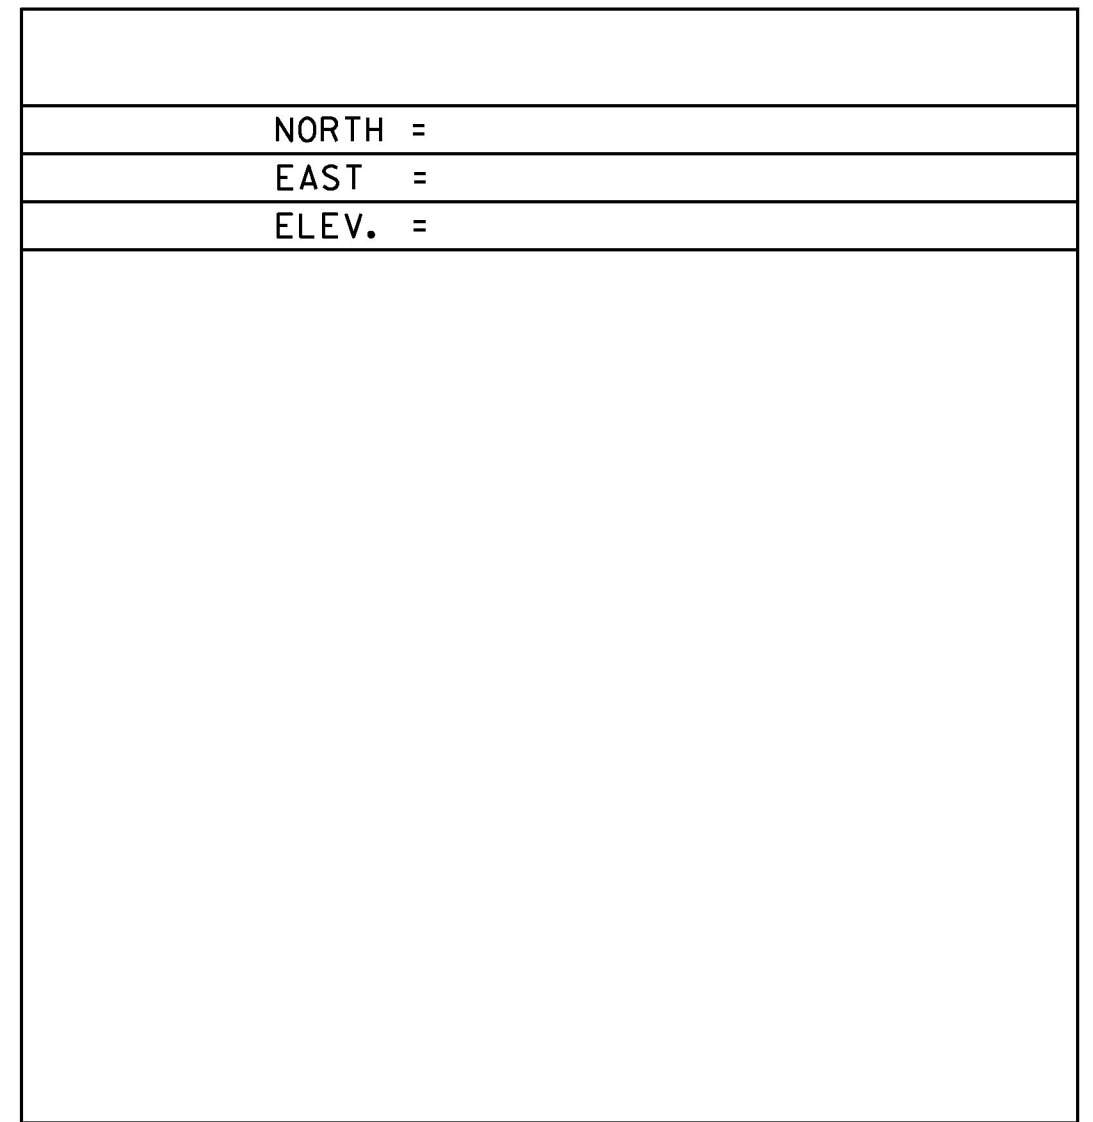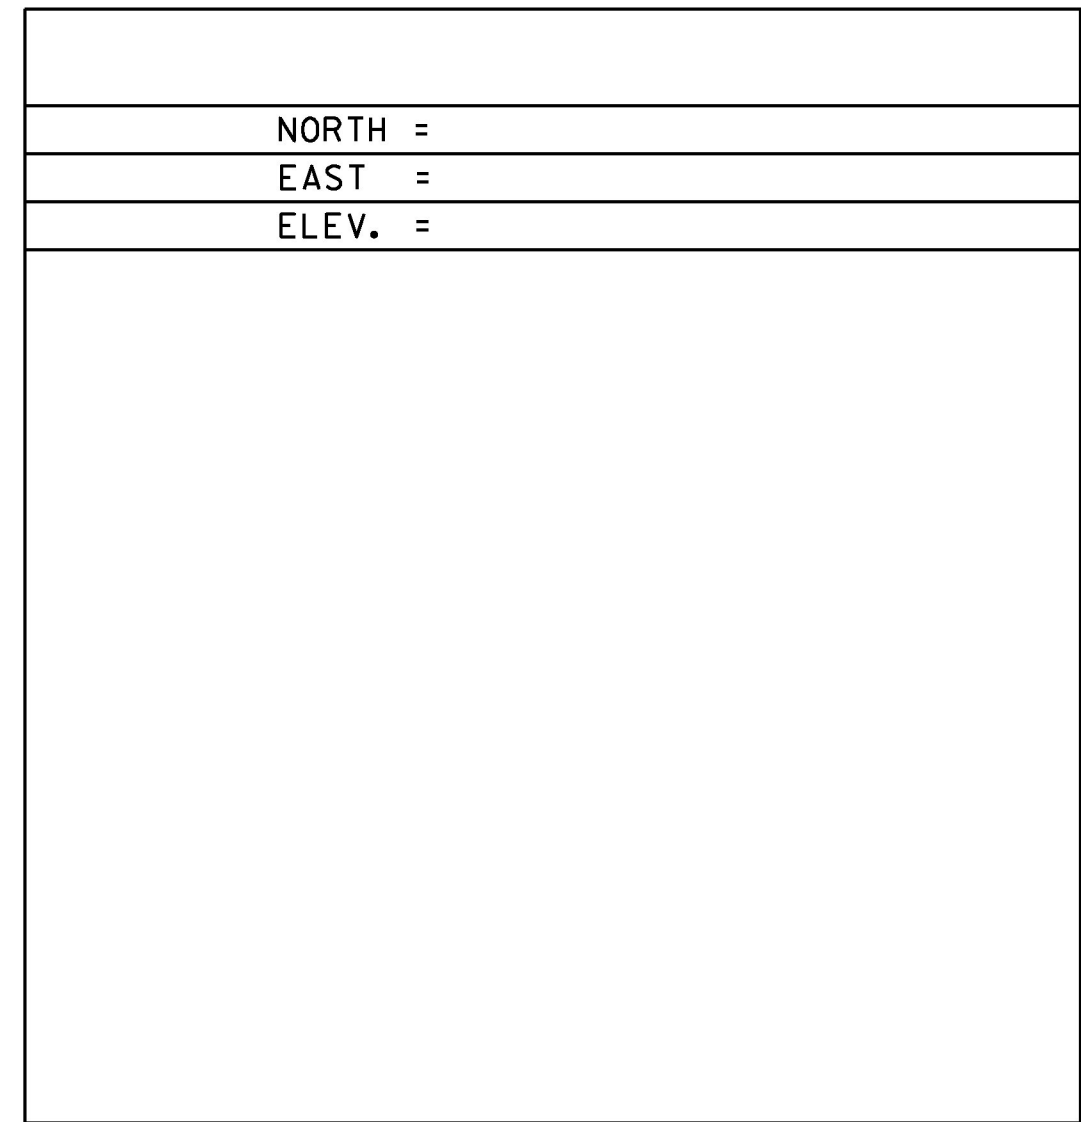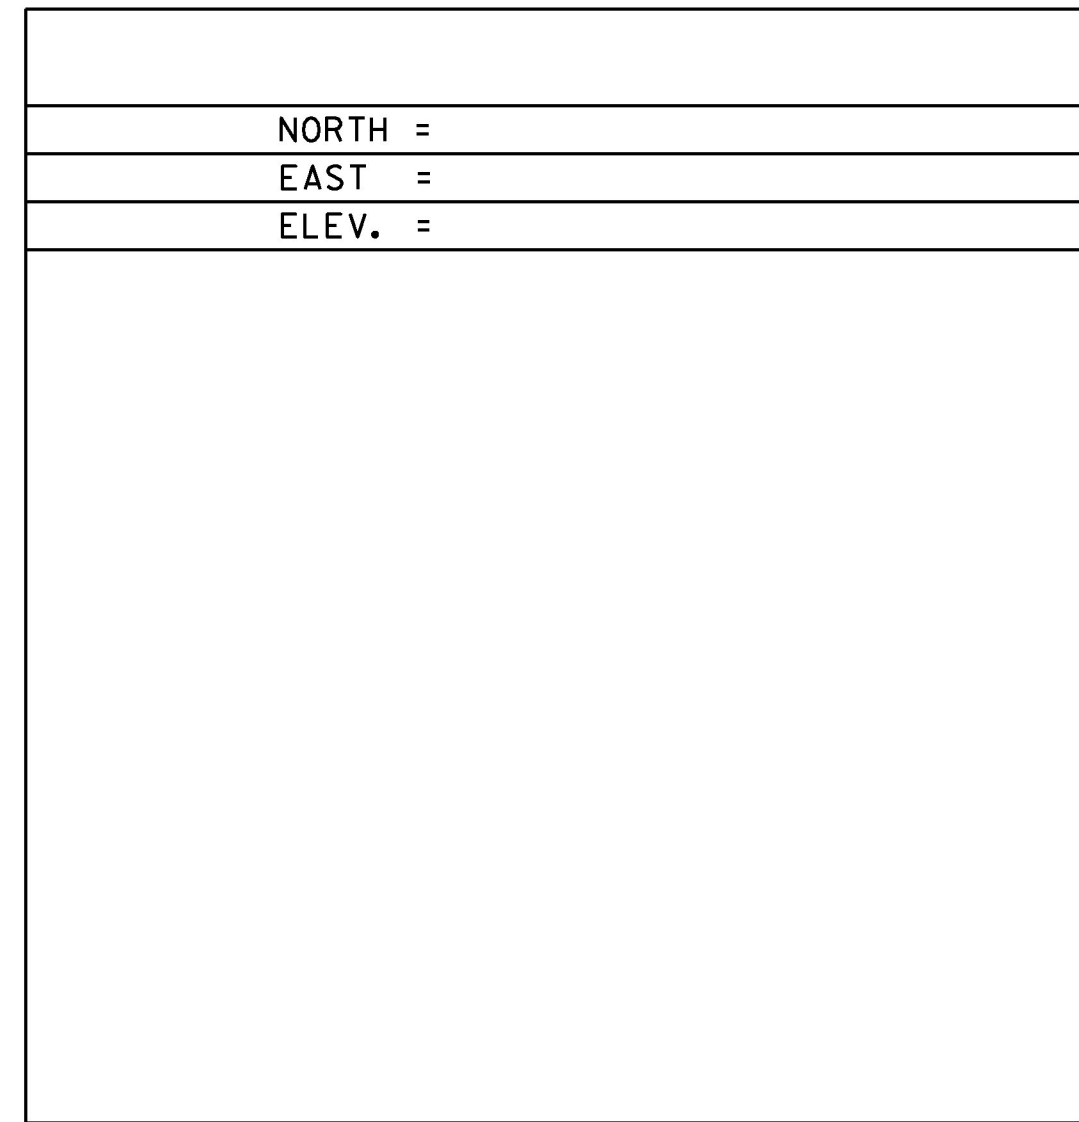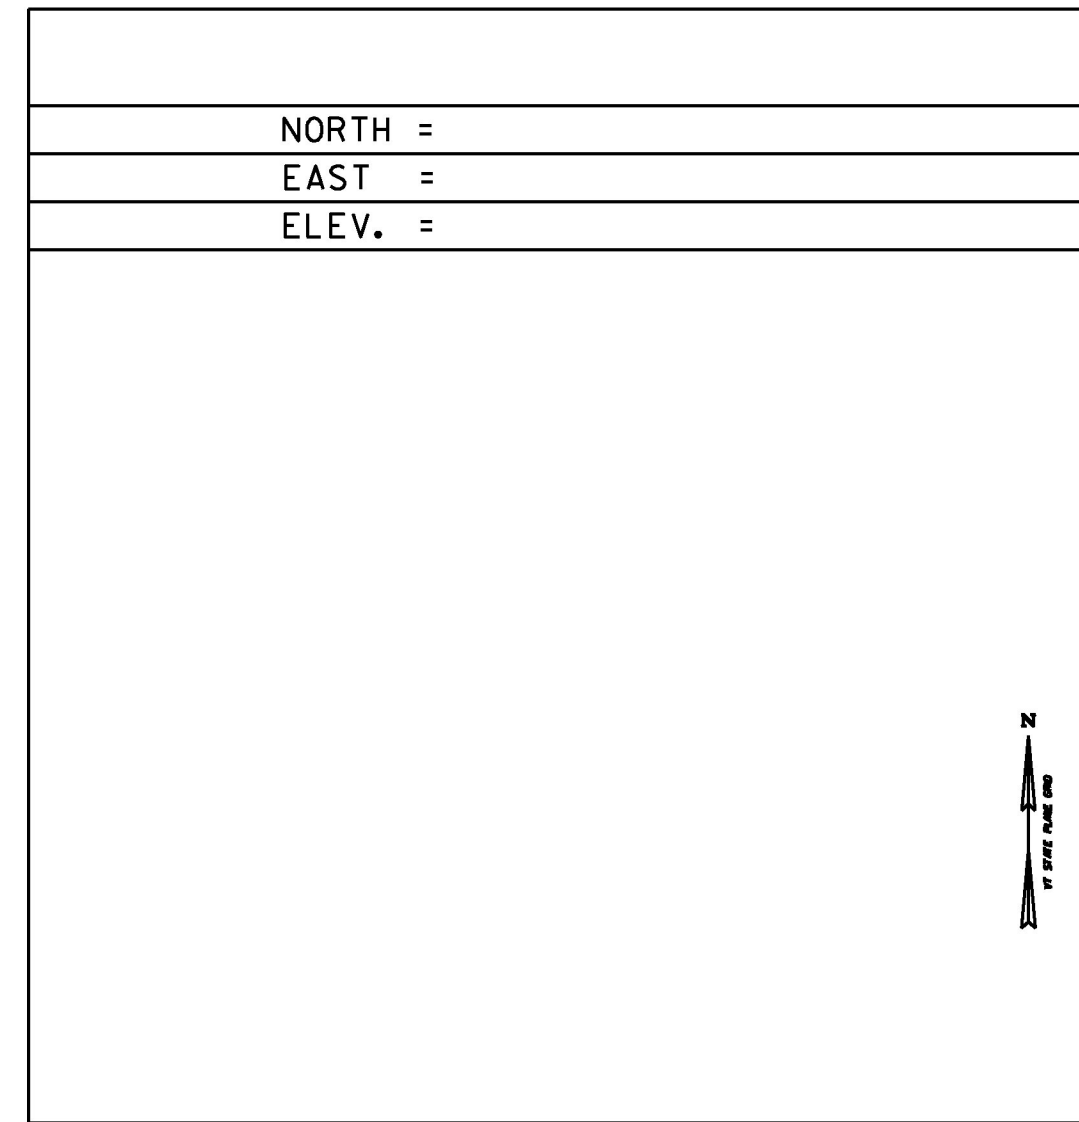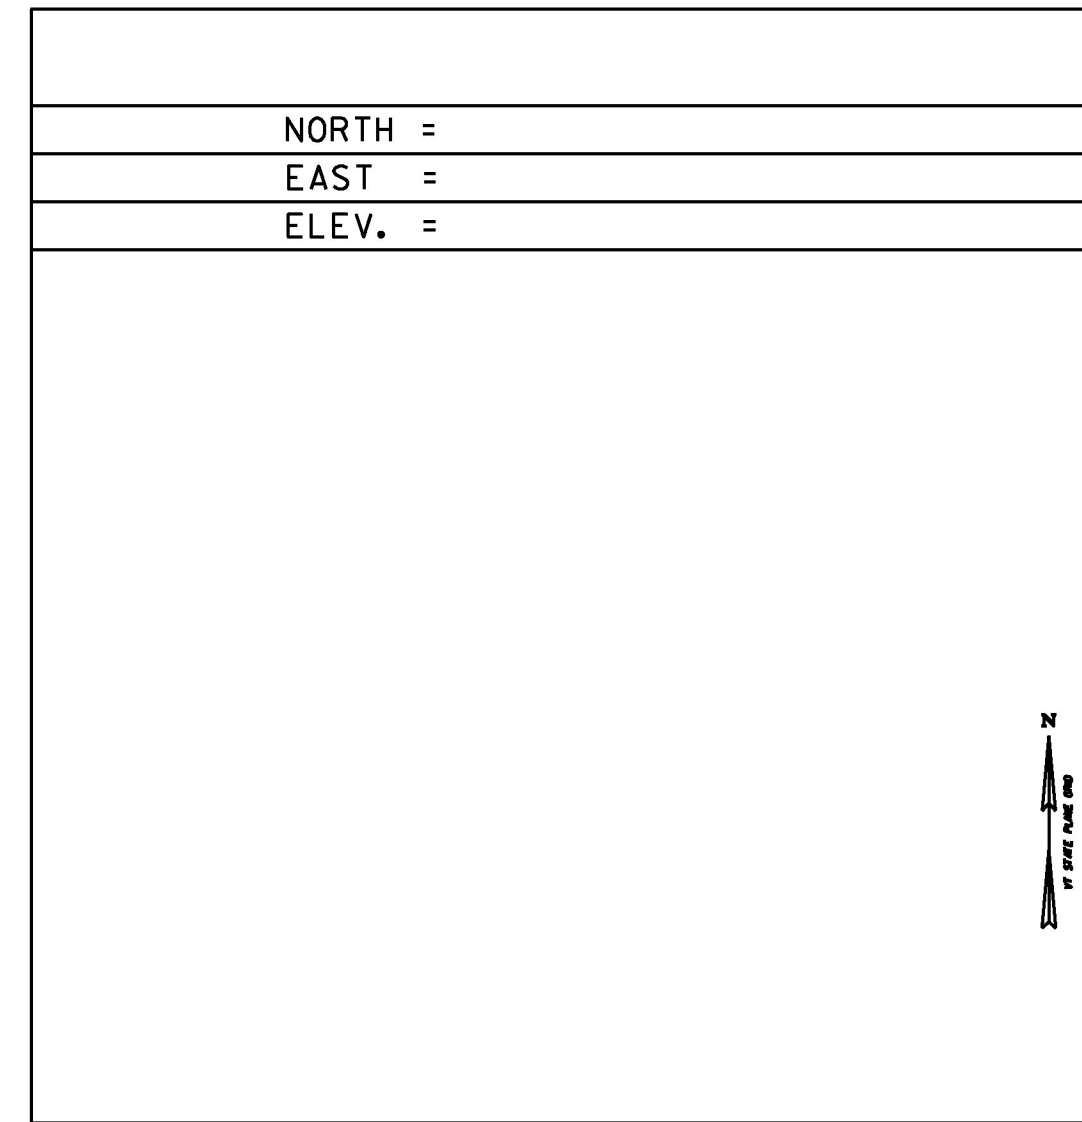

DATUM	
VERTICAL	NAVD 88
HORIZONTAL	NAD 83 (92)
ADJUSTMENT	N/A

PROJECT NAME:	STAMFORD
PROJECT NUMBER:	STP 144(29)
FILE NAME:	s96j226+1e.dgn
PROJECT LEADER:	C.W. CARLSON
DESIGNED BY:	H. SALLS
TIE SHEET	2
PLOT DATE:	03-DEC-2015
DRAWN BY:	D. KARABEGOVIC
CHECKED BY:	H. SALLS
SHEET	II OF 44