



**ABUTMENT #1 PLAN**

SCALE: 1/4" = 1'-0"

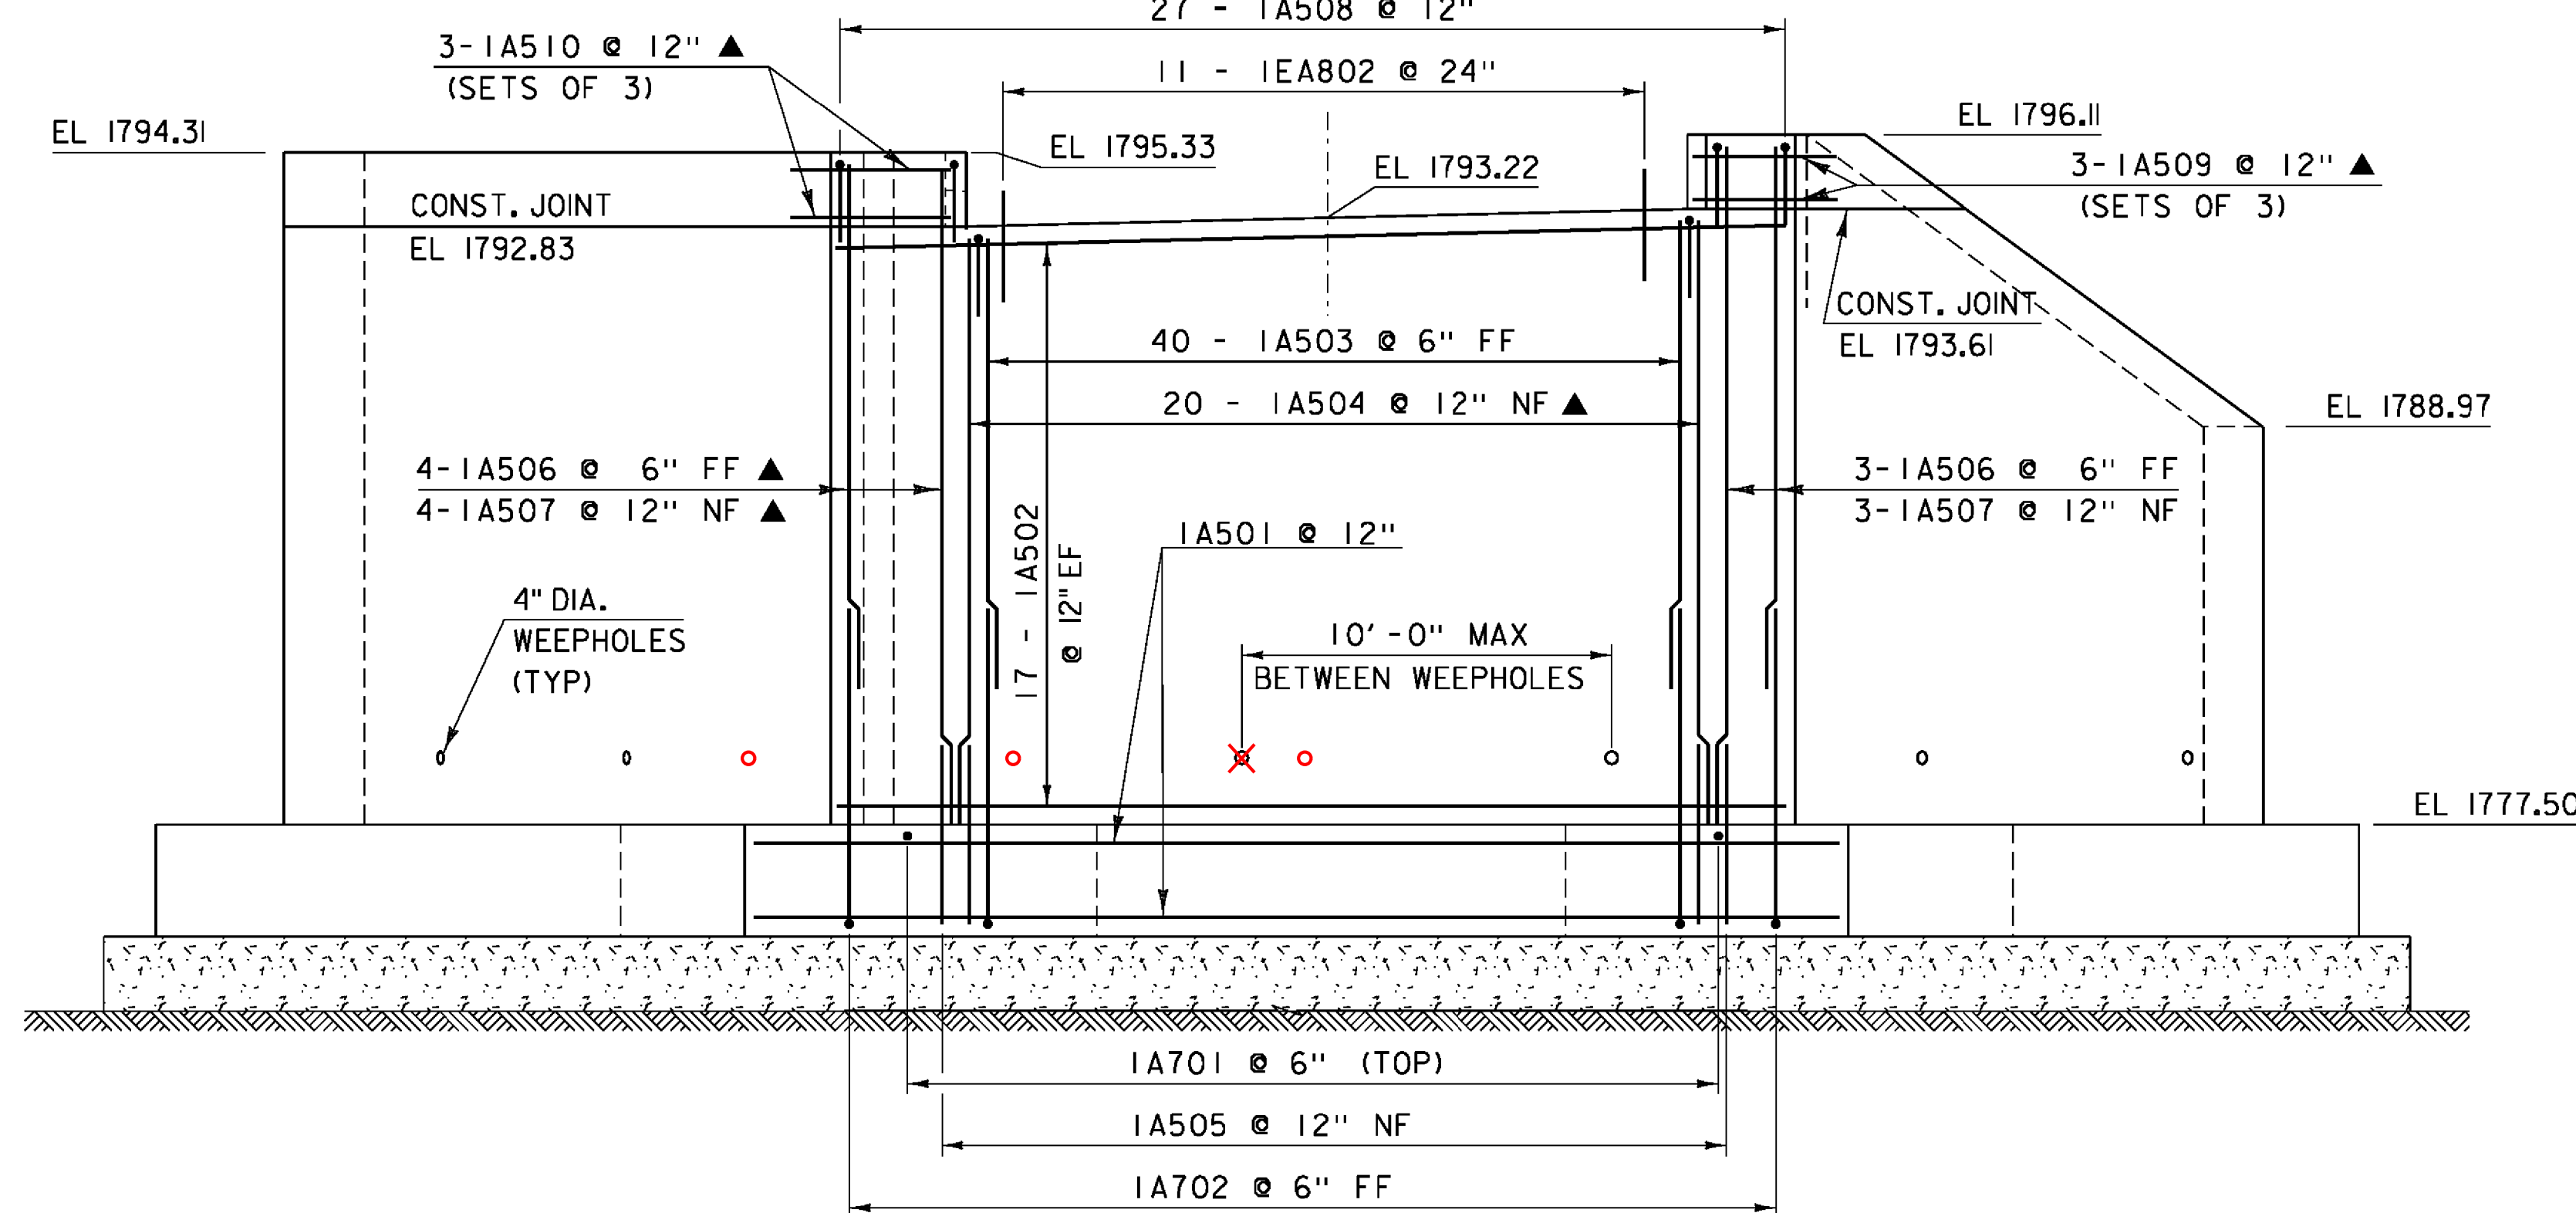

**ABUTMENT #1 ELEVATION**

SCALE: 1/4" = 1'-0"

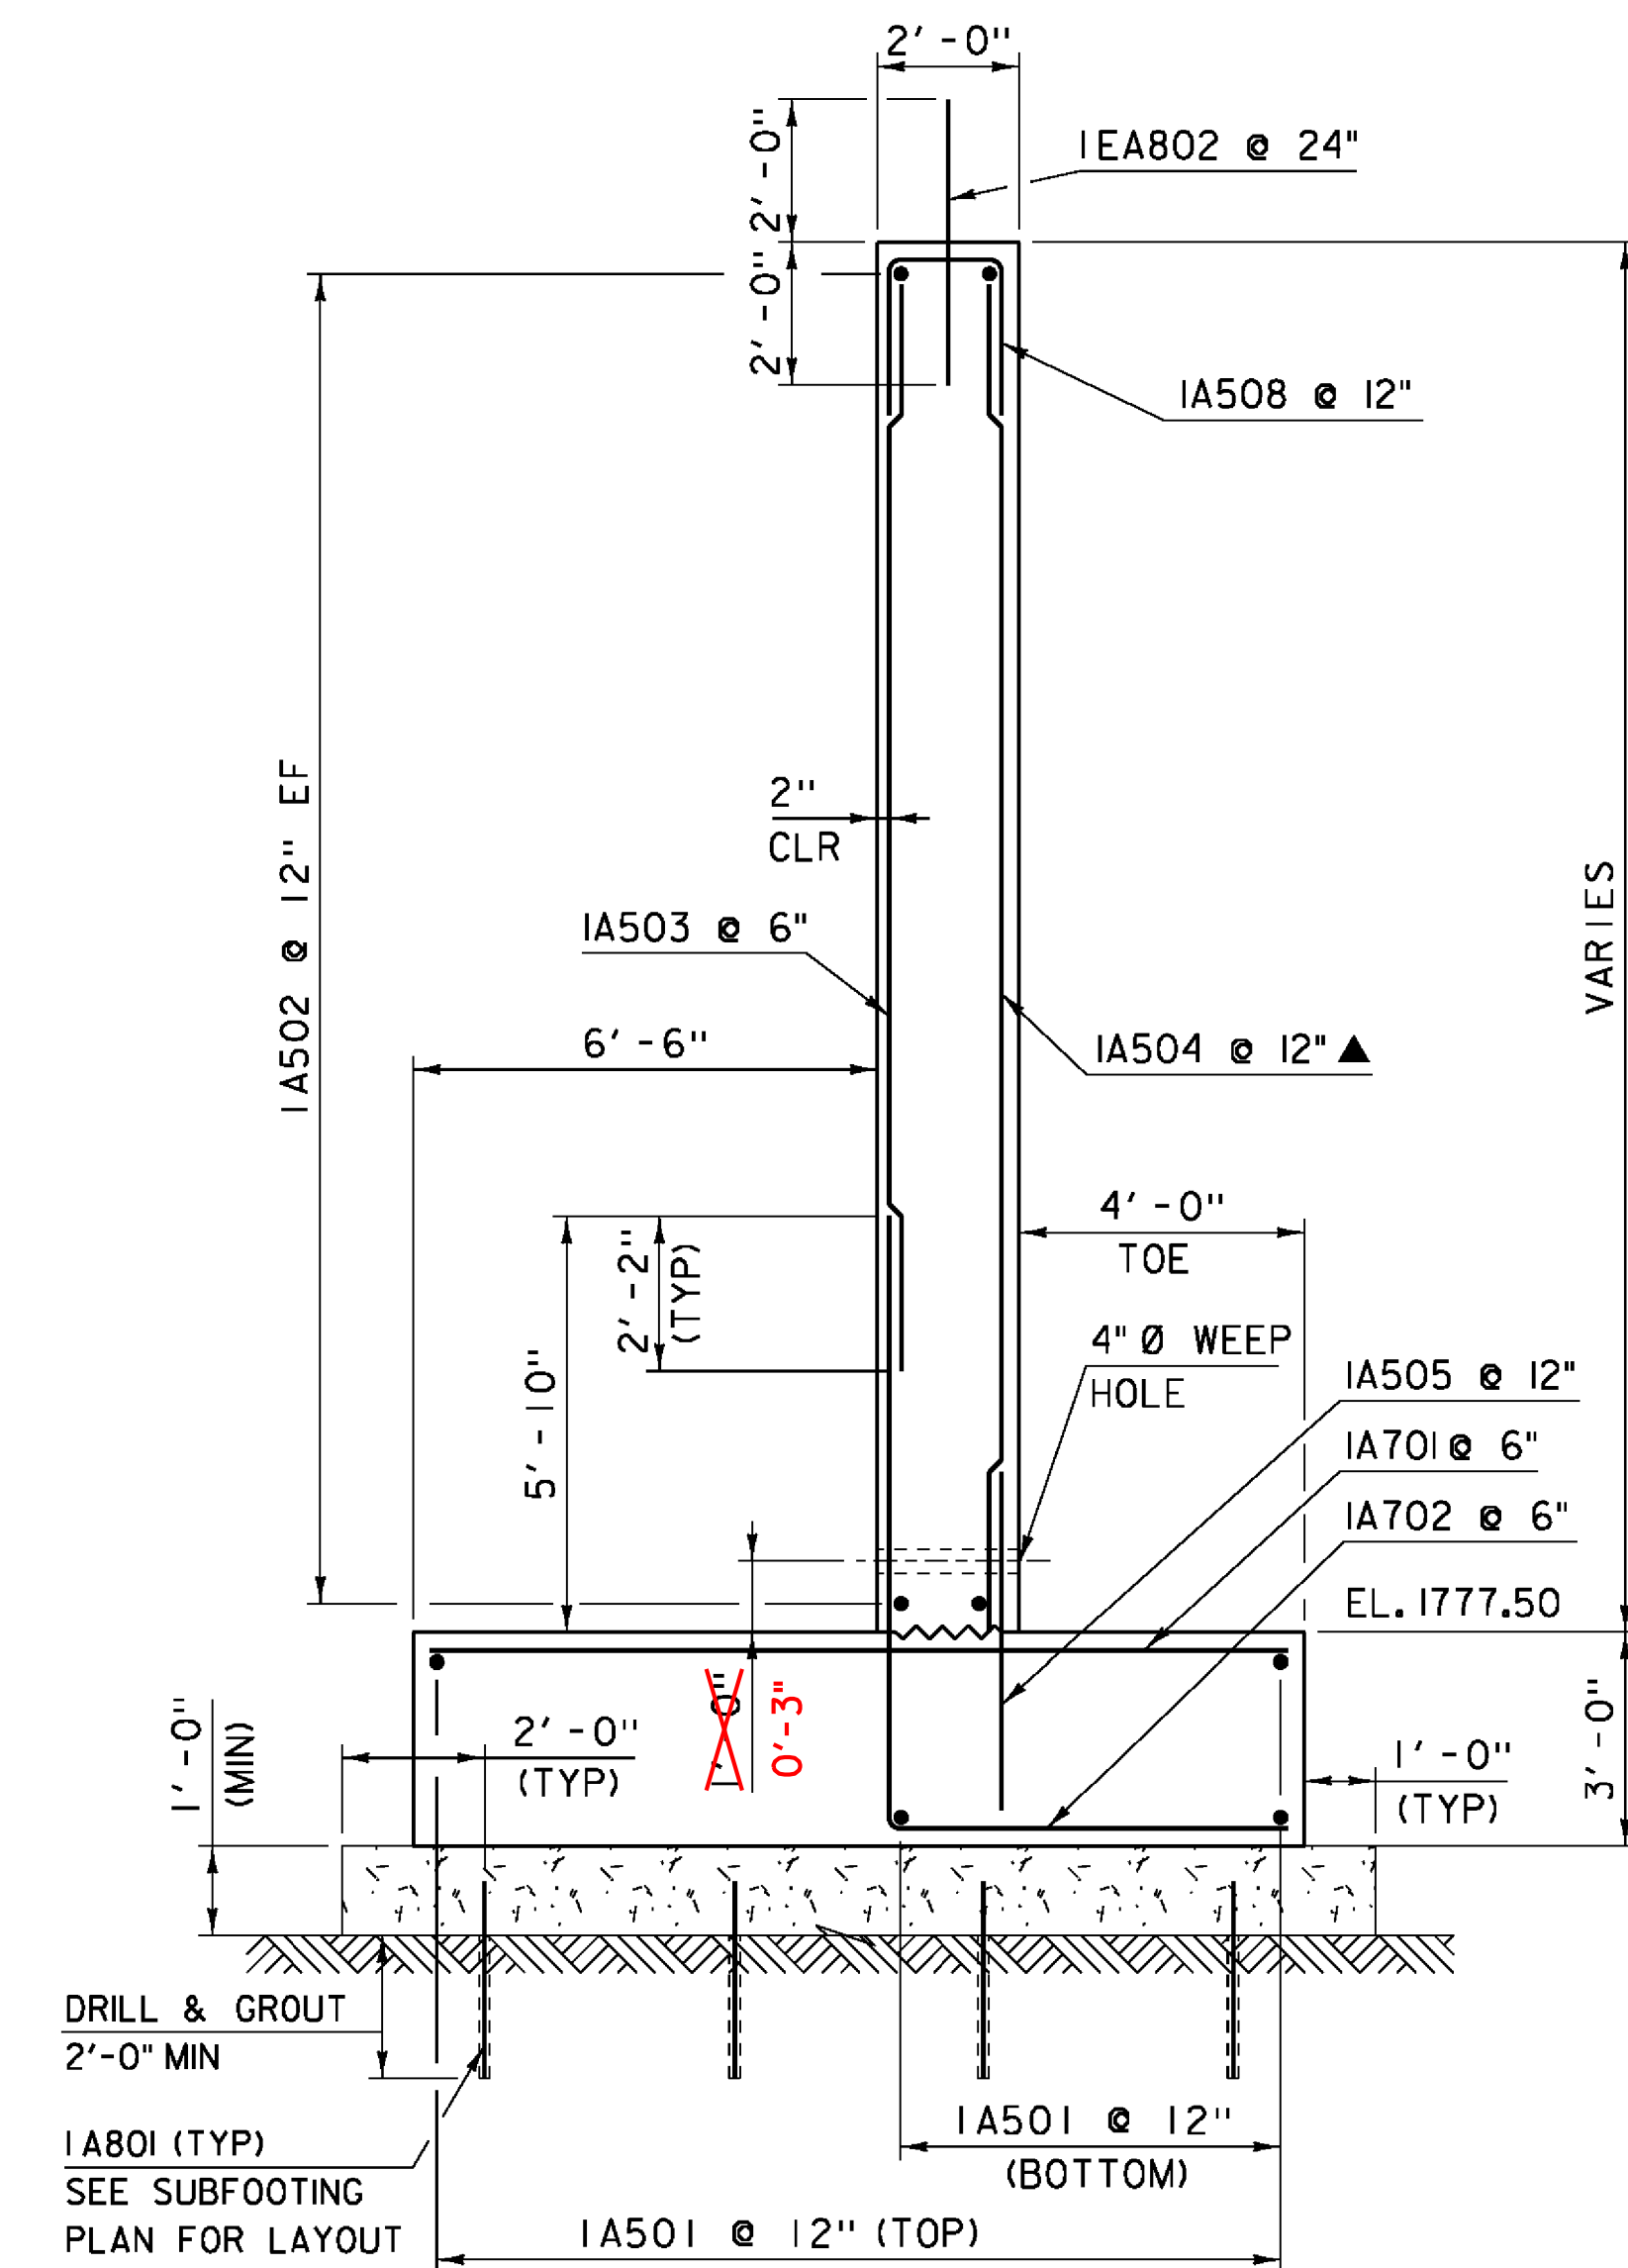

**ABUTMENT #1 SECTION**

**NOTE:**

- NF = NEAR FACE
- FF = FAR FACE
- EF = EACH FACE
- ▲ = CUT TO FIT IN FIELD
- 3" CLEAR, UNLESS OTHERWISE SPECIFIED ON THE PLANS.
- 2' - 2" BAR LAP UNLESS OTHERWISE SPECIFIED ON THE PLANS.

PROJECT NAME: STAMFORD  
PROJECT NUMBER: STP 1441(29)

FILE NAME: s96j226sub.dgn  
PROJECT LEADER: C.W. CARLSON  
DESIGNED BY: F. BARROWS  
ABUTMENT #1 PLAN, ELEVATION & DETAILS

PLOT DATE: 24-DEC-2015  
DRAWN BY: D. KARABEGOVIC  
CHECKED BY: H. SALLS  
SHEET 21 OF 44