



SEE ATTACHED  
REVISED SHEET 23A

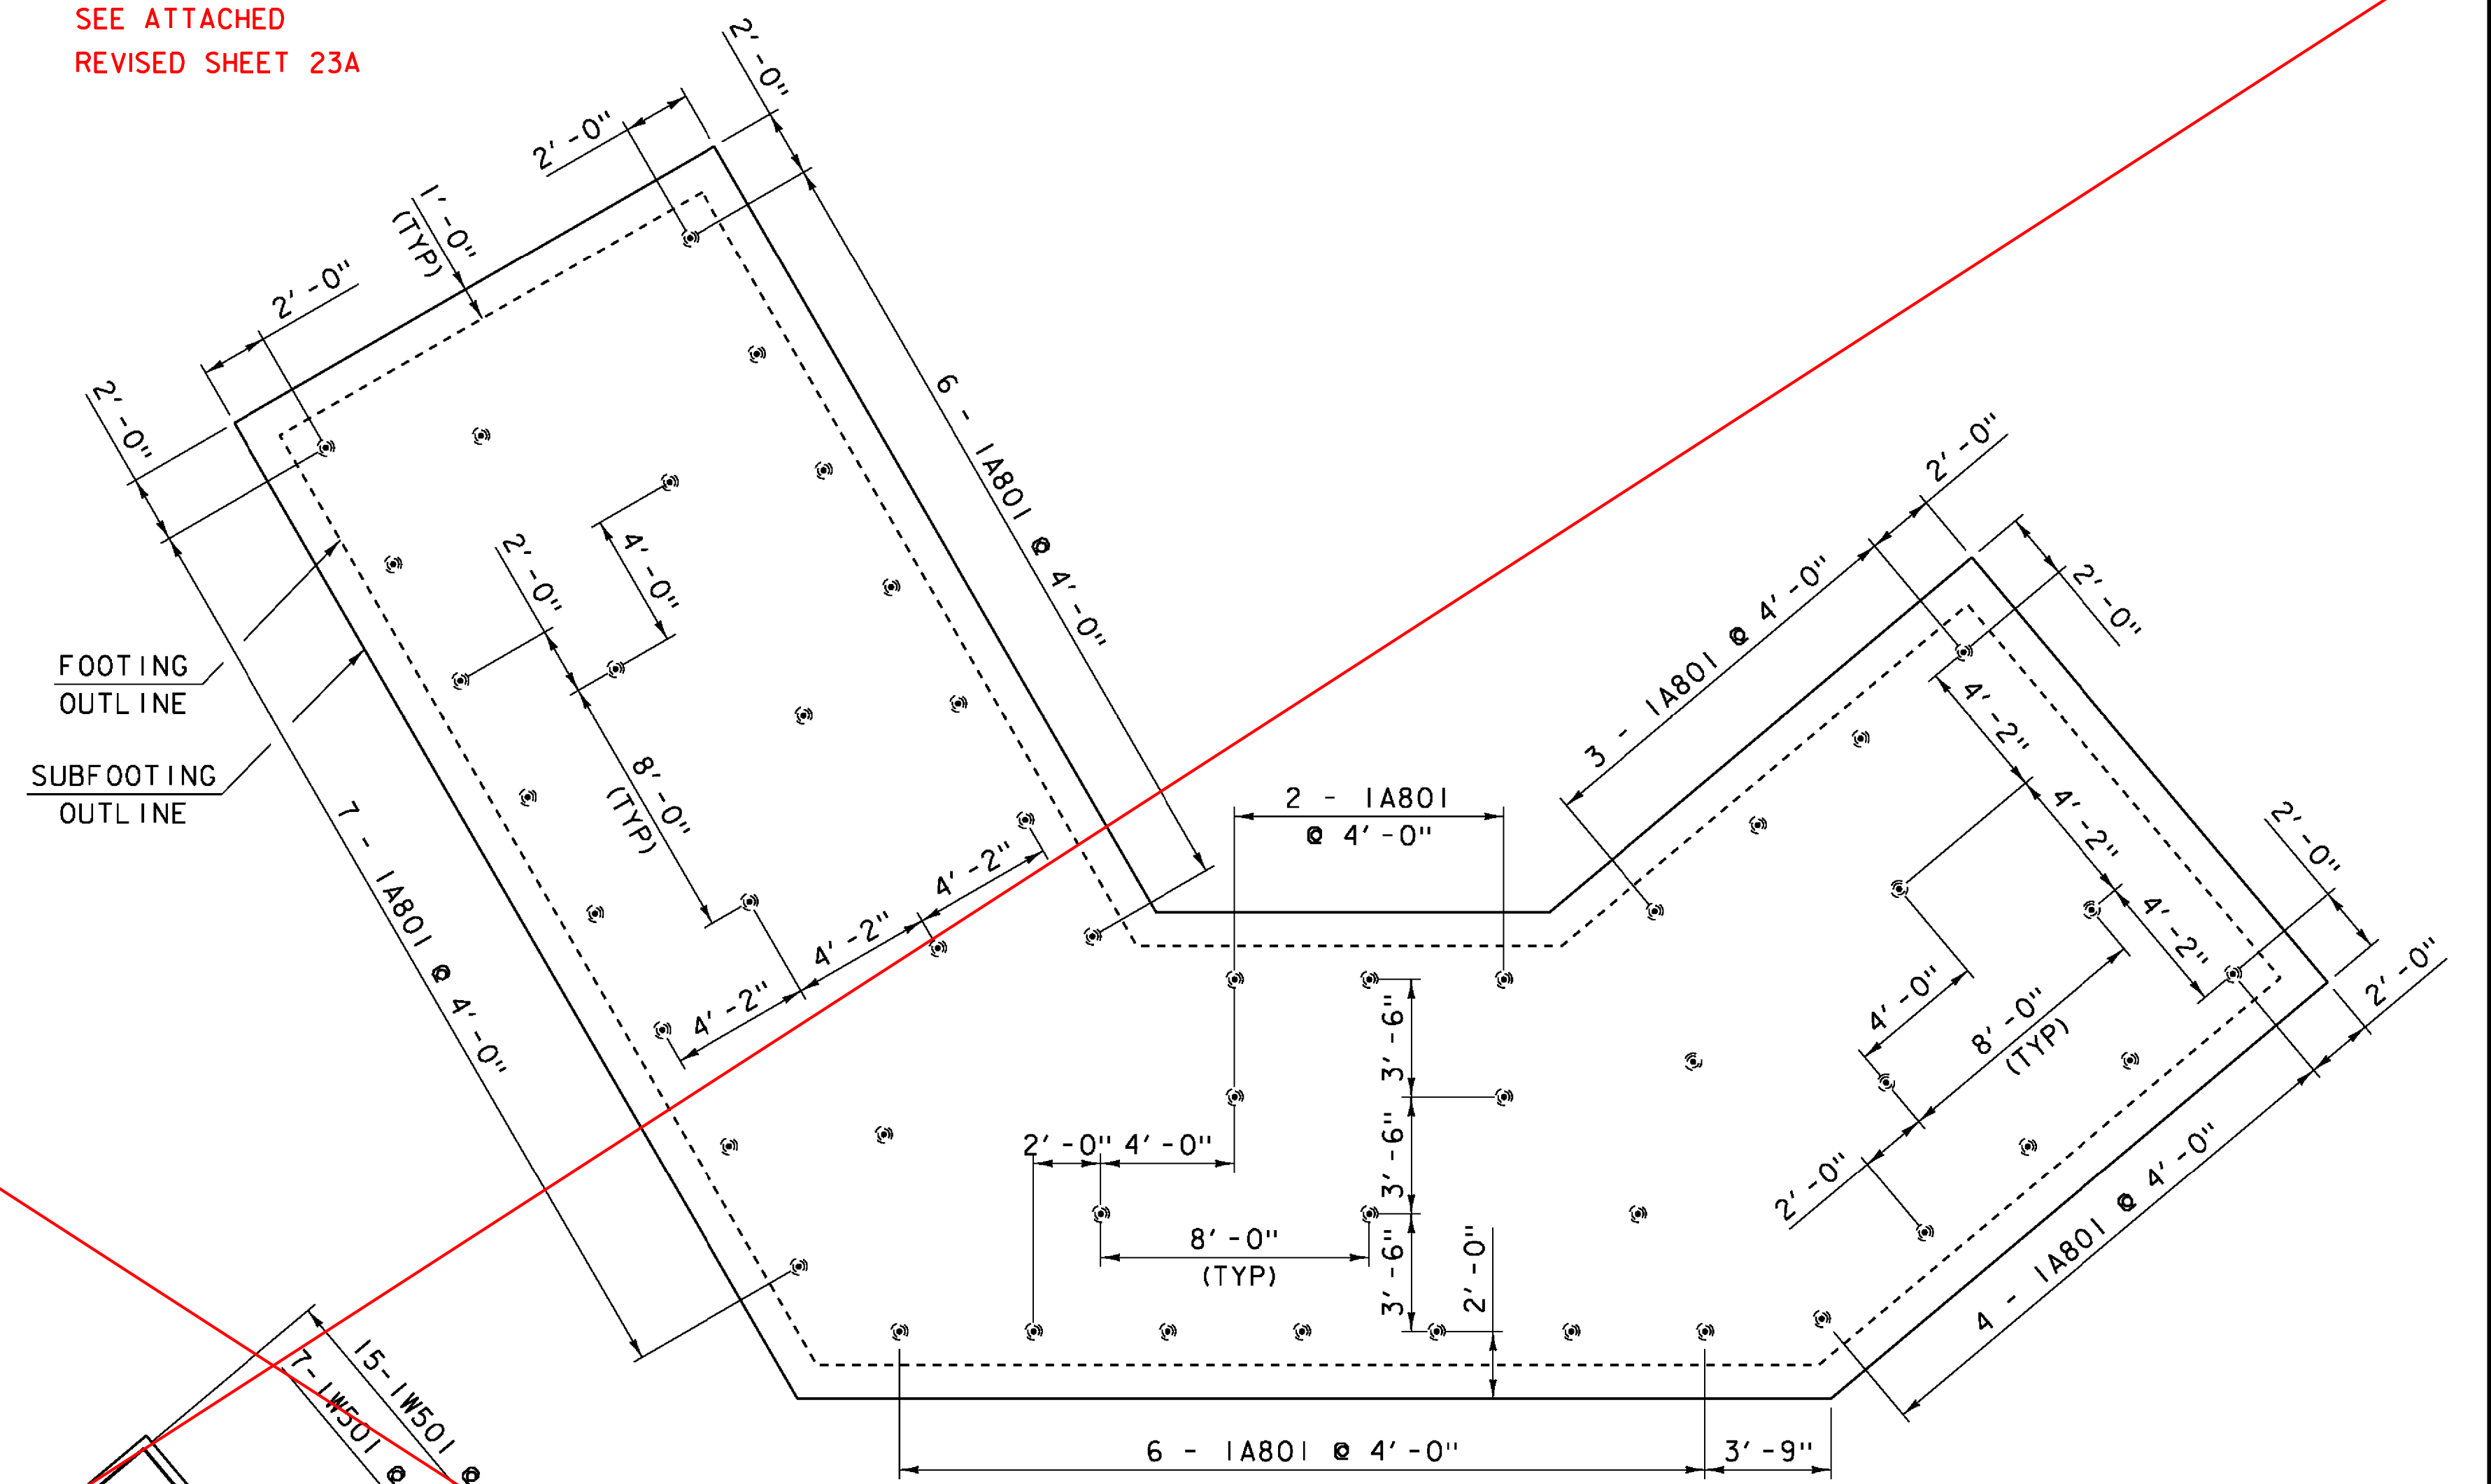

ABUTMENT #1 SUBFOOTING REINFORCING PLAN

SCALE: 1/4" = 1'-0"

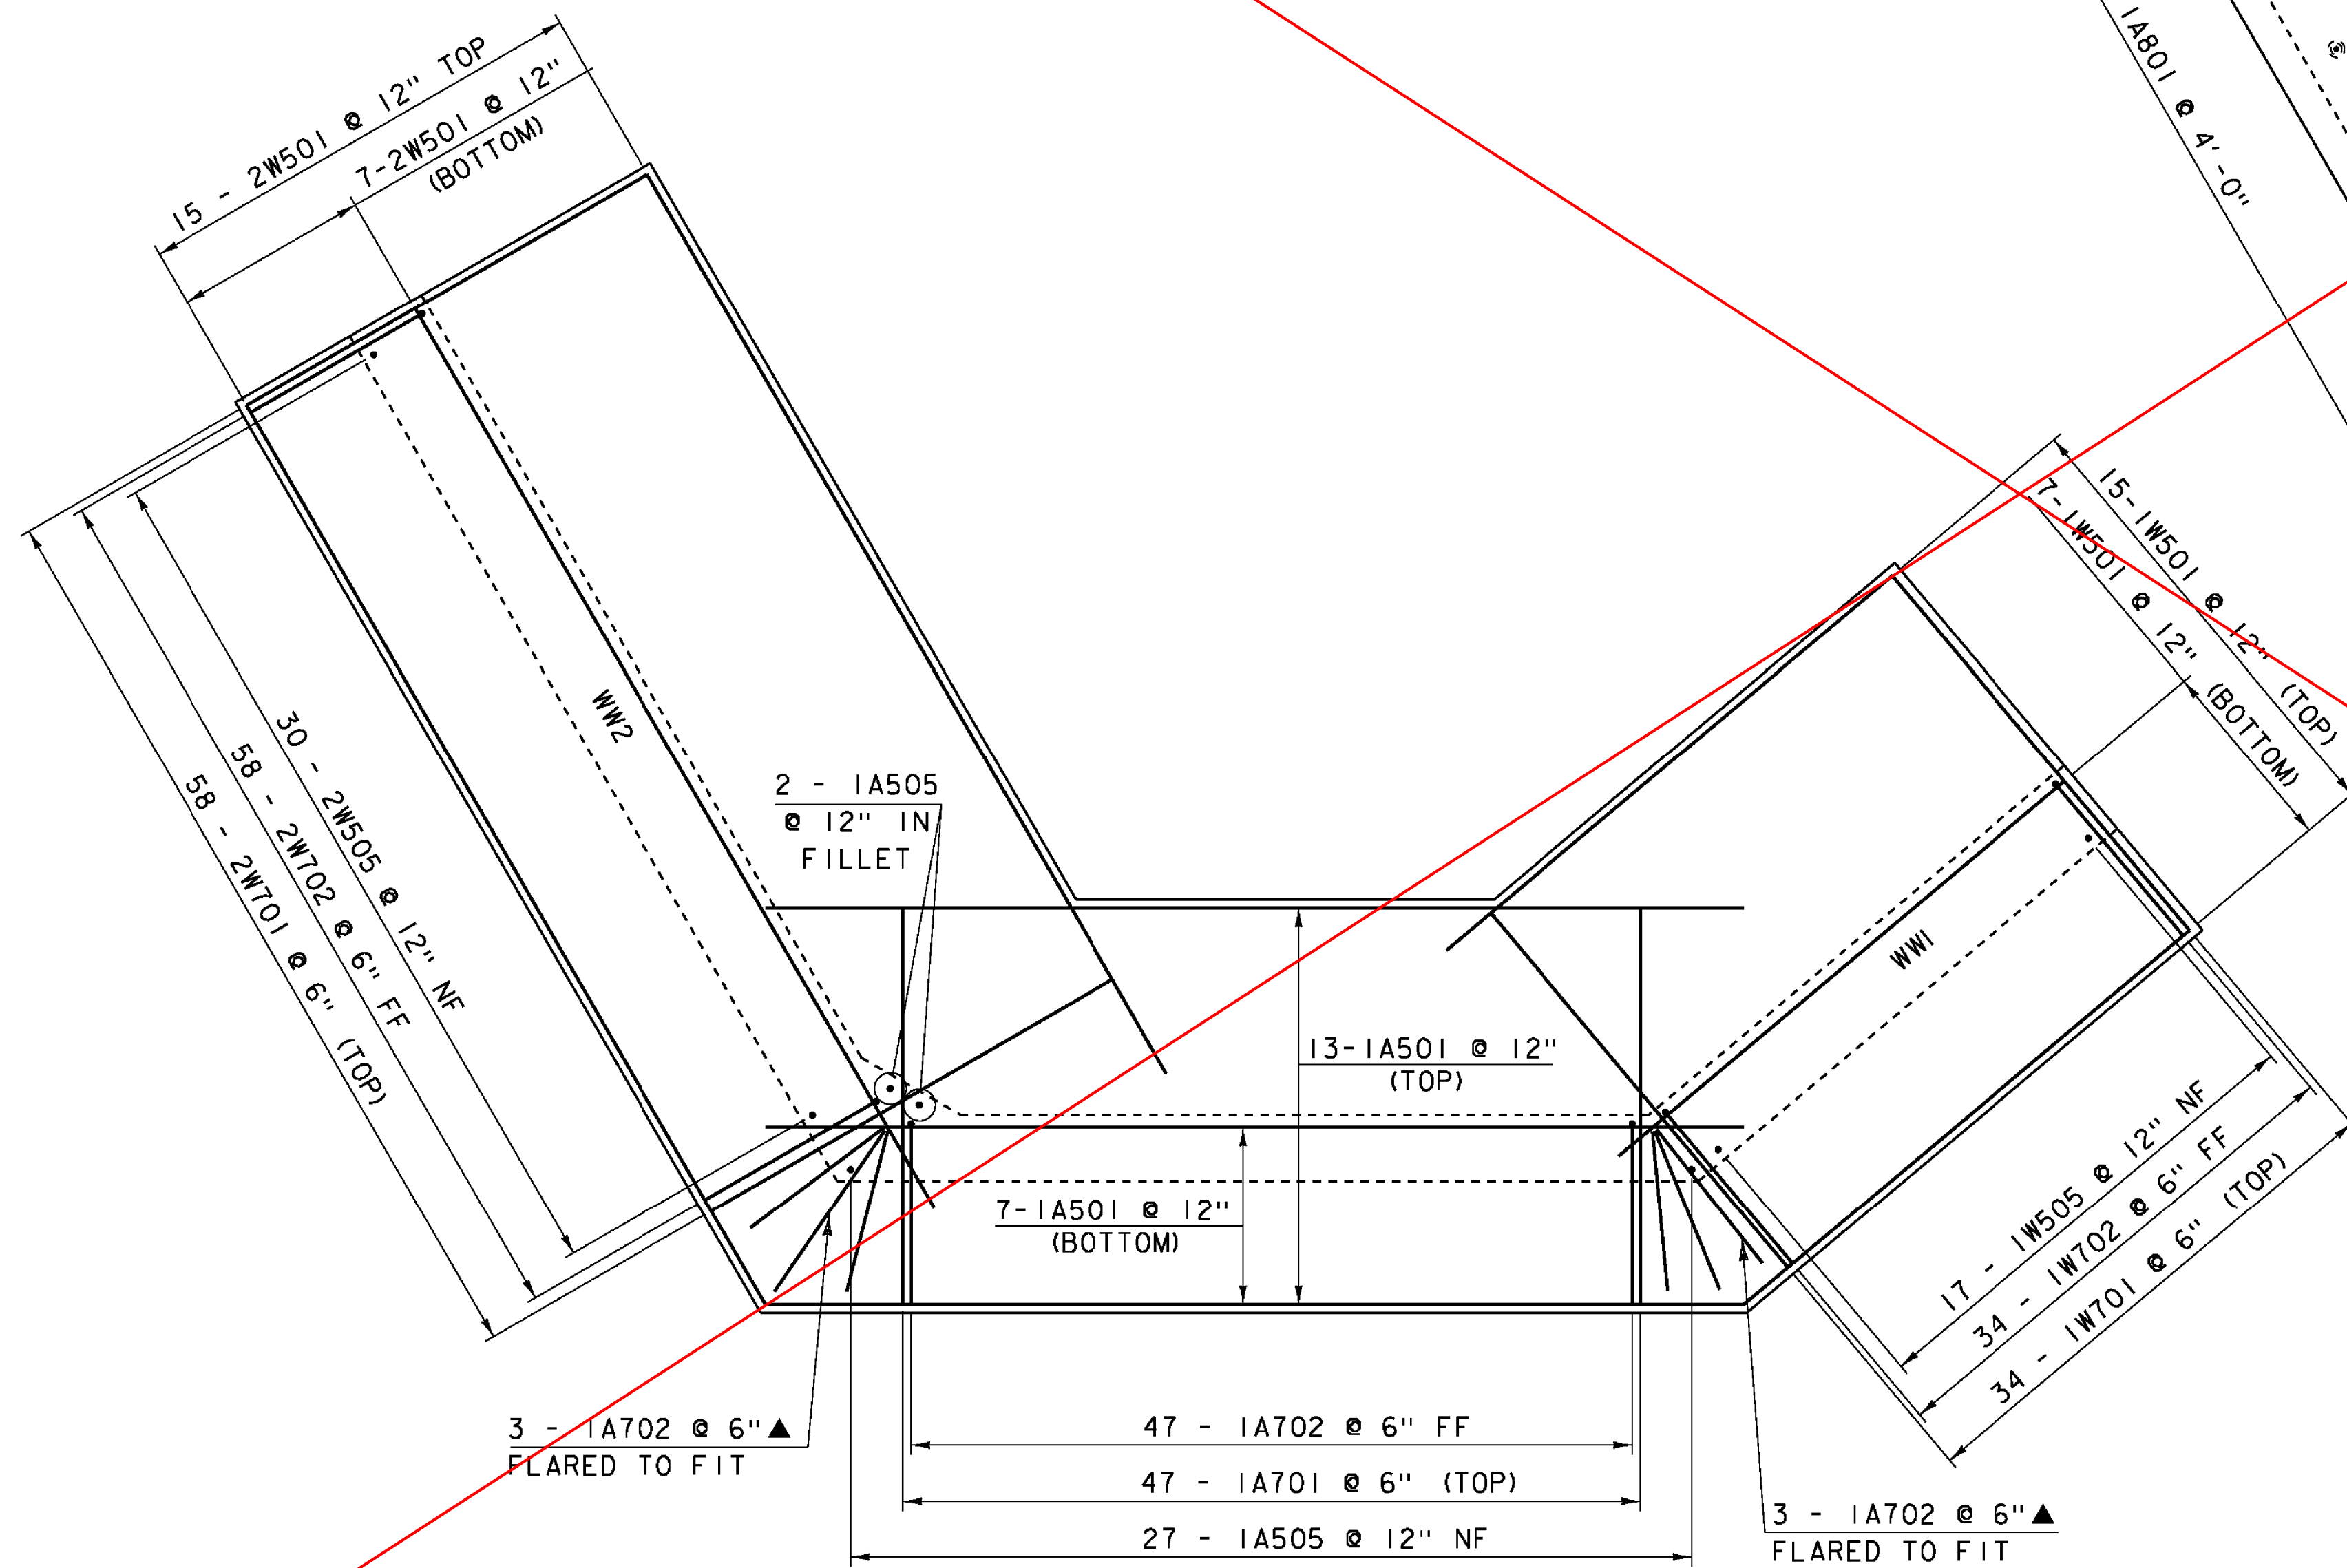

ABUTMENT #1 FOOTING REINFORCING PLAN

SCALE: 1/4" = 1'-0"

**NOTE:**

- NF = NEAR FACE
- FF = FAR FACE
- EF = EACH FACE
- ▲ = CUT TO FIT IN FIELD
- 3" CLEAR, UNLESS OTHERWISE SPECIFIED ON THE PLANS.
- 2'-2" BAR LAP UNLESS OTHERWISE SPECIFIED ON THE PLANS.

PROJECT NAME:	STAMFORD	PLOT DATE:	24-DEC-2015
PROJECT NUMBER:	STP 1441(29)	DRAWN BY:	D. KARABEGOVIC
FILE NAME:	s96j226sub.dgn	DESIGNED BY:	F. BARROWS
PROJECT LEADER:	C. W. CARLSON	CHECKED BY:	H. SALLS
ABUTMENT #1 FOOTING & SUBFOOTING PLAN		SHEET 23 OF 44	