



BEGIN APPROACH STA. 9+50.00


9+50

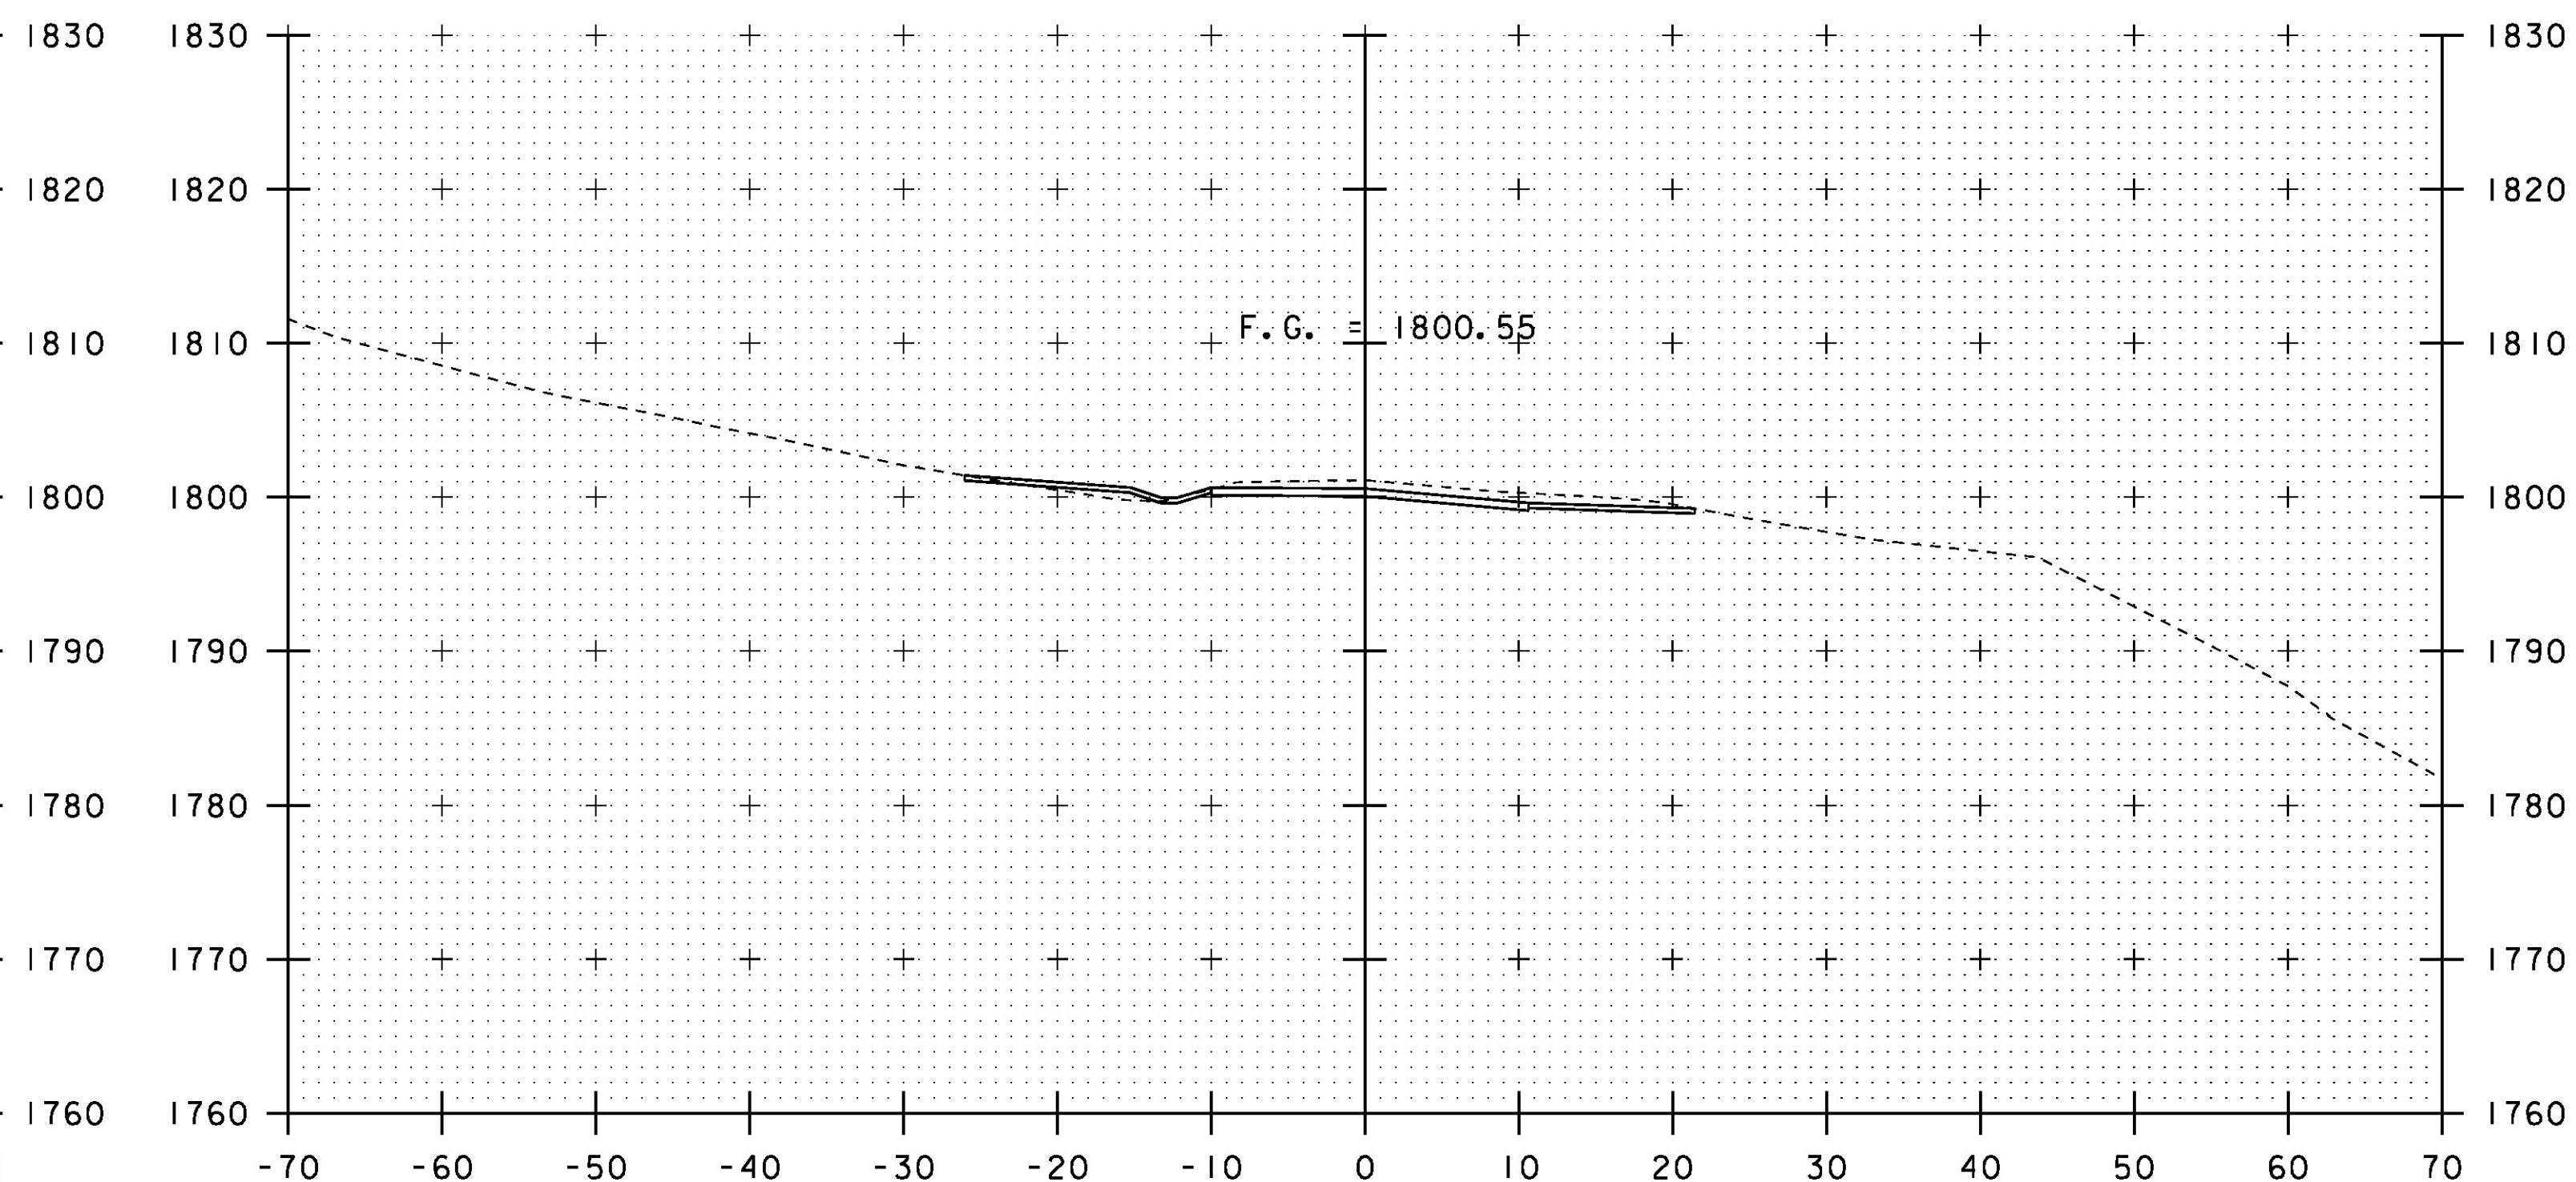

9+86 (125° SKEW)

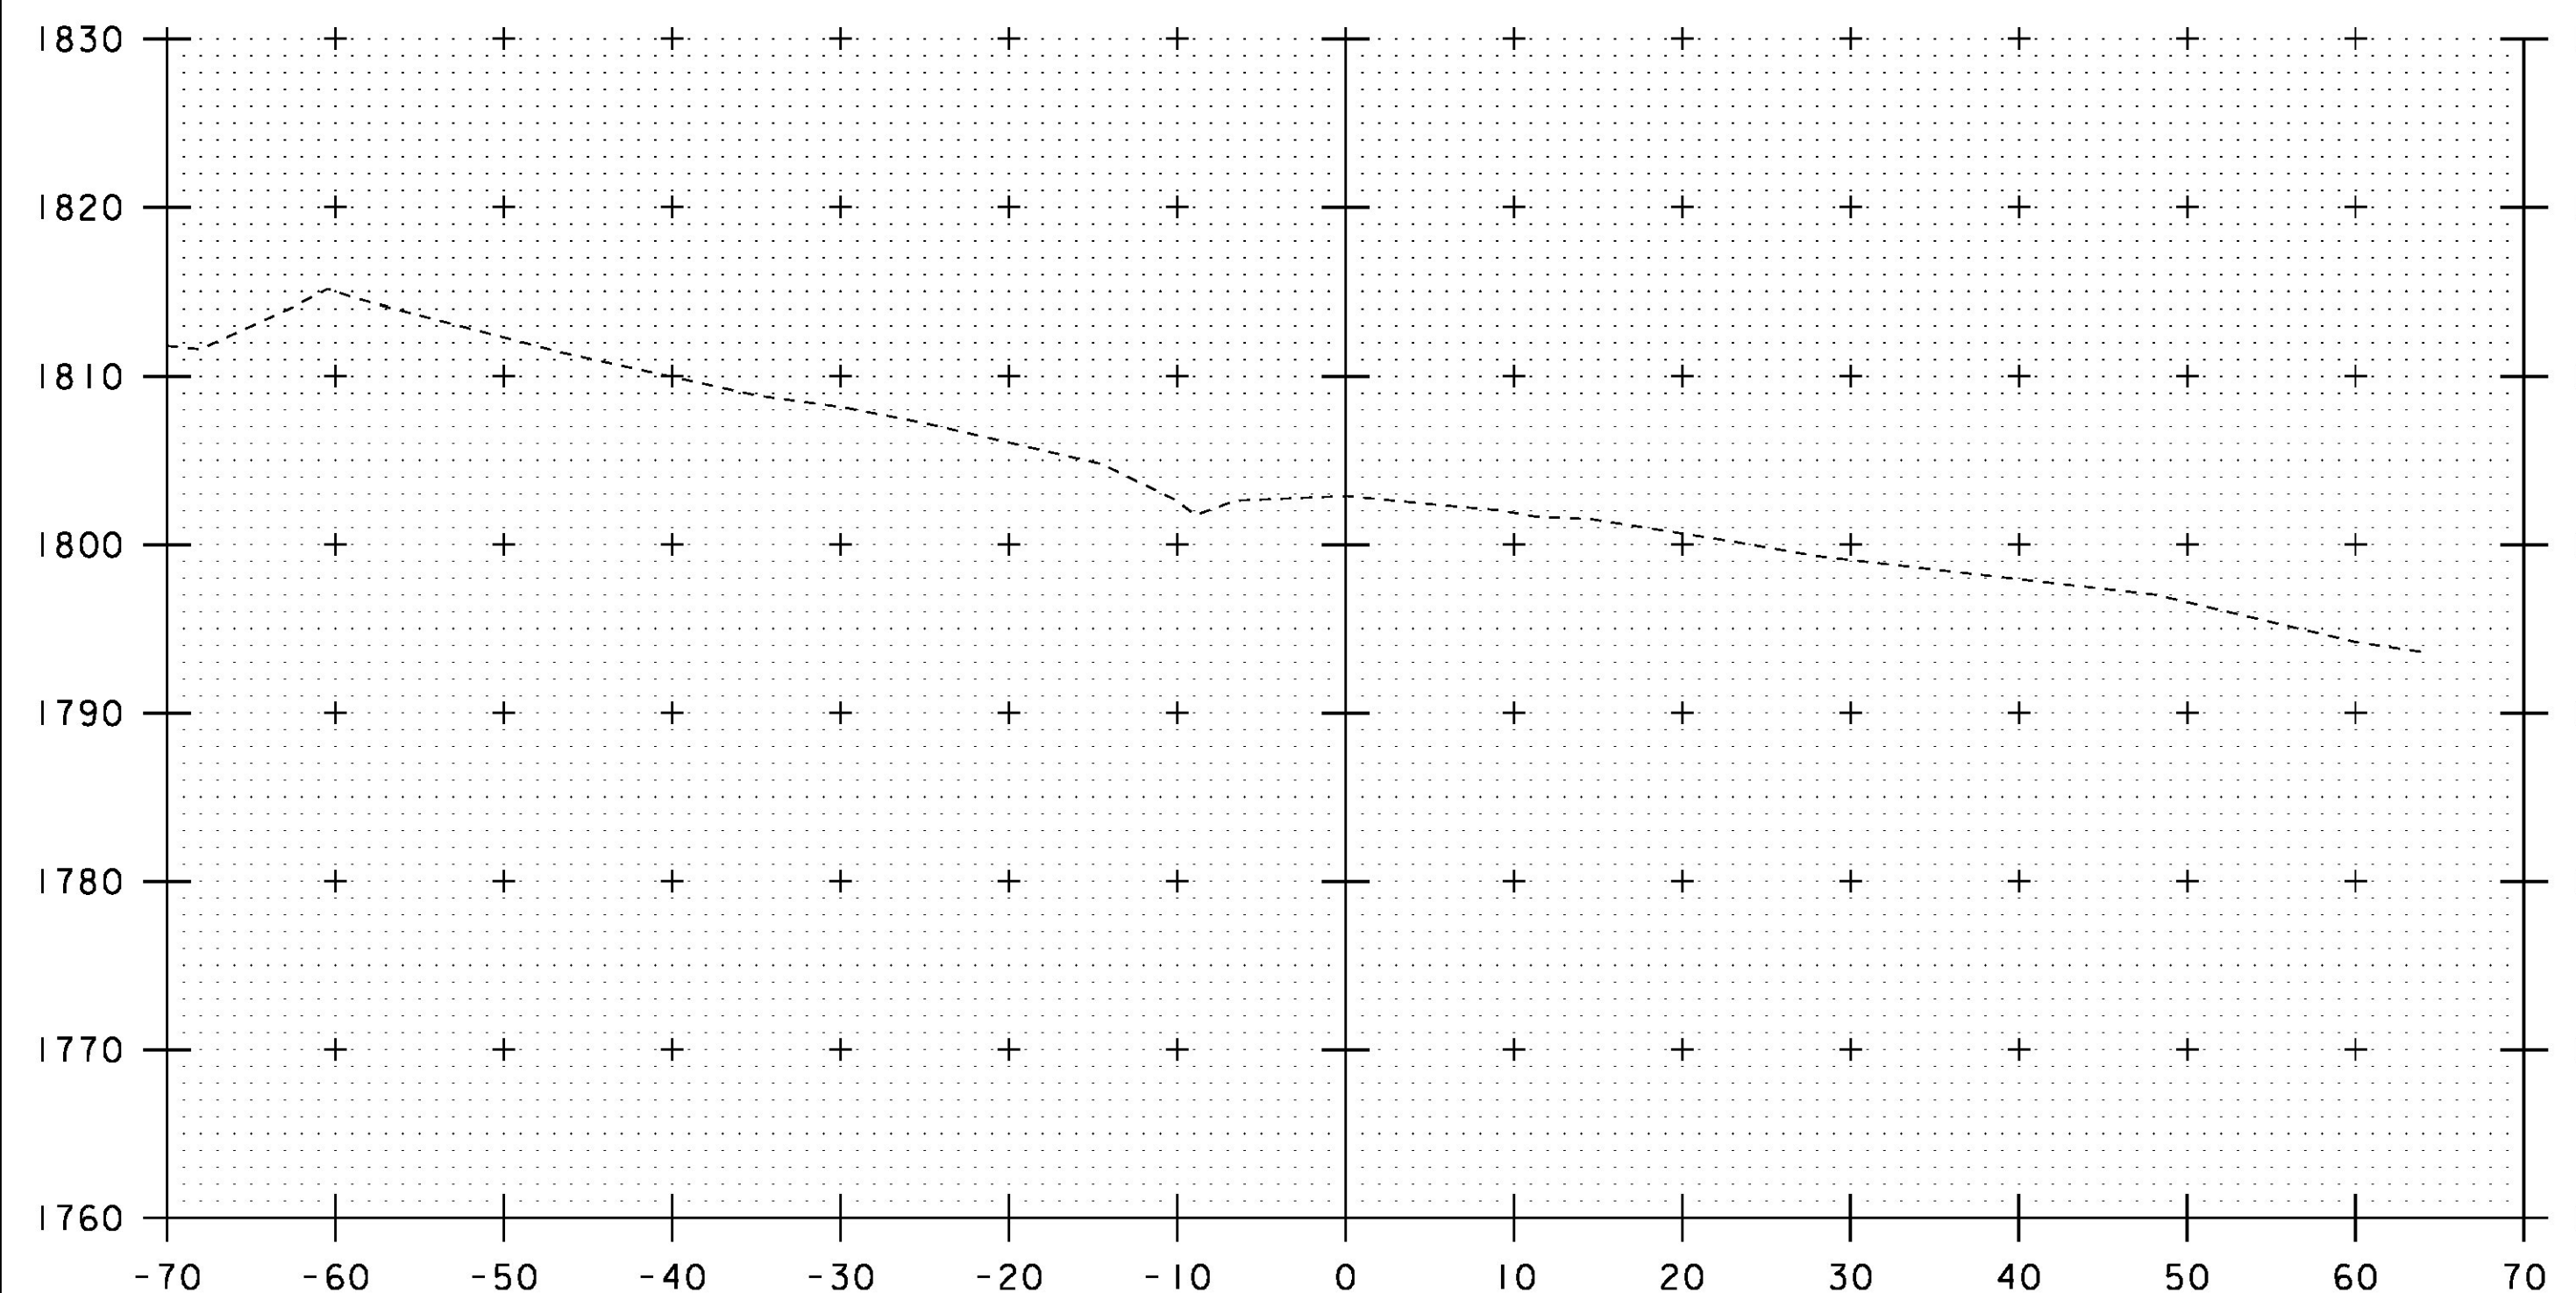

9+25

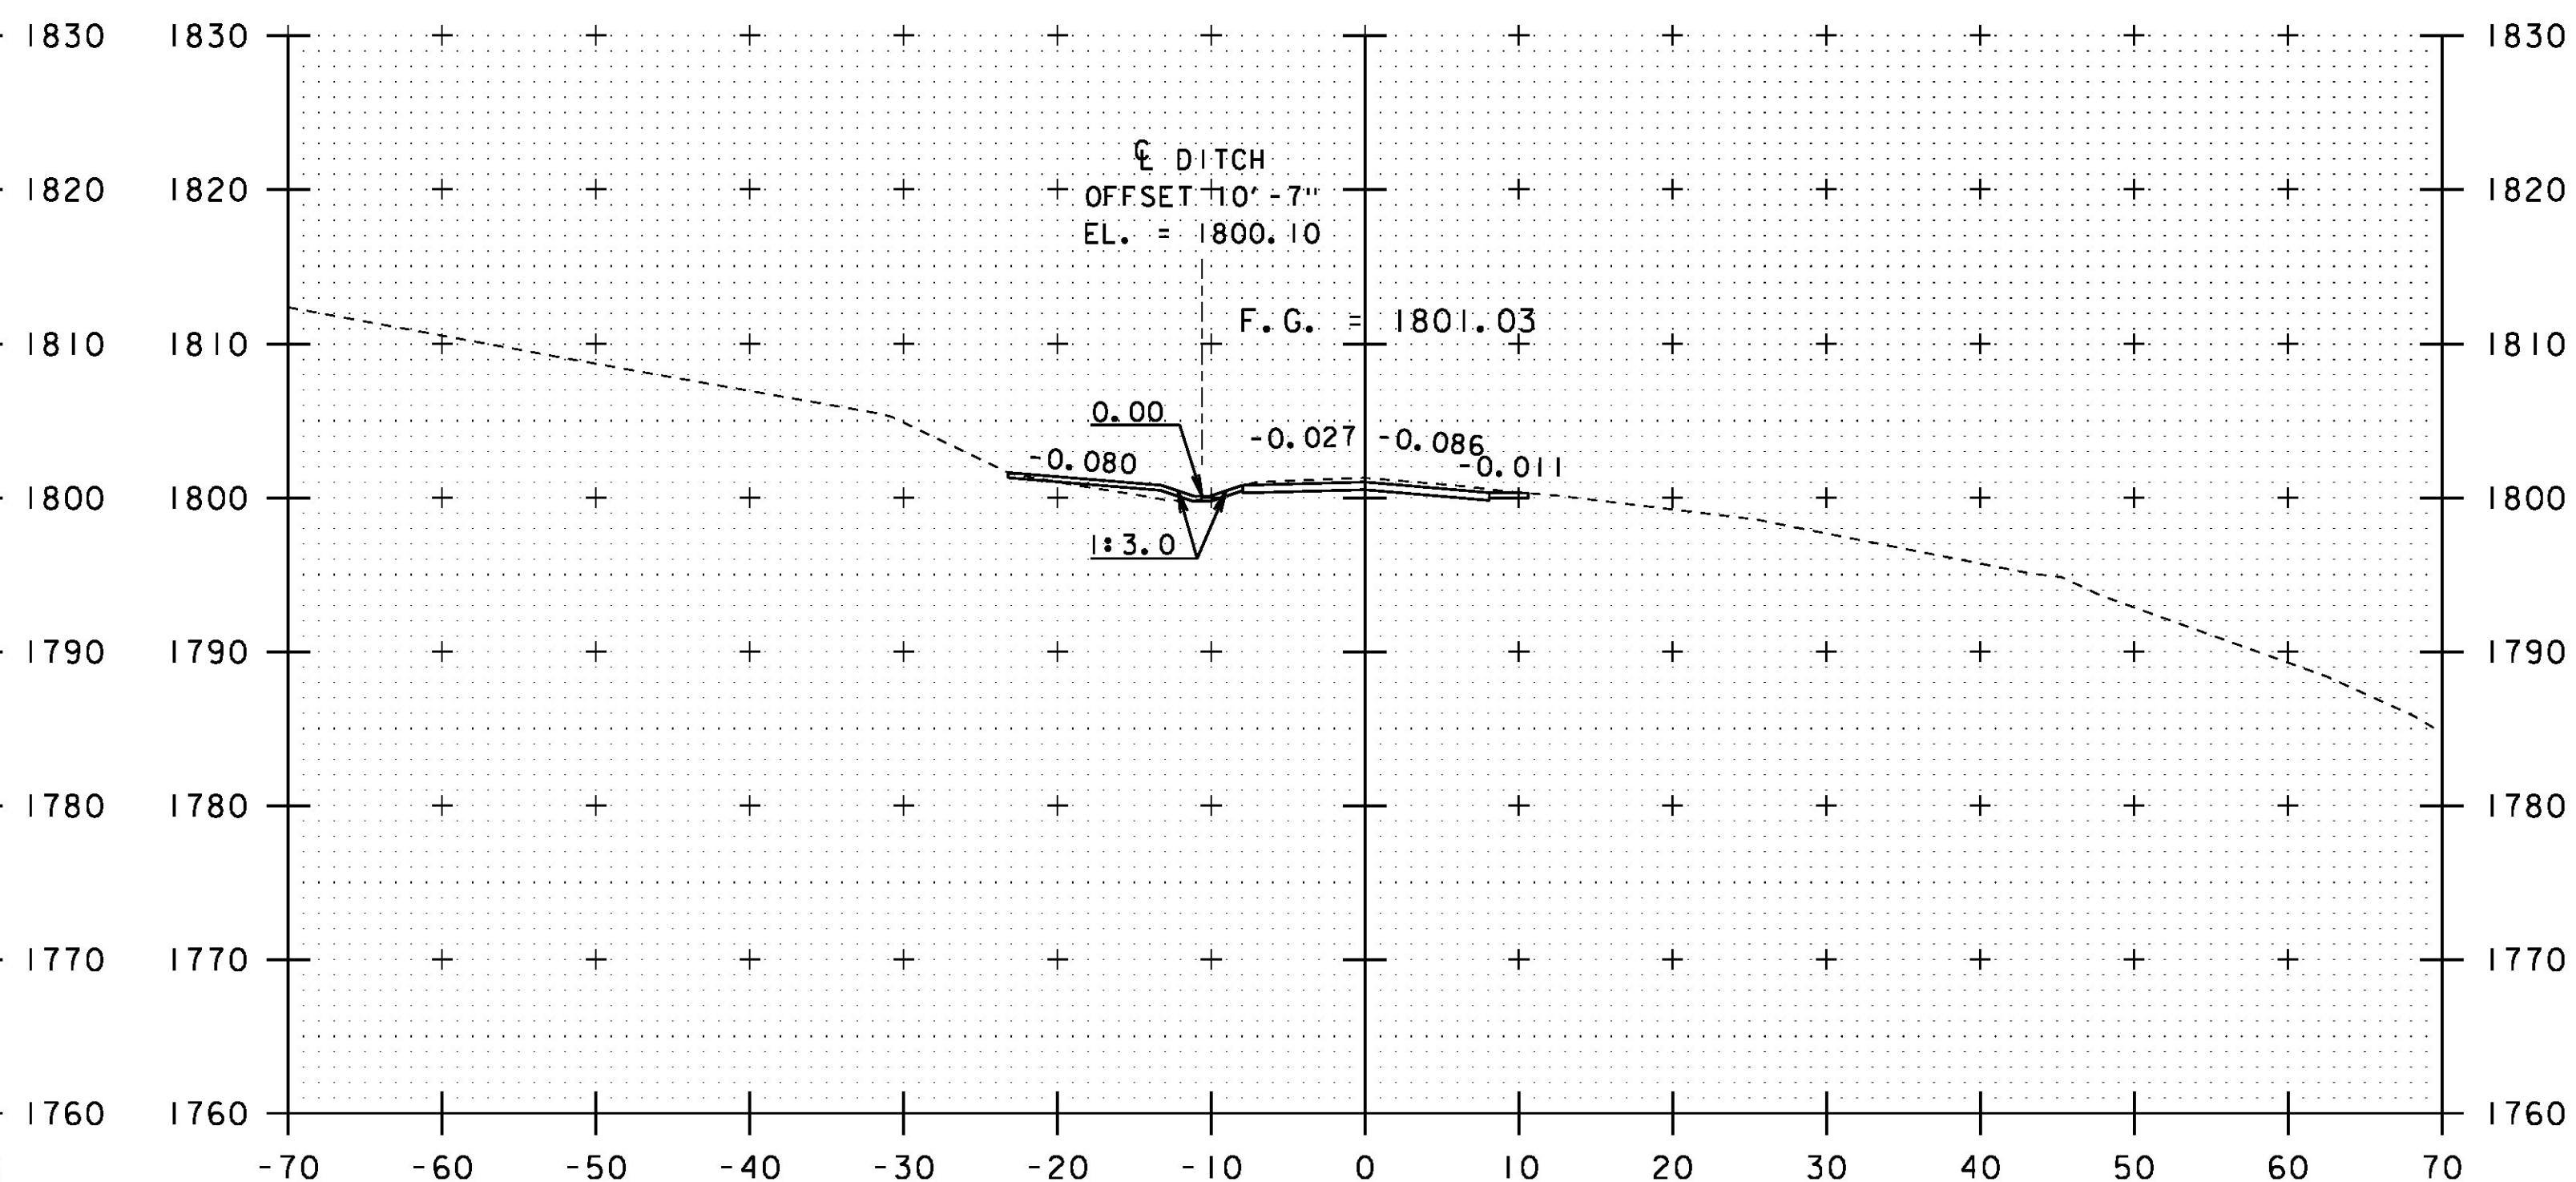

9+75

|                      |               |              |                |
|----------------------|---------------|--------------|----------------|
| PROJECT NAME:        | STAMFORD      | PLOT DATE:   | 03-DEC-2015    |
| PROJECT NUMBER:      | STP 144I(29)  | DRAWN BY:    | D. KARABEGOVIĆ |
| FILE NAME:           | s96j226xs.dgn | DESIGNED BY: | H. SALLS       |
| PROJECT LEADER:      | C.W. CARLSON  | CHECKED BY:  | H. SALLS       |
| TH4 CROSS SECTIONS I |               |              | SHEET 27 OF 44 |

STA. 9+25 TO STA. 9+86