



BEGIN PROJECT STA. 10+37.50


10+25

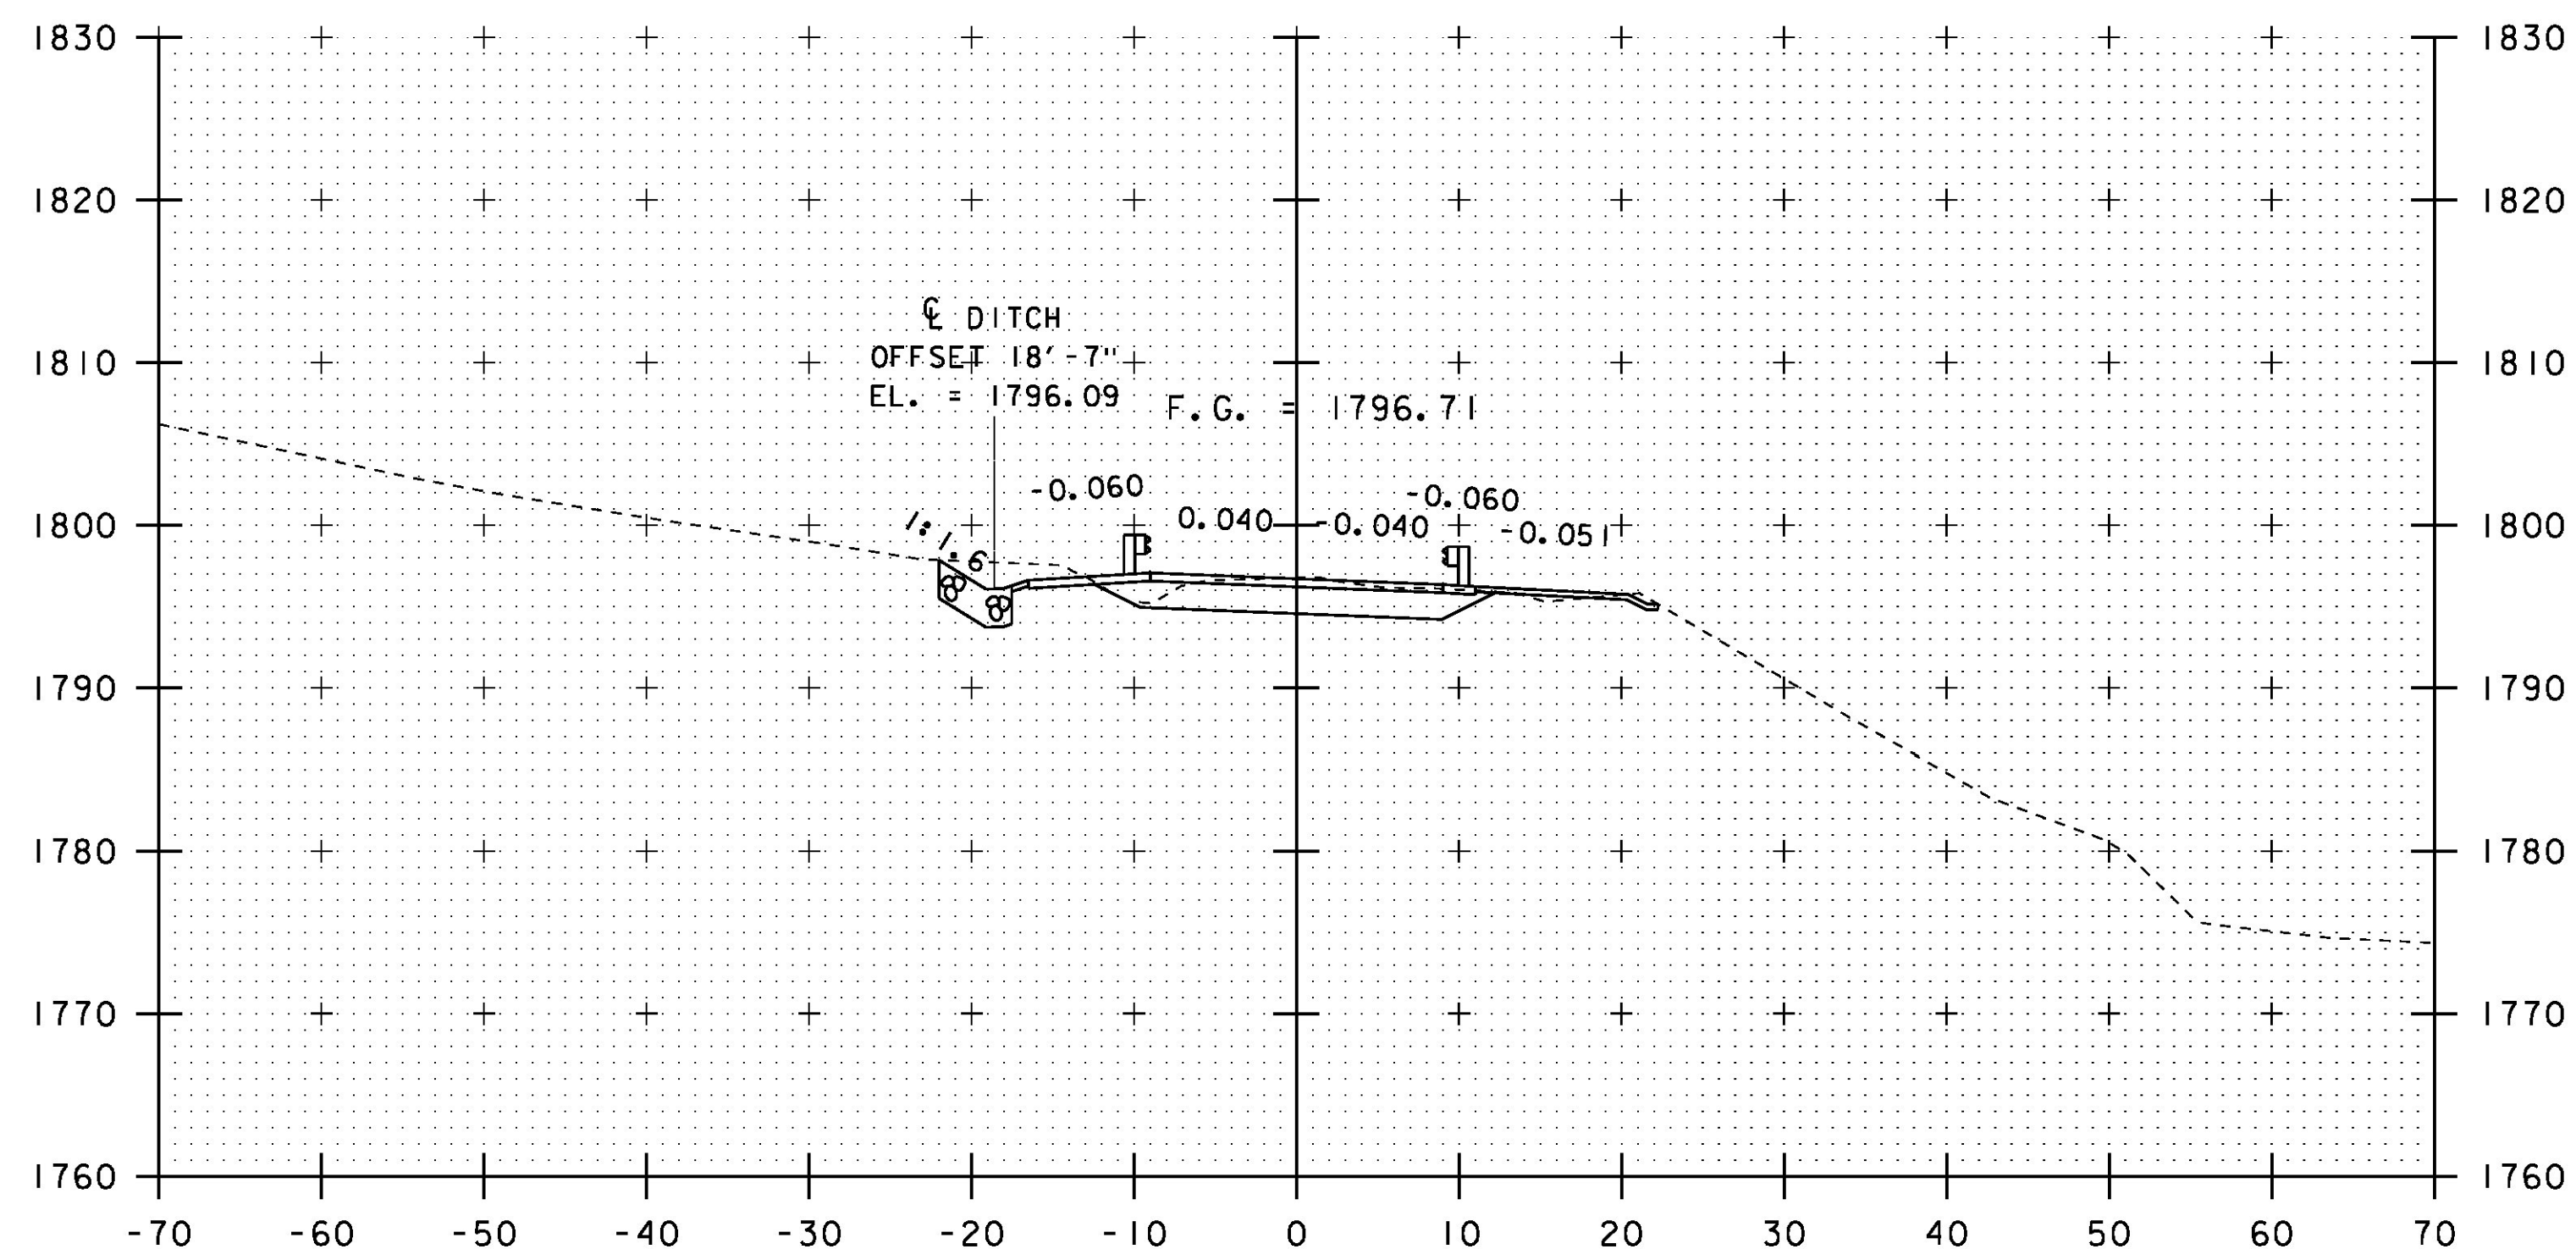

10+75

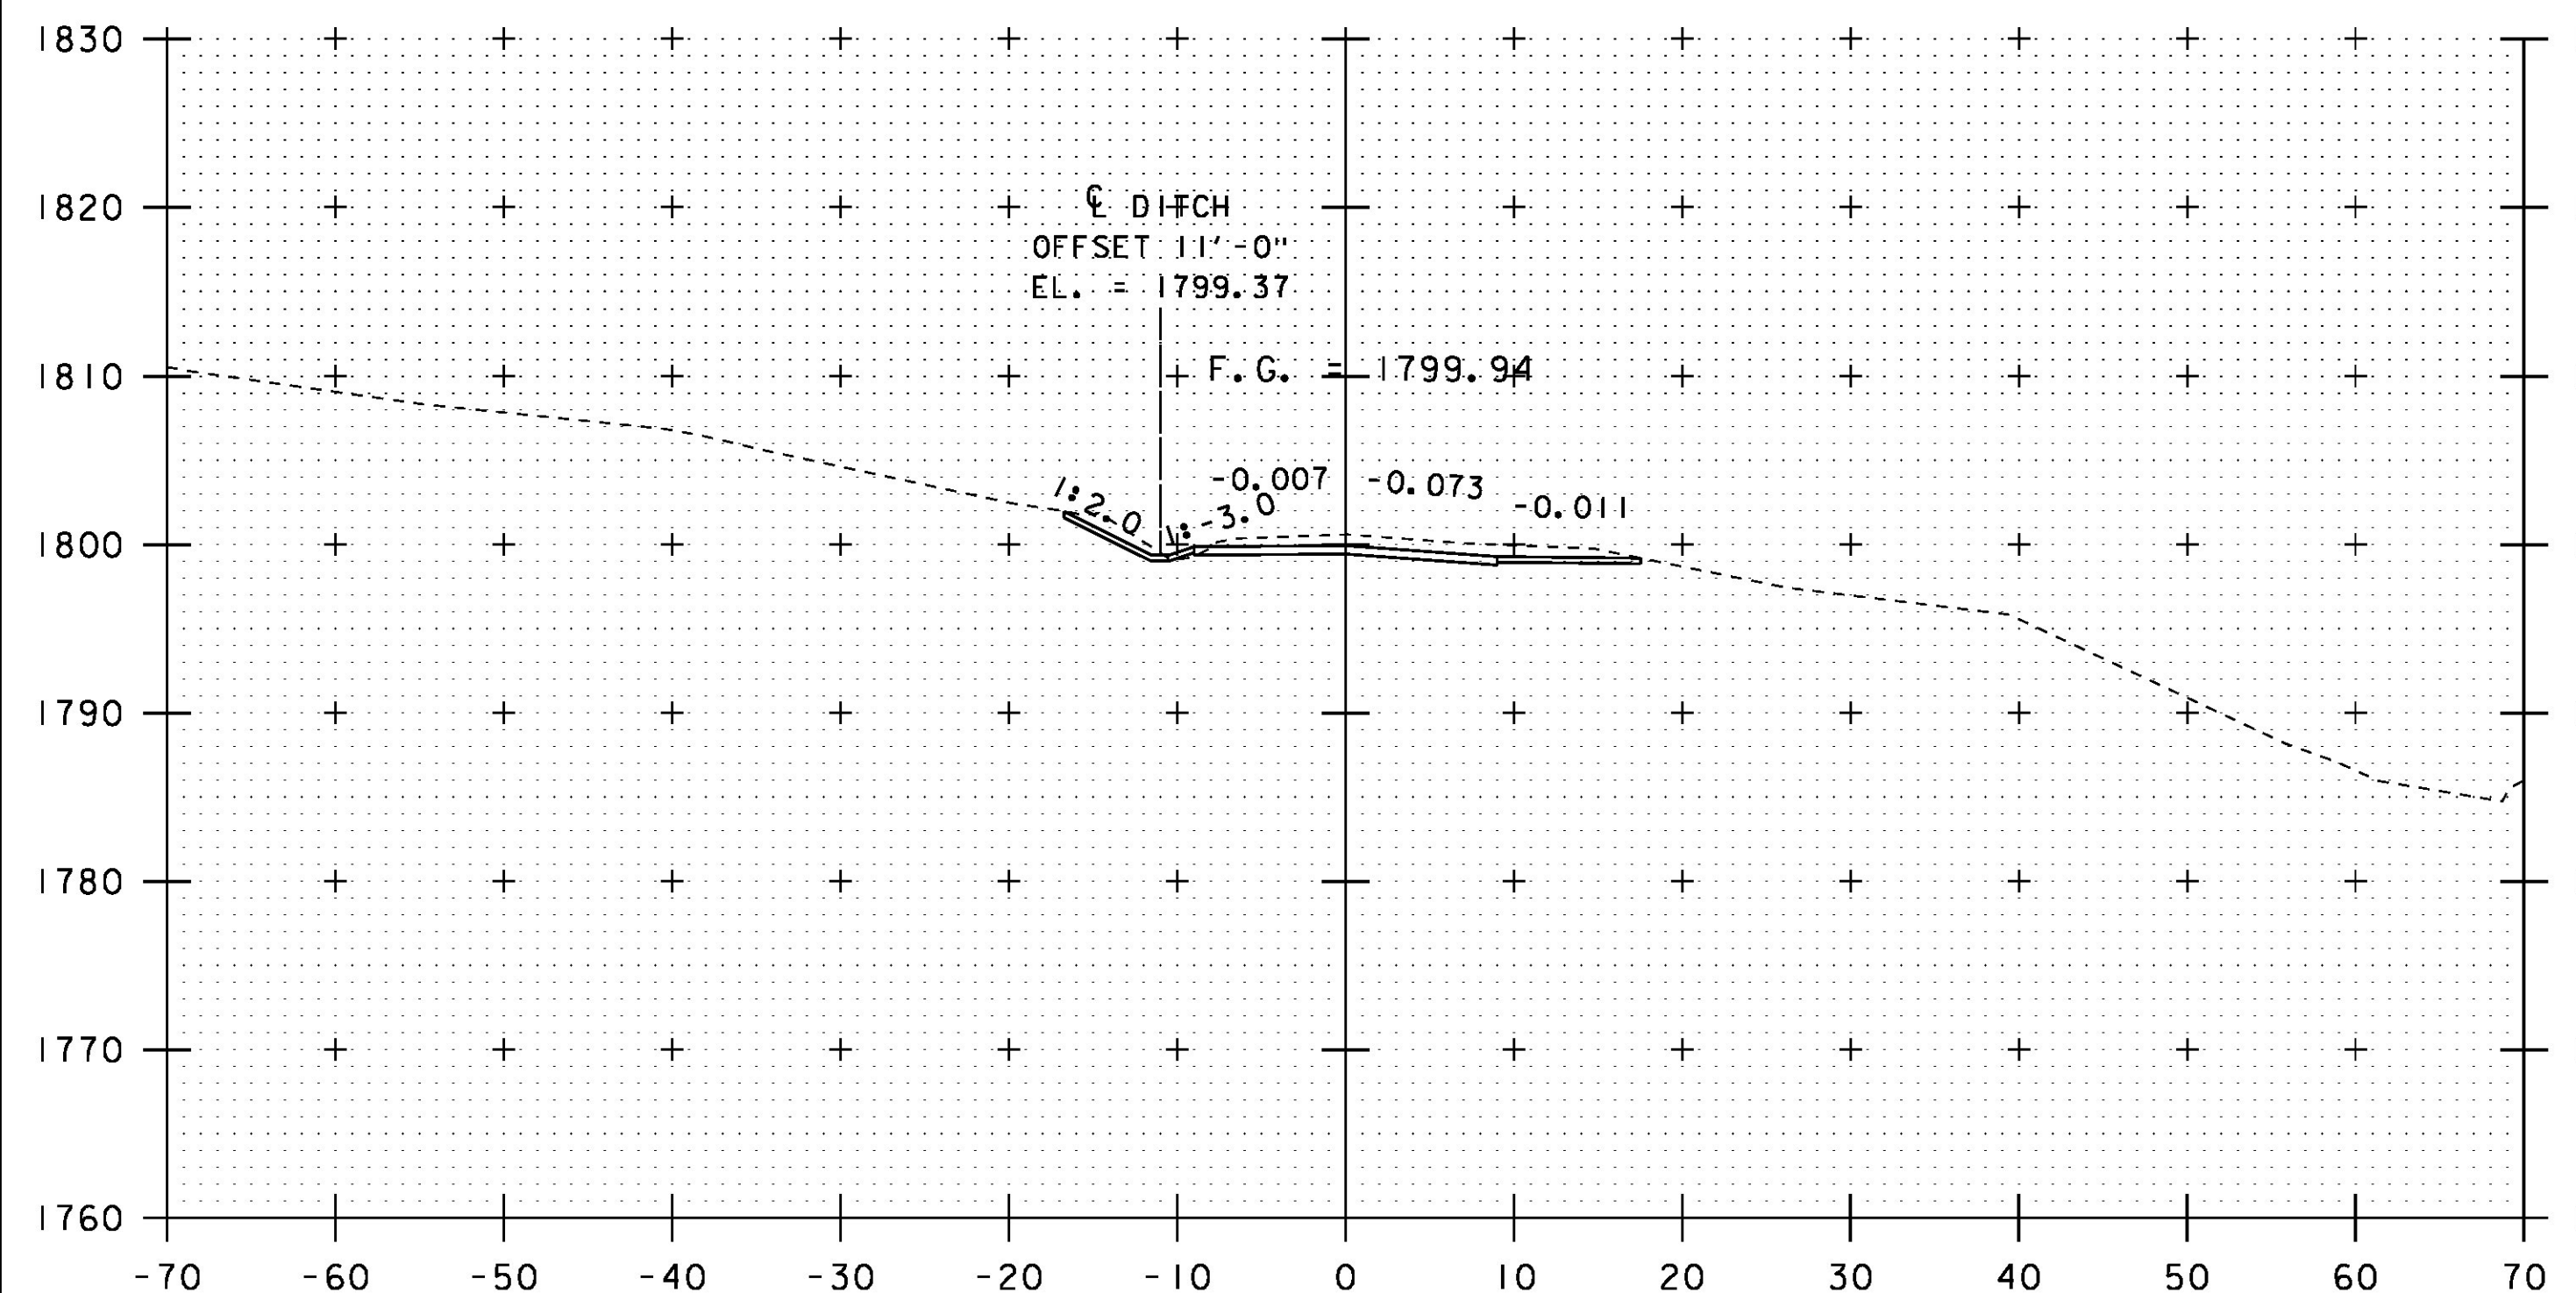

10+00

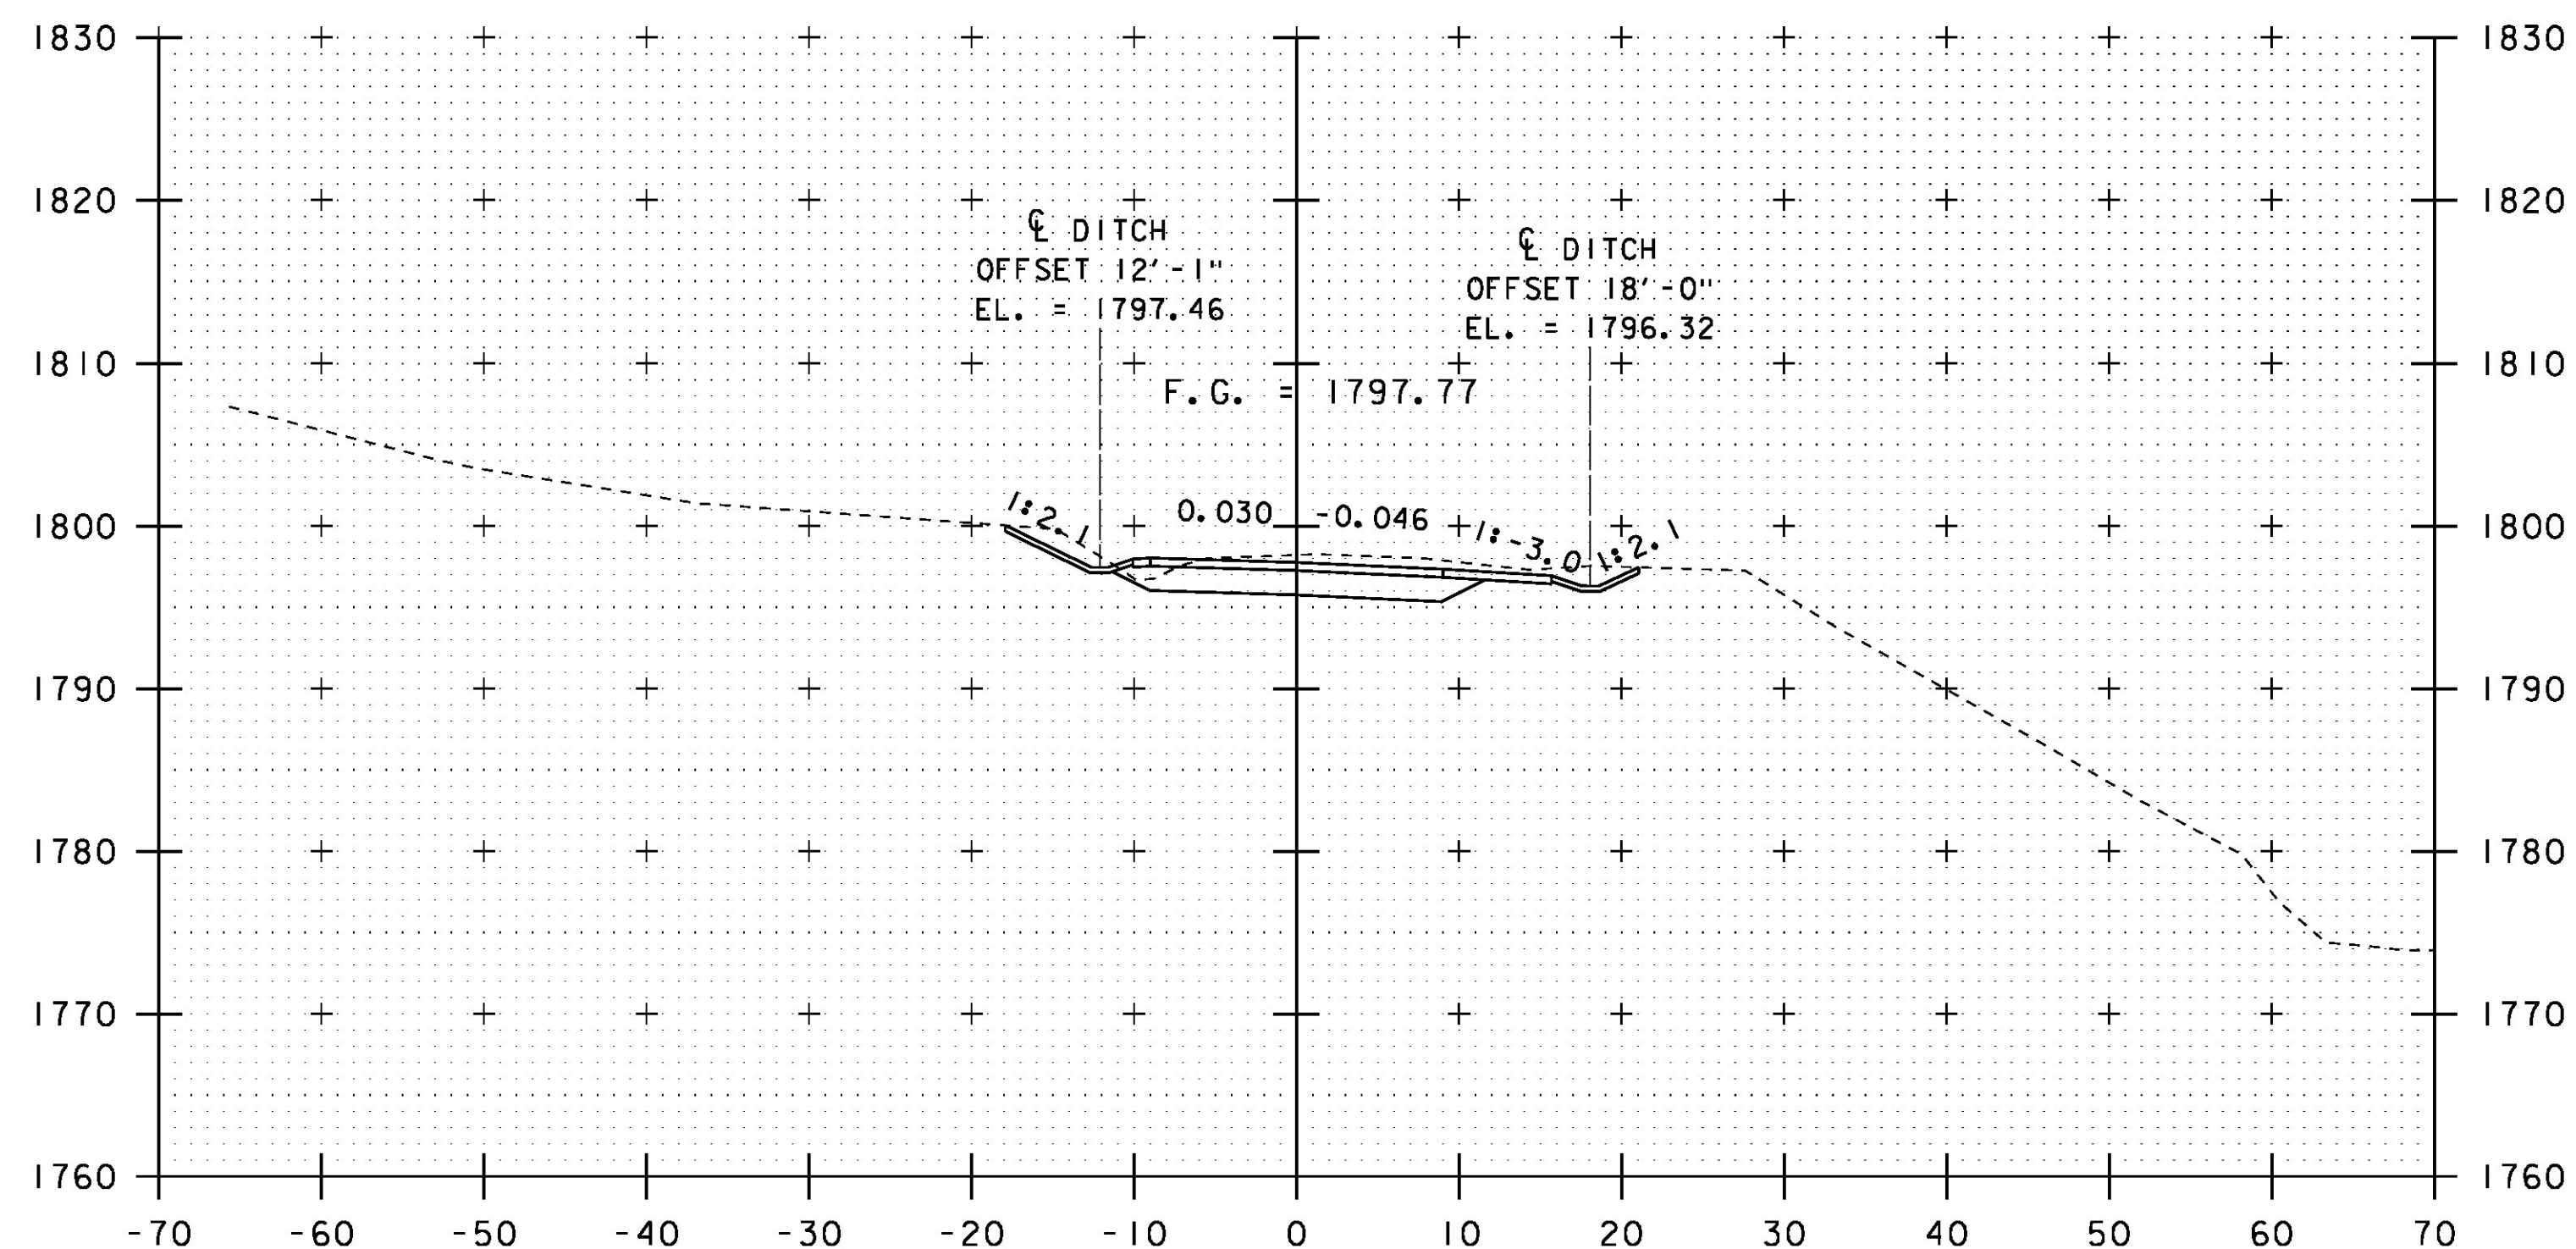

10+50

PROJECT NAME:	STAMFORD	PLOT DATE:	03-DEC-2015
PROJECT NUMBER:	STP 144I(29)	DRAWN BY:	D. KARABEGOVIC
FILE NAME:	s96j226xs.dgn	DESIGNED BY:	H. SALLS
PROJECT LEADER:	C.W. CARLSON	CHECKED BY:	H. SALLS
TH4 CROSS SECTIONS 2		SHEET	28 OF 44

STA. 10+00 TO STA. 10+75