



END PROJECT STA. 12+62.50


12+50

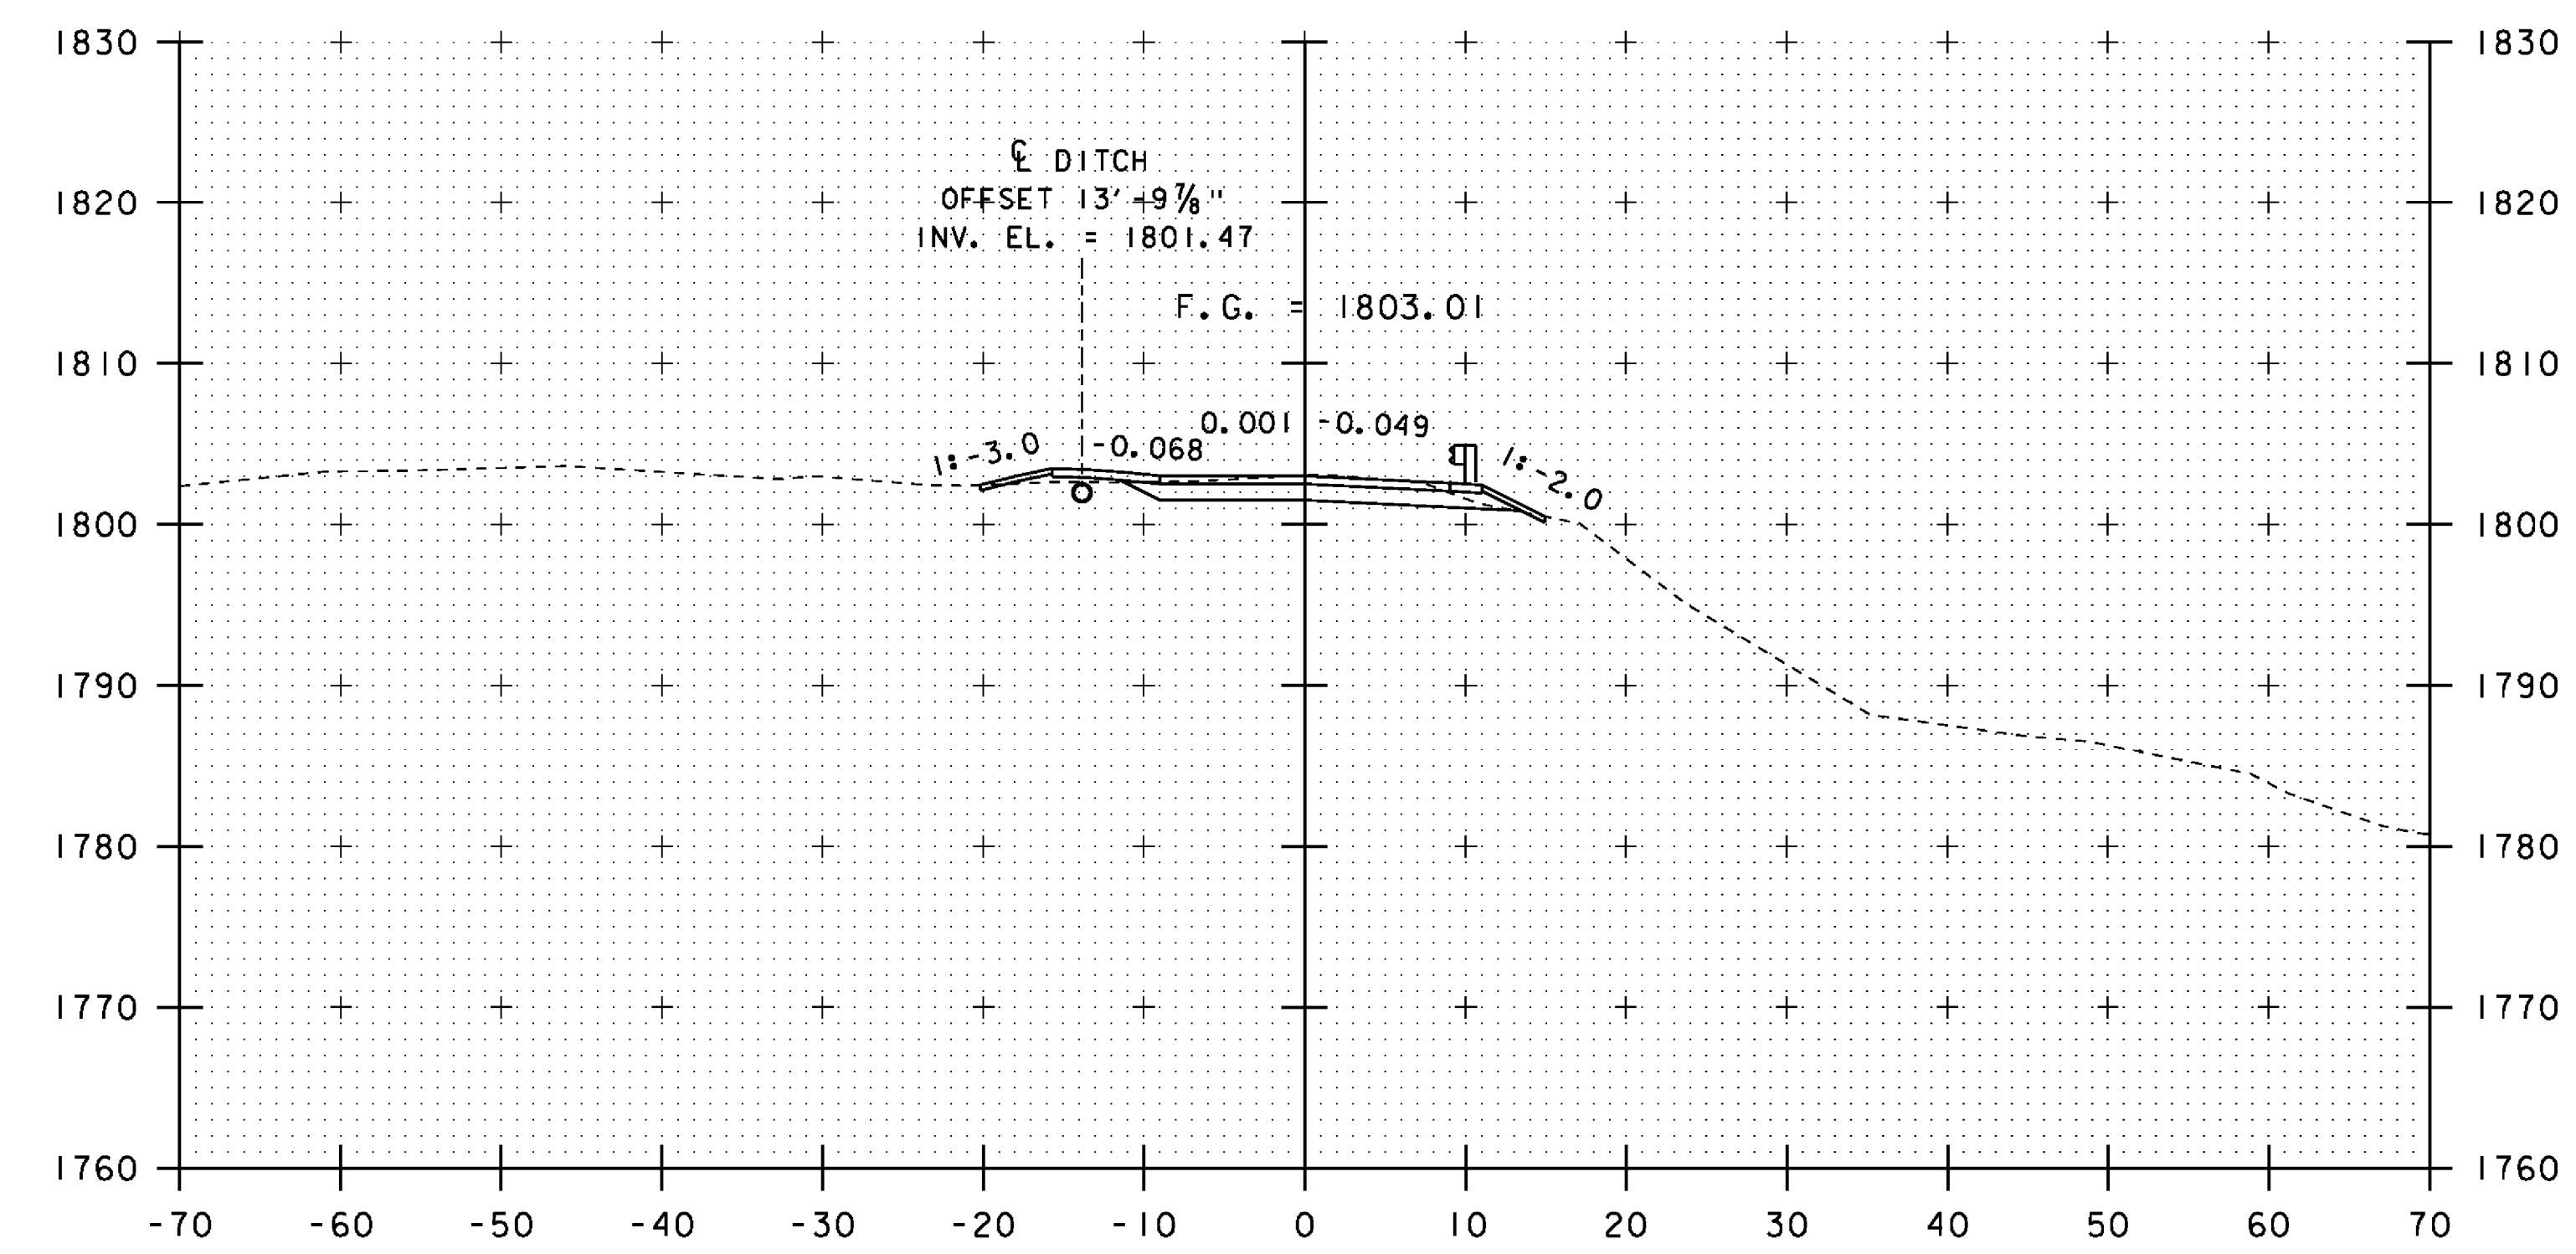

12+75

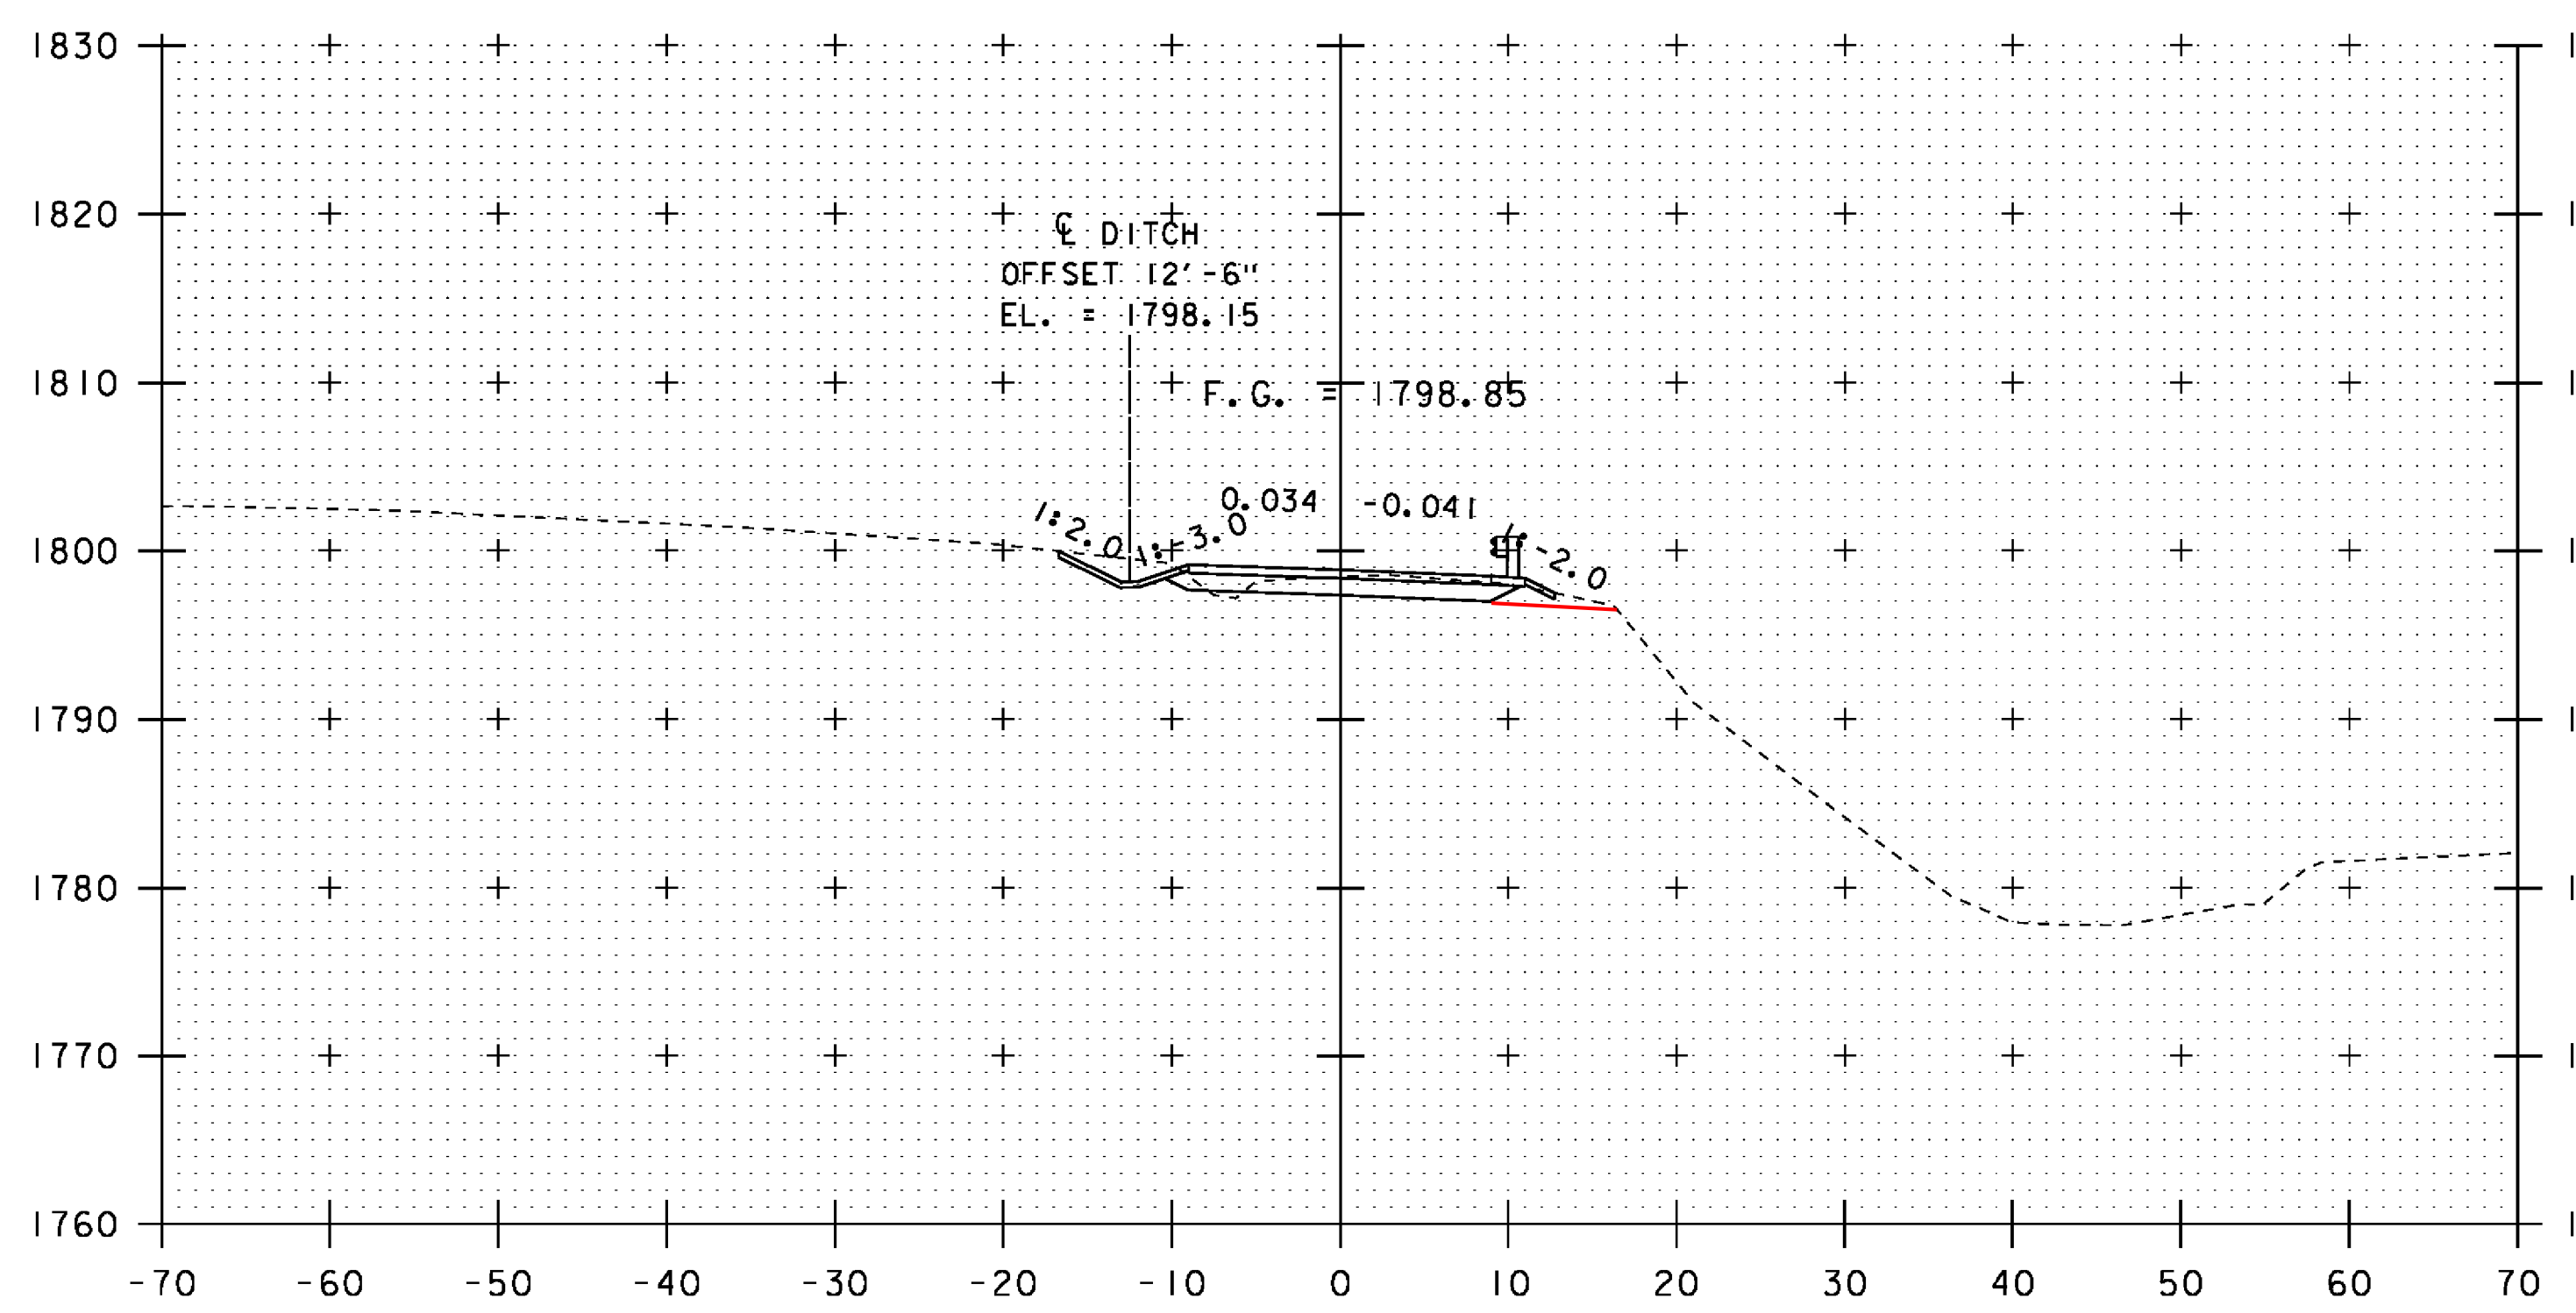

12+25

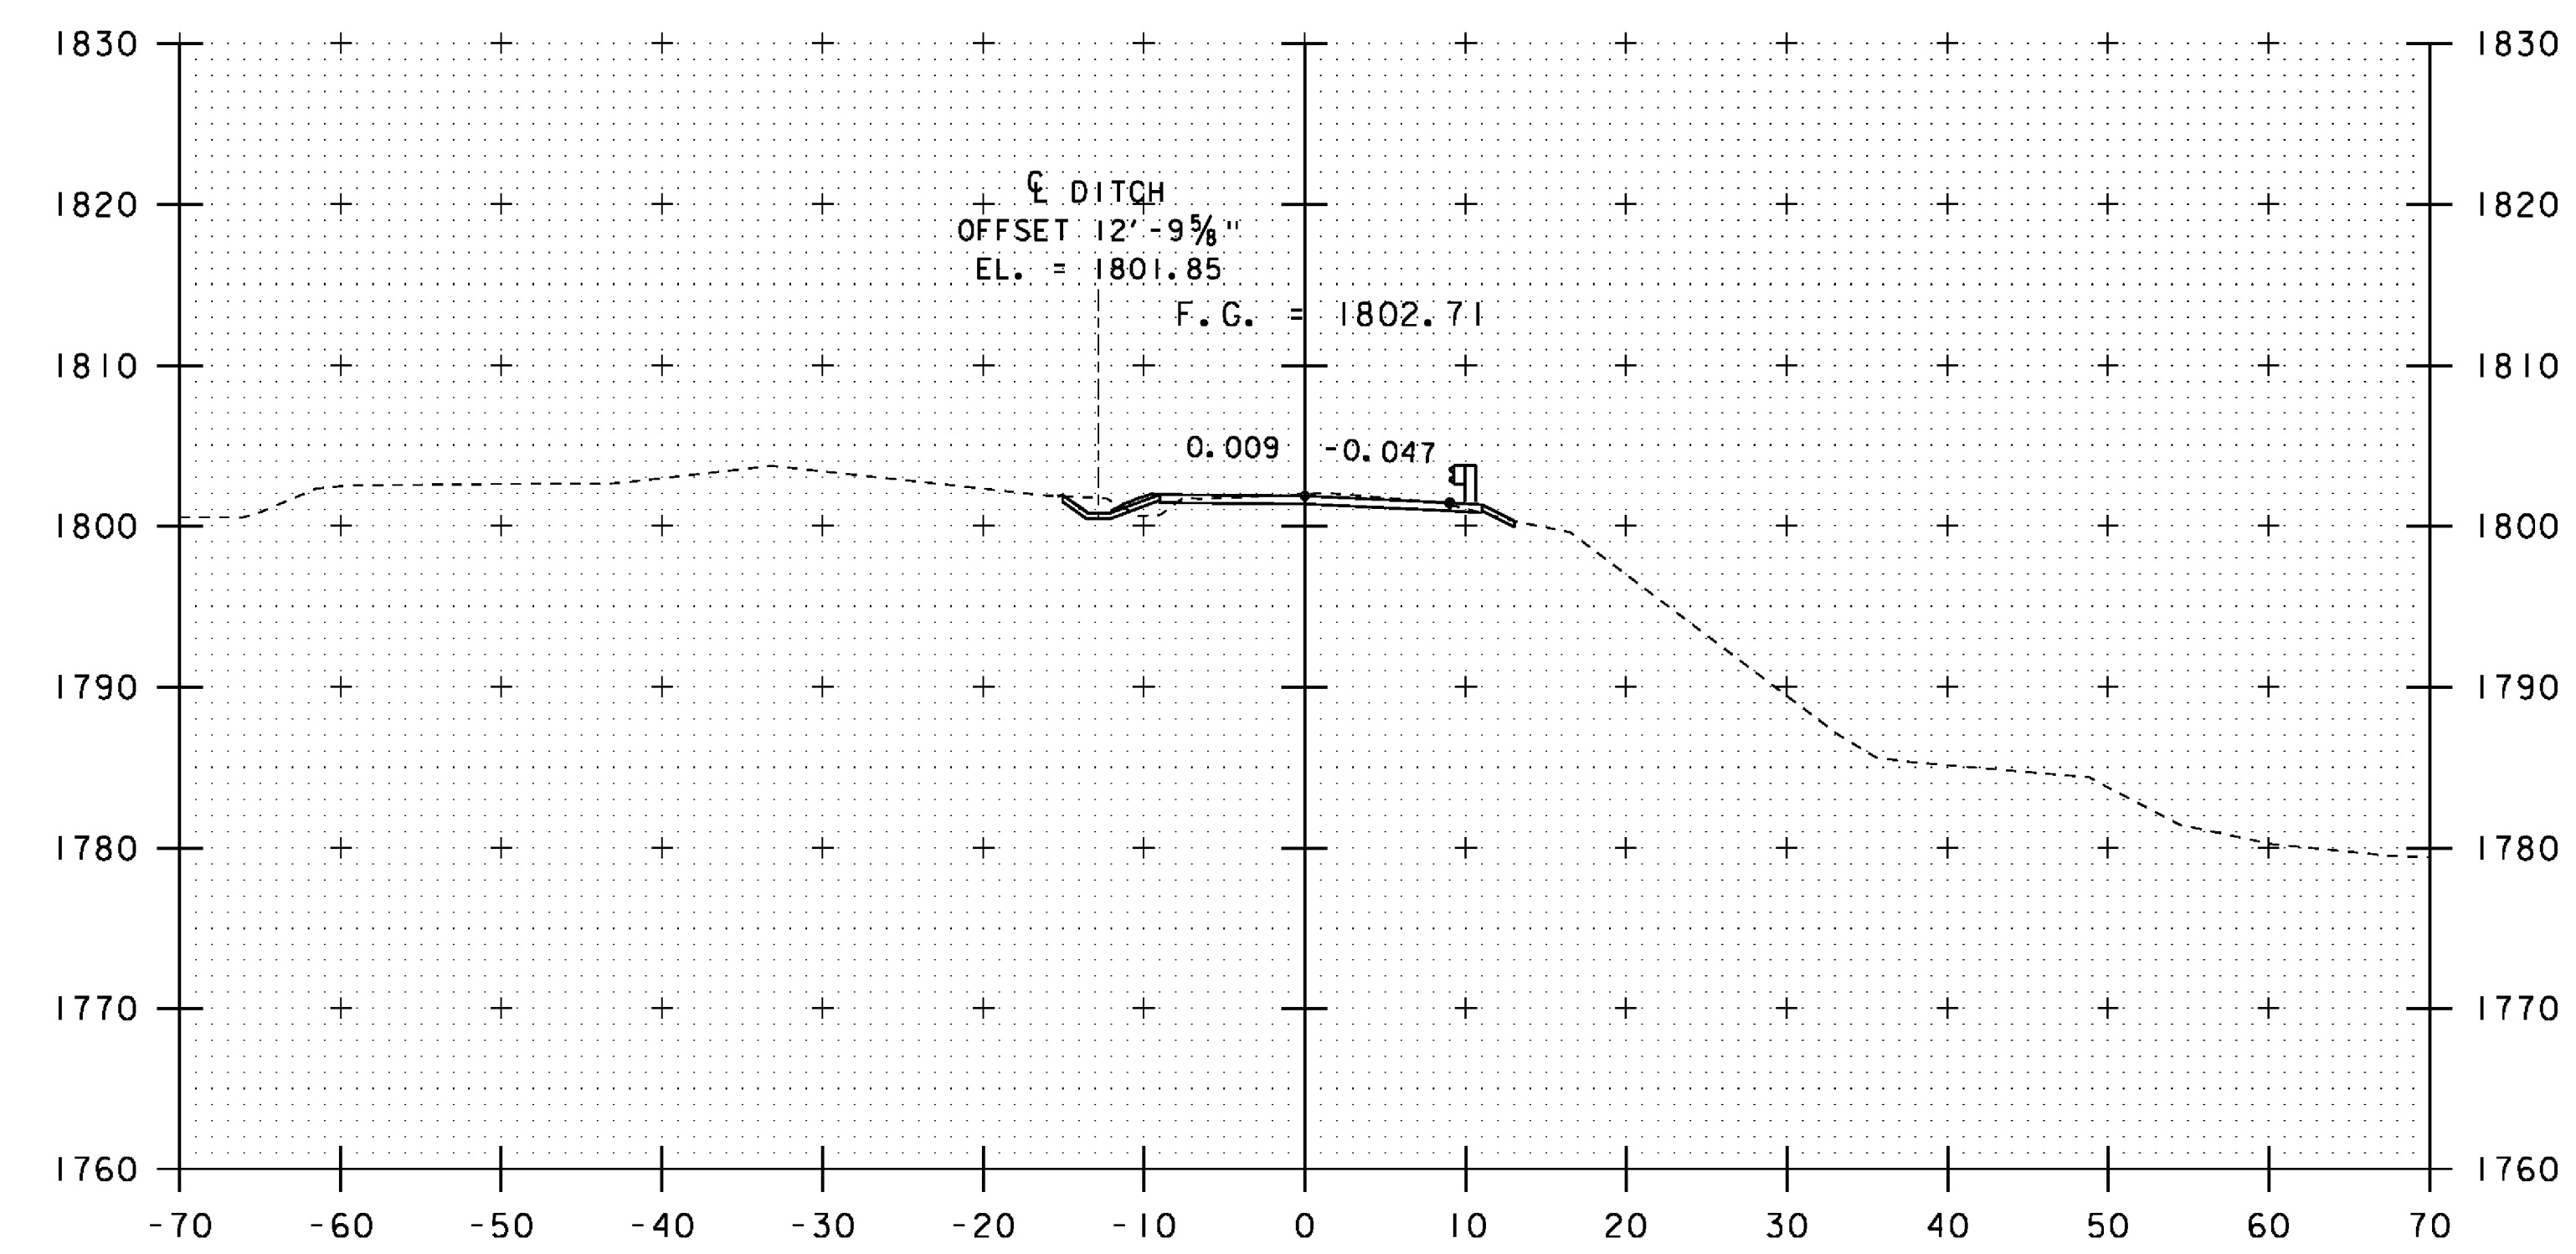

12+63

PROJECT NAME:	STAMFORD	PLOT DATE:	03-DEC-2015
PROJECT NUMBER:	STP 144(29)	DRAWN BY:	D. KARABEGOVIC
FILE NAME:	s96j226xs.dgn	CHECKED BY:	H. SALLS
PROJECT LEADER:	C.W. CARLSON	TH4 CROSS SECTIONS	SHEET 31 OF 44
DESIGNED BY:	H. SALLS		

STA. 12+25 TO STA. 12+75