





13+25

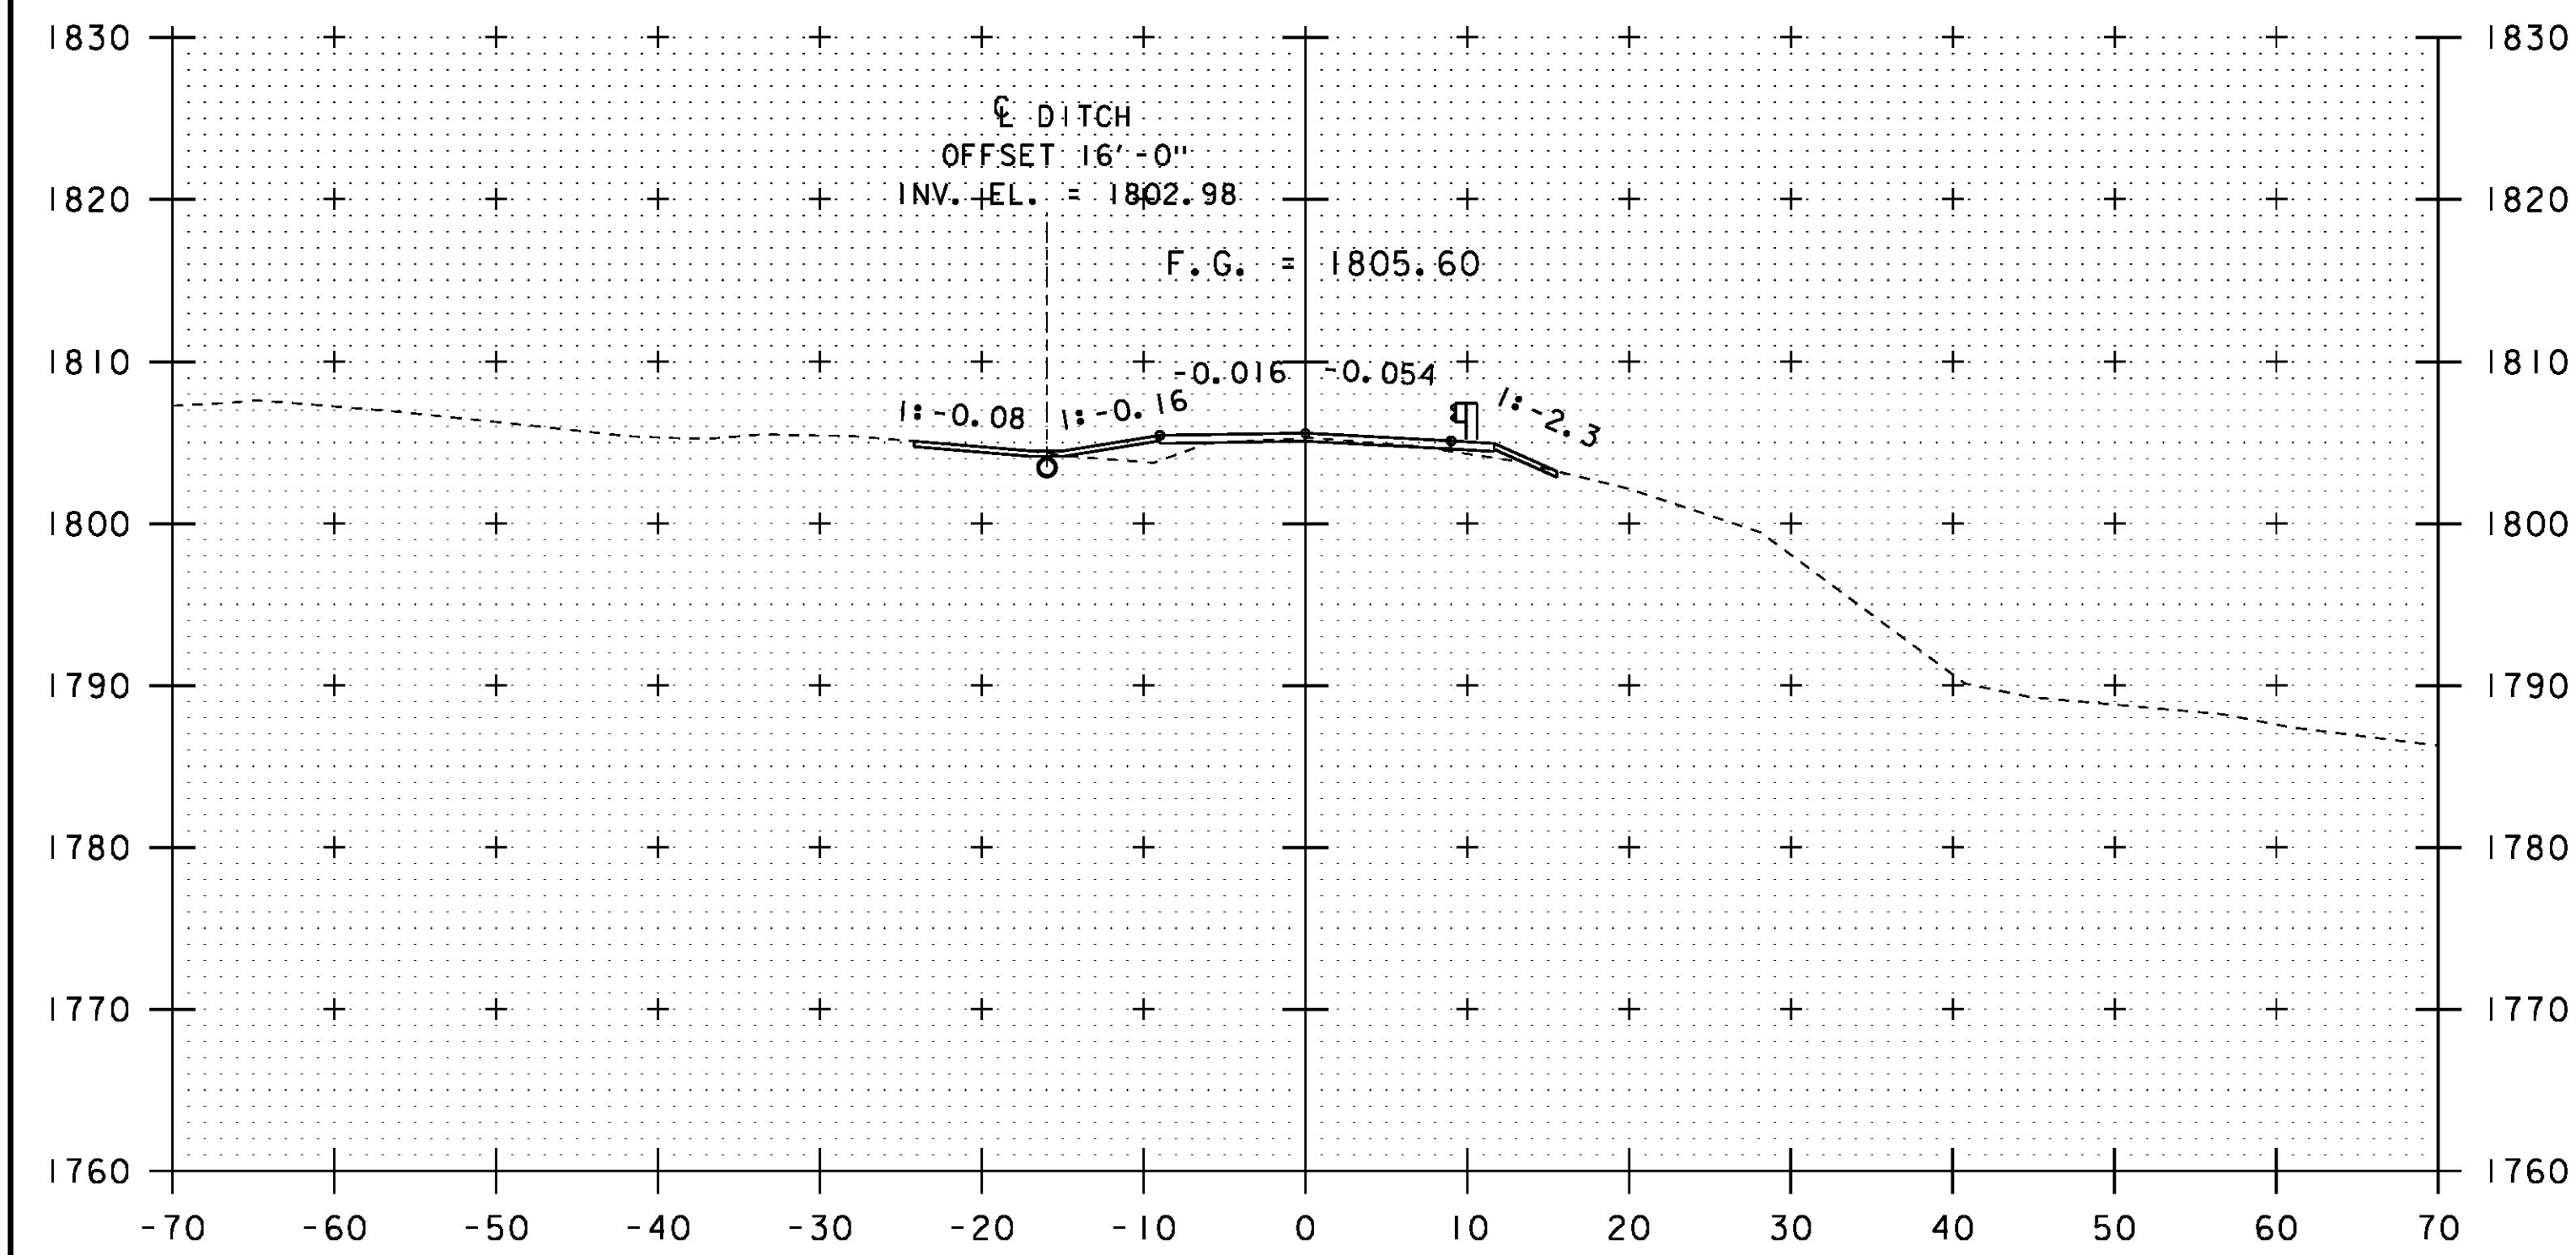

13+00

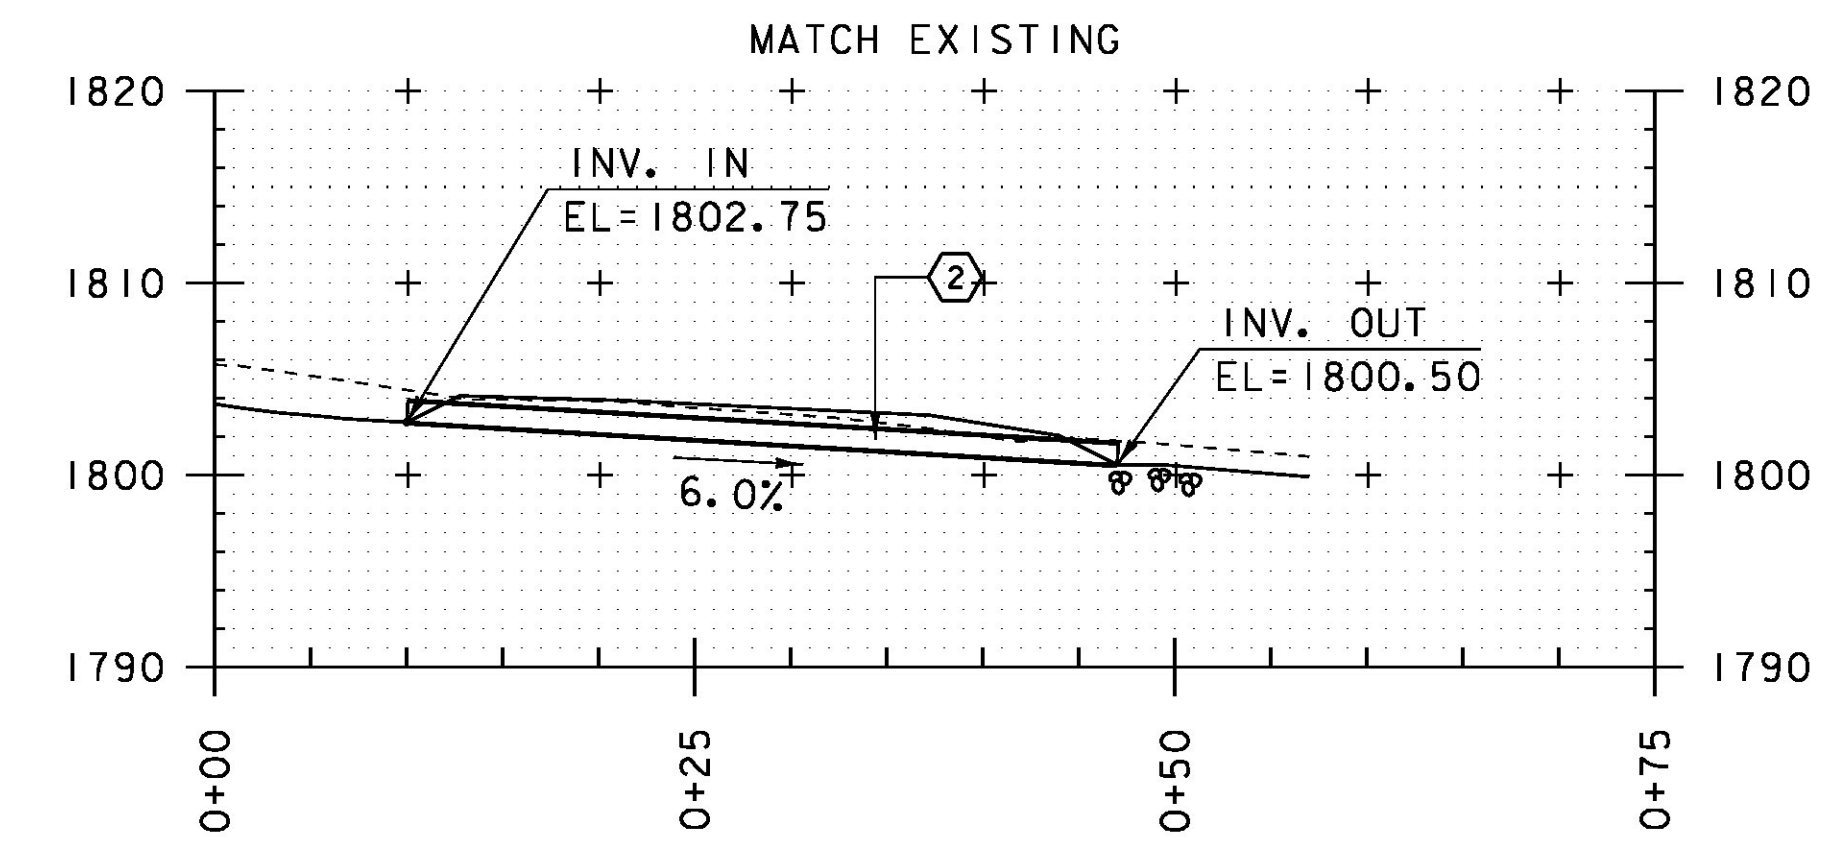

DRAINAGE PIPE

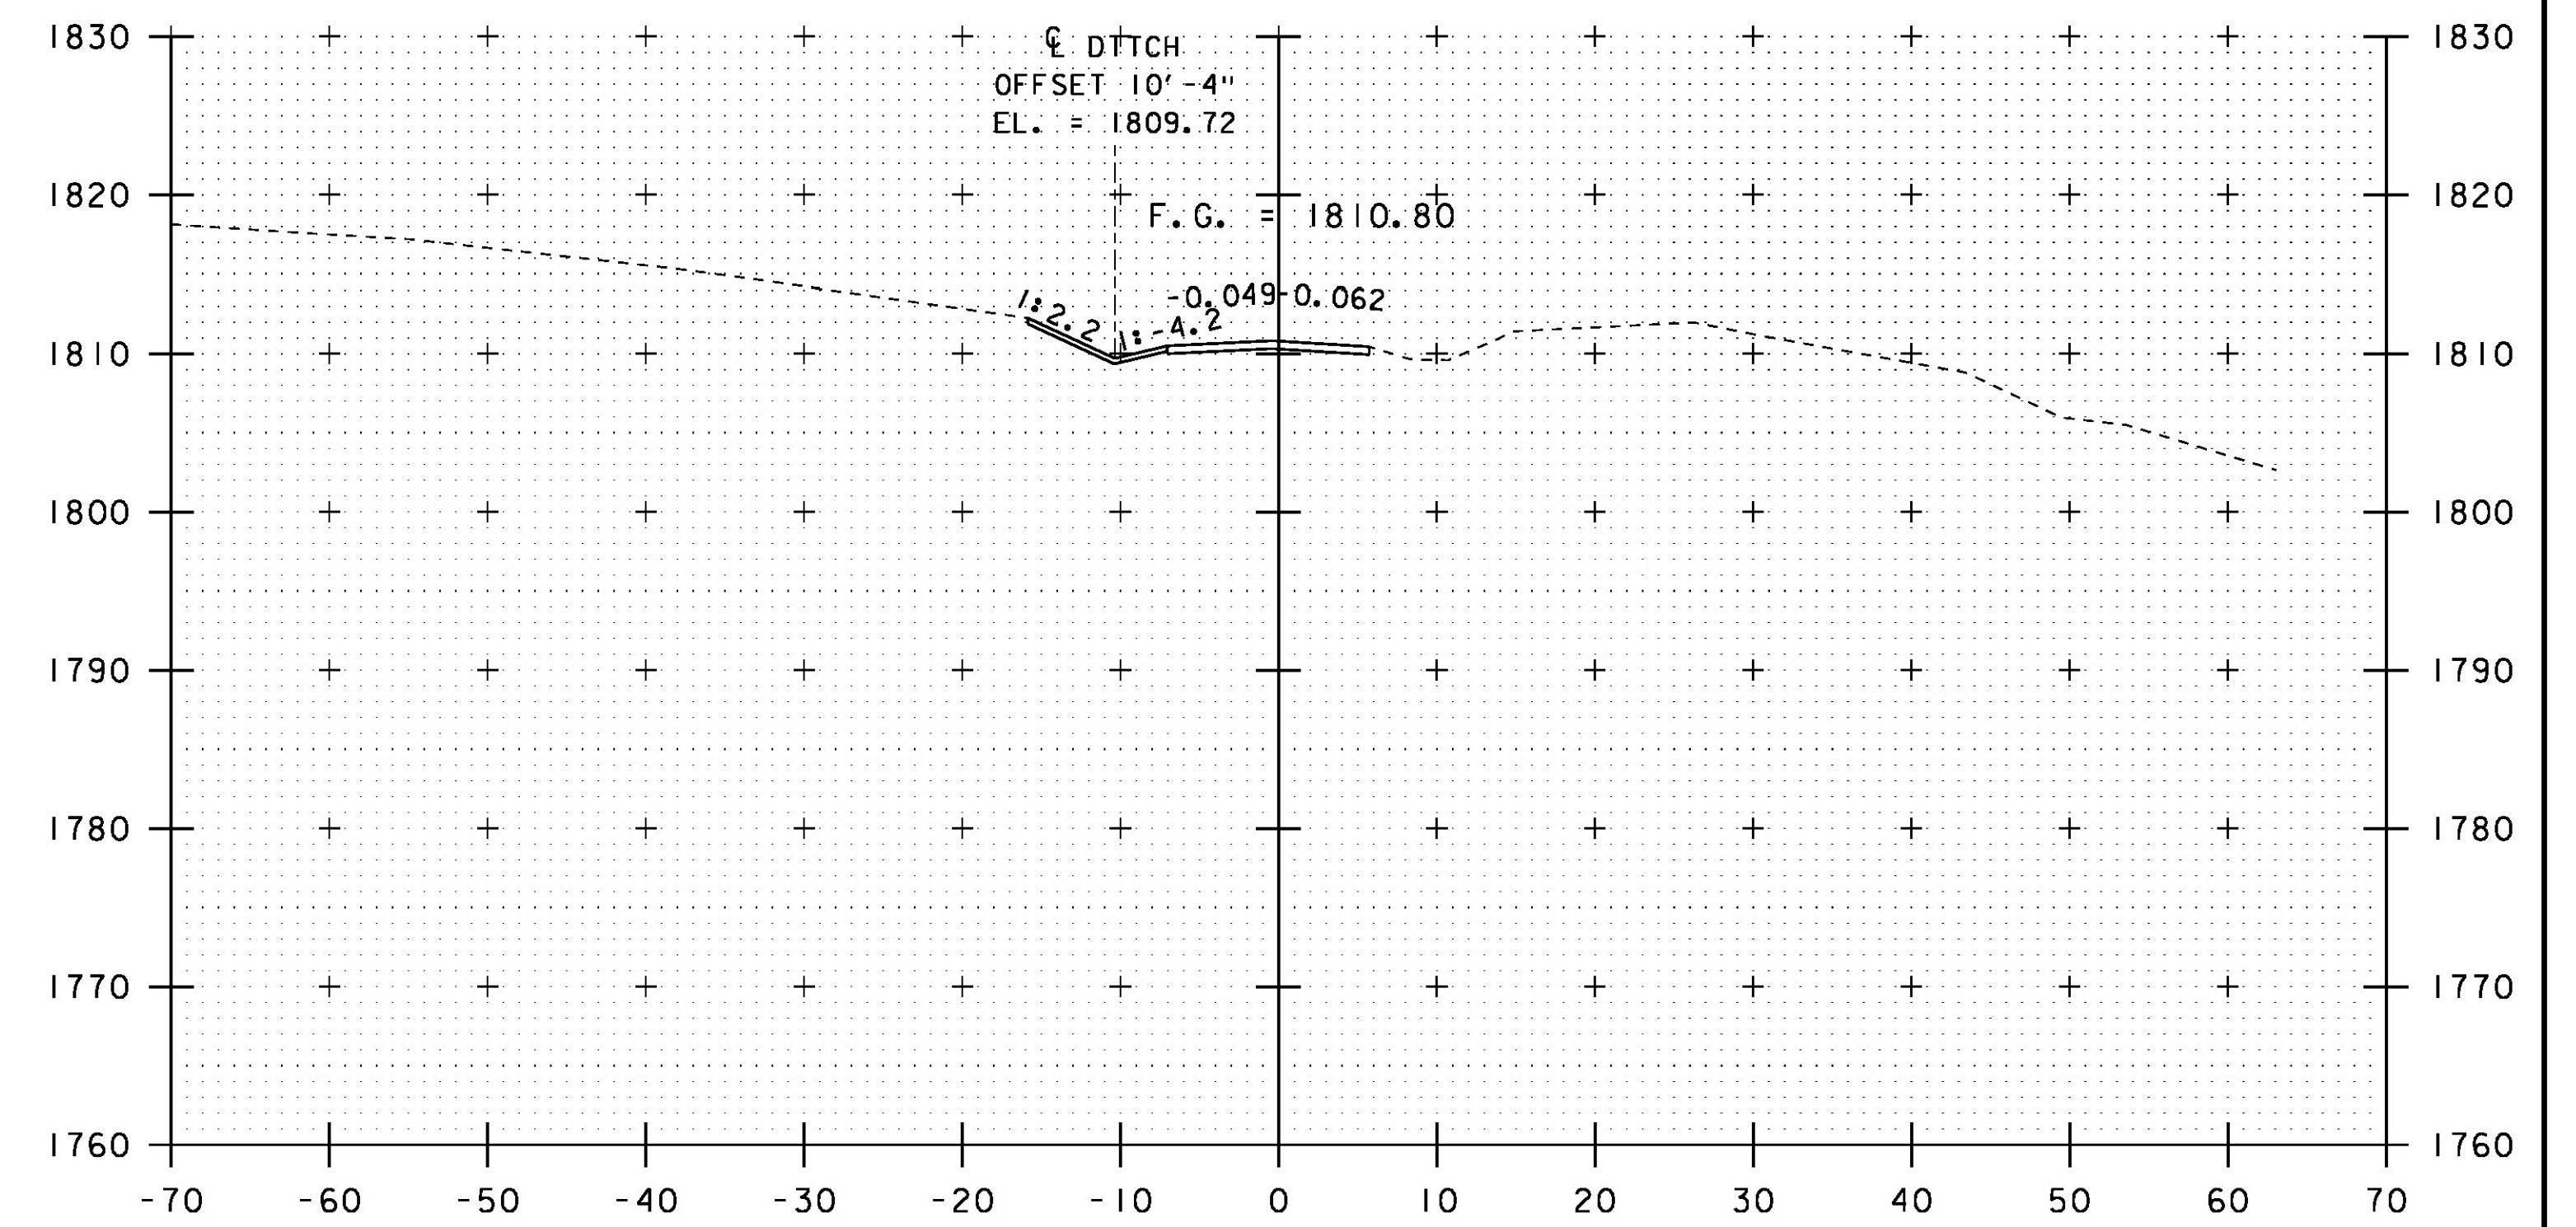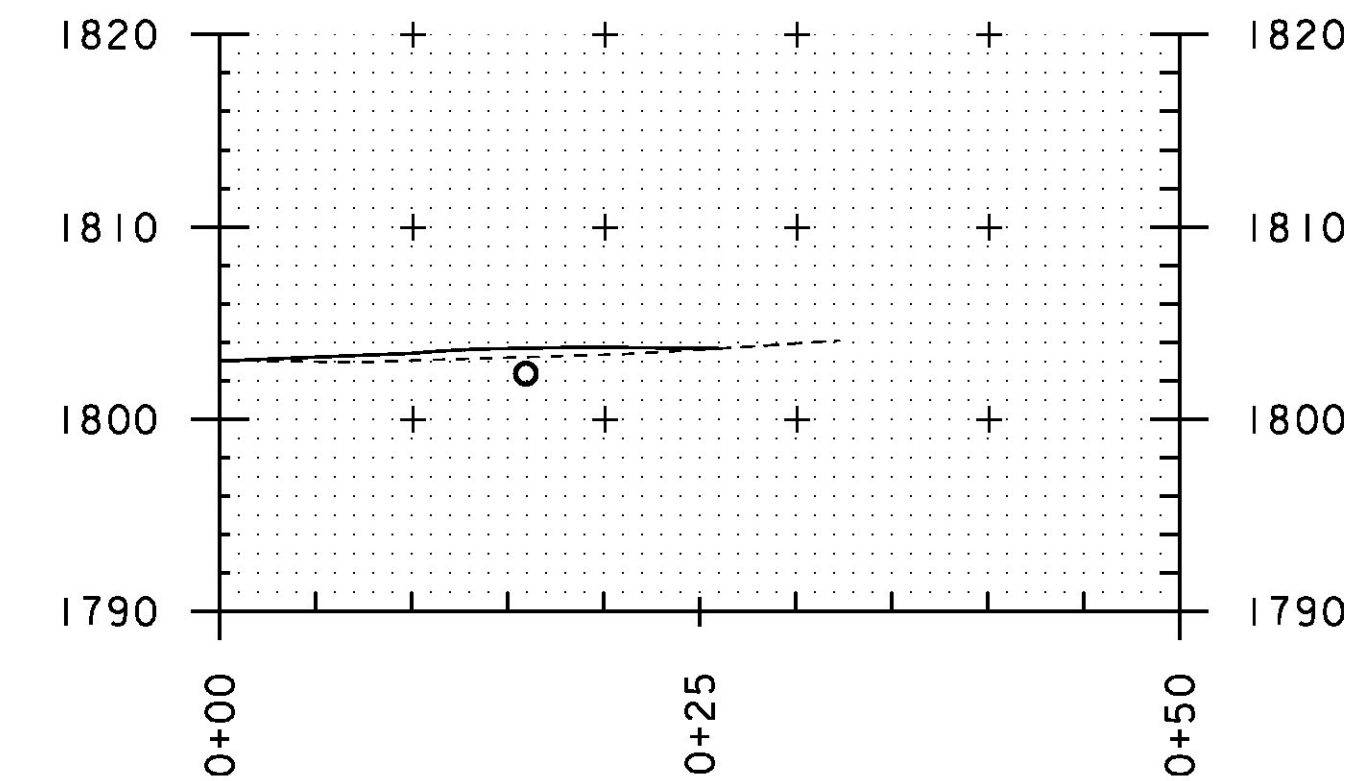

END APPROACH STA. 13+50.00

13+50

STA. 12+95 TO STA. 13+50

PROJECT NAME: STAMFORD	PLOT DATE: 03-DEC-2015
PROJECT NUMBER: STP 144(29)	DRAWN BY: D. KARABEGOVIĆ
FILE NAME: s96j226xs.dgn	DESIGNED BY: H. SALLS
PROJECT LEADER: C.W. CARLSON	CHECKED BY: H. SALLS
TH4 CROSS SECTIONS 6	SHEET 32 OF 44