

SEE SHEET 2 FOR
INDEX OF SHEETS AND
LIST OF STANDARDS

STATE OF VERMONT AGENCY OF TRANSPORTATION



PROPOSED IMPROVEMENT BRIDGE PROJECT


TOWN OF BRATTLEBORO
COUNTY OF WINDHAM

ROUTE NO : T.H. 10 CLASS 2 BRIDGE NO : 30


PROJECT LOCATION : BEGINNING AT A POINT ON EXISTING T.H. 10 APPROXIMATELY 0.11 KILOMETERS
SOUTHEAST OF THE EXISTING INTERSECTION OF T.H. 10 AND VT. 9 AND PROCEEDING
NORTHEASTERLY 110 METERS ALONG A NEW T.H. 10 ALIGNMENT.

PROJECT DESCRIPTION : CONSTRUCTION OF A NEW BRIDGE DOWNSTREAM FROM THE EXISTING COVERED BRIDGE,
WITH RELATED CHANNEL AND ROADWAY APPROACH WORK.

LENGTH OF NEW STRUCTURE : 28.000 METERS.
LENGTH OF ROADWAY : 82.000 METERS.
LENGTH OF PROJECT : 110.000 METERS.

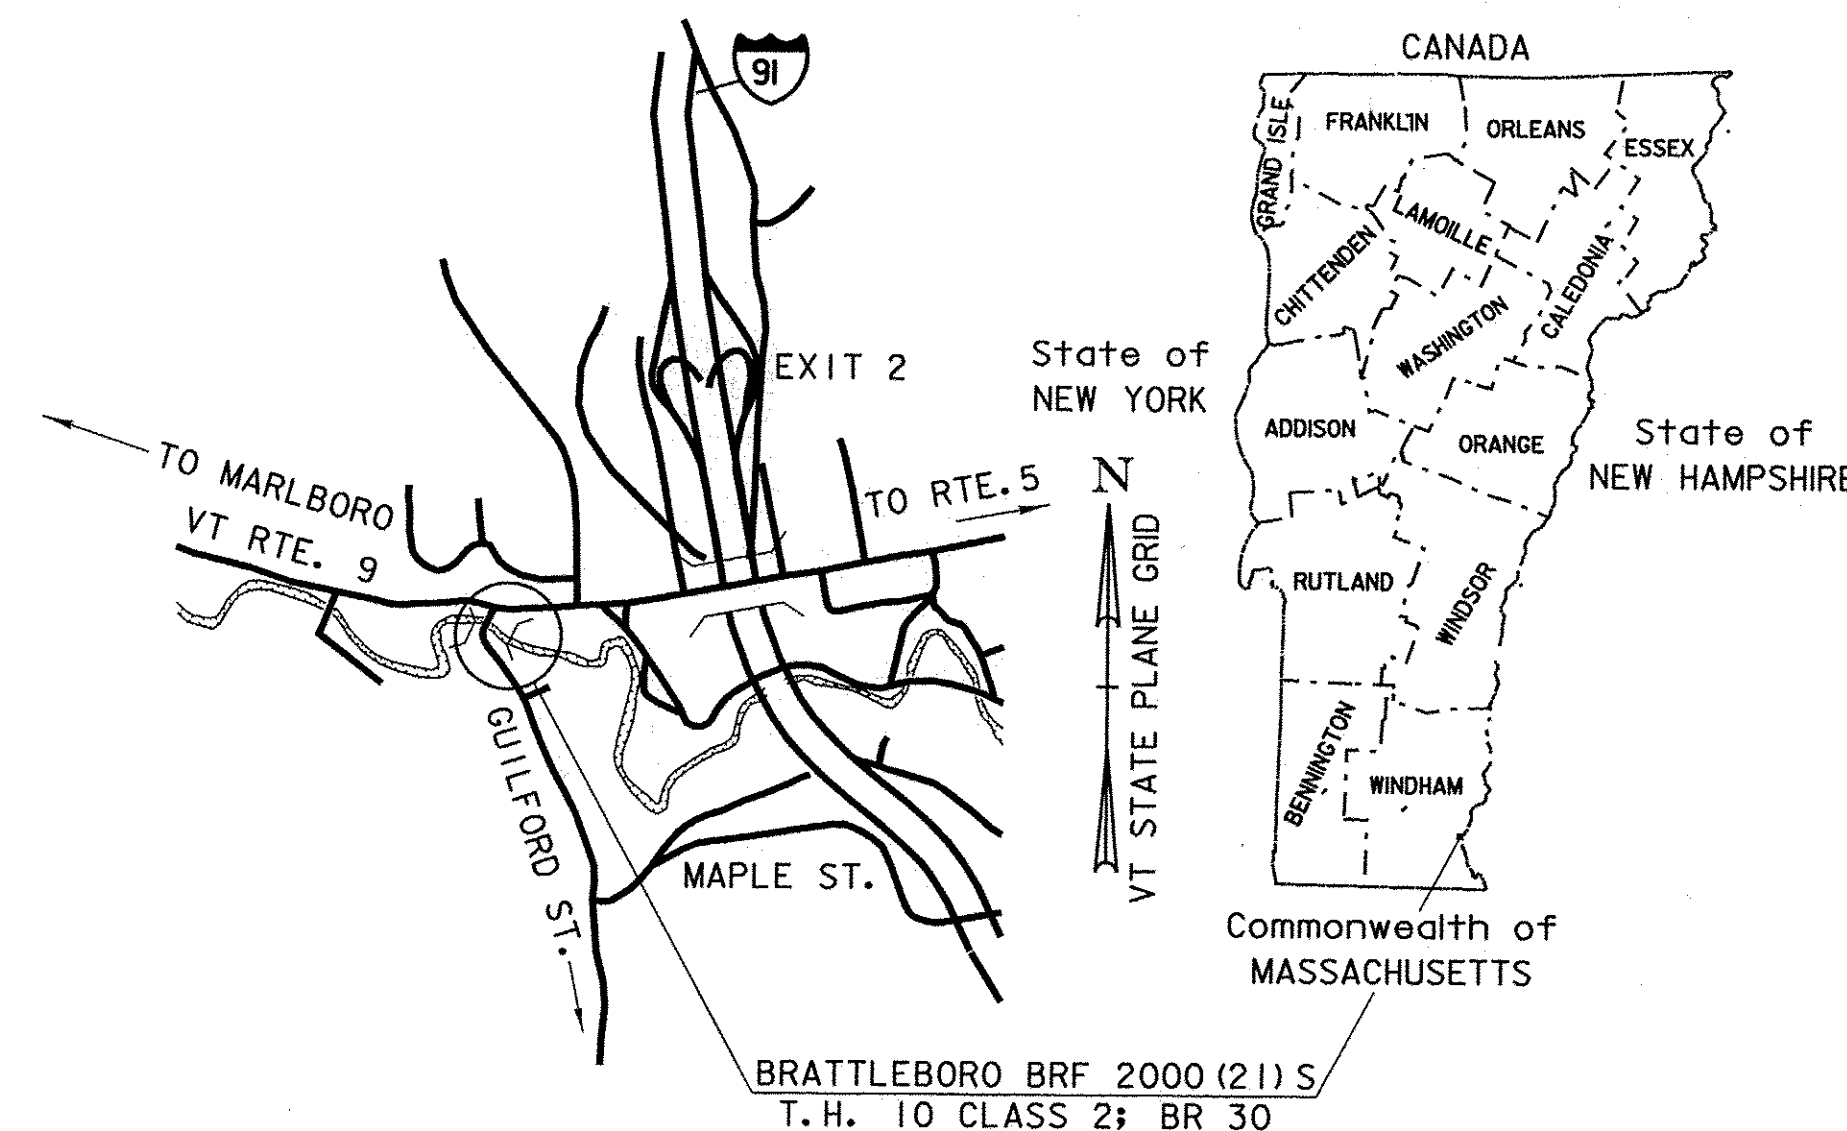


RECORD PLANS	
CONTRACTOR:	J. A. MCDONALD INC. - LYNDON CENTER, VT
RESIDENT ENGINEER:	FRED ROSS
CONSTRUCTION BEGAN:	AUGUST 4, 2009
CONSTRUCTION COMPLETE:	MAY 19, 2011
RECORD PLANS BY:	FRED ROSS & CHIP PIERCE
I HEREBY CERTIFY THAT ALL THE CONSTRUCTION REQUIRED BY THIS SET OF DRAWINGS HAS BEEN ACCOMPLISHED AS INDICATED HEREIN.	
BY:	<i>Fred Ross</i> RESIDENT ENGINEER
DATE:	9-9-13
NOTE: Any further information concerning final quantities, amounts or other details relative to this project may be found at Central Files in the electronic archives.	

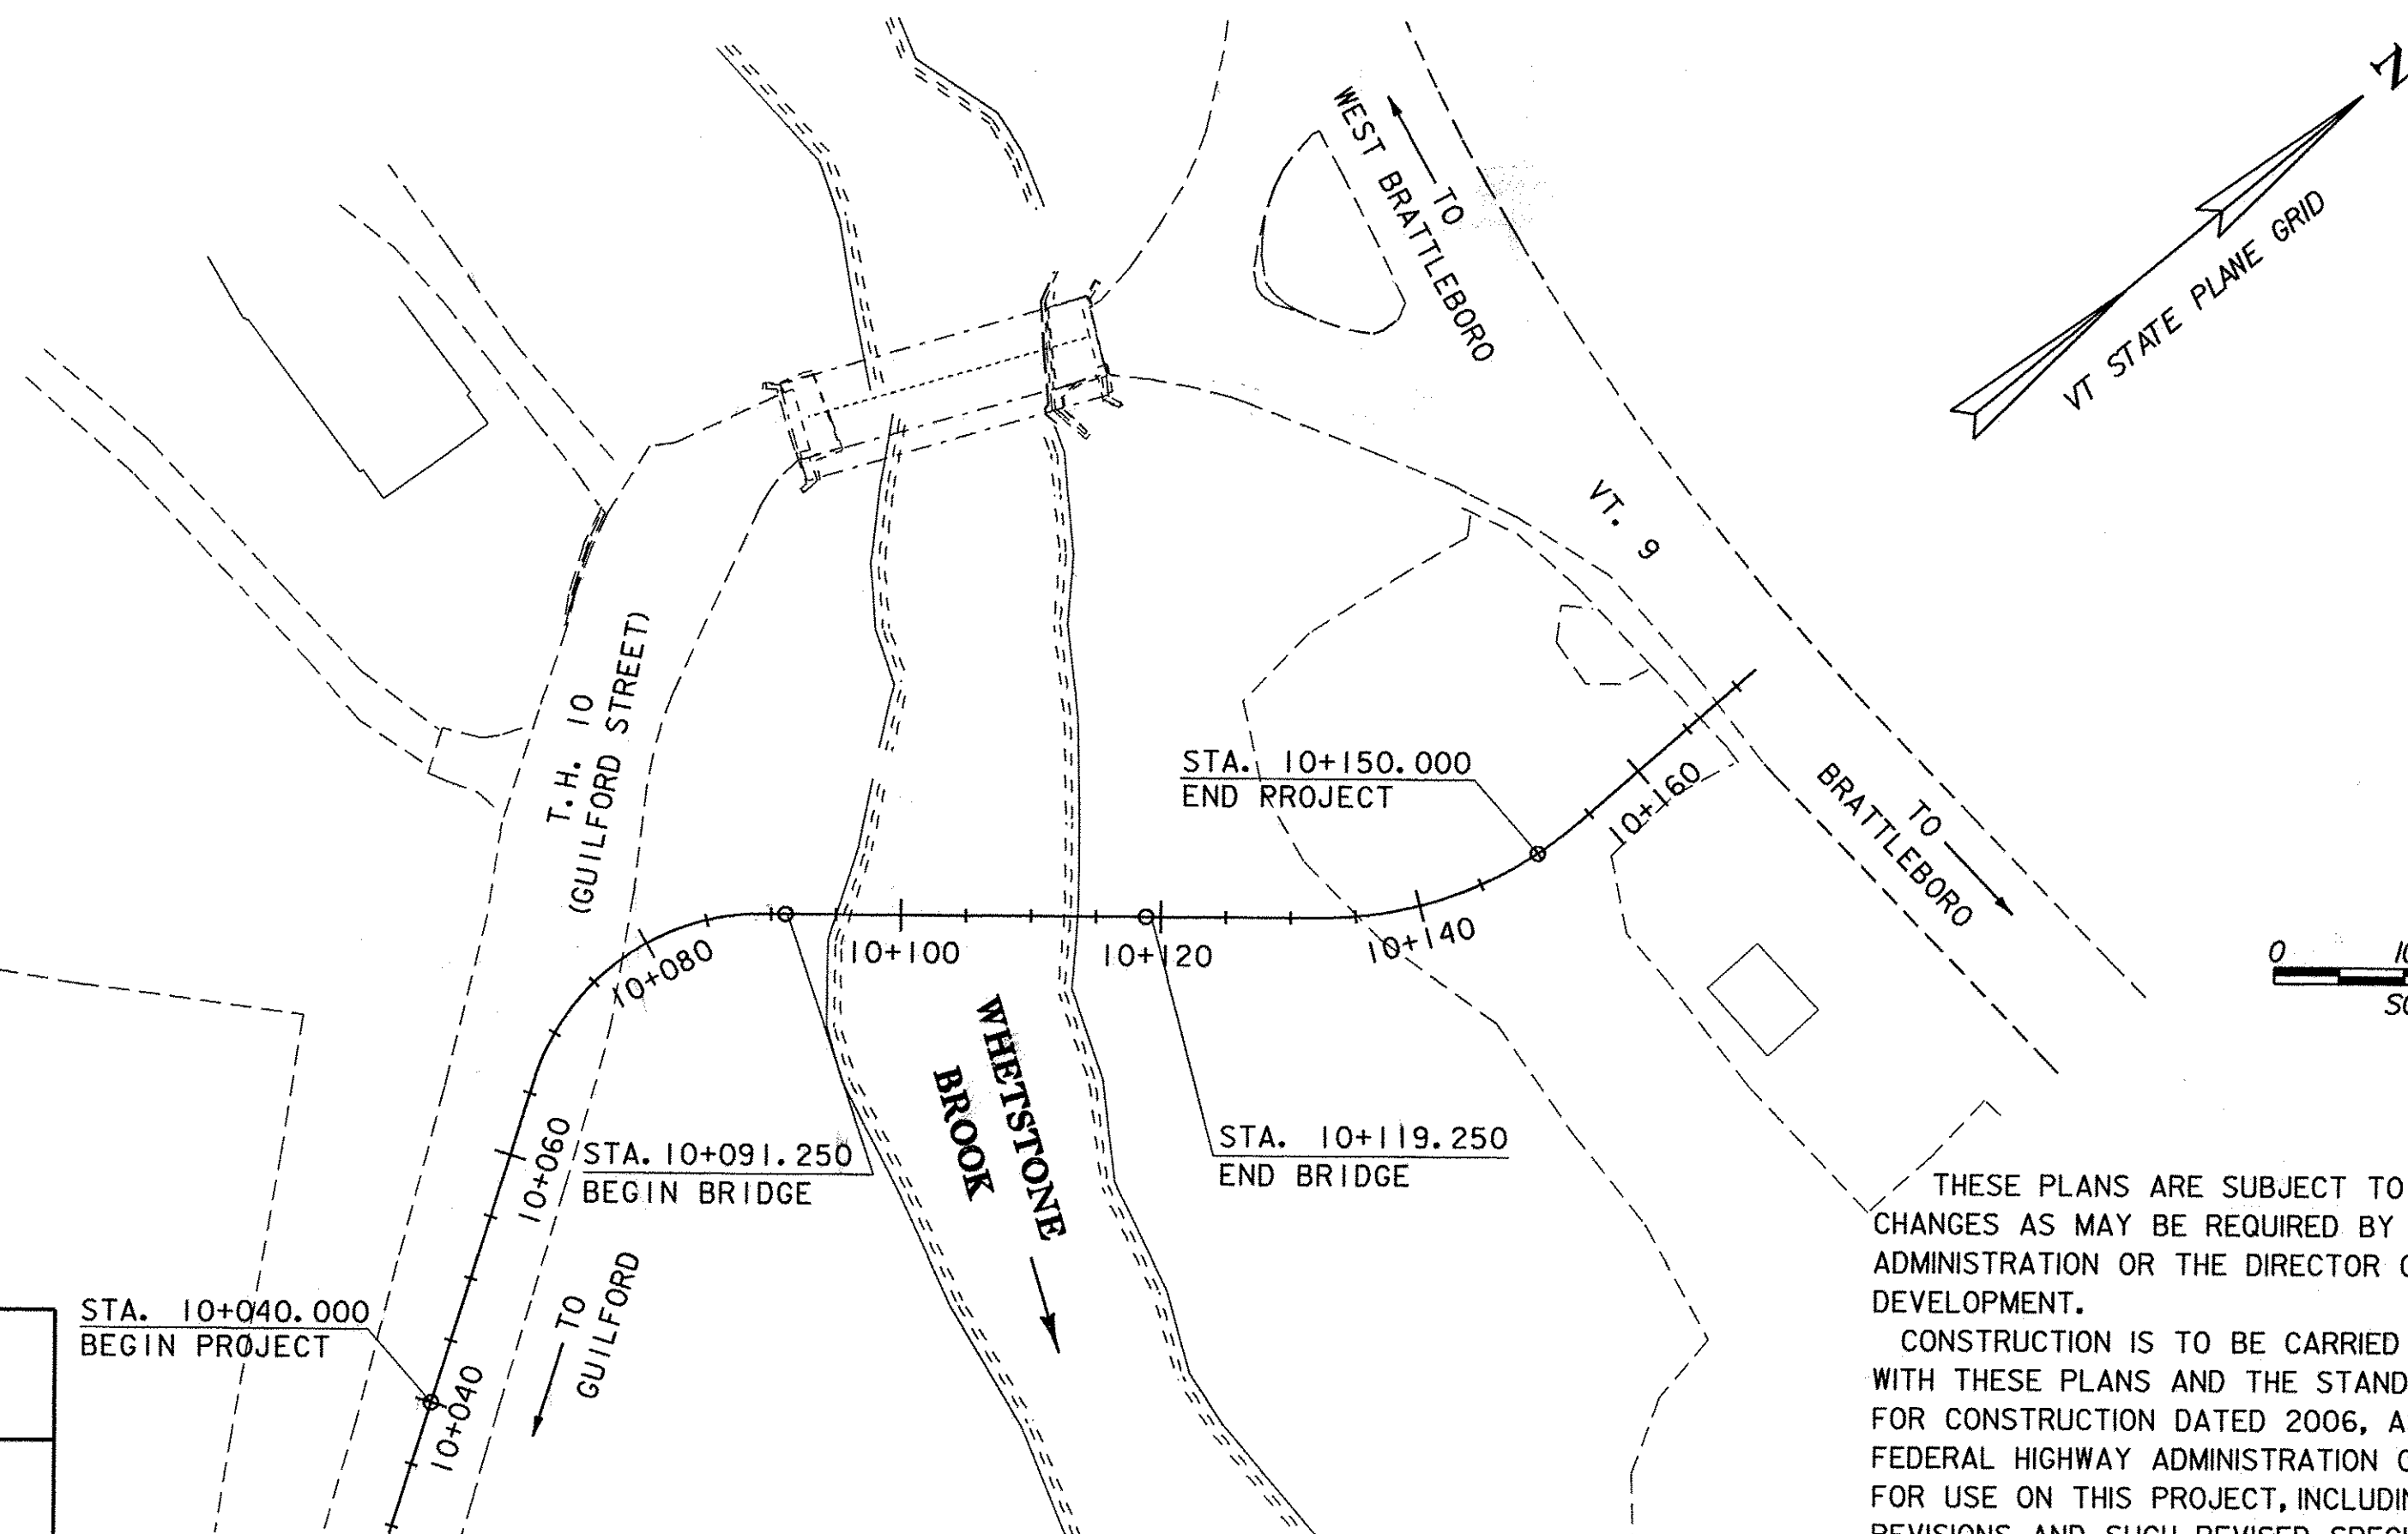

CONVENTIONAL SYMBOLS	
COUNTY LINE	
TOWN LINE	
LIMITS OF ACCESS	
POINT OF ACCESS	
FENCE LINE	
STONE WALL	
TRAVELED WAY	
GUARD RAIL	
RAILROAD	
SURVEY LINE	
CULVERT	
POWER POLE	
TELEPHONE POLE	
TREES	
CONTROL OF ACCESS	
PROPERTY LINE	
R.O.W. TAKING LINE	
SLOPE RIGHTS	
TOP OF CUT	
TOE OF SLOPE	

SURVEYED BY : R. D. GILMAN
SURVEYED DATE : 9-17-97
DATUM
VERTICAL NAVD 88
HORIZONTAL NAD-83 (92)

THESE PLANS ARE SUBJECT TO SUCH ENGINEERING CHANGES AS MAY BE REQUIRED BY THE FEDERAL HIGHWAY ADMINISTRATION OR THE DIRECTOR OF PROGRAM DEVELOPMENT.
CONSTRUCTION IS TO BE CARRIED ON IN ACCORDANCE WITH THESE PLANS AND THE STANDARD SPECIFICATIONS FOR CONSTRUCTION DATED 2006, AS APPROVED BY THE FEDERAL HIGHWAY ADMINISTRATION ON JUNE 15, 2006 FOR USE ON THIS PROJECT, INCLUDING ALL SUBSEQUENT REVISIONS AND SUCH REVISED SPECIFICATIONS AND SPECIAL PROVISIONS AS ARE INCORPORATED IN THESE PLANS.

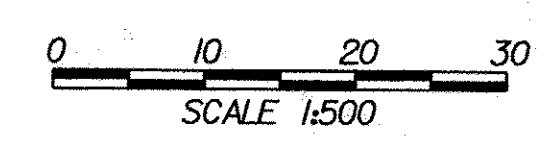

Metric
UNLESS NOTED OTHERWISE
STATIONS ARE IN KILOMETERS
ELEVATIONS ARE IN METERS
DIMENSIONS ARE IN MILLIMETERS

DIRECTOR OF PROGRAM DEVELOPMENT	
APPROVED <i>Rick Johnson</i>	DATE 4-30-09
PROJECT MANAGER : R. WHITCOMB	
PROJECT NAME : BRATTLEBORO	
PROJECT NUMBER : BRF 2000 (21) S	
SHEET 1 OF 77 SHEETS	