



Profile Along New Centerline T.H. 10 (Guilford Street)

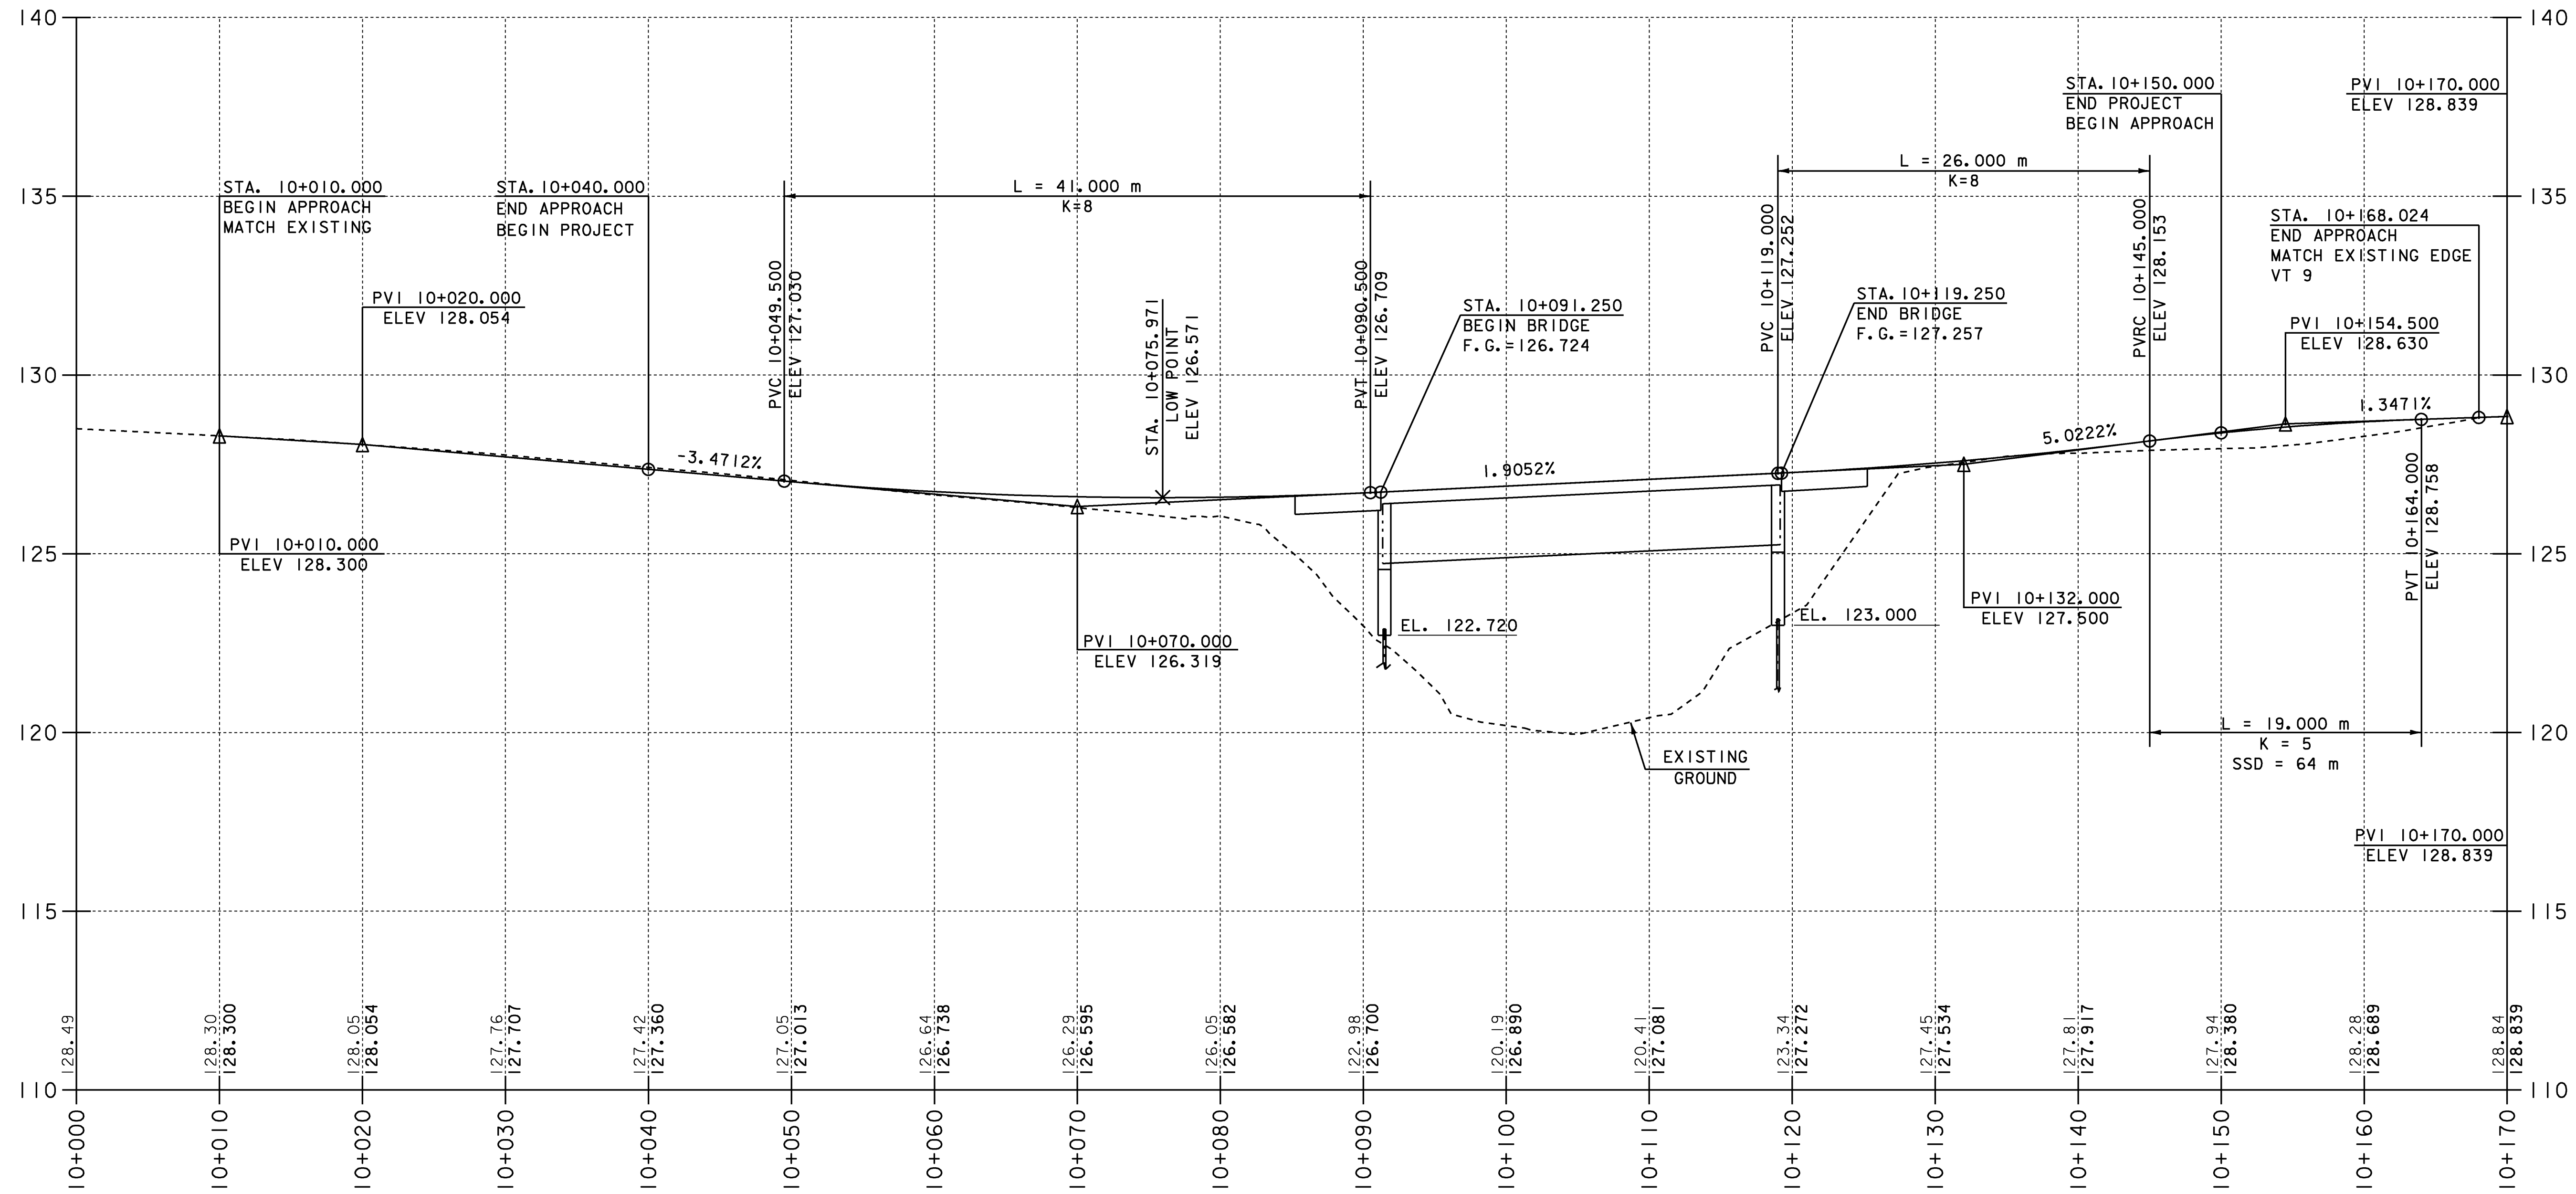

NOTE:
 ELEVATIONS SHOWN TO THE NEAREST HUNDREDTH ARE EXISTING GROUND.
 ELEVATIONS SHOWN TO THE NEAREST THOUSANDTH ARE FINISHED GRADE.

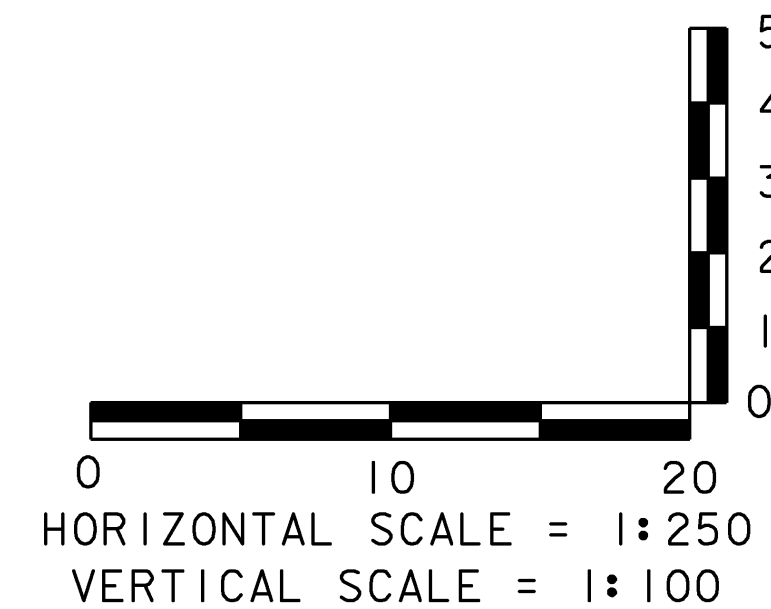

PROFILE SHEET 1

PROJECT NAME: BRATTLEBORO	PLOT DATE: 29-APR-2009
PROJECT NUMBER: BRF 2000(2)S	DRAWN BY: str3
FILE NAME: 96J228/str/sj228xsl.dgn	DESIGNED BY: J. PERRIGO
DESIGNED BY: J. PERRIGO	CHECKED BY: D. BONNEAU
sj228pr 1. i	SHEET 17 OF 77