

SEE SHEET 16 FOR THESE SIGNS AND RAMPS

**100mm WHITE LINE**  
 MAINLINE 10+081.8 RT. - 10+165.9 RT.  
 MAINLINE 10+084.4 LT. - 10+165.9 LT.  
 MAINLINE 10+168.2 RT. - 10+169.4 RT.  
 MAINLINE 10+168.8 LT. - 10+169.5 LT.  
 VT 9 3+000.0 RT. - 3+064.5 RT.

**100mm YELLOW LINE**  
 MAINLINE 10+035.0 CL. - 10+066.1 CL. (DOUBLE)  
 MAINLINE 10+084.5 CL. - 10+164.1 CL. (DOUBLE)

**600mm STOP BAR**  
 MAINLINE 10+065.8 CL. - 10+065.8 RT.  
 MAINLINE 10+084.8 CL. - 10+085.6 LT.  
 MAINLINE 10+164.1 CL. - 10+164.1 RT.  
 DRIVE STA 20+005.2 LT

**LETTER OR SYMBOL**  
 MAINLINE 10+063.2 RT. (4 EA.)  
 MAINLINE 10+087.7 LT. (4 EA.)  
 MAINLINE 10+161.7 RT. (4 EA.)  
 DRIVE STA 20+008 LT (4 EA.)

**CROSSWALK MARKING**  
 MAINLINE 10+078.0 RT. - 10+084.5 LT.  
 MAINLINE 10+165.9 RT. - 10+168.3 LT.  
 VT 9 3+065.44 LT. - 3+065.76 RT.  
 3+042 3+042

**REMOVAL OF EXISTING PAVEMENT MARKINGS**  
 MAINLINE 10+169.4 RT. - 10+169.5 LT. (EDGELINE)  
 CHANNEL LINE 50+067.9 RT. - 50+083.8 LT. (EDGELINE)  
 CHANNEL LINE 50+081.6 RT. - 50+087.4 RT. (CROSSWALK)


**TRAFFIC SIGNS, TYPE A**  
 MAINLINE 10+063.2 RT. (2 EA.)  
 MAINLINE 10+088.0 LT. (2 EA.)  
 MAINLINE 10+155.0 LT. (1 EA.)  
 MAINLINE 10+160.7 LT. (2 EA.)  
 MAINLINE 10+161.8 RT. (1 EA.)  
 MAINLINE 10+167.6 RT. (2 EA.)  
 DRIVE 20+006 LT (2 EA.)  
 MAINLINE 9+950 RT (1EA)

**REMOVING SIGNS**  
 MAINLINE 10+164.2 LT. (1 EA.)  
 MAINLINE 10+179.8 LT. (1 EA.)  
 MAINLINE 10+165.0 LT. (2 EA.)  
 DRIVE 20+020.1 RT. (2 EA.)  
 DRIVE 20+027.9 RT. (2 EA.)  
 CHANNEL LINE 50+085.1 RT. (2 EA.)  
 CHANNEL LINE 50+085.1 RT. (2 EA.)  
 CHANNEL LINE 50+087.6 RT. (2 EA.)  
 CHANNEL LINE 50+089.7 LT. (1 EA.)  
 CHANNEL LINE 50+090.6 LT. (2 EA.)  
 CHANNEL LINE 50+097.1 RT. (1 EA.)


**ERECTING SALVAGED SIGNS**  
 VT 9 STA 3+064.8 RT. (2 EA.)  
 VT 9 STA 3+066.8 LT. (2 EA.)

STA. 20+022.00  
 MATCH EXISTING  
 END NEW PAVEMENT

1200 STONE FILL,  
 TYPE IV (TYP.)

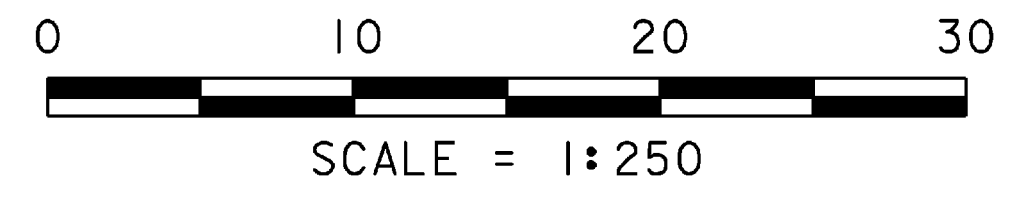

**LEGEND**  
 ## - PAVEMENT MARKING REMOVAL  
 R&S - REMOVE AND SALVAGE  
 R - REMOVE  
 S - SALVAGE  
 N - NEW

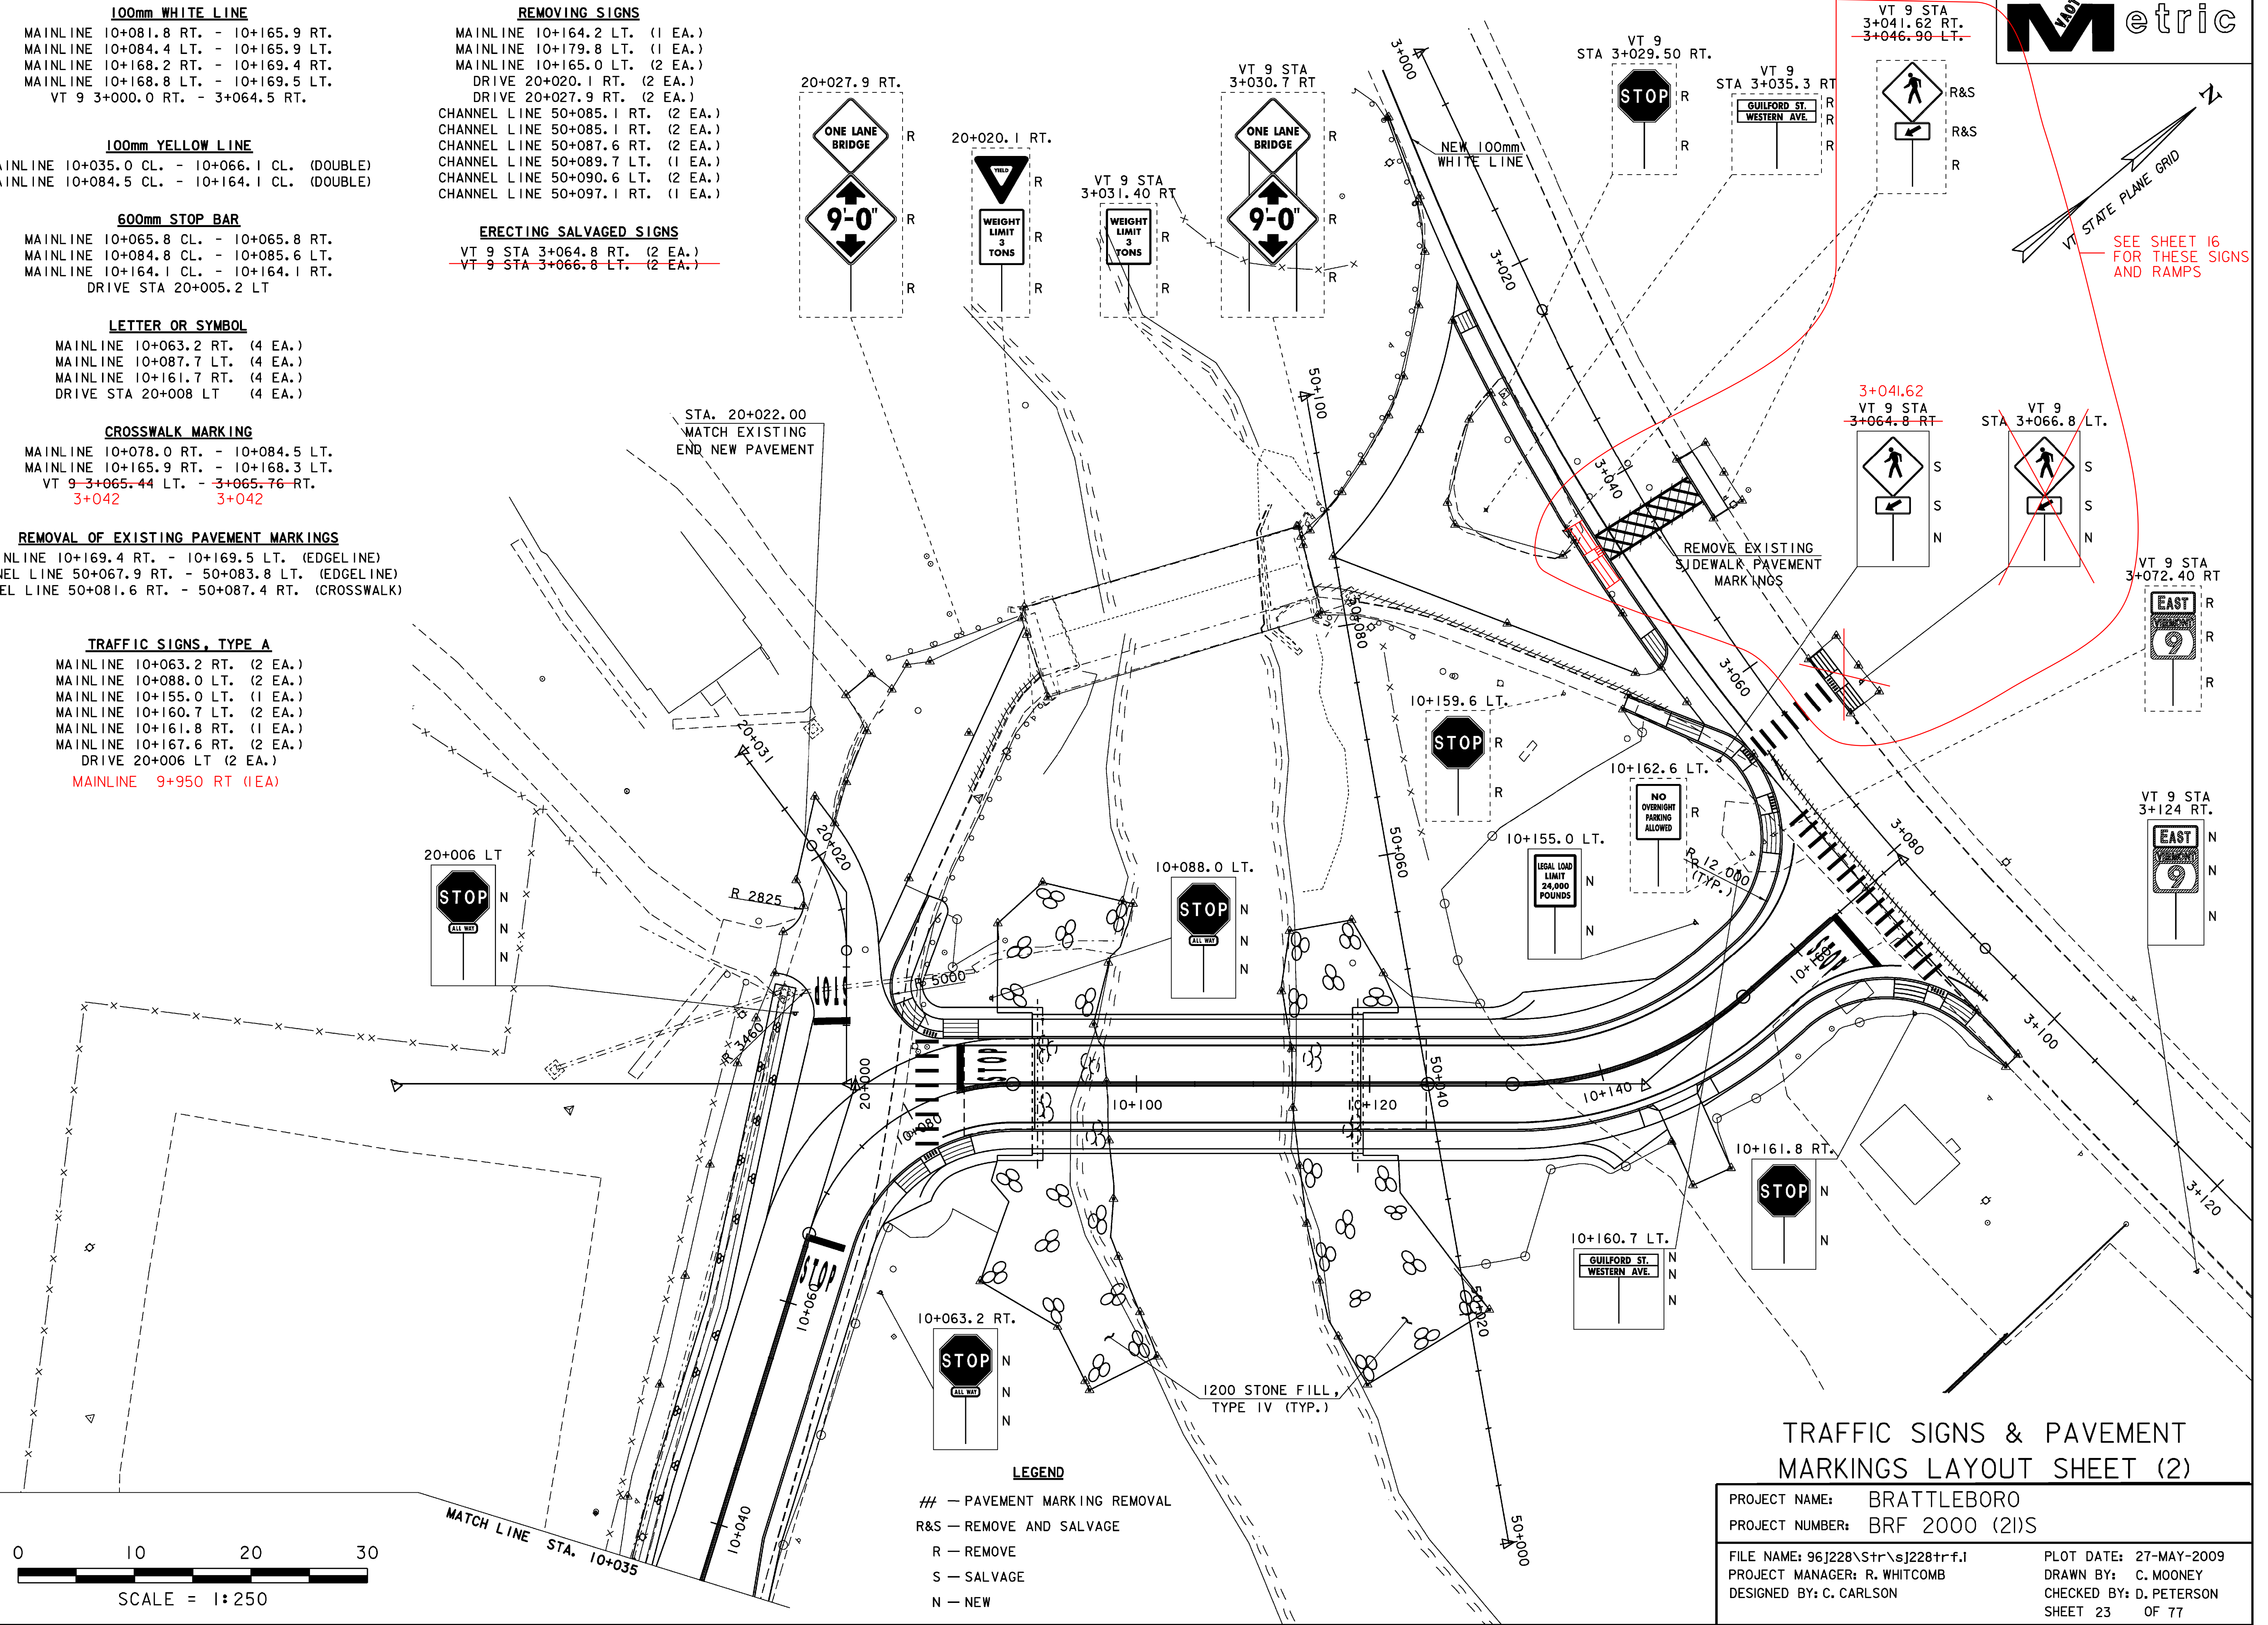

**TRAFFIC SIGNS & PAVEMENT MARKINGS LAYOUT SHEET (2)**

PROJECT NAME:	BRATTLEBORO	FILE NAME:	96J228\S+tr\sJ228+tr.f.I	PLOT DATE:	27-MAY-2009
PROJECT NUMBER:	BRF 2000 (2)S	PROJECT MANAGER:	R. WHITCOMB	DRAWN BY:	C. MOONEY
		DESIGNED BY:	C. CARLSON	CHECKED BY:	D. PETERSON
				SHEET 23	OF 77