




APPROACH RAIL LAYOUT WW1
SCALE = 1:5

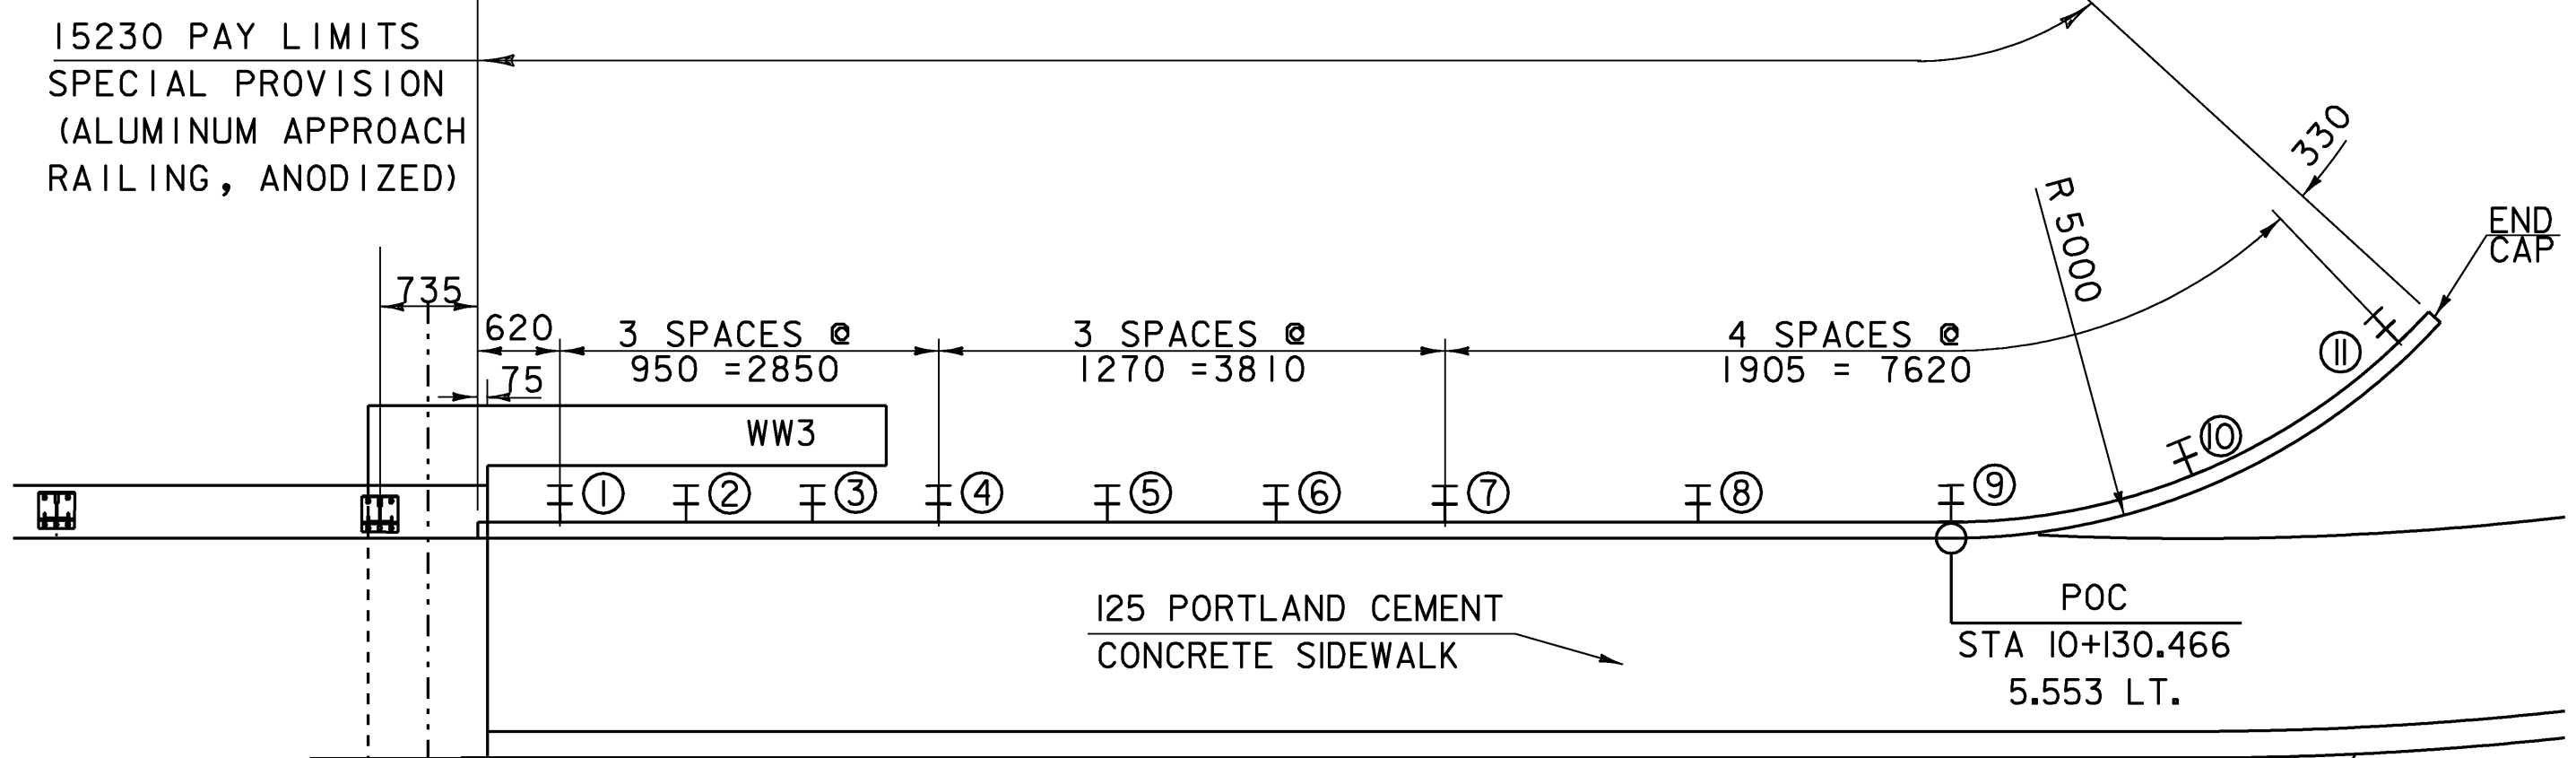

APPROACH RAIL LAYOUT WW3
SCALE = 1:5

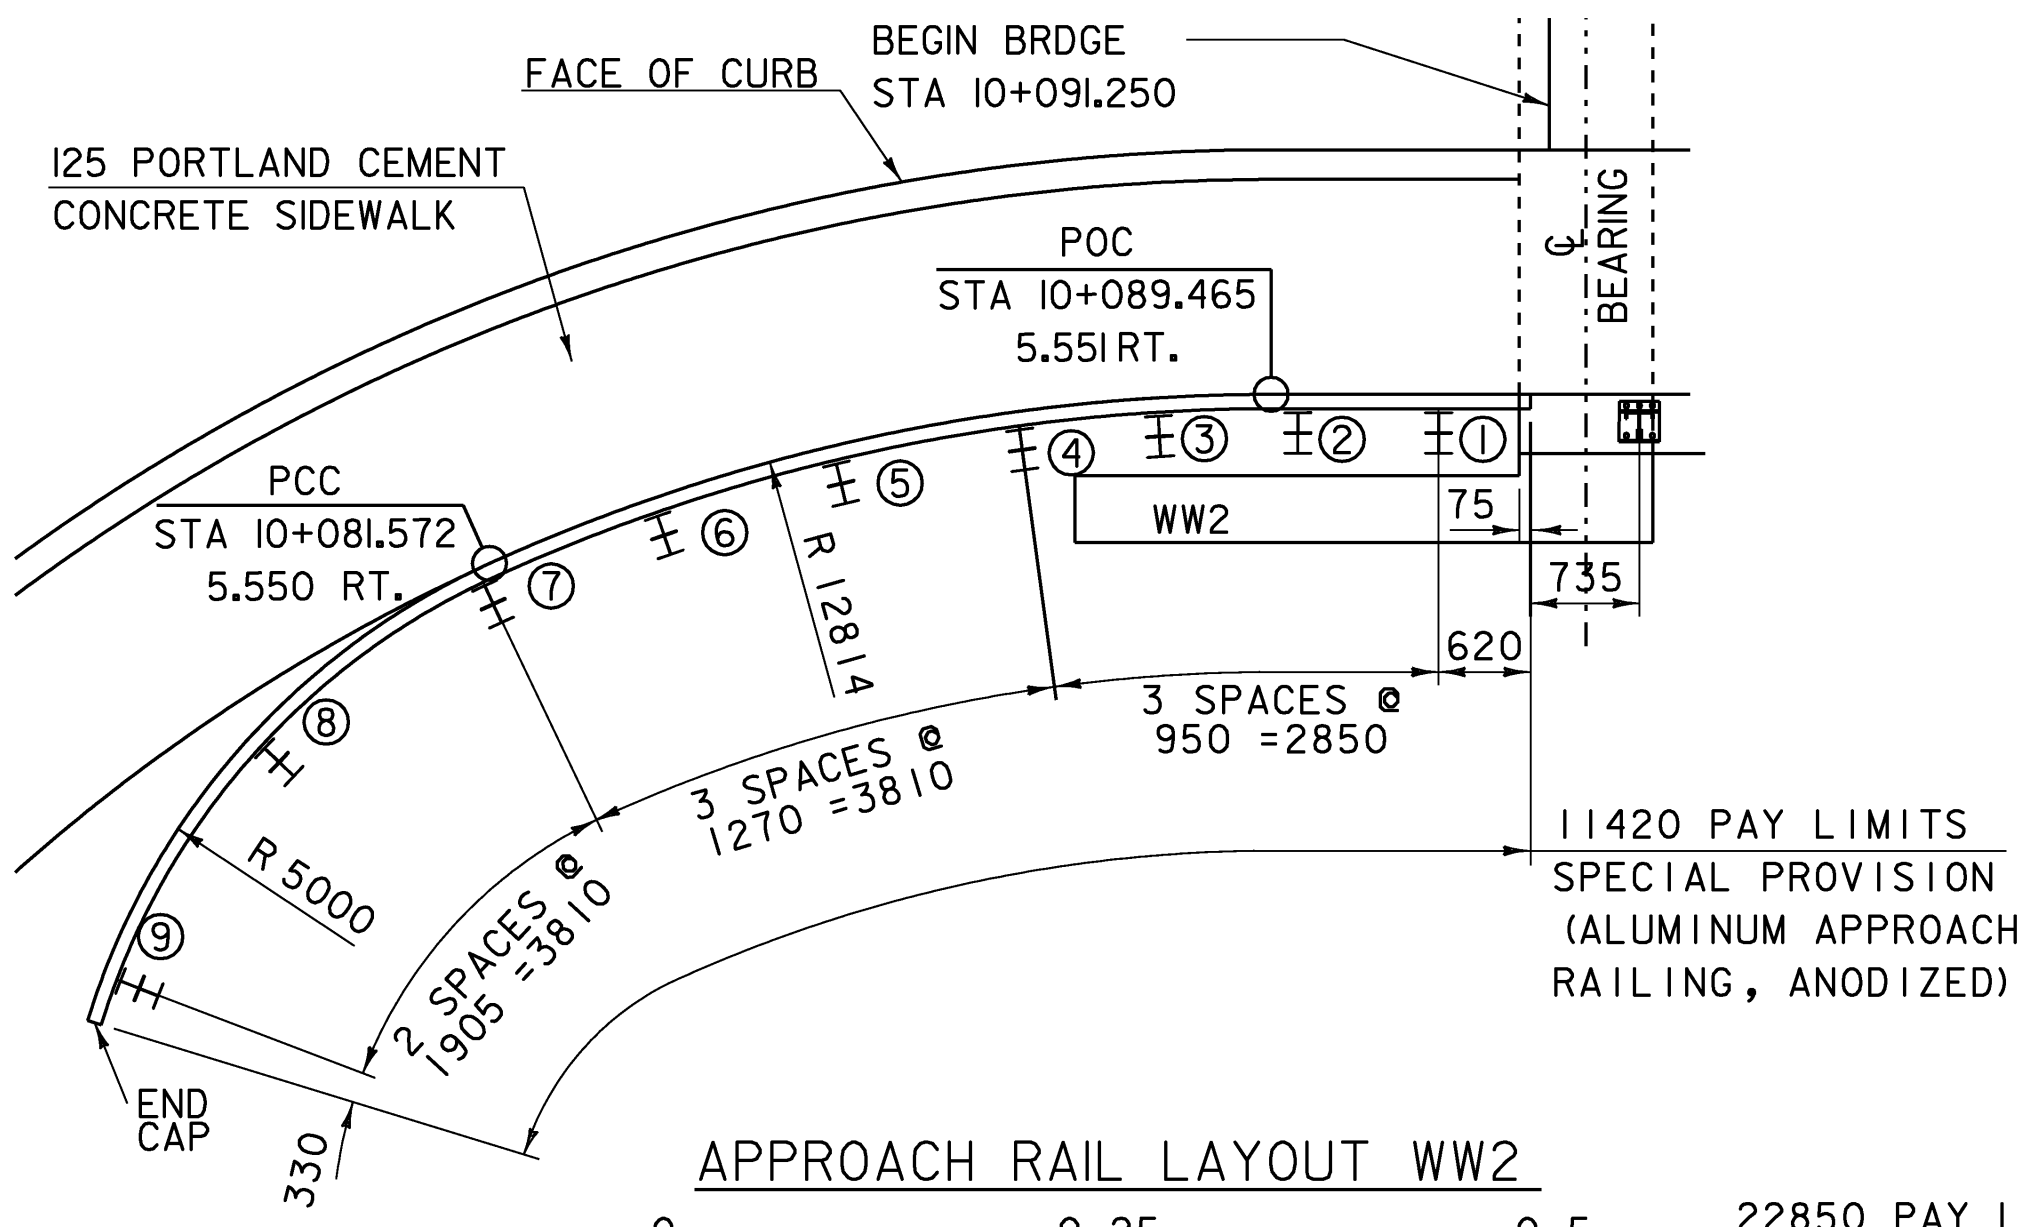

APPROACH RAIL LAYOUT WW2
SCALE = 1:5

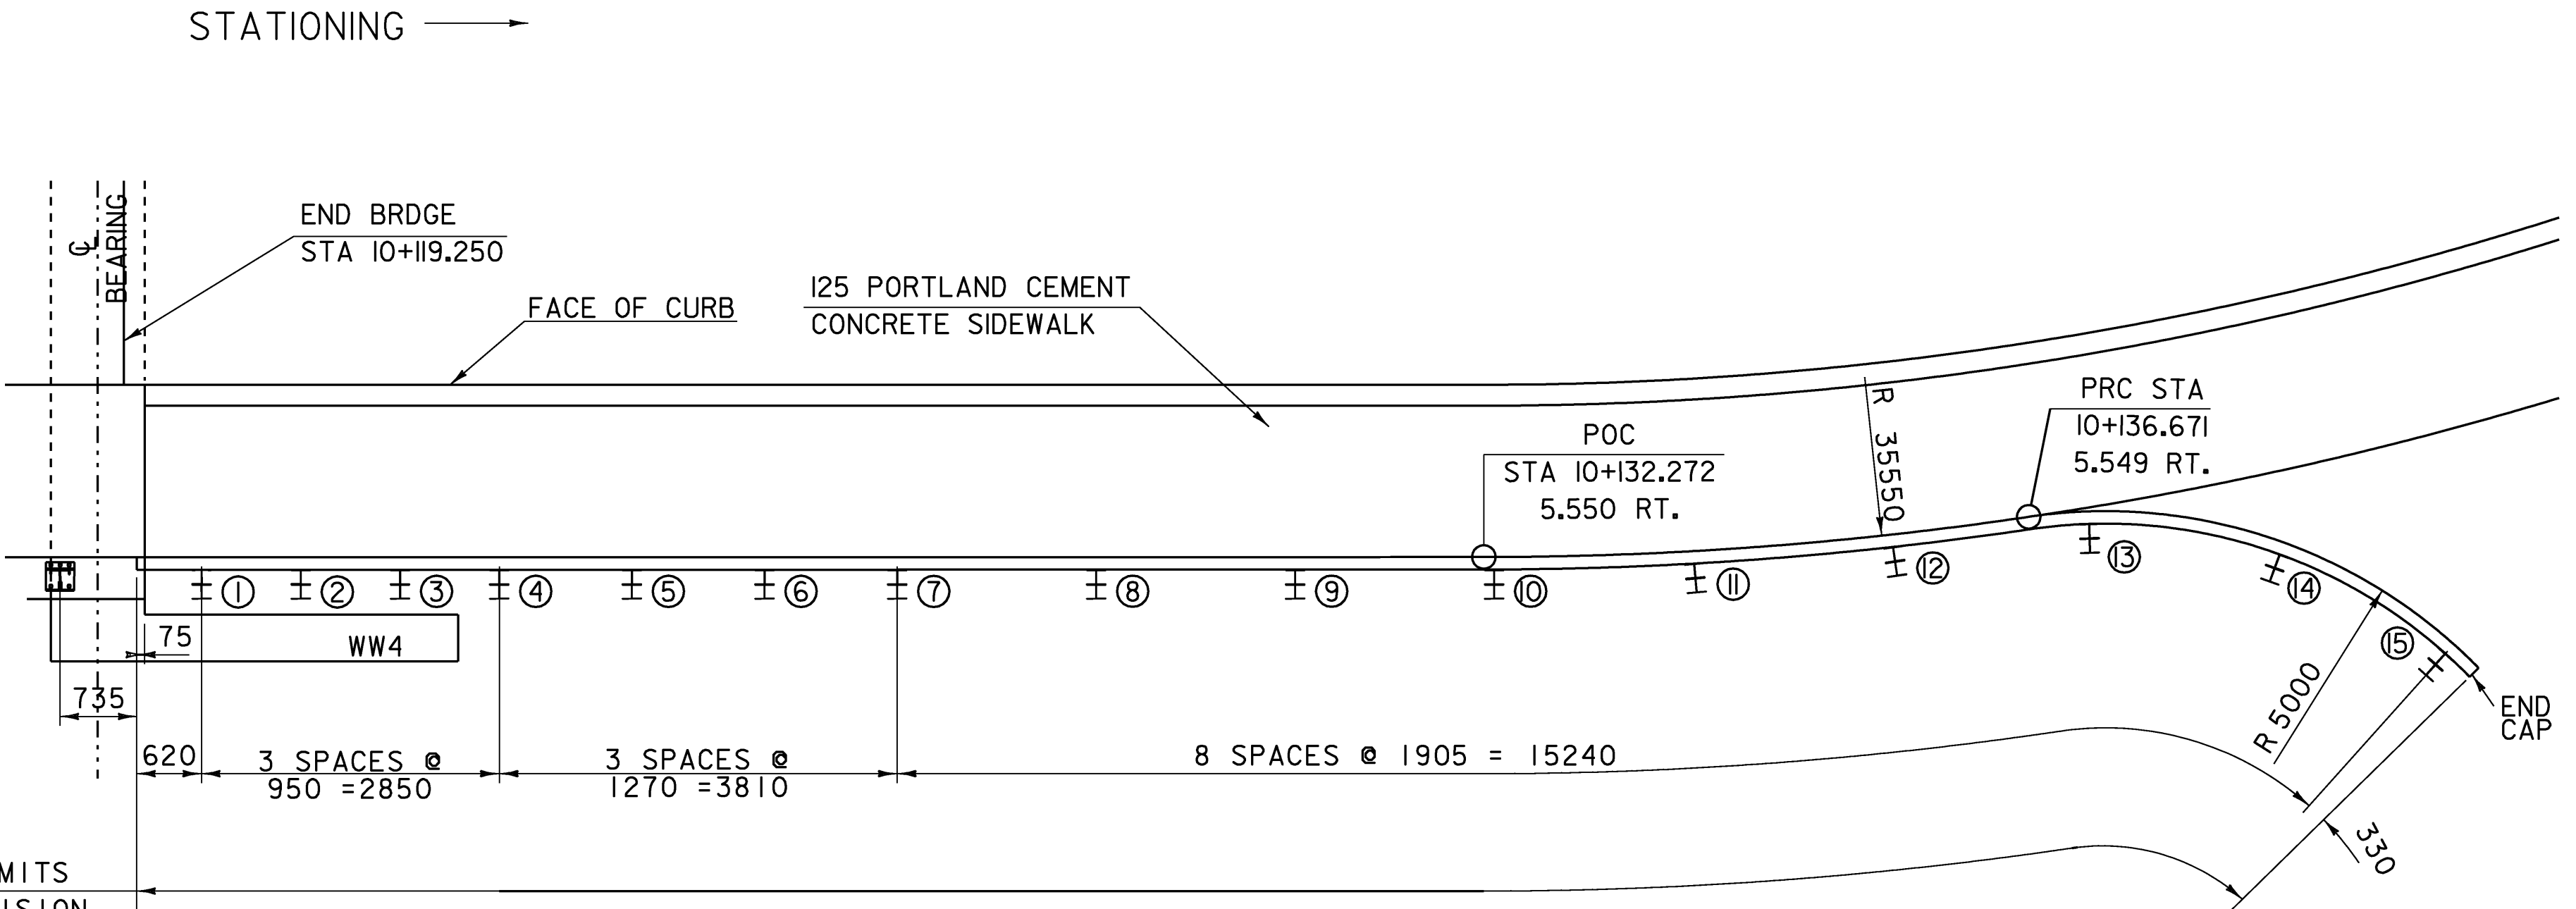

APPROACH RAIL LAYOUT WW4
SCALE = 1:5

ALUMINUM RAILING LAYOUT SHEET

PROJECT NAME:	BRATTLEBORRO	FILE NAME:	96j288\str\sj228rall.dgn	PLOT DATE:	29-APR-2009
PROJECT NUMBER:	BRF 2000 (2)S	PROJECT LEADER:	R. WHITCOMB	DRAWN BY:	C. MOONEY
		DESIGNED BY:	D. PETERSON	CHECKED BY:	C. CARLSON
				SHEET	24 OF 77