



ALTERNATE POUR SEQUENCE

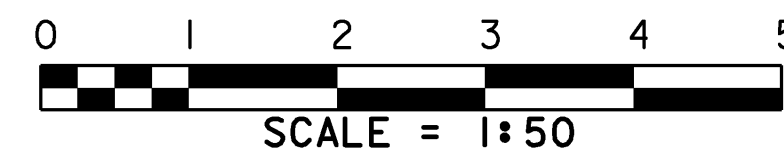

NOTES:

1. PLACE ALL OF THE BACKWALL, WINGWALL, AND DECK CONCRETE ABOVE THE PILE CAP CONSTRUCTION JOINTS IN ONE CONTINUOUS POUR WITHIN A MAXIMUM DURATION OF EIGHT HOURS.
2. OTHERWISE THE ALTERNATE POUR SEQUENCE SHOWN ABOVE MUST BE FOLLOWED. A MINIMUM NINETY-SIX HOUR DELAY MUST BE OBSERVED BETWEEN ADJACENT POURS.

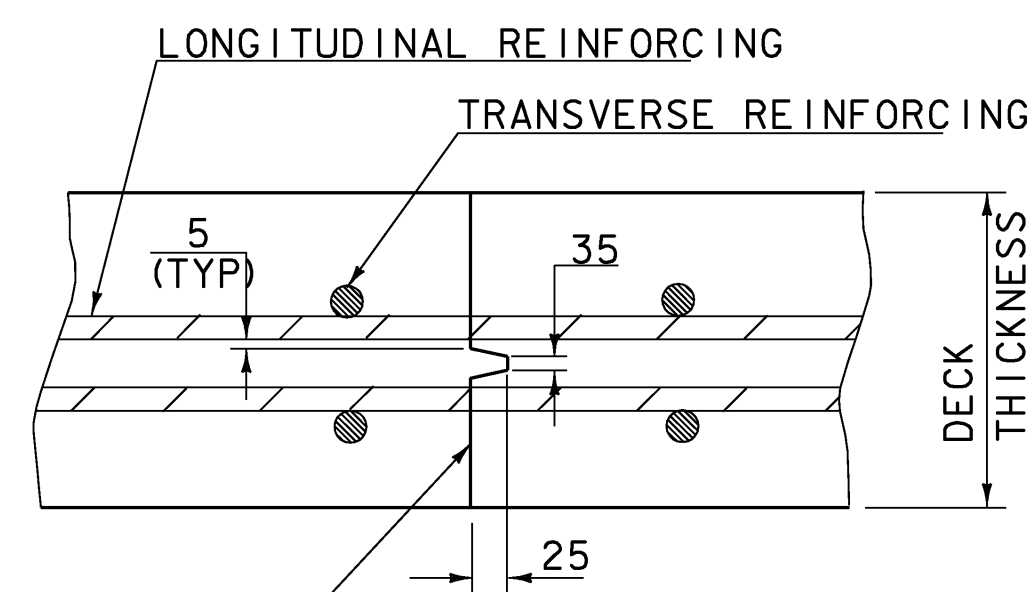

APPLY EPOXY BONDING COMPOUND BEFORE PLACING NEW CONCRETE. INCLUDE WITH COST BID FOR ADJACENT CONCRETE.

TRANSVERSE BRIDGE SLAB CONSTRUCTION JOINT DETAILS

NOTE:

NF - NEAR FACE
FF - FAR FACE
EF - EACH FACE
▲ - CUT TO FIT IN FIELD
80 CLR. UNLESS OTHERWISE SPECIFIED ON THE PLANS.
660 MIN. LAP LENGTH UNLESS OTHERWISE SPECIFIED ON THE PLANS

POUR SEQUENCE DETAILS

PROJECT NAME: BRATTLEBORO	PLOT DATE: 29-APR-2009
PROJECT NUMBER: BRF 2000(2)S	DRAWN BY: D. PETERSON
FILE NAME: 96J228\str\sj228sup.dgn	CHECKED BY: C. CARLSON
PROJECT LEADER: R.R. WHITCOMB	SHEET 36 OF 77
DESIGNED BY: C. CARLSON	
sj228sup.l	