



FRAMING PLAN
 0 1 2 3 4 5
 SCALE = 1:50

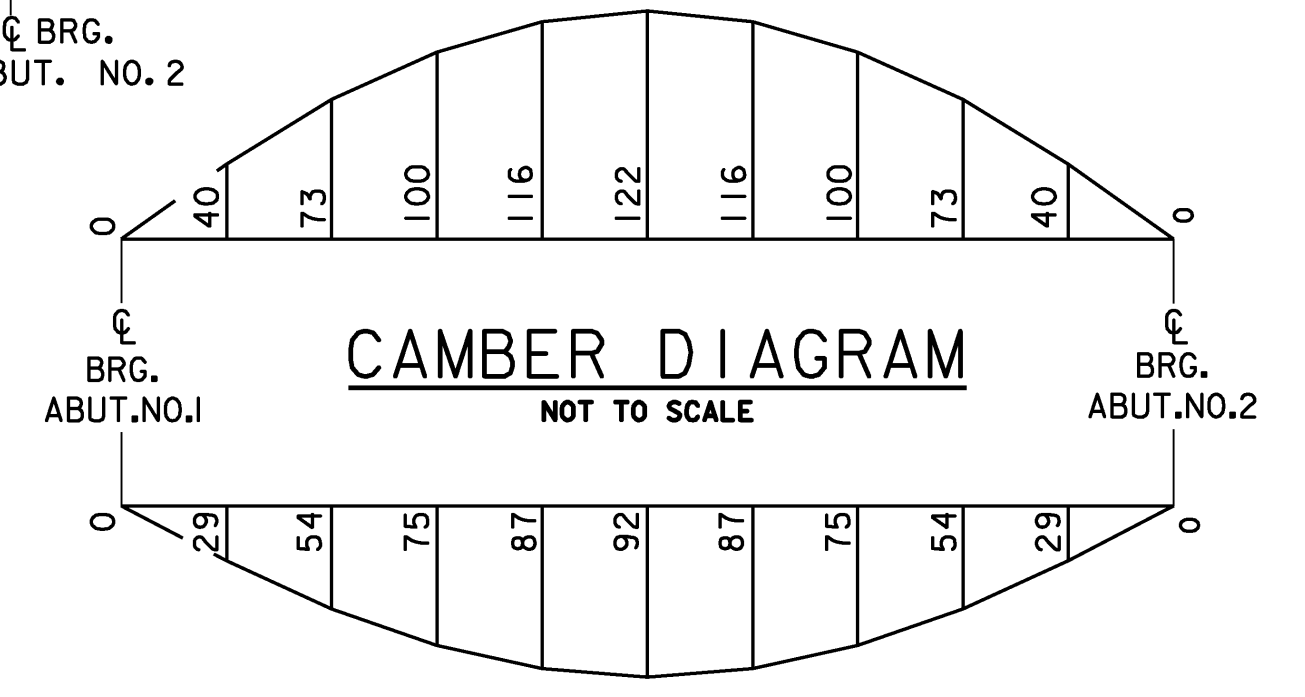

DEAD LOAD DEFLECTION DIAGRAM
 NOT TO SCALE

NOTE: CAMBER AND DEFLECTION MEASUREMENTS ARE GIVEN IN MILLIMETERS AT TENTH POINTS. DEAD LOAD DEFLECTION IS DUE TO GIRDER, DIAPHRAGMS, DECK, SIDEWALK, PAVEMENT, AND RAILING.

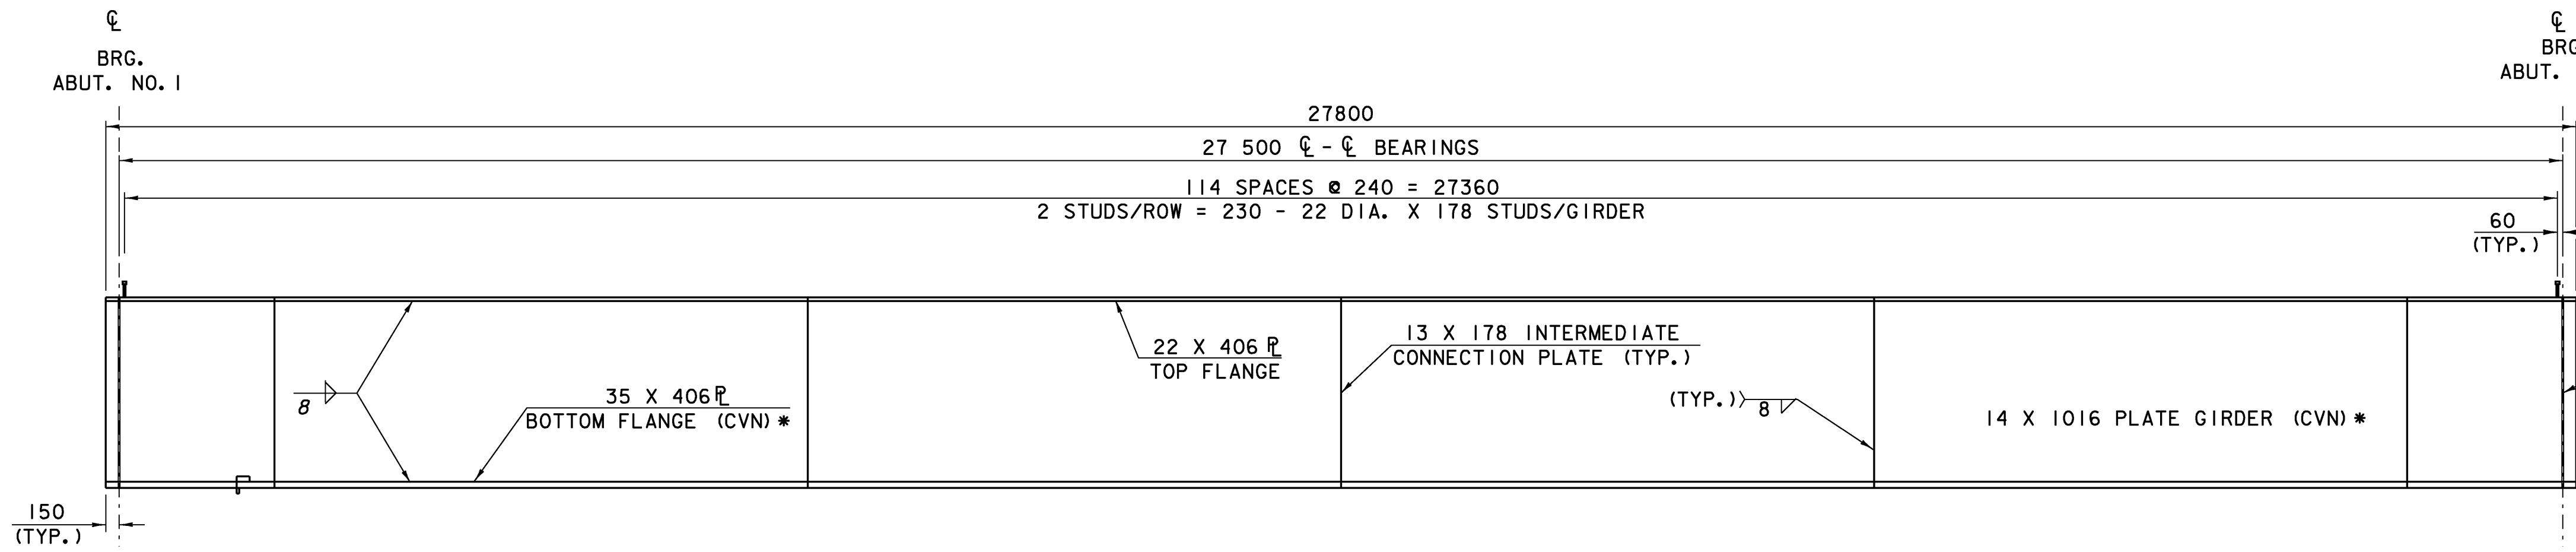

FRAMING ELEVATION
 0 1 2 3 4 5
 SCALE = 1:50

* PLATE REQUIRES CHARPY V-NOTCH TESTING

FRAMING PLAN

PROJECT NAME: BRATTLEBORO	PLOT DATE: 29-APR-2009
PROJECT NUMBER: BRF 2000(2)S	DRAWN BY: str3
FILE NAME: 96j228\str\s1228fr.dgn	DESIGNED BY: J. PERRIGO
PROJECT LEADER: R.R. WHITCOMB	CHECKED BY: D. BONNEAU
DESIGNED BY: J. PERRIGO	SHEET 37 OF 77
FILE NAME: s1228fr.l	