


INTEGRAL ABUTMENT DETAIL
NTS

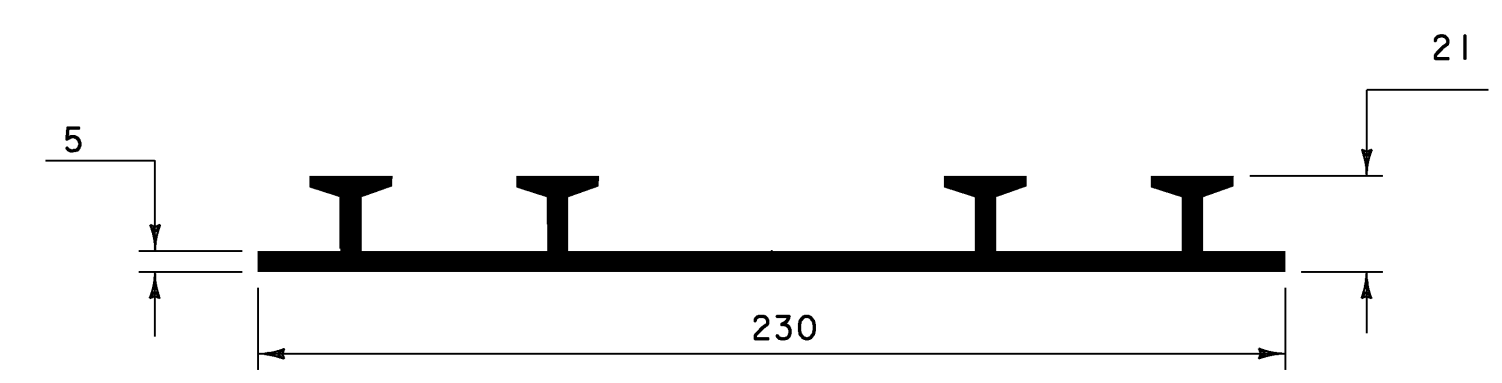

P.V.C. WATERSTOP FOR CONSTRUCTION JOINTS
(NOT TO SCALE)

PAYMENT FOR THE P.V.C. WATERSTOP SHALL BE INCIDENTAL TO THE UNIT BID PRICE FOR THE ADJACENT CONCRETE. OTHER CONFIGURATIONS OF WATERSTOP MAY BE USED UPON APPROVAL OF THE ENGINEER.

NOTE:

- NF - NEAR FACE
- FF - FAR FACE
- EF - EACH FACE
- ▲ - CUT TO FIT IN FIELD
- 80 CLR. UNLESS OTHERWISE SPECIFIED ON THE PLANS.
- 660 MIN. LAP LENGTH UNLESS OTHERWISE SPECIFIED ON THE PLANS

ABUTMENT REINFORCEMENT DETAILS

PROJECT NAME:	BRATTLEBORO	FILE NAME:	96j228\str\sj228sup.dgn	PLOT DATE:	27-MAY-2009
PROJECT NUMBER:	BRF 2000(2)S	PROJECT LEADER:	R.R. WHITCOMB	DRAWN BY:	D. PETERSON
		DESIGNED BY:	C. CARLSON	CHECKED BY:	C. CARLSON
			sj228bed.i	SHEET 41	OF 77