


MAINLINE CROSS SECTIONS (4)

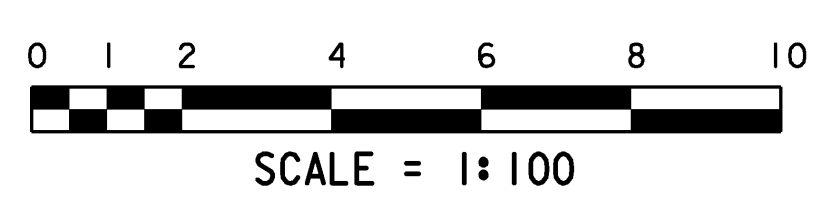

PROJECT NAME:	BRATTLEBORO	PLOT DATE:	29-APR-2009
PROJECT NUMBER:	BRF 2000 (2)S	DRAWN BY:	str3
FILE NAME:	96J228/str/sj228xsl.dgn	DESIGNED BY:	J. PERRIGO
PROJECT MANAGER:	R.R. WHITCOMB	CHECKED BY:	D. BONNEAU
DESIGNED BY:	J. PERRIGO	SHEET	50 OF 77