


DRIVE CROSS SECTIONS

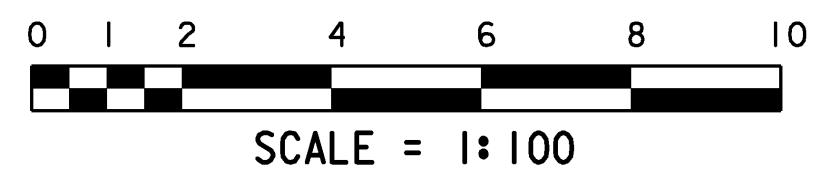

PROJECT NAME:	BRATTLEBORO	PLOT DATE:	29-APR-2009
PROJECT NUMBER:	BRF 2000 (2)S	DRAWN BY:	str3
FILE NAME:	961228/str/sj228xs.dgn	CHECKED BY:	D. BONNEAU
DESIGNED BY:	J. PERRIGO	SHEET	54 OF 77