




3+030.00

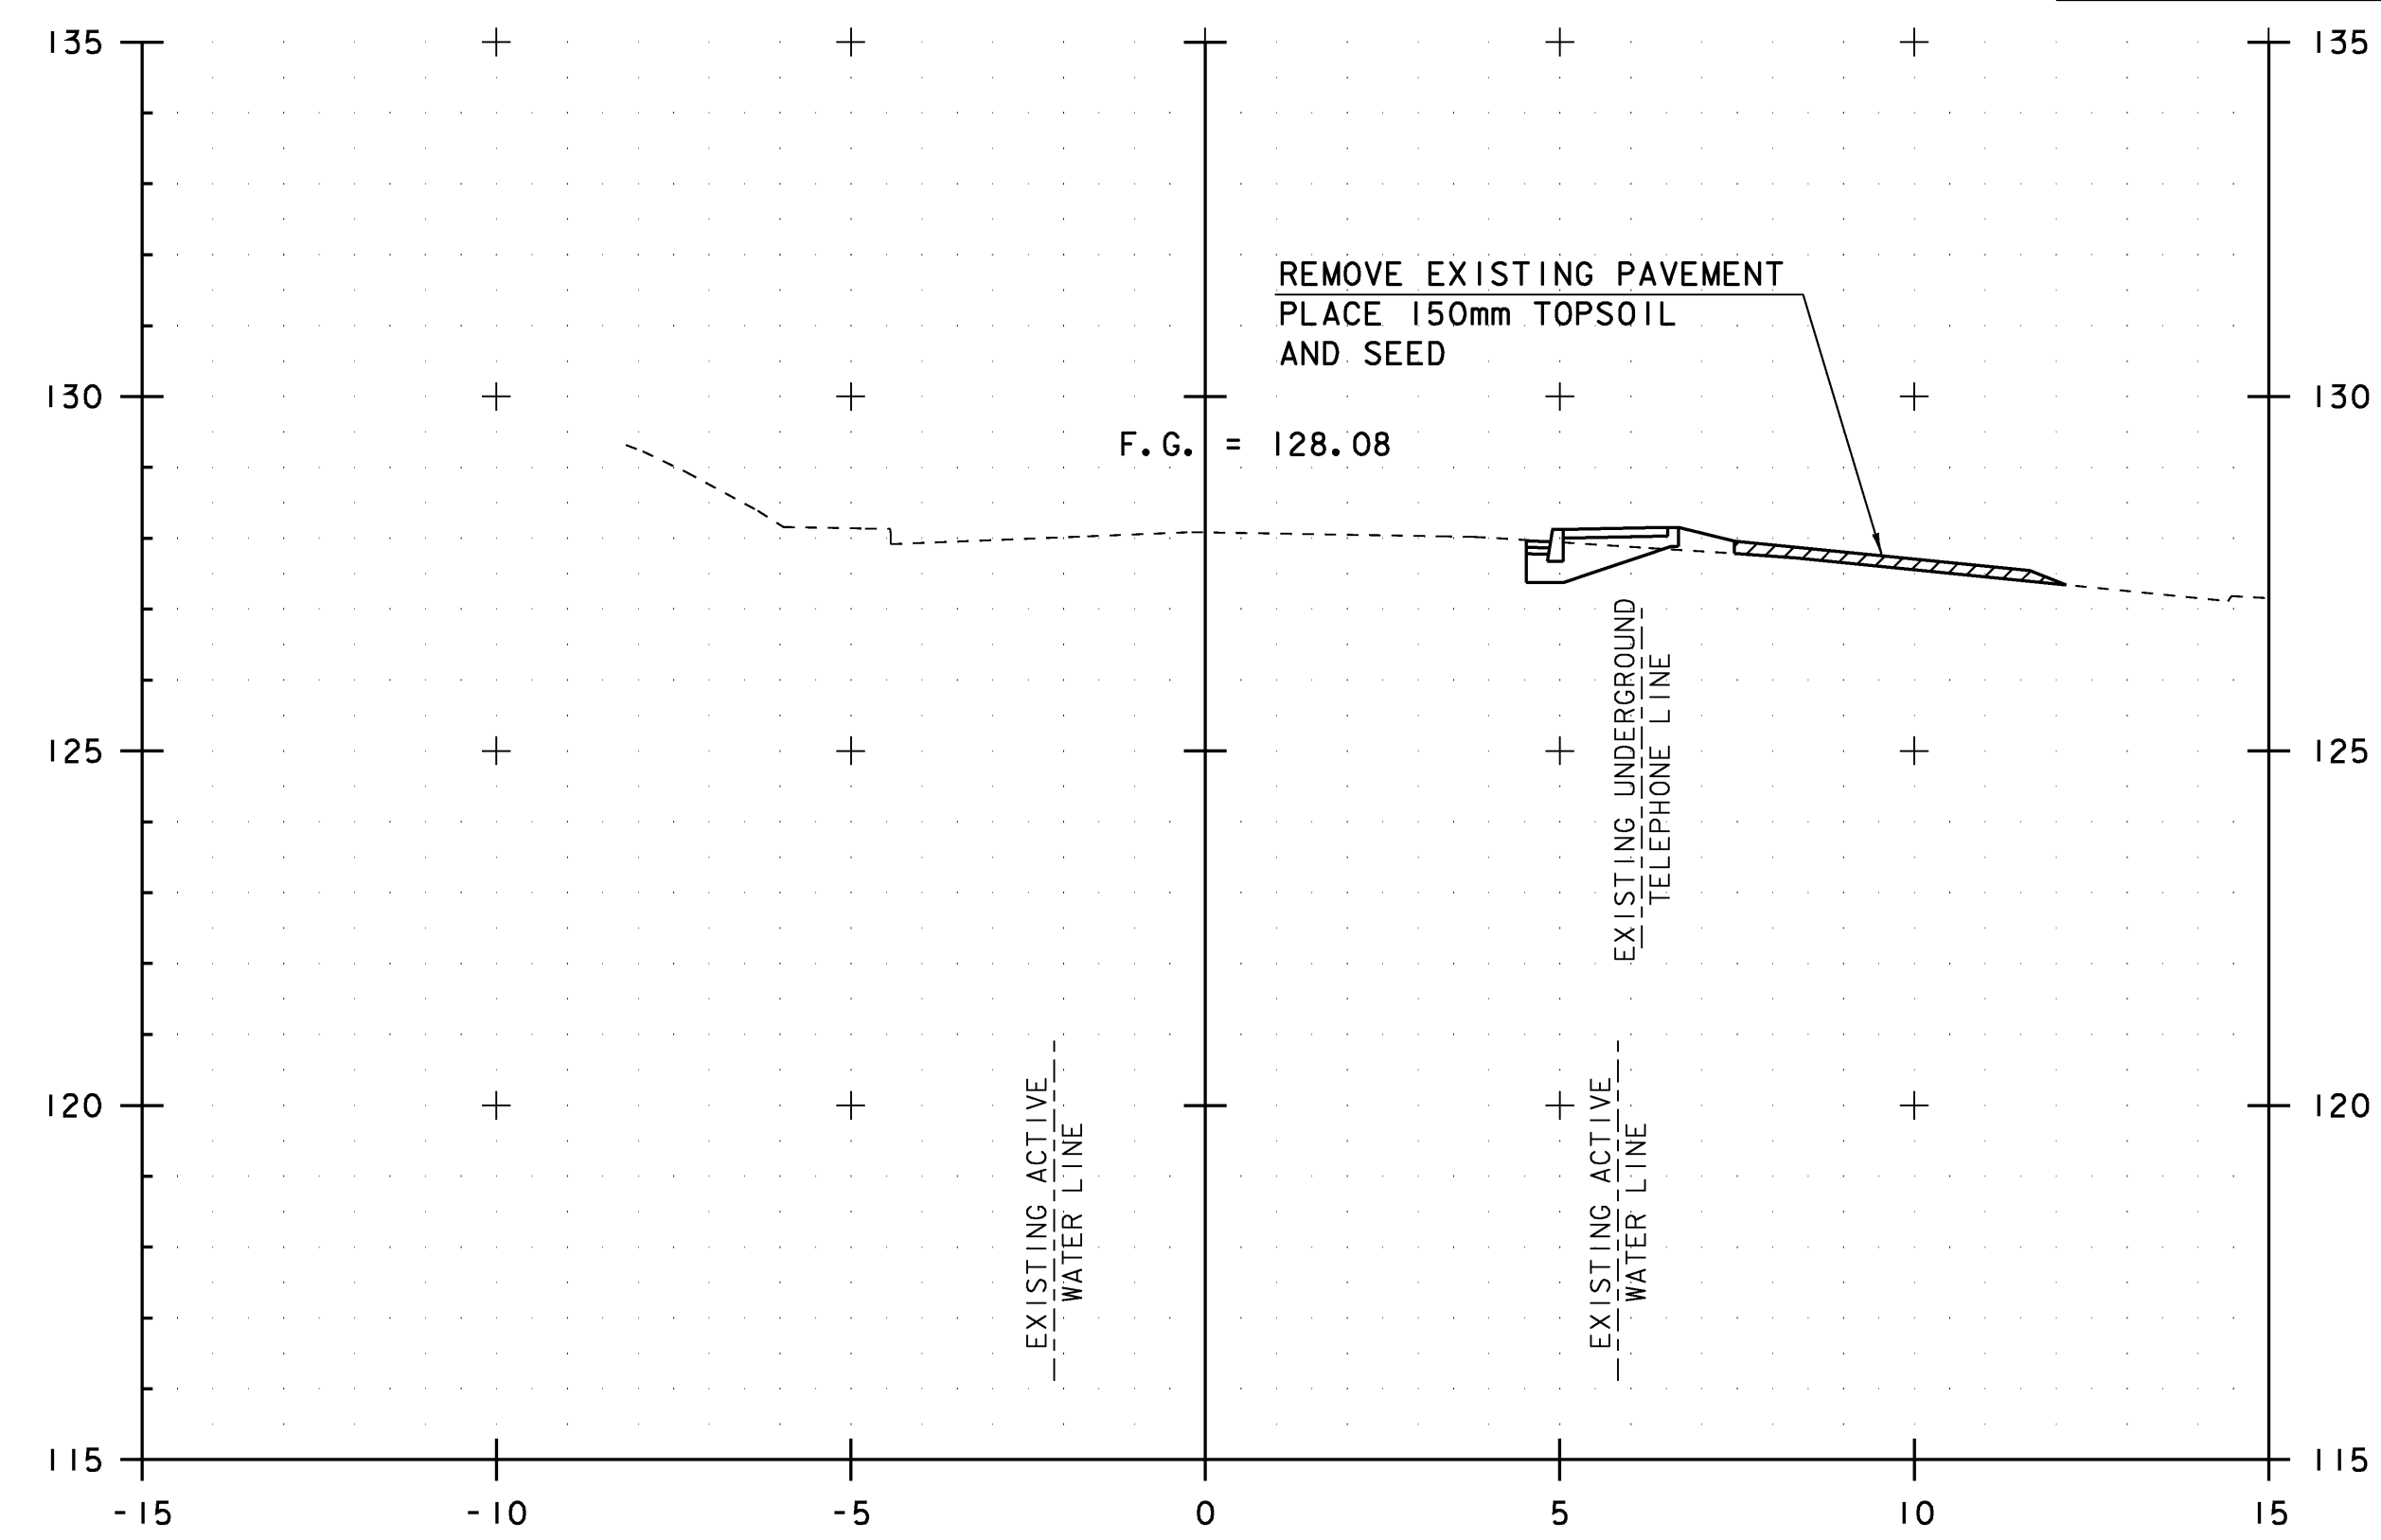

3+050.00

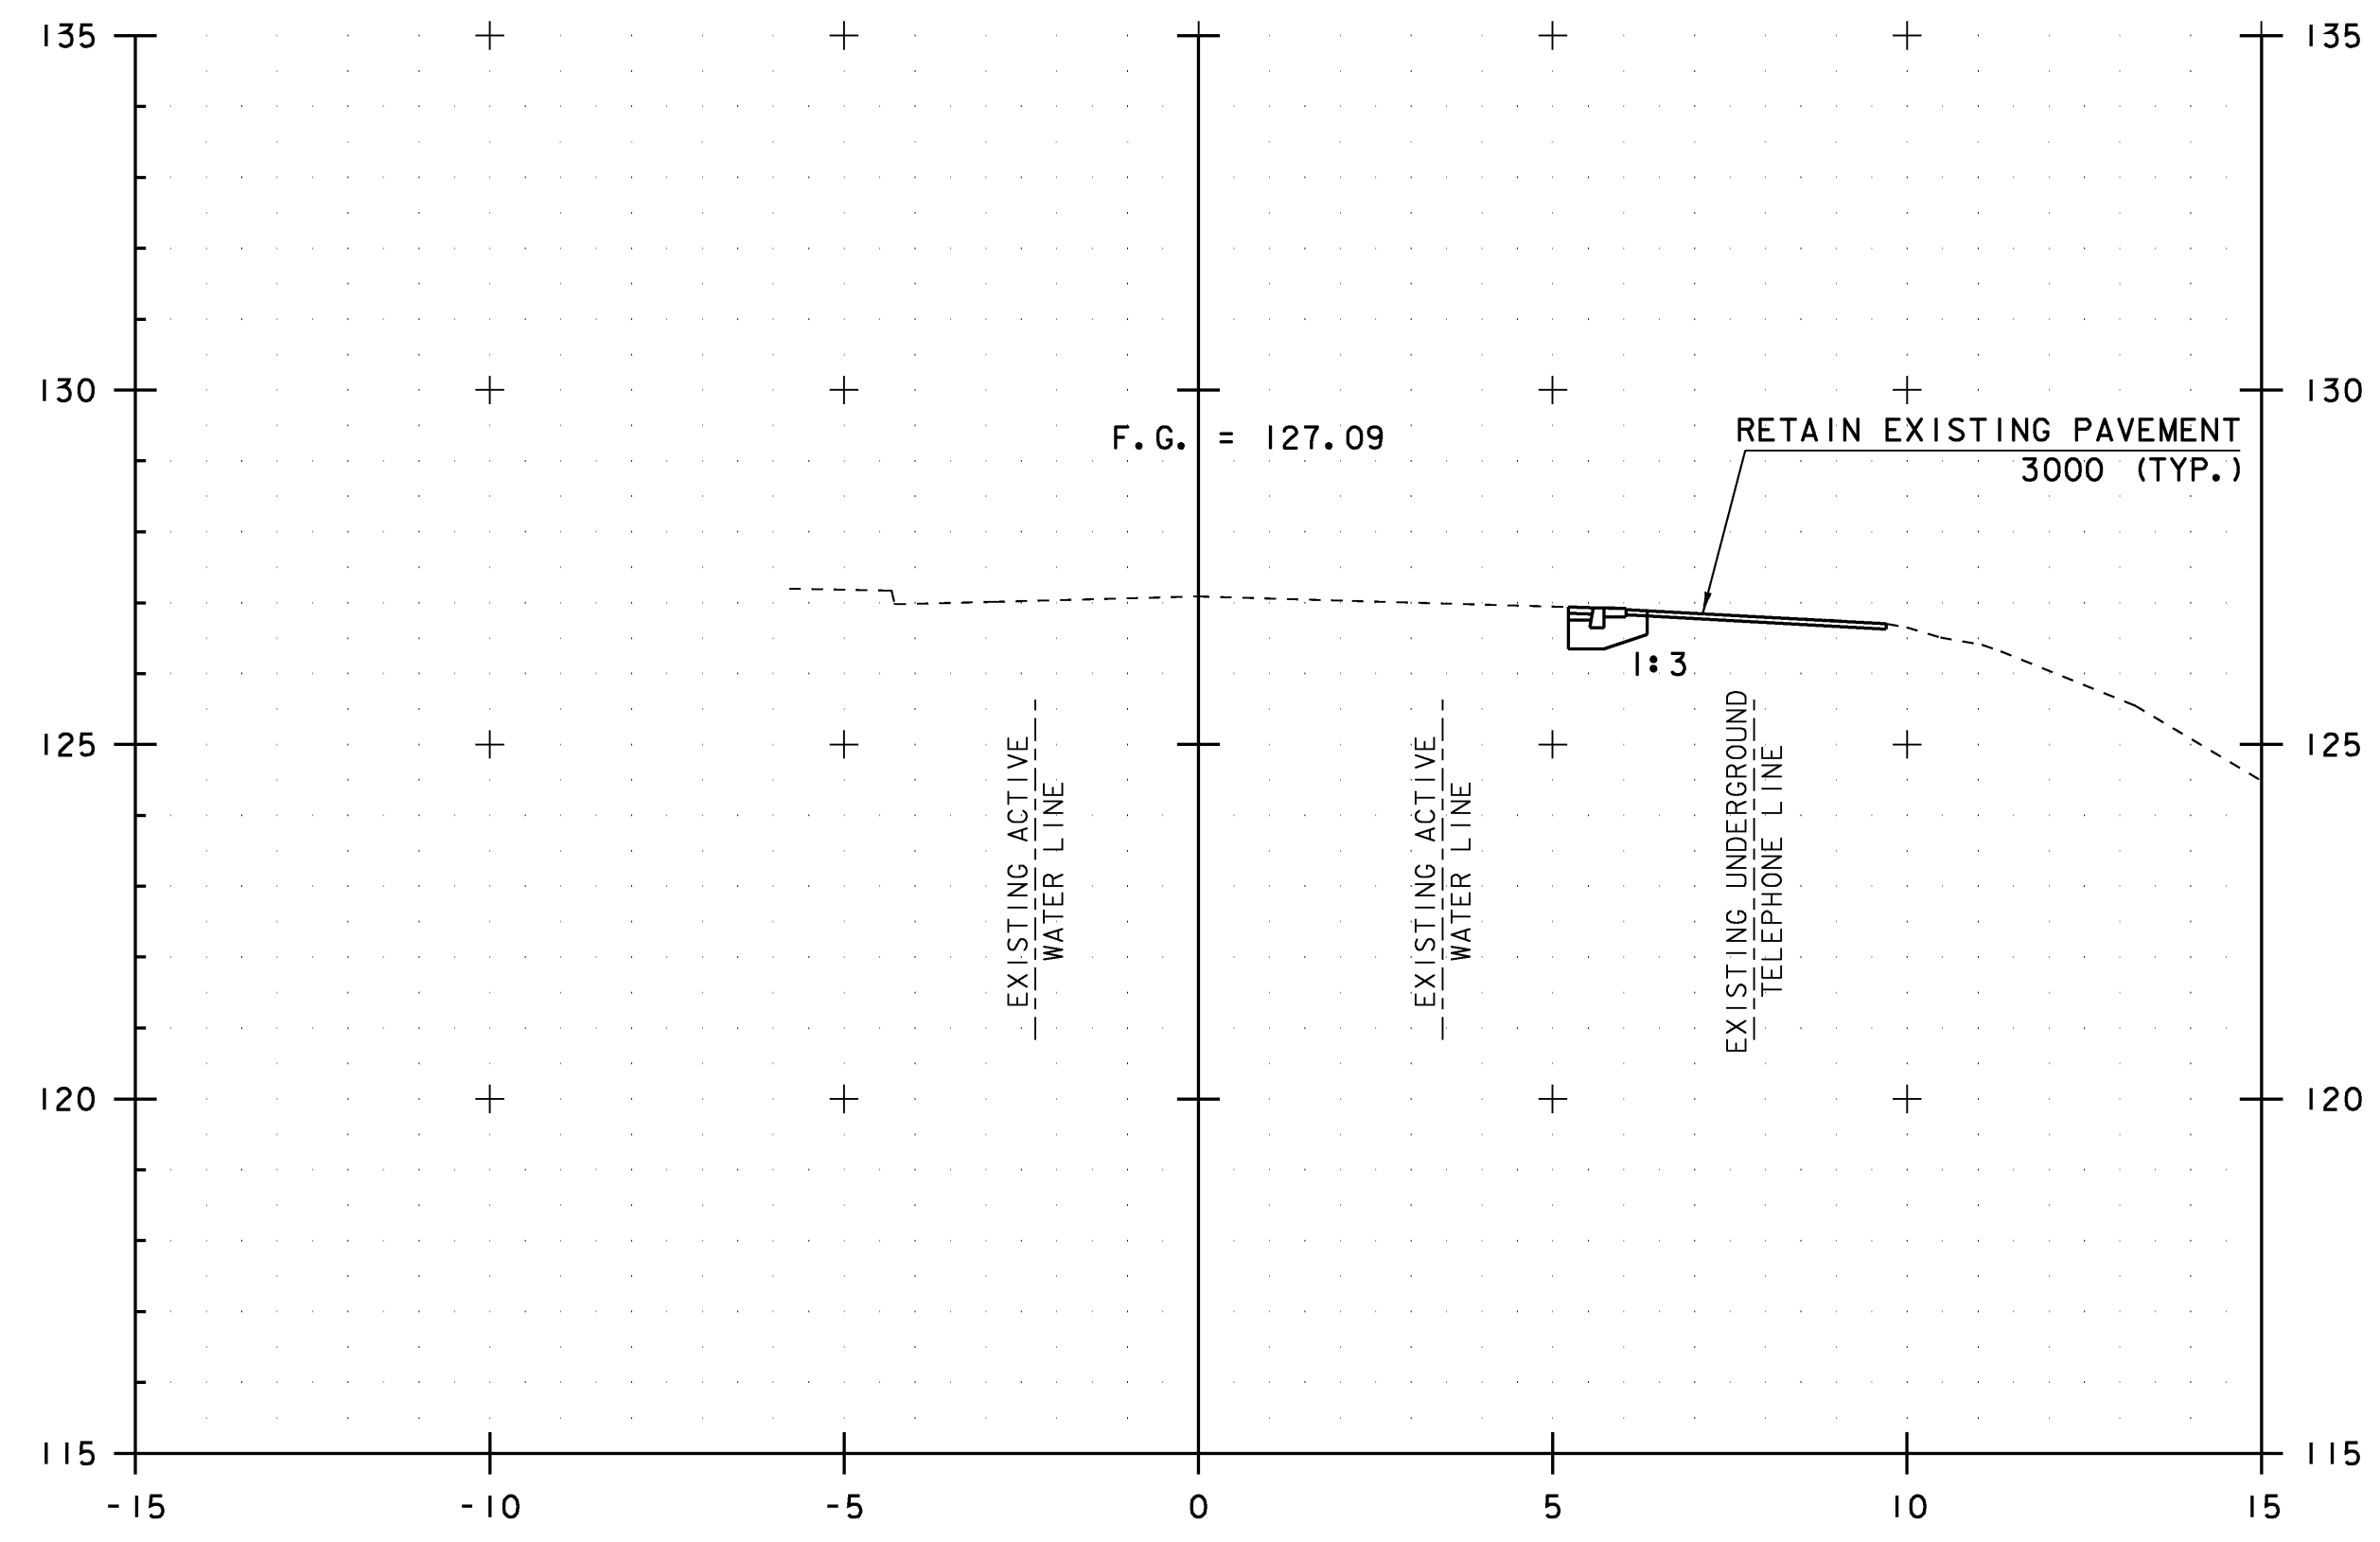


3+020.00

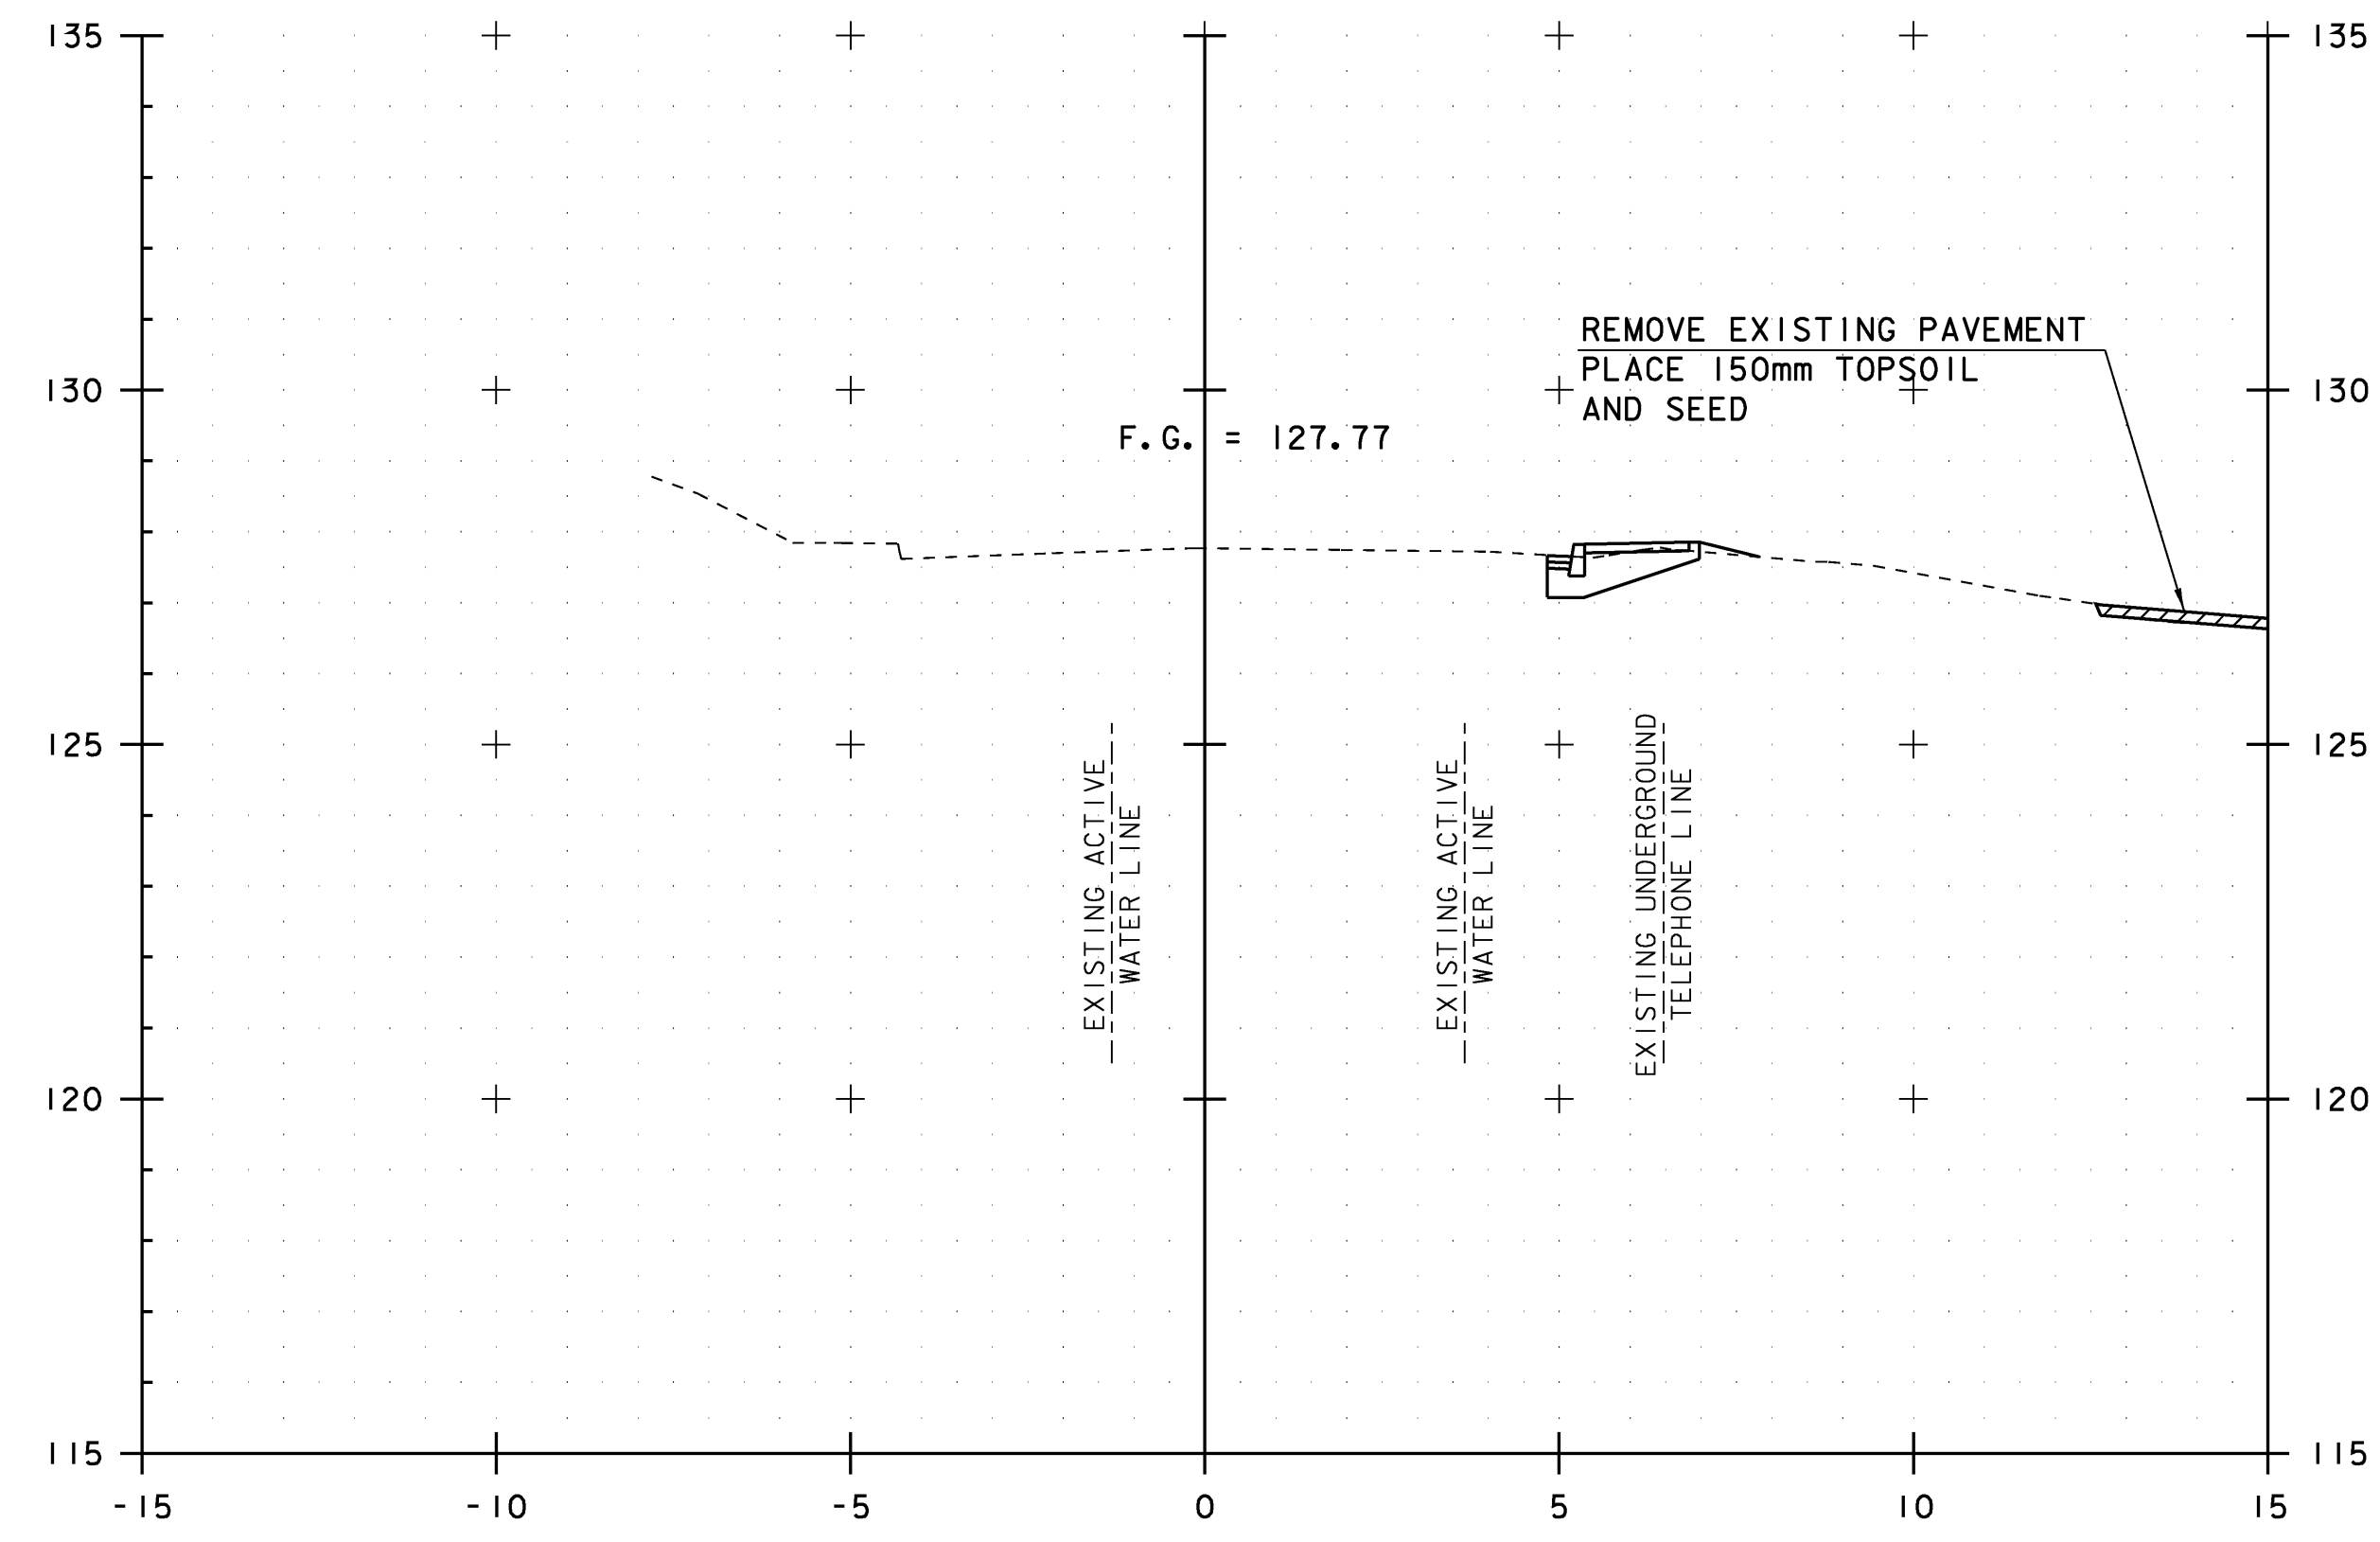

3+040.00

VT9 CROSS SECTIONS (1)

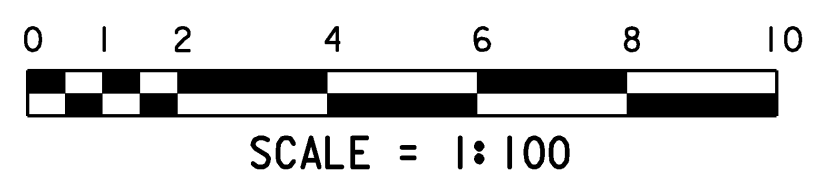

STA. 3+020 TO STA. 3+050

PROJECT NAME:	BRATTLEBORO	PLOT DATE:	29-APR-2009
PROJECT NUMBER:	BRF 2000 (2)S	DRAWN BY:	str3
FILE NAME:	96J228/str/sj228xsl.dgn	CHECKED BY:	D. BONNEAU
PROJECT MANAGER:	R.R. WHITCOMB	SHEET	55 OF 77
DESIGNED BY:	J. PERRIGO		