


VT9 CROSS SECTIONS (2)

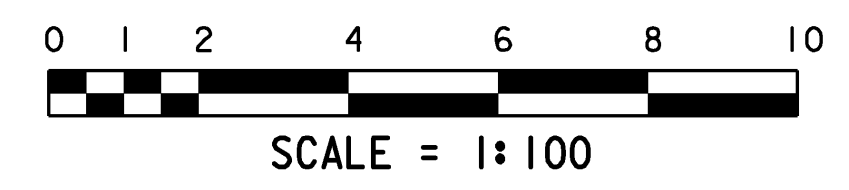

STA. 3+060 TO STA. 3+090

PROJECT NAME: BRATTLEBORO	
PROJECT NUMBER: BRF 2000 (2)S	
FILE NAME: 96J228/str/sj228xsl.dgn	PLOT DATE: 29-APR-2009
PROJECT MANAGER: R.R. WHITCOMB	DRAWN BY: str3
DESIGNED BY: J.PERRIGO	CHECKED BY: D. BONNEAU
sj228col1	SHEET 56 OF 77