
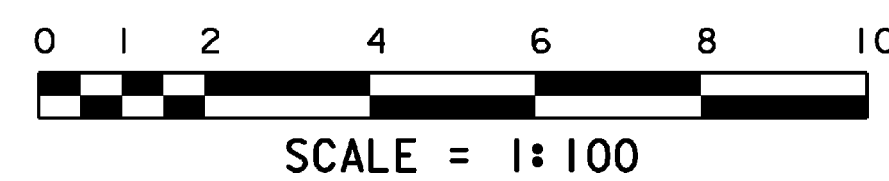


SEE PAGE 14 OF 77 FOR NEW CHANNEL LINE  
ALSO SEE NEW CHANNEL X SECTIONS ON FULL SIZE SHEETS

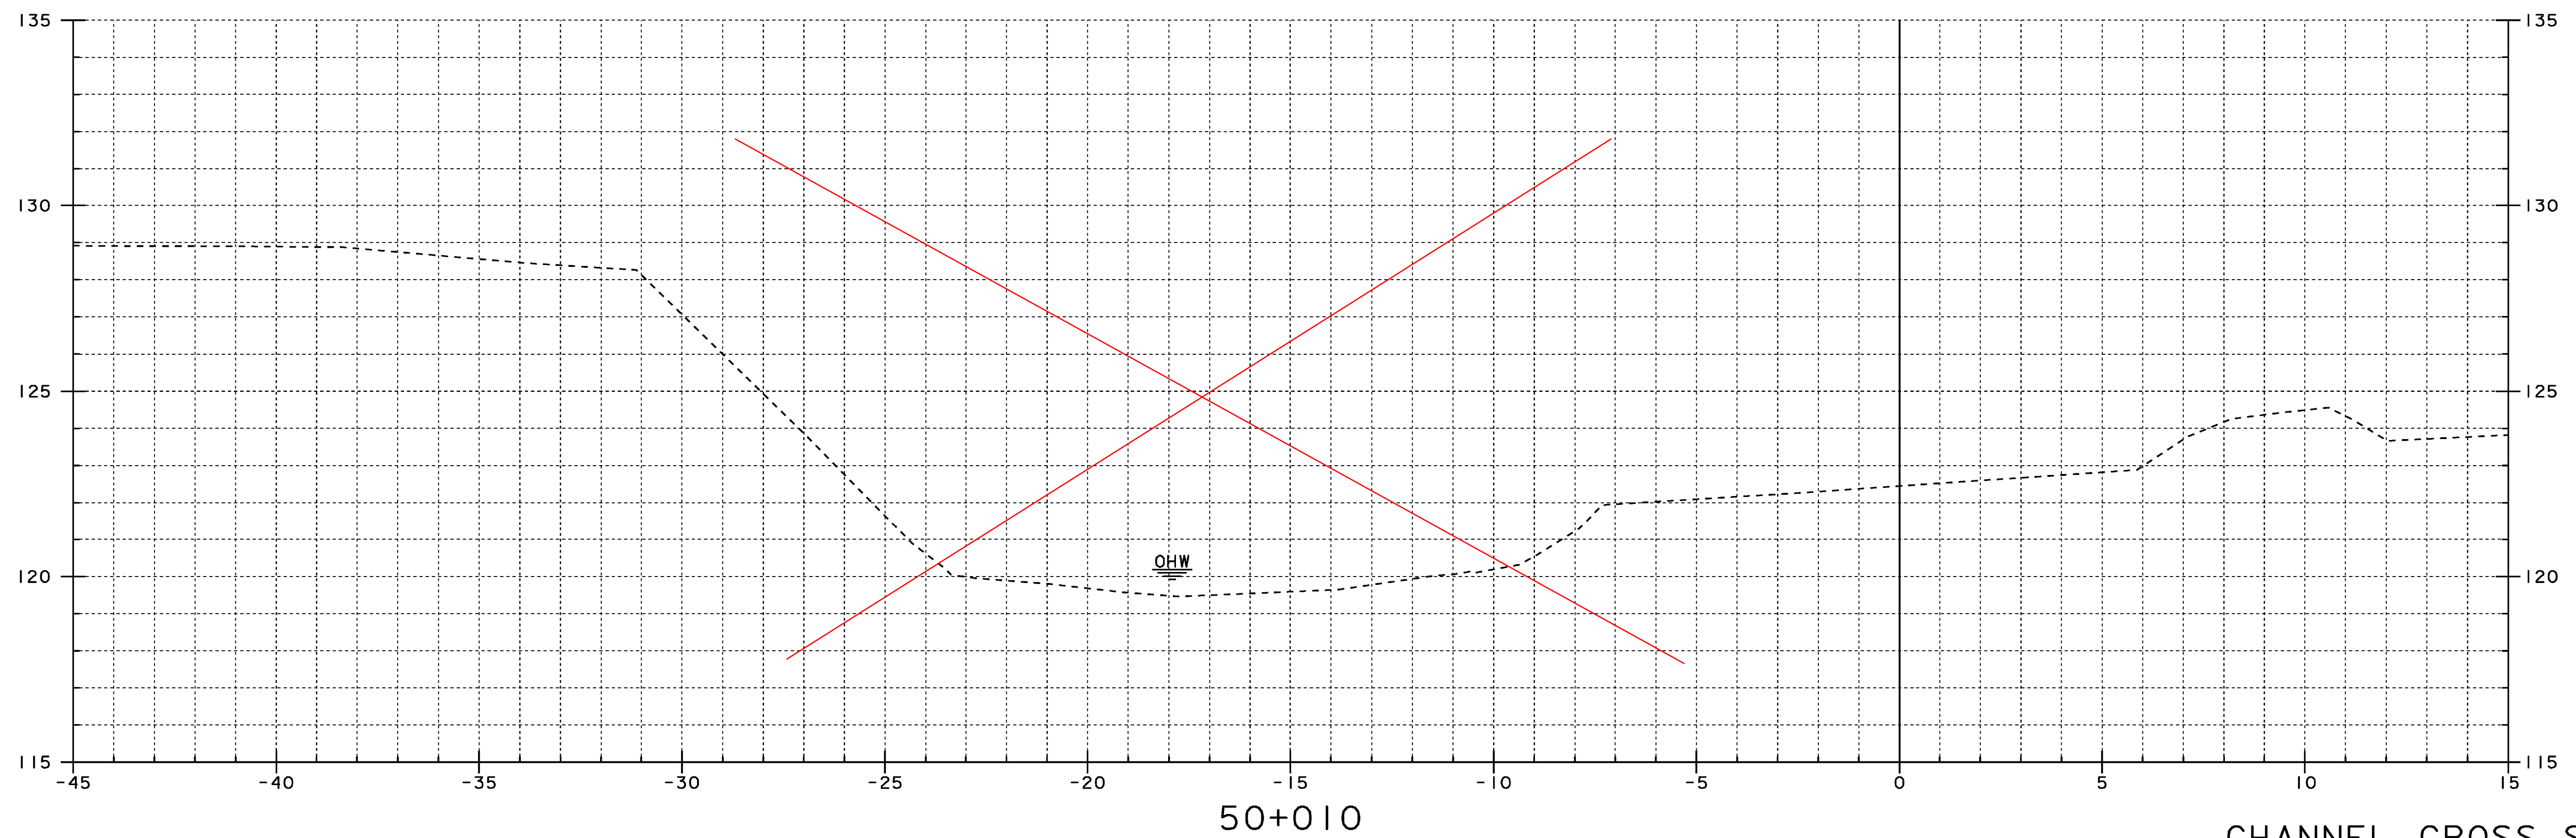

CHANNEL CROSS SECTIONS (1)

PROJECT NAME: BRATTLEBORO  
PROJECT NUMBER: BRF 2000 (2)S

FILE NAME: 96J228/str/sj228xsl.dgn	PLOT DATE: 29-APR-2009
PROJECT MANAGER: R.R. WHITCOMB	DRAWN BY: str3
DESIGNED BY: J. PERRIGO	CHECKED BY: D. BONNEAU
sj228c01.l	SHEET 57 OF 77