


STA. 50+055.10 FAR LT.
END GRANULAR BACKFILL FOR STRUCTURES

STA. 50+055.00 LT.
END UNCLASSIFIED CHANNEL EXCAVATION
GEOTEXTILE UNDER STONE FILL
STONE FILL, TYPE IV
GRUBBING MATERIAL



PLACE 150mm TOPSOIL
AND SEED OVER EXISTING
GRAVEL PARKING AREA

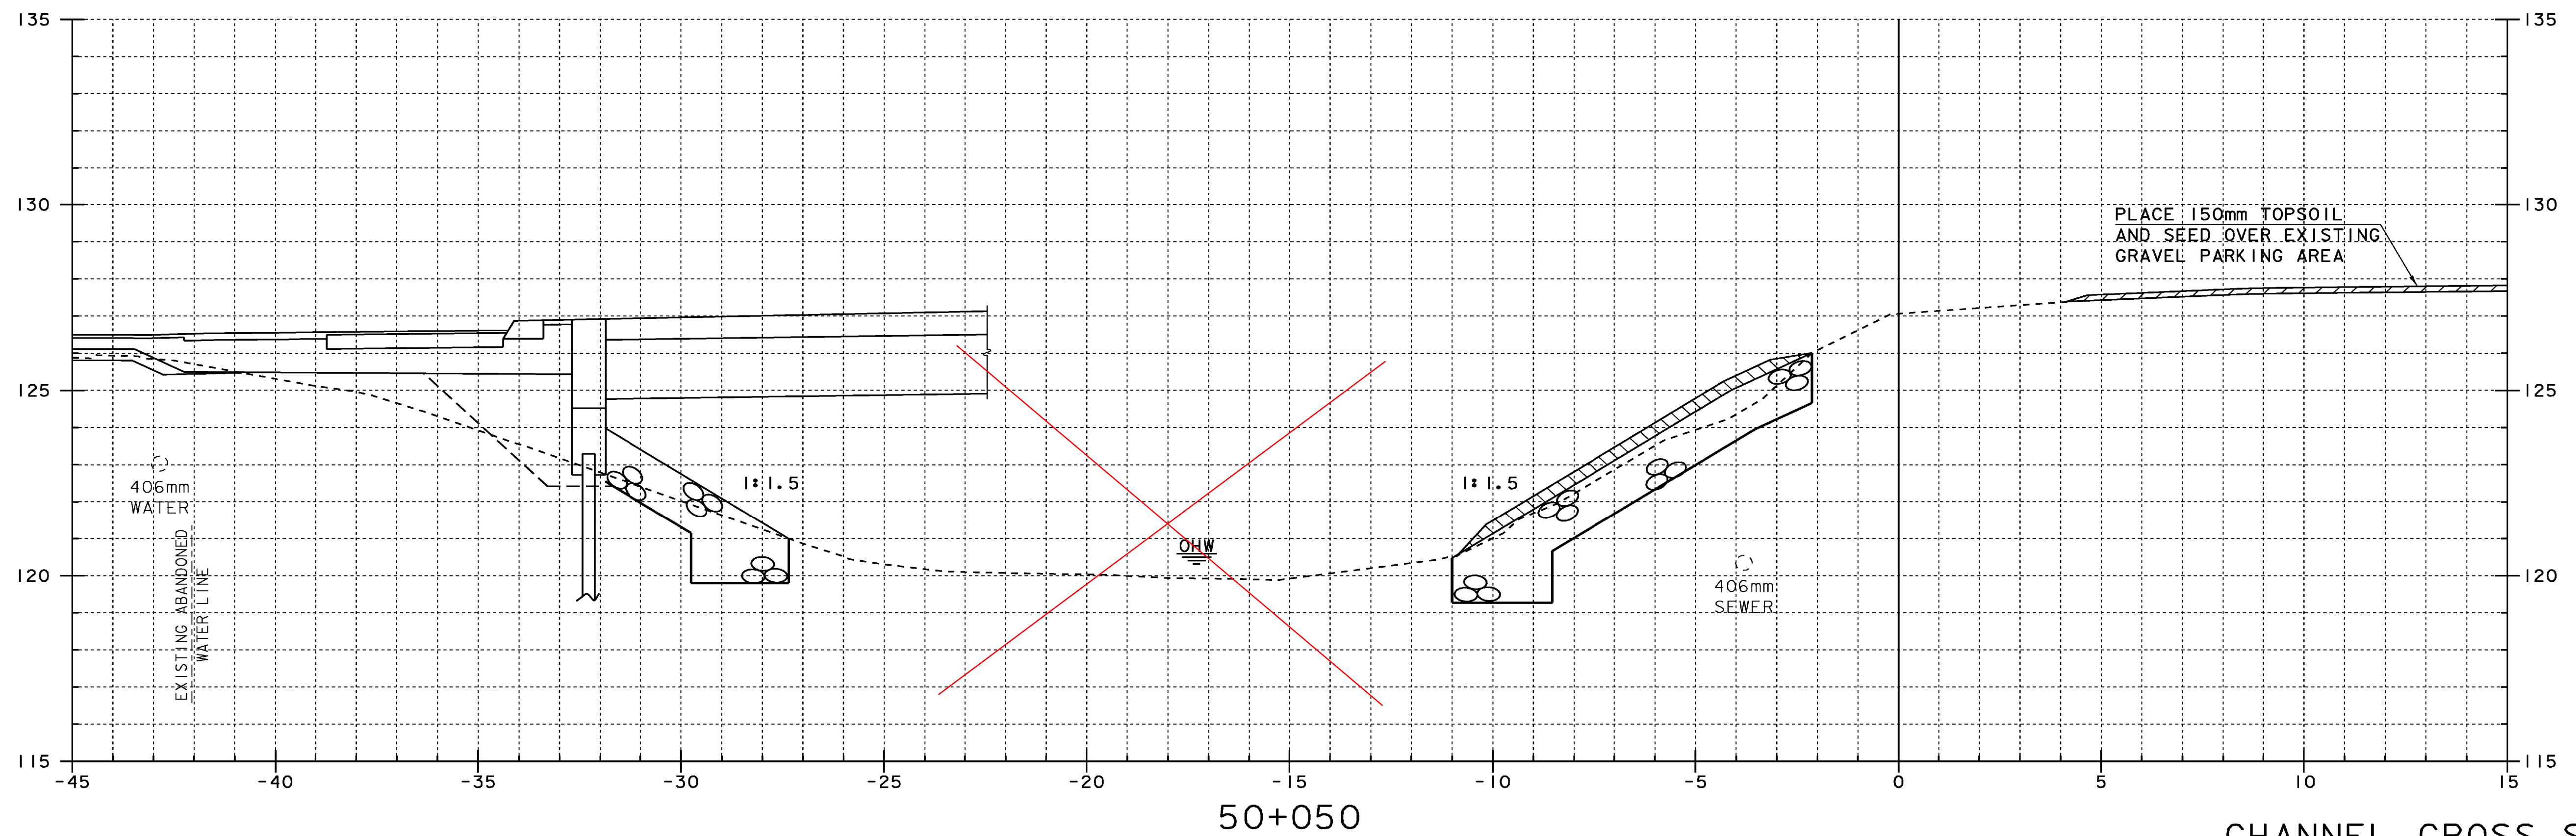

SCALE = 1:100

CHANNEL CROSS SECTIONS (5)

PROJECT NAME:	BRATTLEBORO	PLOT DATE:	26-MAY-2009
PROJECT NUMBER:	BRF 2000 (2)S	DRAWN BY:	str3
FILE NAME:	96J228/str/sj228xsl.dgn	CHECKED BY:	D. BONNEAU
PROJECT MANAGER:	R.R. WHITCOMB	SHEET	61 OF 77
DESIGNED BY:	J. PERRIGO		
sj228c05.1			