


STA. 50+062.78 FAR LT.
 END UNCLASSIFIED CHANNEL EXCAVATION
 GEOTEXTILE UNDER STONE FILL
 STONE FILL, TYPE IV
 GRUBBING MATERIAL

50+070

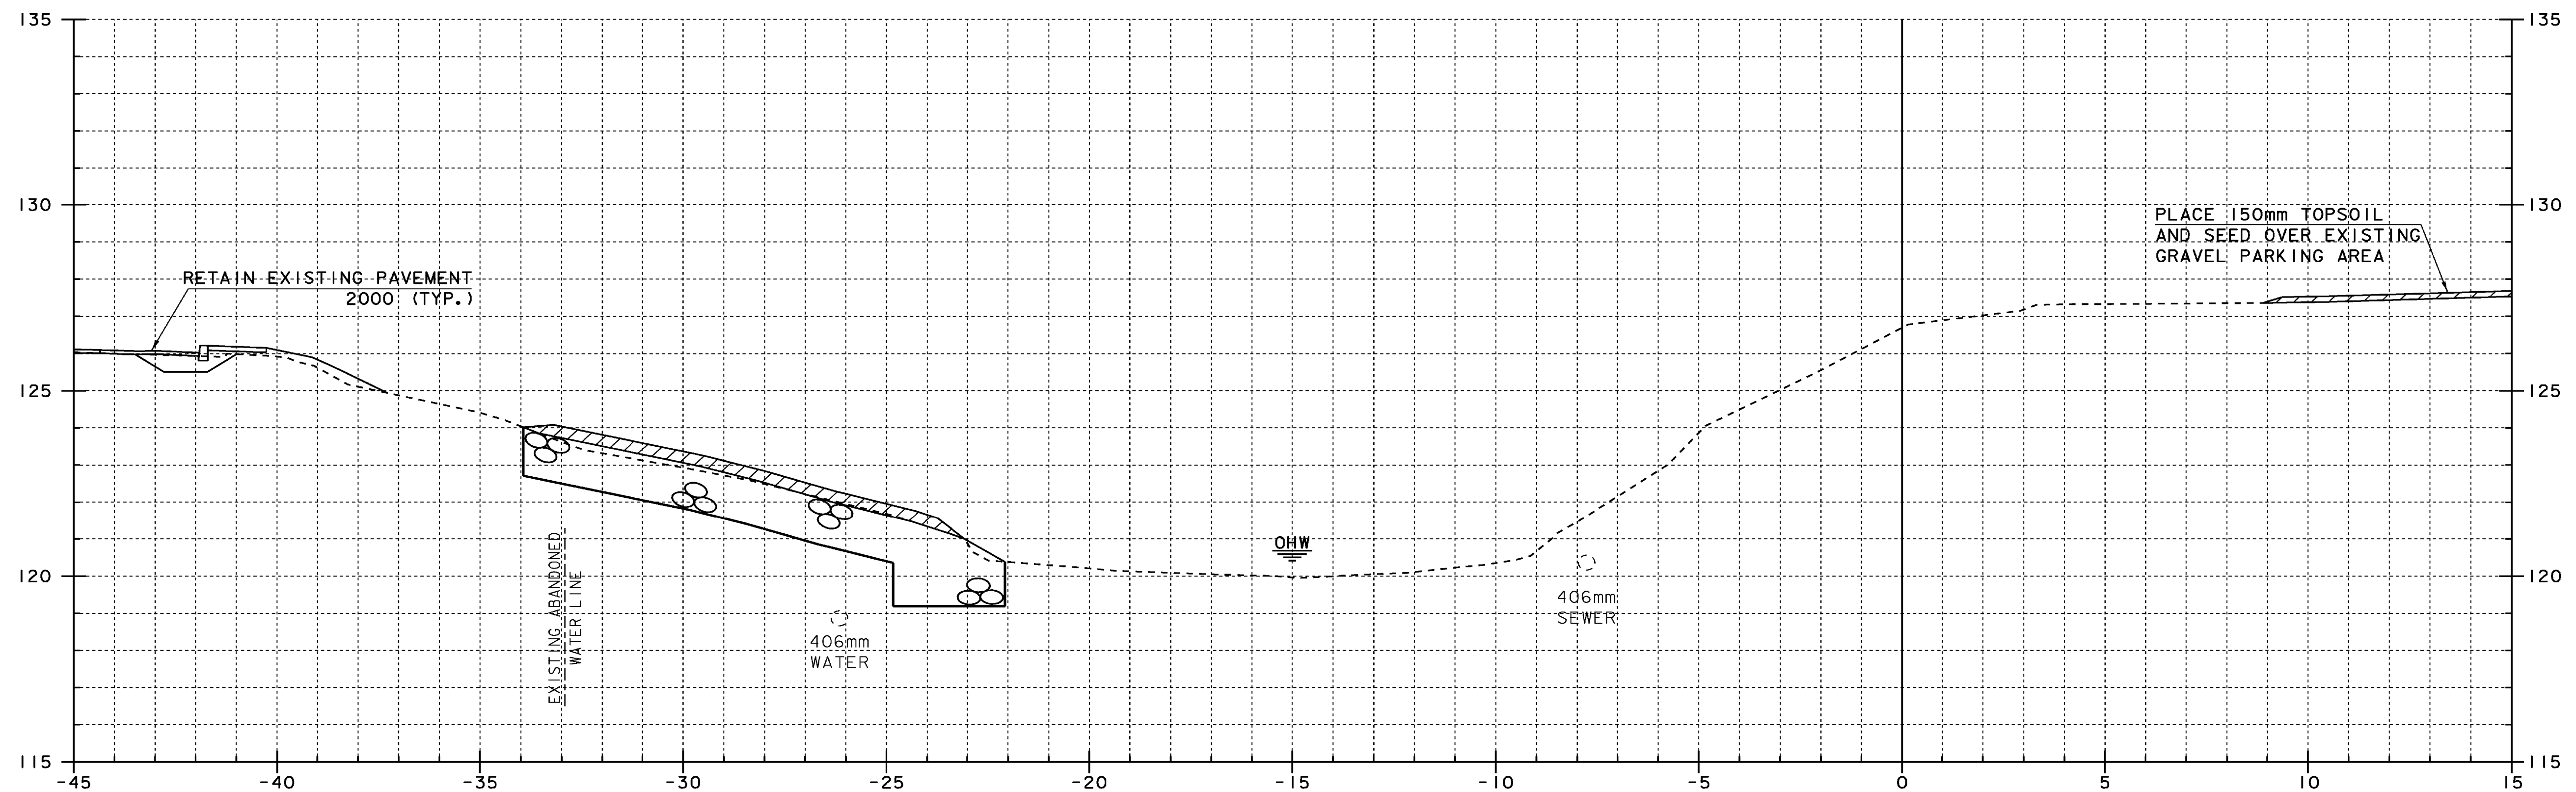

50+060

CHANNEL CROSS SECTIONS (6)



SCALE = 1:100

| | | | |
|------------------|-------------------------|-------------|-------------|
| PROJECT NAME: | BRATTLEBORO | PLOT DATE: | 29-APR-2009 |
| PROJECT NUMBER: | BRF 2000 (2)S | DRAWN BY: | str3 |
| FILE NAME: | 96J228/str/sj228xsl.dgn | CHECKED BY: | D. BONNEAU |
| PROJECT MANAGER: | R.R. WHITCOMB | SHEET | 62 OF 77 |
| DESIGNED BY: | J. PERRIGO | | |
| sj228c06.1 | | | |