


ELEVATION - SE APPROACH RAIL

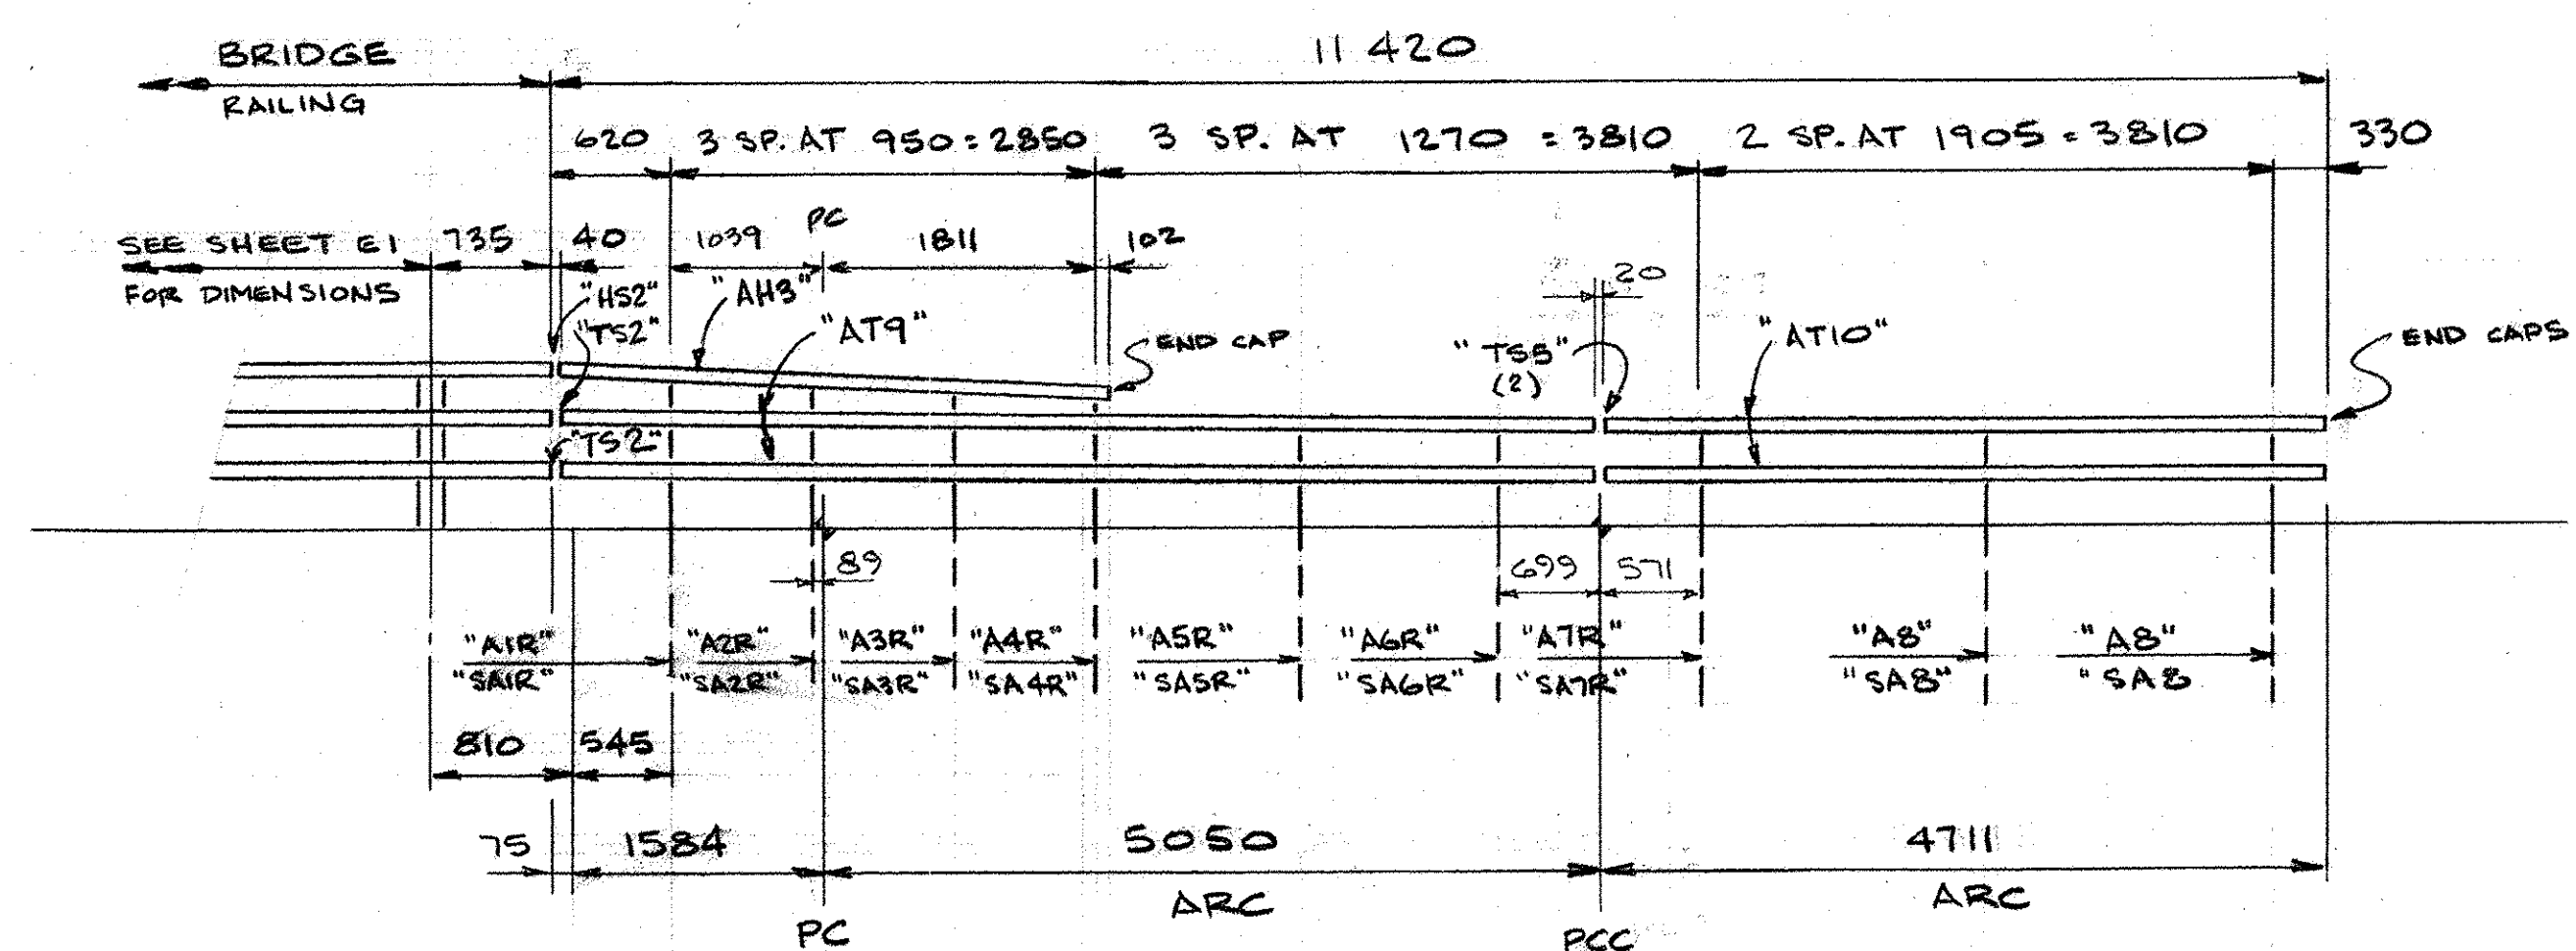

ELEVATION - SW APPROACH RAIL

RECEIVED  
 CRE. BY DPH DATE 4/5/10  
 APR 06 2010  
 RESUBMIT 1 APPROVED [Signature]  
 BY [Signature] DATE 4/20/10

AUCIELLO IRON WORKS INC 560 MAIN ST. HUDSON, MA (978) 568-8382	
VT AGENCY OF TRANSPORTATION BRATTLEBORO # BRF 2000(21)'S BRIDGE # 30 T.H. 10 OVER WHETSTONE BROOK	
ALUM. APPROACH RAILING	
SURFACE PREP: NONE	FINISH: BLACK ANODIZE
FOR: F.R. LAFAYETTE, INC	
DR: <u>[Signature]</u> 2-5-2010	DWG. NO. <u>BR-2978</u>
CHK: <u>[Signature]</u> 4/5/10	JOB NO. <u>AB07025-1002</u>
1	4/5/10 FOR APPROVAL
ISSUE	DATE DESCRIPTION
BY <u>[Signature]</u>	
SHEET E5 OF 5	