
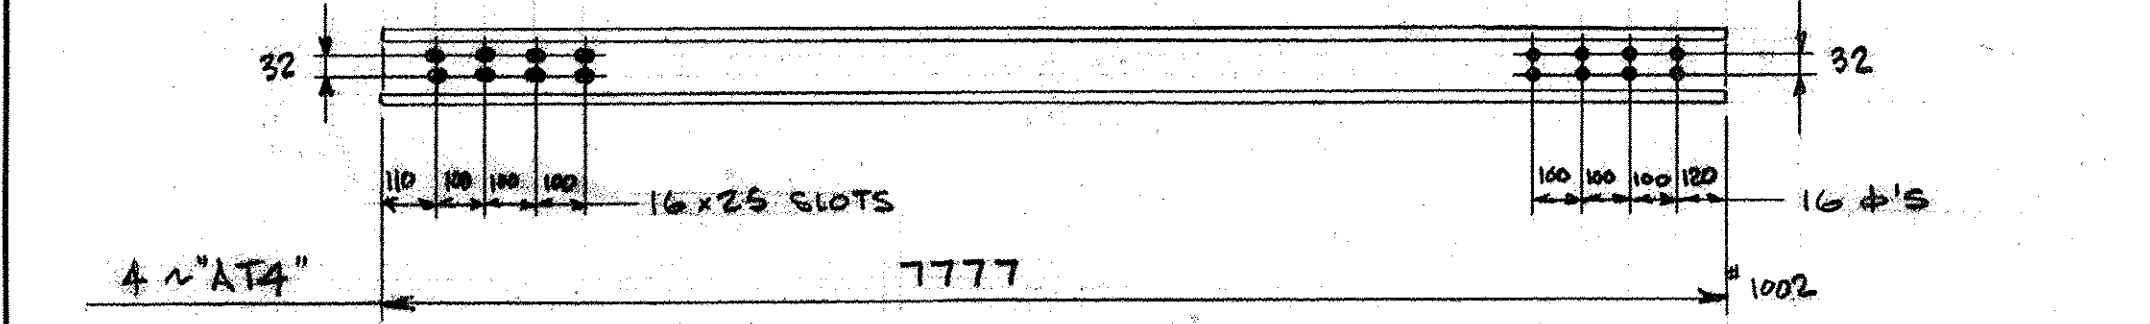
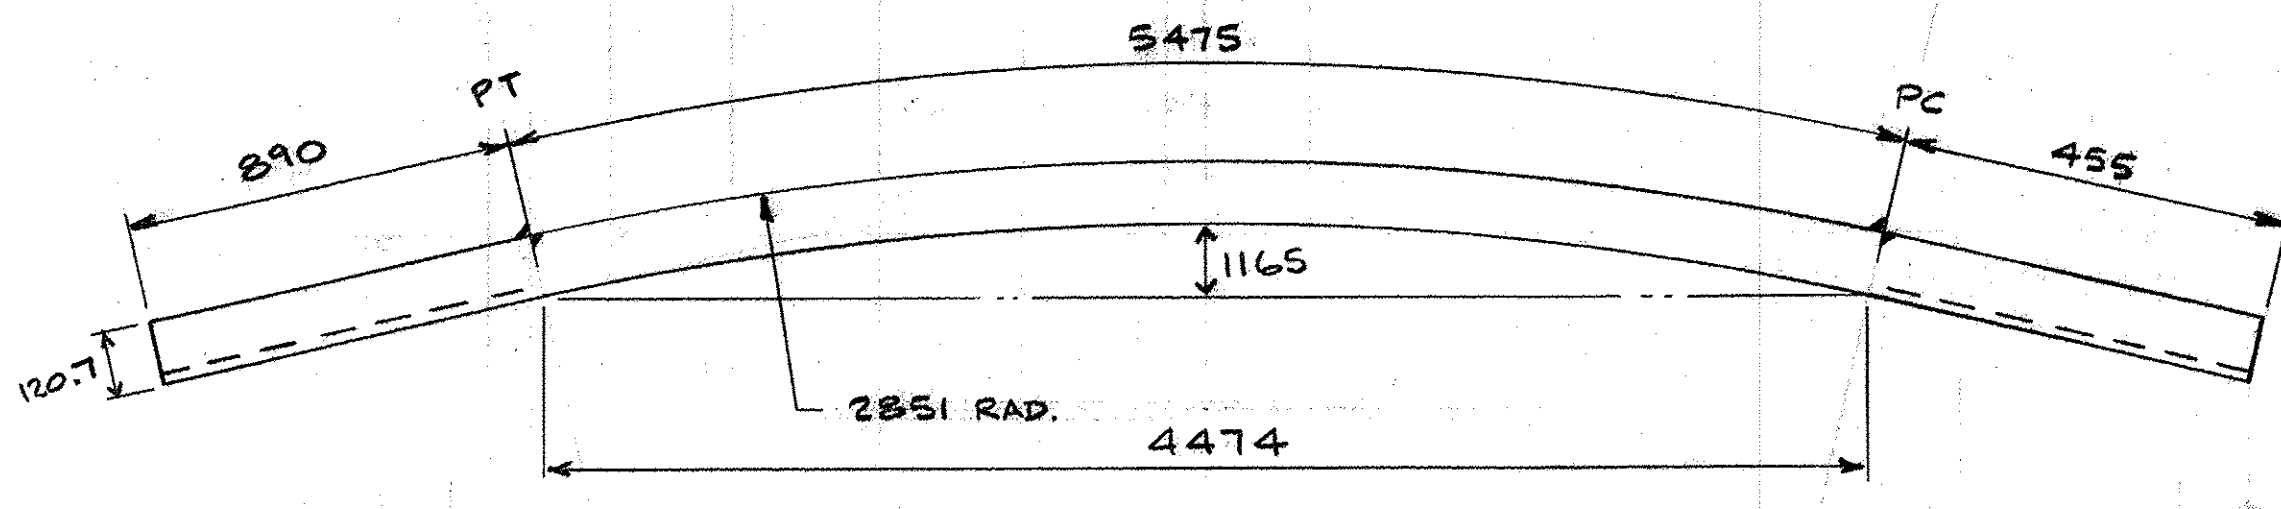




QTY.	MK.	"T"	"A"	"B"	"C"	HOLE	LENGTH
2	AT1	3391	2060	428	2000	F.S.	5451
2	AT5	3252	4135	1650	3658	N.S.	7387
2	AT6	0	4725	535	4441	F.S.	4725
2	AT10	0	4695	528	4415	N.S.	4695

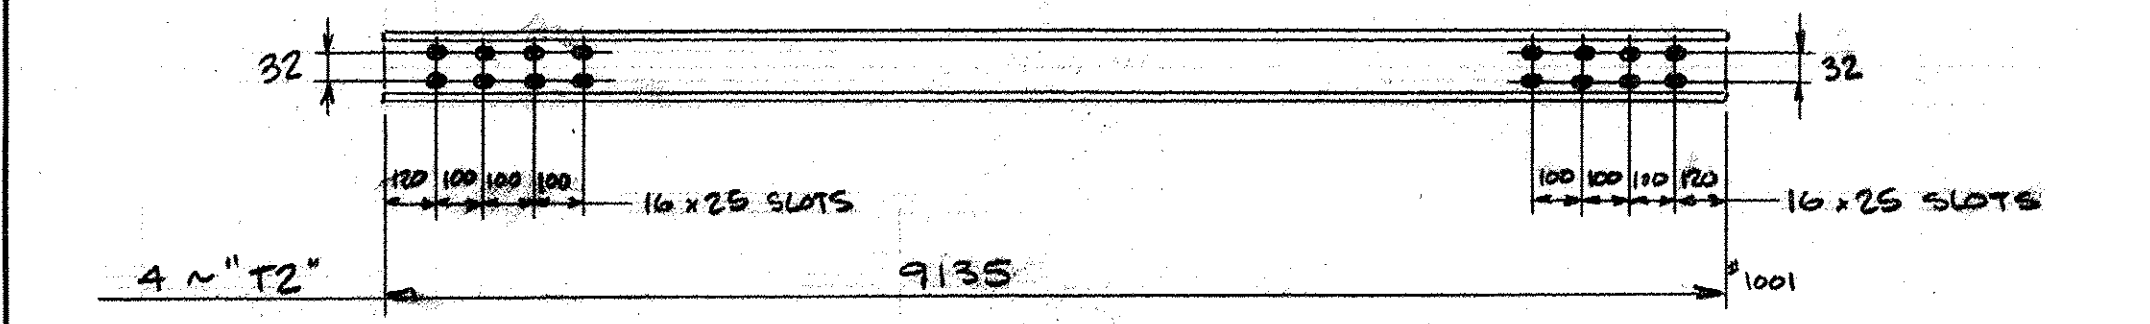

RECEIVED
 BY: *DRP*
 DATE: *4/29/10*
 APR 02 2010
 RESUBMIT APPROVED AS NOTED
 BY: *WE* DATE: *4/29/10*

DIMENSIONS ARE GIVEN IN MILLIMETERS

#1001 = BRIDGE RAILING
 #1002 = APPROACH RAILING

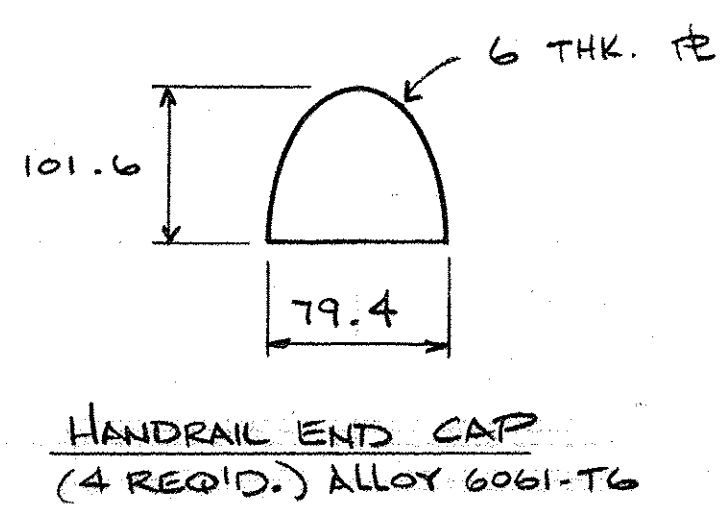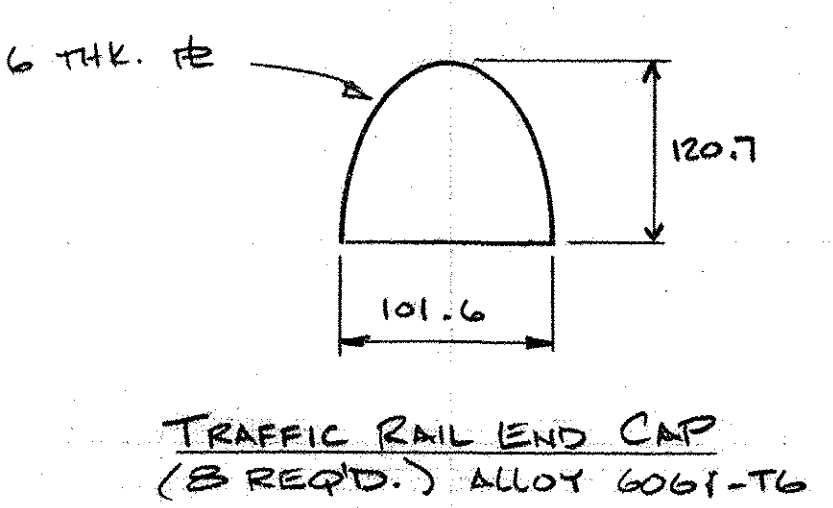

AUCIELLO IRON WORKS INC 560 MAIN ST. HUDSON, MA (978) 568-8382	
VT. AGENCY OF TRANSPORTATION BRATTLEBORO #BRF 2000(21)S BRIDGE #30 T.H. 10 OVER WHETSTONE BROOK	
ALUM. BRIDGE & APPROACH RAILING	
SURFACE PREP: NONE	FINISH: BLACK ANODIZE
FOR: F.R. LAFAYETTE, INC DR: 2-15-2010 DWG. NO. CHR: 2/5/10 BR-2978	
1 ISSUE DATE: 4/5/10	FOR APPROVAL DESCRIPTION: <i>BR-2978</i> BY: <i>WE</i>
JOB NO. AB07025-1001 SHEET F3 OF 5	