


10+010.00

*Begin of approach
Begin Cold Plane*

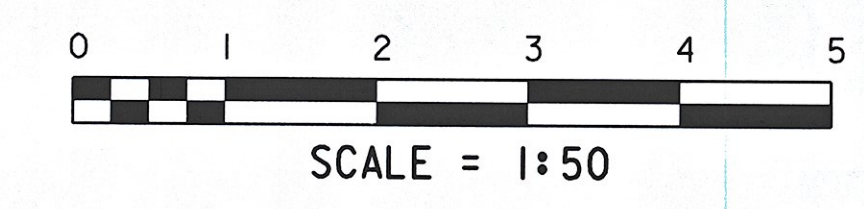

STA. 10+010 TO STA. 10+010

STA. 10+010.000
BEGIN APPROACH
MATCH EXISTING

PROJECT NAME:	BRATTLEBORRO	PLOT DATE:	16-FEB-2010
PROJECT NUMBER:	BRF 2000(2)S	DRAWN BY:	C. MOONEY
FILE NAME:	96J228/str/sj228xs_const.dgn	DESIGNED BY:	D. PETERSON
		CHECKED BY:	C. CARLSON
		ML X-SECTION 01 - (MOD.)	SHEET <i>xs1</i> OF 33