


10+015.00

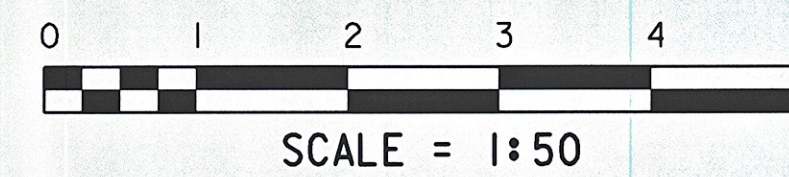

STA. 10+015 TO STA. 10+015

PROJECT NAME:	BRATTLEBORO	PLOT DATE:	16-FEB-2010
PROJECT NUMBER:	BRF 2000(2)S	DRAWN BY:	C. MOONEY
FILE NAME:	96J228/str/sj228xs.const.dgn	CHECKED BY:	C. CARLSON
PROJECT LEADER:	C. CARLSON	ML X-SECTION 02 - (MOD.)	SHEET 2 OF 33
DESIGNED BY:	D. PETERSON		