


10+025.00

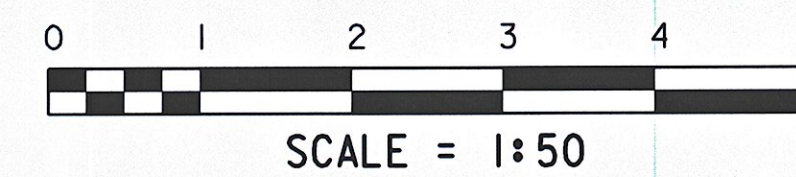

STA. 10+025 TO STA. 10+025

PROJECT NAME:	BRATTLEBORRO	PLOT DATE:	16-FEB-2010
PROJECT NUMBER:	BRF 2000(2)S	DRAWN BY:	C. MOONEY
FILE NAME:	96J228/str/sj228xs_const.dgn	CHECKED BY:	C. CARLSON
DESIGNED BY:	D. PETERSON	SHEET	4 OF 33
ML X-SECTION 04 - (MOD.)			