


~~STA. 10+030.000~~
~~BEGIN CONCRETE CURB LT.~~

10+030.00

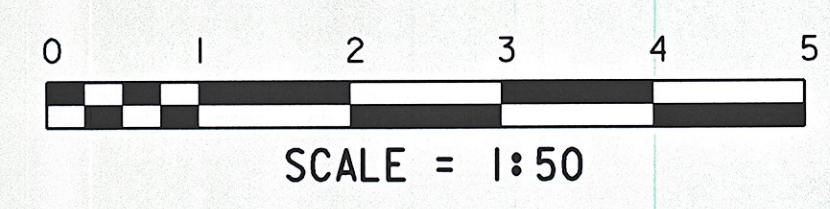

STA. 10+030 TO STA. 10+030

PROJECT NAME:	BRATTLEBORRO	PLOT DATE:	16-FEB-2010
PROJECT NUMBER:	BRF 2000(2)S	DRAWN BY:	C. MOONEY
FILE NAME:	96J228/str/sj228xs.const.dgn	CHECKED BY:	C. CARLSON
PROJECT LEADER:	C. CARLSON	SHEET	5 OF 33
DESIGNED BY:	D. PETERSON		
ML X-SECTION 05 - (MOD.)			