



$\frac{25}{1000} = 0.025$ factor

Calculation: $1.99 = 5.0$
 Error: $1.121 = 3.0$
 (1.1) 1.121

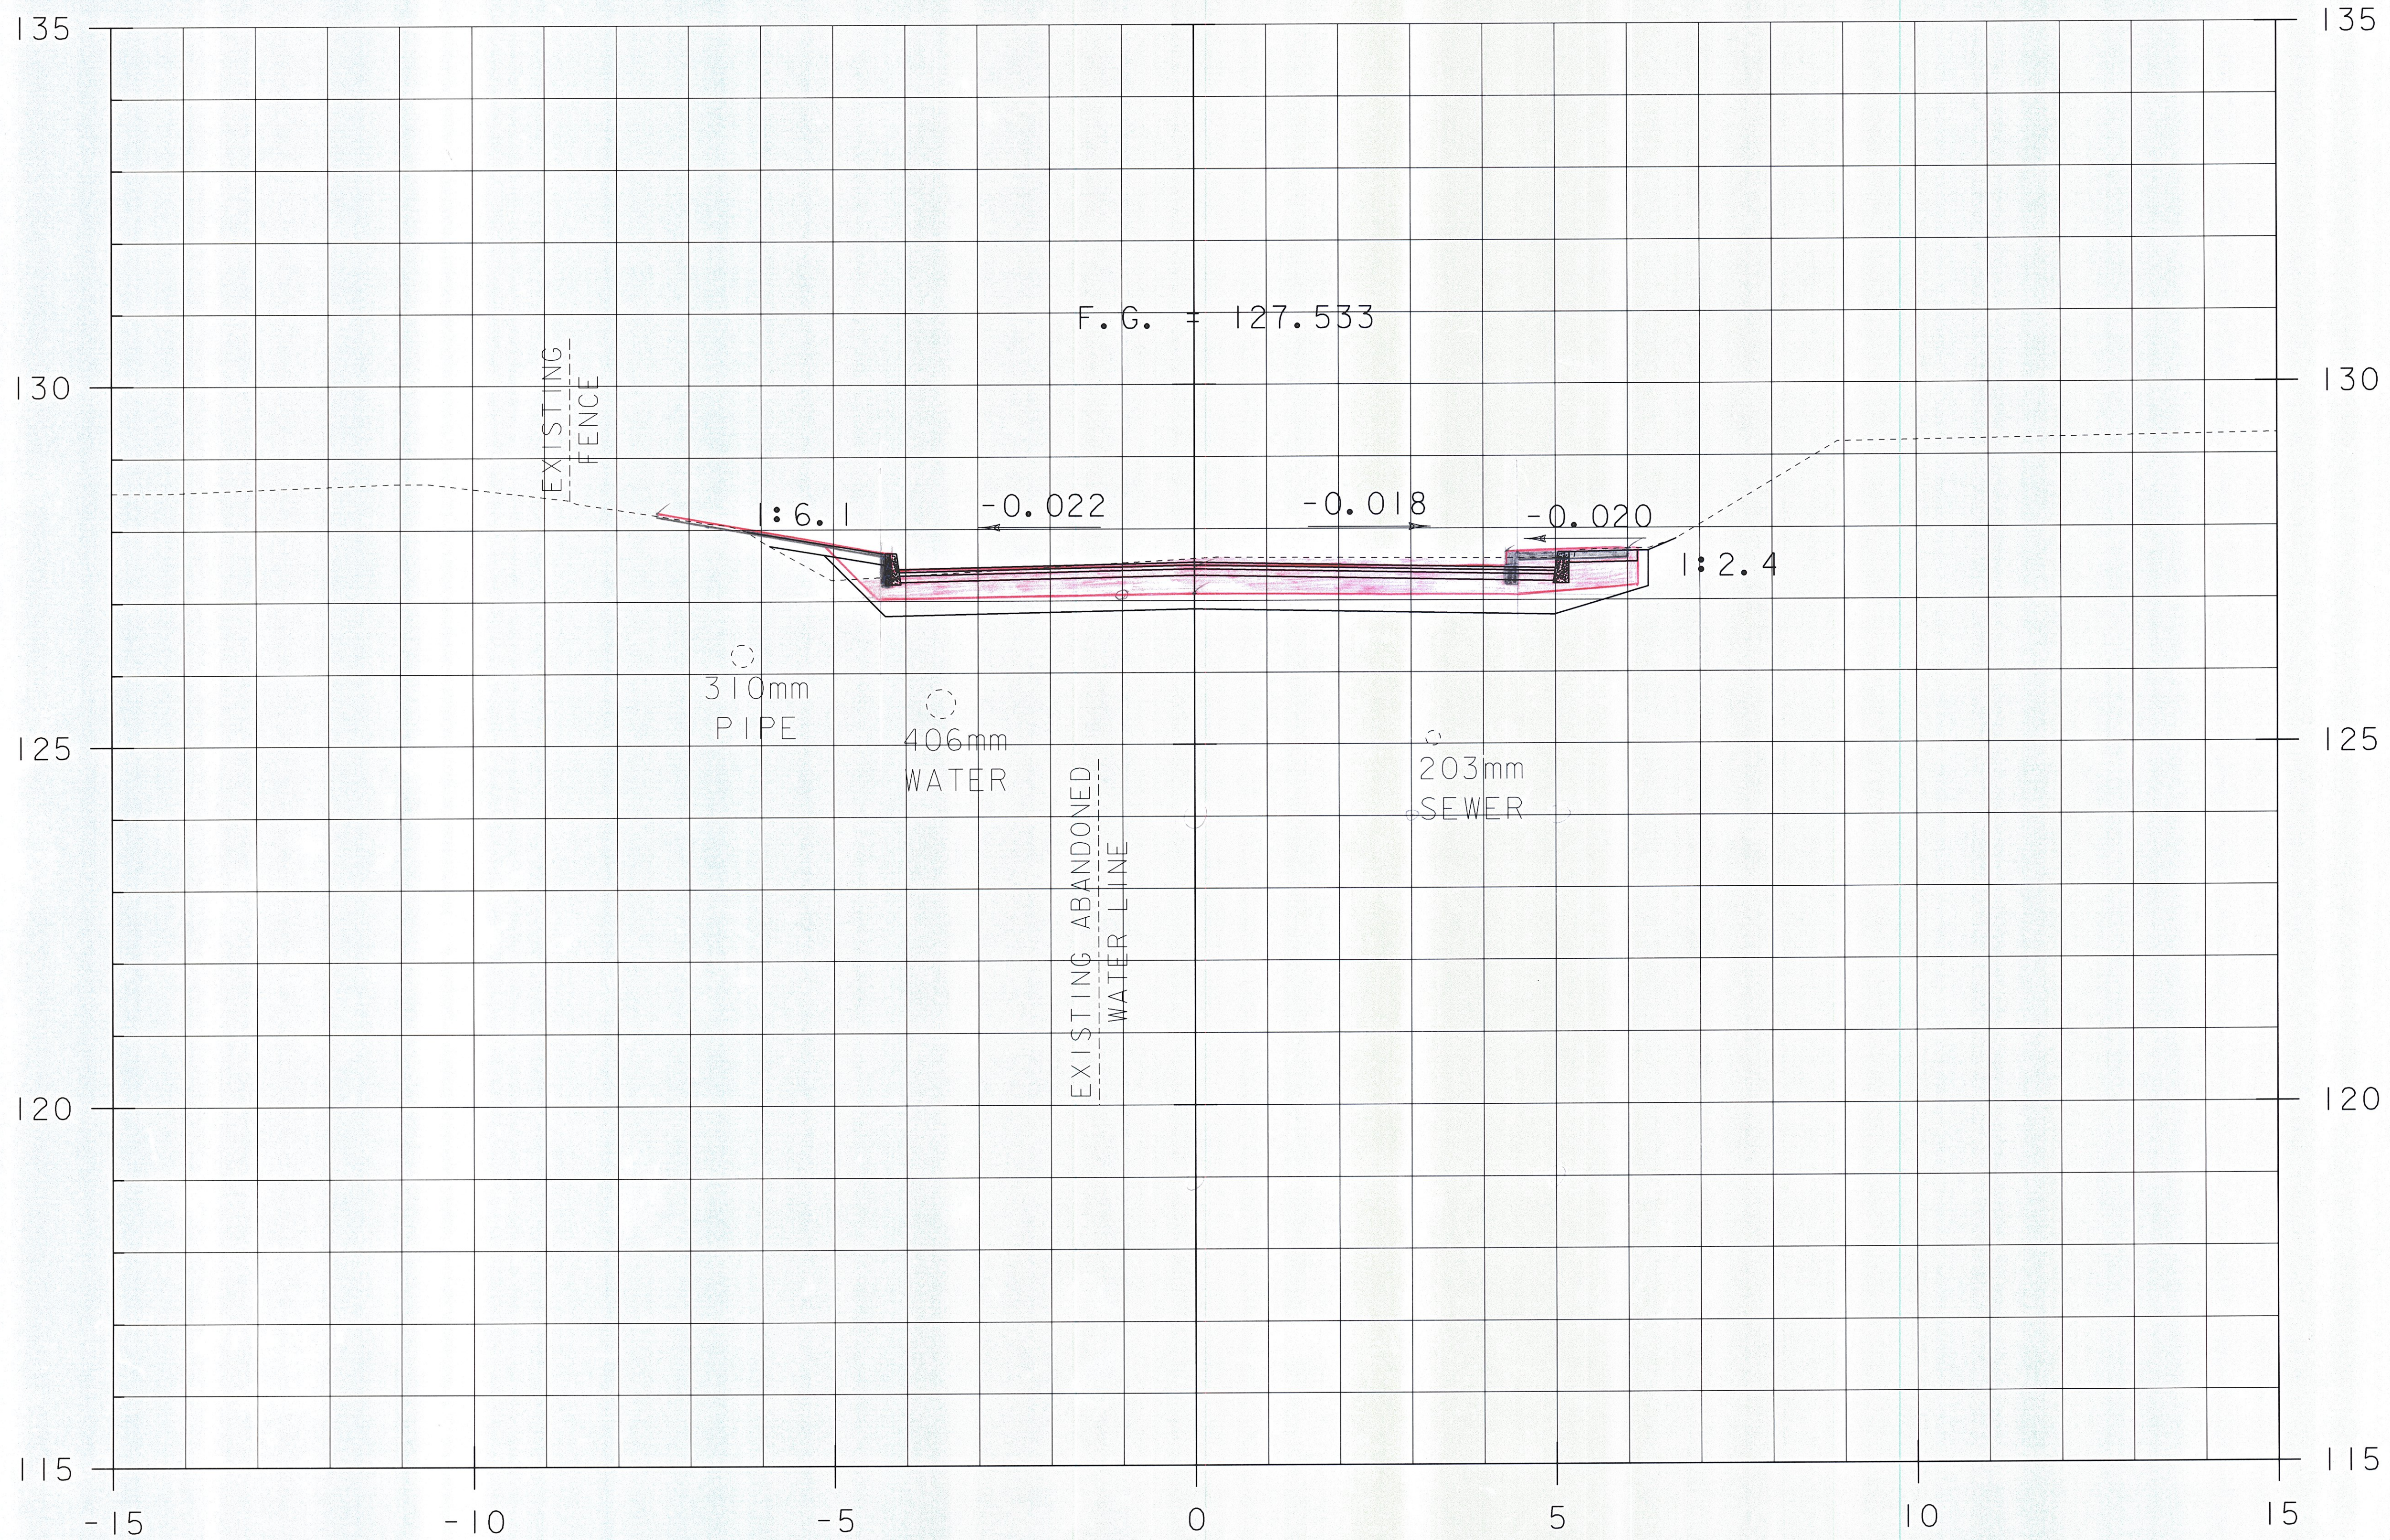

10+035.00

Start Excavation (Butt)
 End Cold Plane
 Start Gravel (Butt)

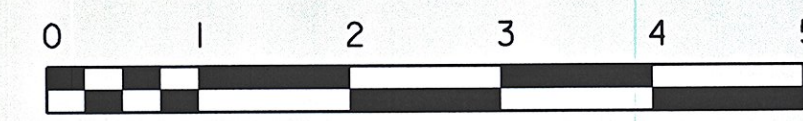

SCALE = 1:50

STA. 10+035 TO STA. 10+035

PROJECT NAME:	BRATTLEBORRO	FILE NAME:	96J228/str/sj228xs.const.dgn	PLOT DATE:	16-FEB-2010
PROJECT NUMBER:	BRF 2000(2)S	PROJECT LEADER:	C. CARLSON	DRAWN BY:	C. MOONEY
		DESIGNED BY:	D. PETERSON	CHECKED BY:	C. CARLSON
		ML X-SECTION 06 - (MOD.)		SHEET	6 OF 33