


Common = 218 = 5.5
 Ground = 152 = 3.8
 ✓ Mill 1-13-10


333
 1.8
 513

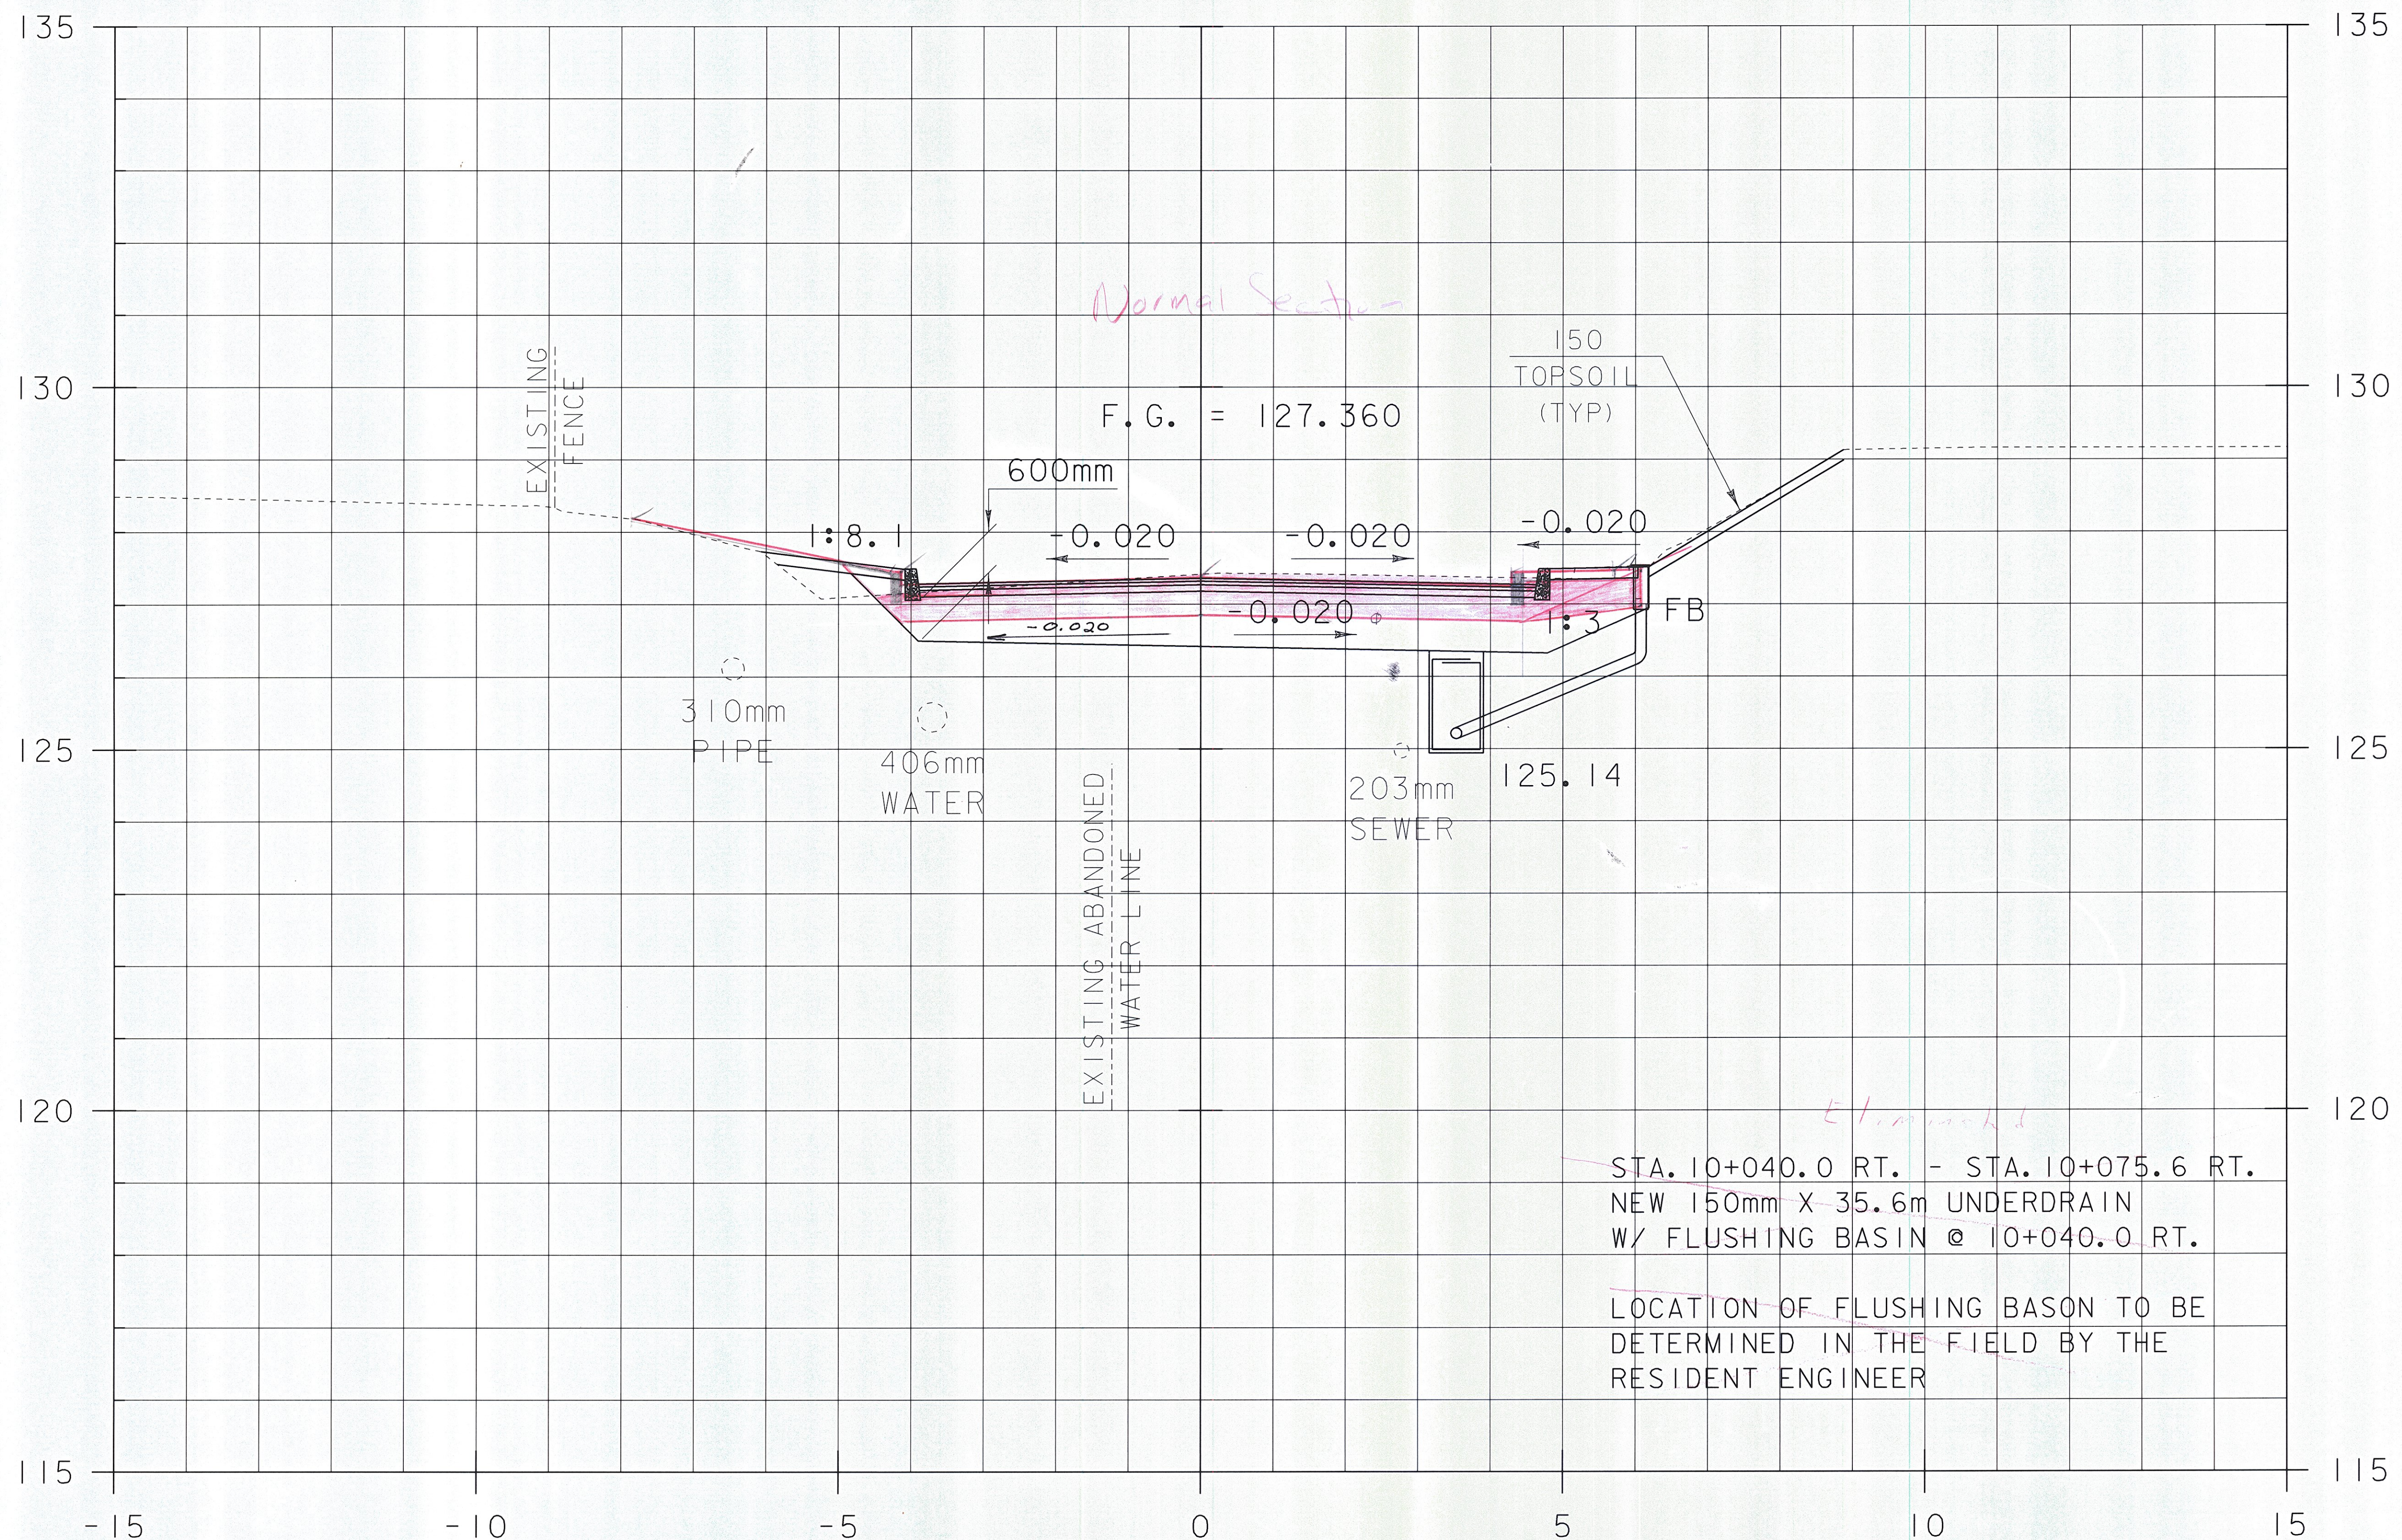

Eliminated
 STA. 10+040.0 RT. - STA. 10+075.6 RT.
 NEW 150mm X 35.6m UNDERDRAIN
 W/ FLUSHING BASIN @ 10+040.0 RT.
 LOCATION OF FLUSHING BASIN TO BE
 DETERMINED IN THE FIELD BY THE
 RESIDENT ENGINEER

10+040.00

STA. 10+040.000
 END APPROACH
 BEGIN PROJECT

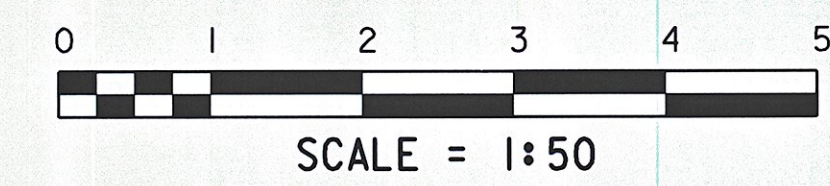

STA. 10+040 TO STA. 10+040

PROJECT NAME:	BRATTLEBORO	FILE NAME:	96J228/str/sj228xs_const.dgn	PLOT DATE:	16-FEB-2010
PROJECT NUMBER:	BRF 2000(2)S	PROJECT LEADER:	C. CARLSON	DRAWN BY:	C. MOONEY
		DESIGNED BY:	D. PETERSON	CHECKED BY:	C. CARLSON
		ML X-SECTION 07 - (MOD.)		SHEET	7 OF 33