


10+045.00

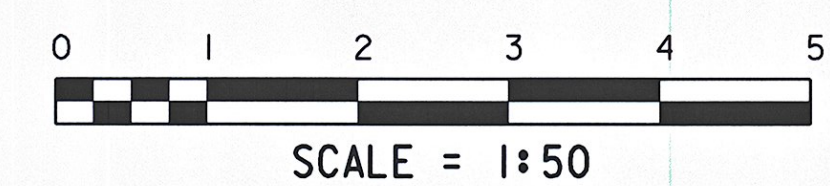

STA. 10+045 TO STA. 10+045

PROJECT NAME:	BRATTLEBORRO	FILE NAME:	96J228/str/sj228xs_const.dgn	PLOT DATE:	16-FEB-2010
PROJECT NUMBER:	BRF 2000(2)S	PROJECT LEADER:	C. CARLSON	DRAWN BY:	C. MOONEY
		DESIGNED BY:	D. PETERSON	CHECKED BY:	C. CARLSON
		ML X-SECTION 08 - (MOD.)		SHEET	8 OF 33