



Common = 307 = 7.7 ✓
 Gravel = 259 = 6.5 ✓
 Sand = 0 ✓
 ✓ PR. 10-13-10

120
 600
 700
 127.02
 - .78
 126.24

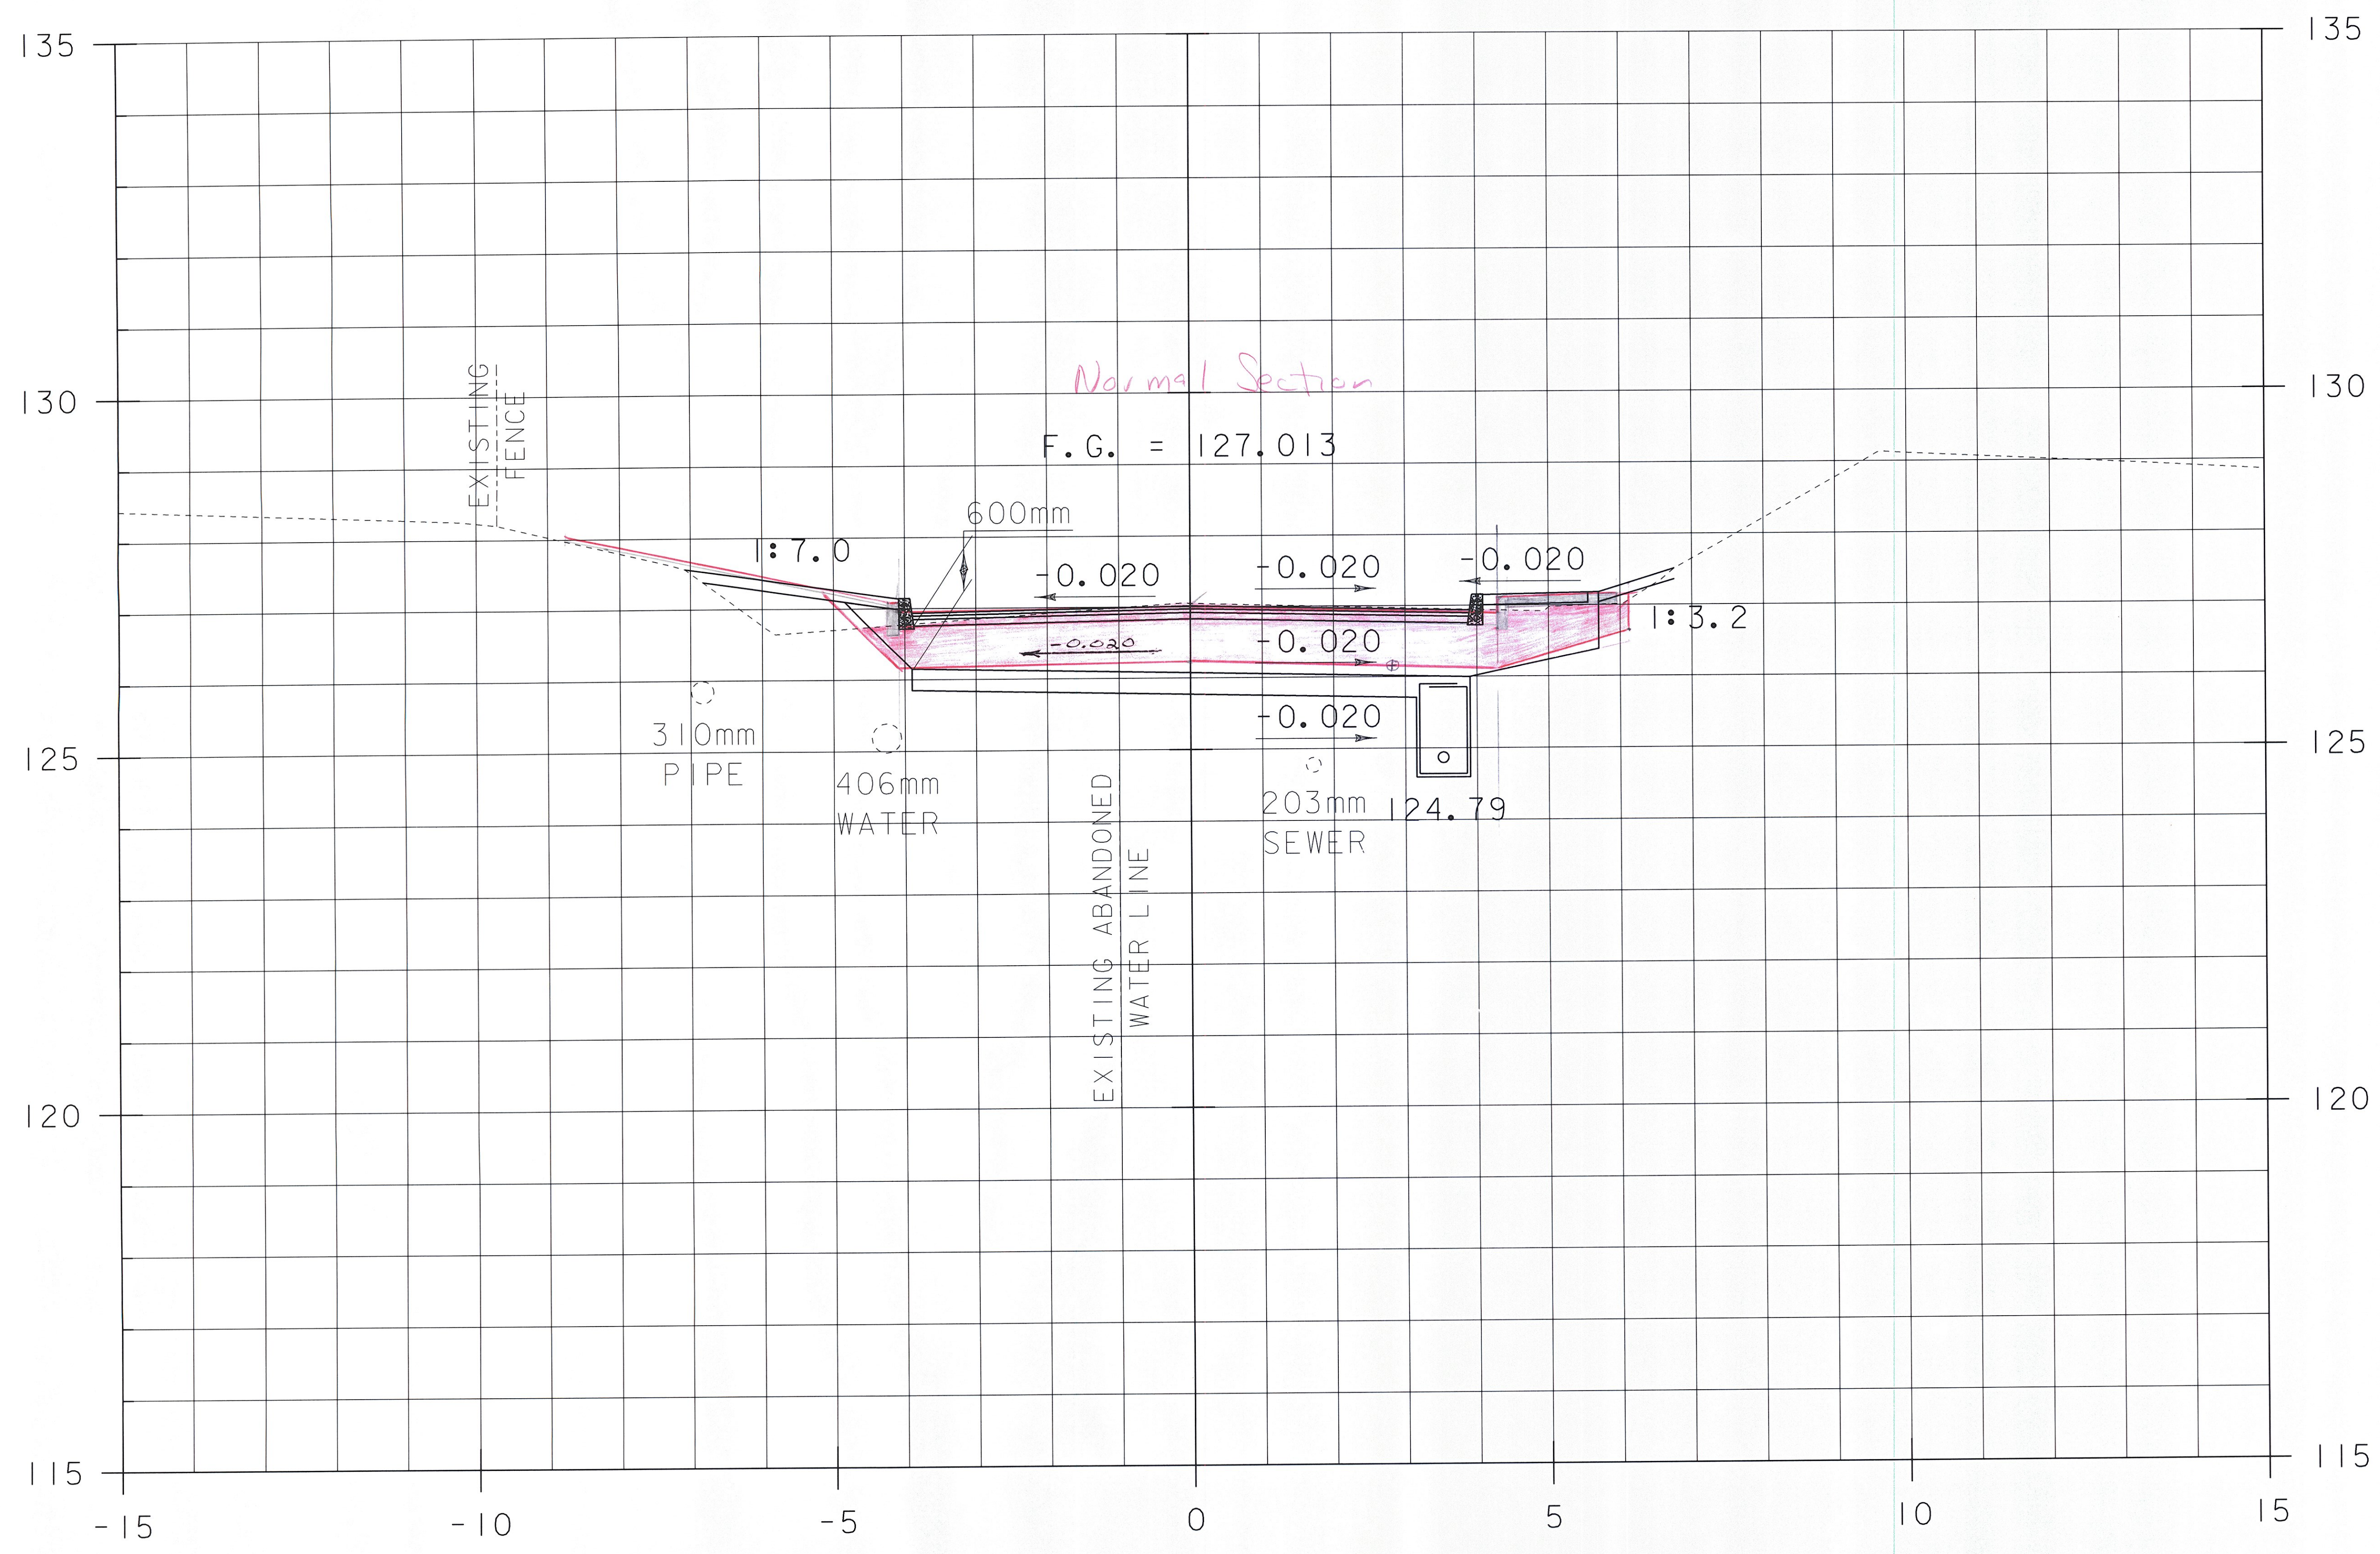

10+050.00
*Basin Sand Taper
 Gravel Fill Depth*

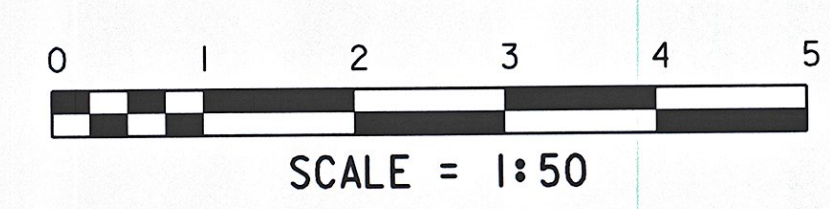

STA. 10+050 TO STA. 10+050

PROJECT NAME:	BRATTLEBORO	PLOT DATE:	16-FEB-2010
PROJECT NUMBER:	BRF 2000(2)S	DRAWN BY:	C. MOONEY
FILE NAME:	96J228/str/sj228xs_const.dgn	CHECKED BY:	C. CARLSON
PROJECT LEADER:	C. CARLSON	SHEET	9 OF 33
DESIGNED BY:	D. PETERSON		
ML X-SECTION 09 - (MOD.)			