



Concrete = 403 = 10.1 ✓
 Gravel = 282 = 7.1 ✓
 Sand (4.4+4.1) x 0.5 = 2.6 ✓
 ✓ x PC 10-13-10

1.18
 .6
 .3
 1.08
 126.88
 - 1.08
 125.80

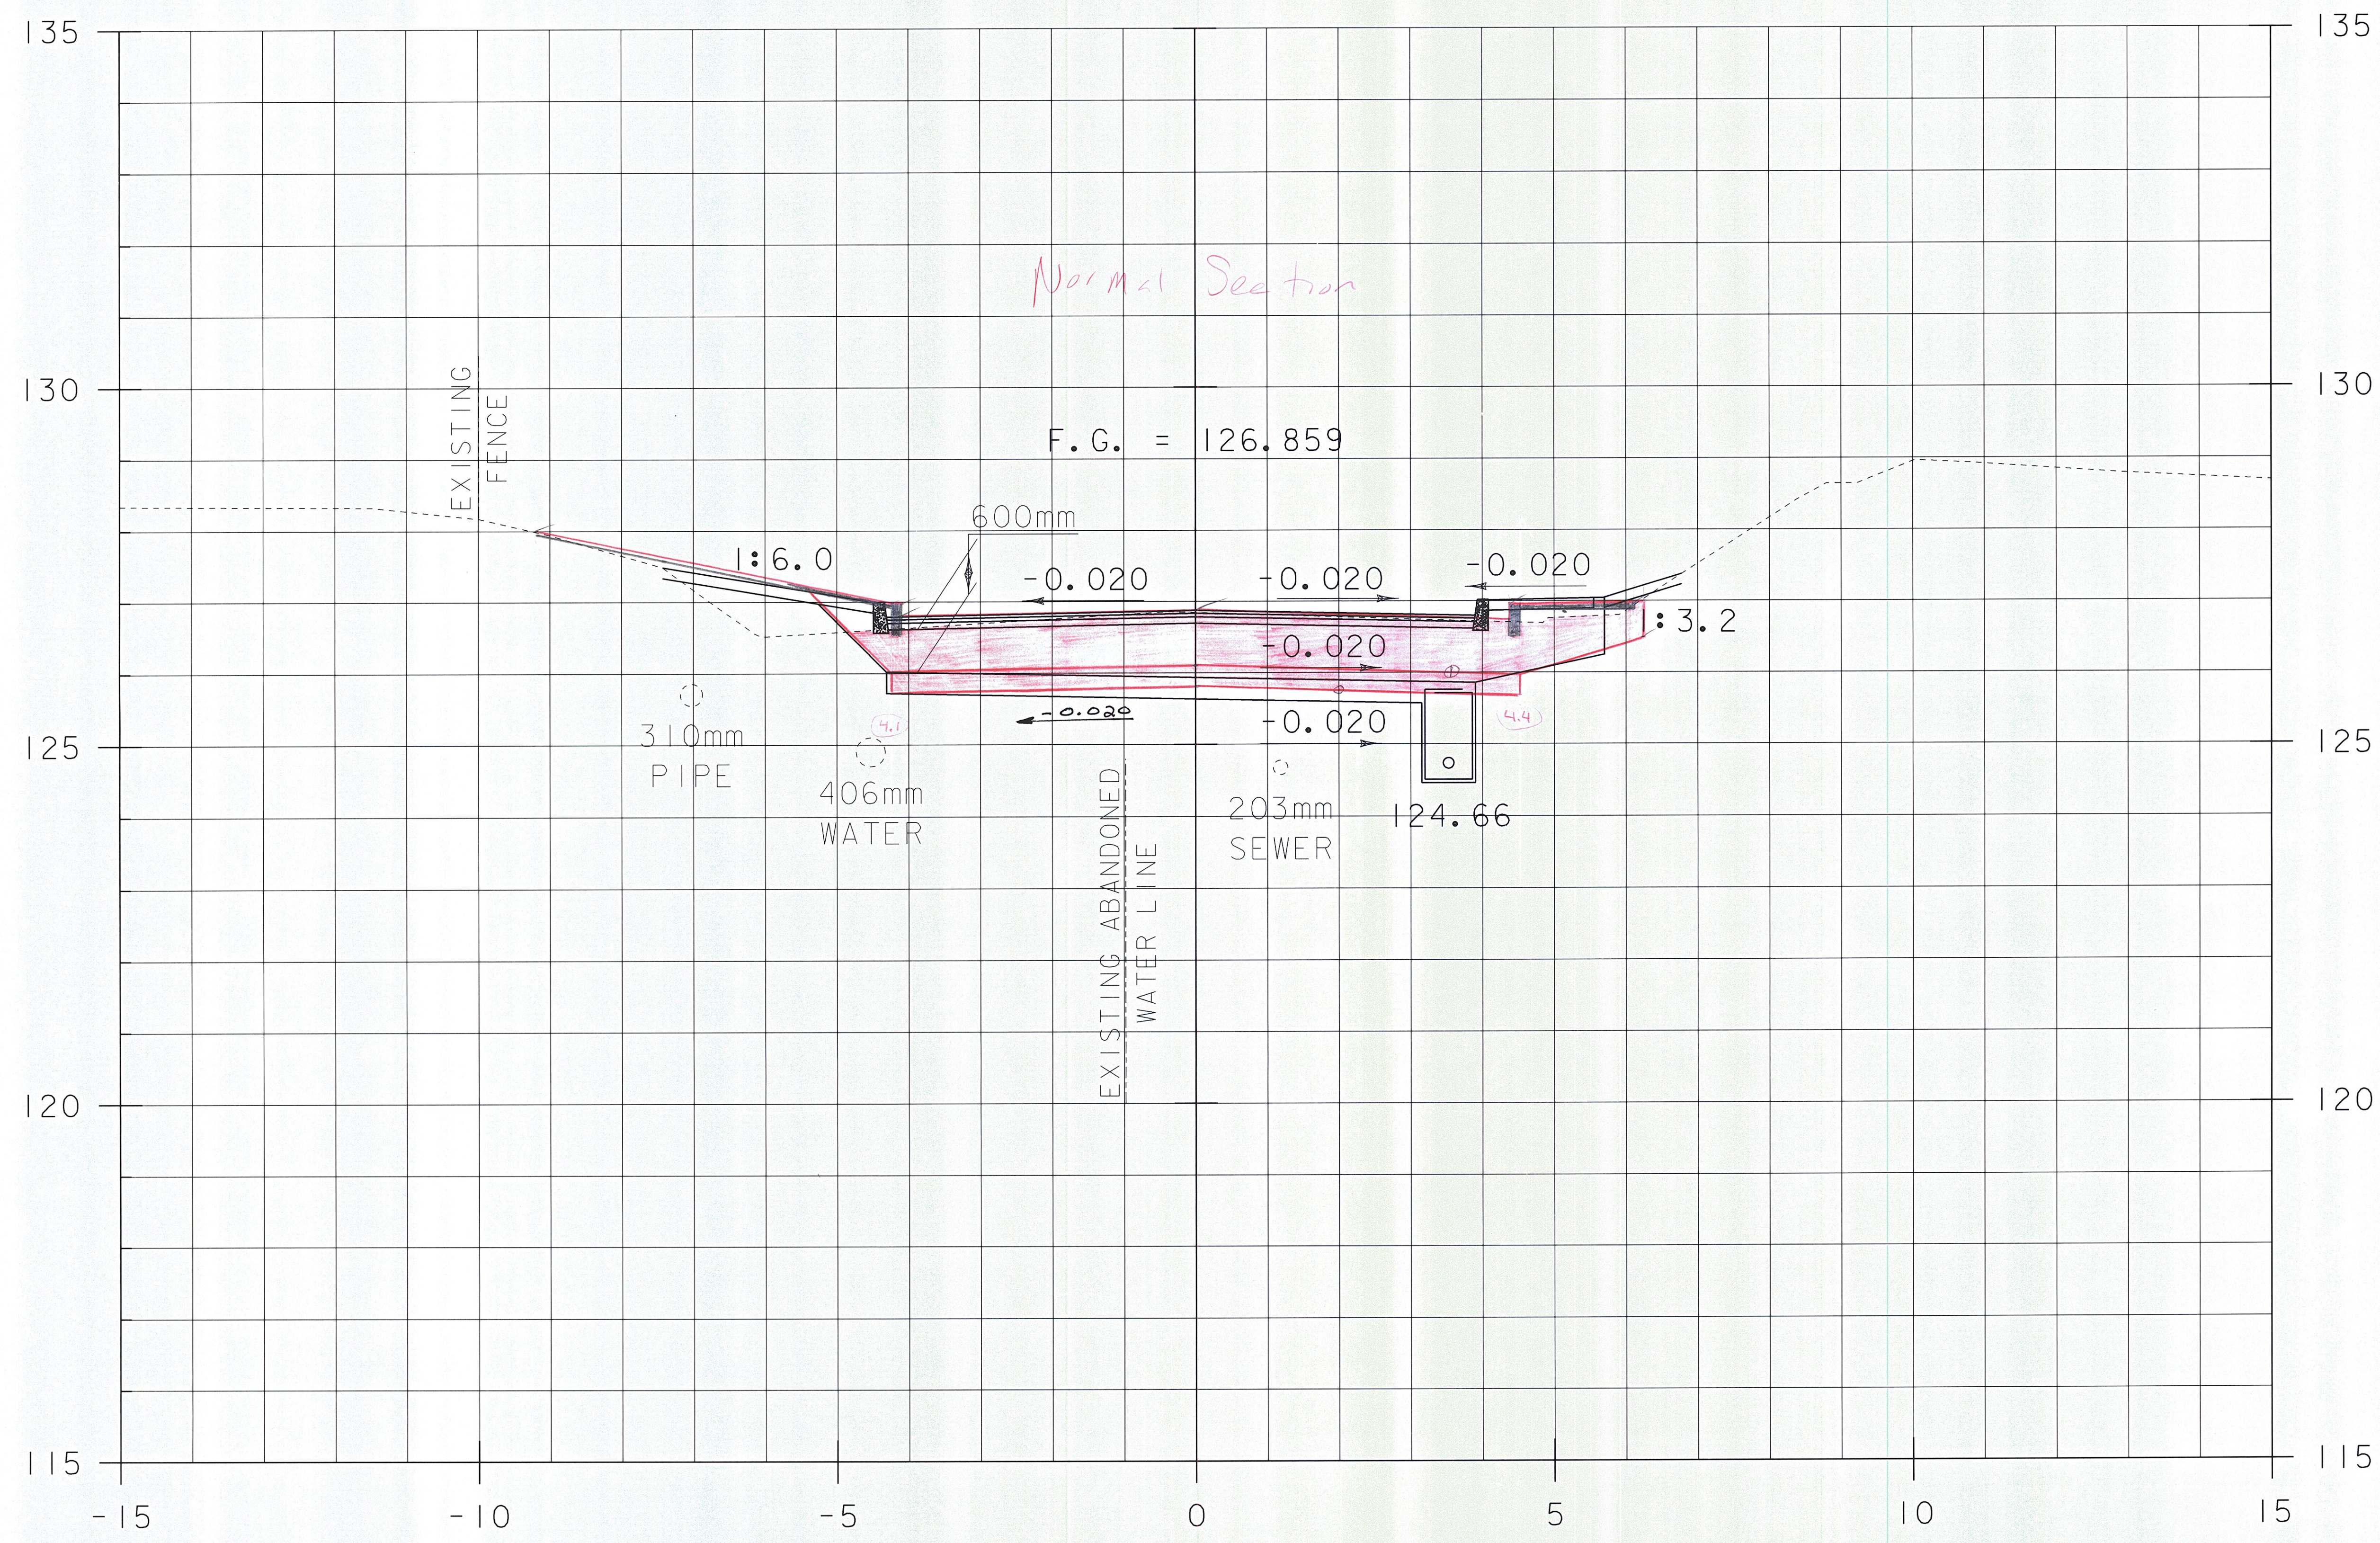

10+055.00
 Sand Full Depth

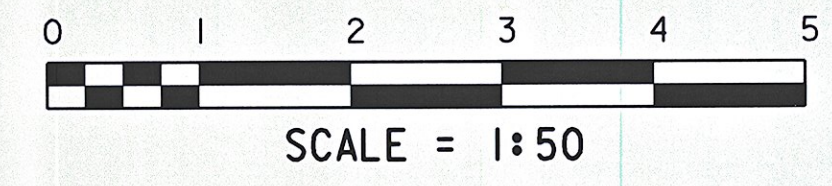

STA. 10+055 TO STA. 10+055

PROJECT NAME:	BRATTLEBORO	PLOT DATE:	16-FEB-2010
PROJECT NUMBER:	BRF 2000(2)S	DRAWN BY:	C. MOONEY
FILE NAME:	96J228/str/sj228xs.const.dgn	CHECKED BY:	C. CARLSON
PROJECT LEADER:	C. CARLSON	SHEET	10 OF 33
DESIGNED BY:	D. PETERSON		
ML X-SECTION 10 - (MOD.)			