



Common 344' = 2.6'
 Gravel 249' = 6.2' *for 10/13/10*
 Sand 0.3 x (400 + 4.3) = 2.5'
Rev 10-13-10

.12
 .6
 .3
 1.02
 176.76
 - 1.02
 175.62

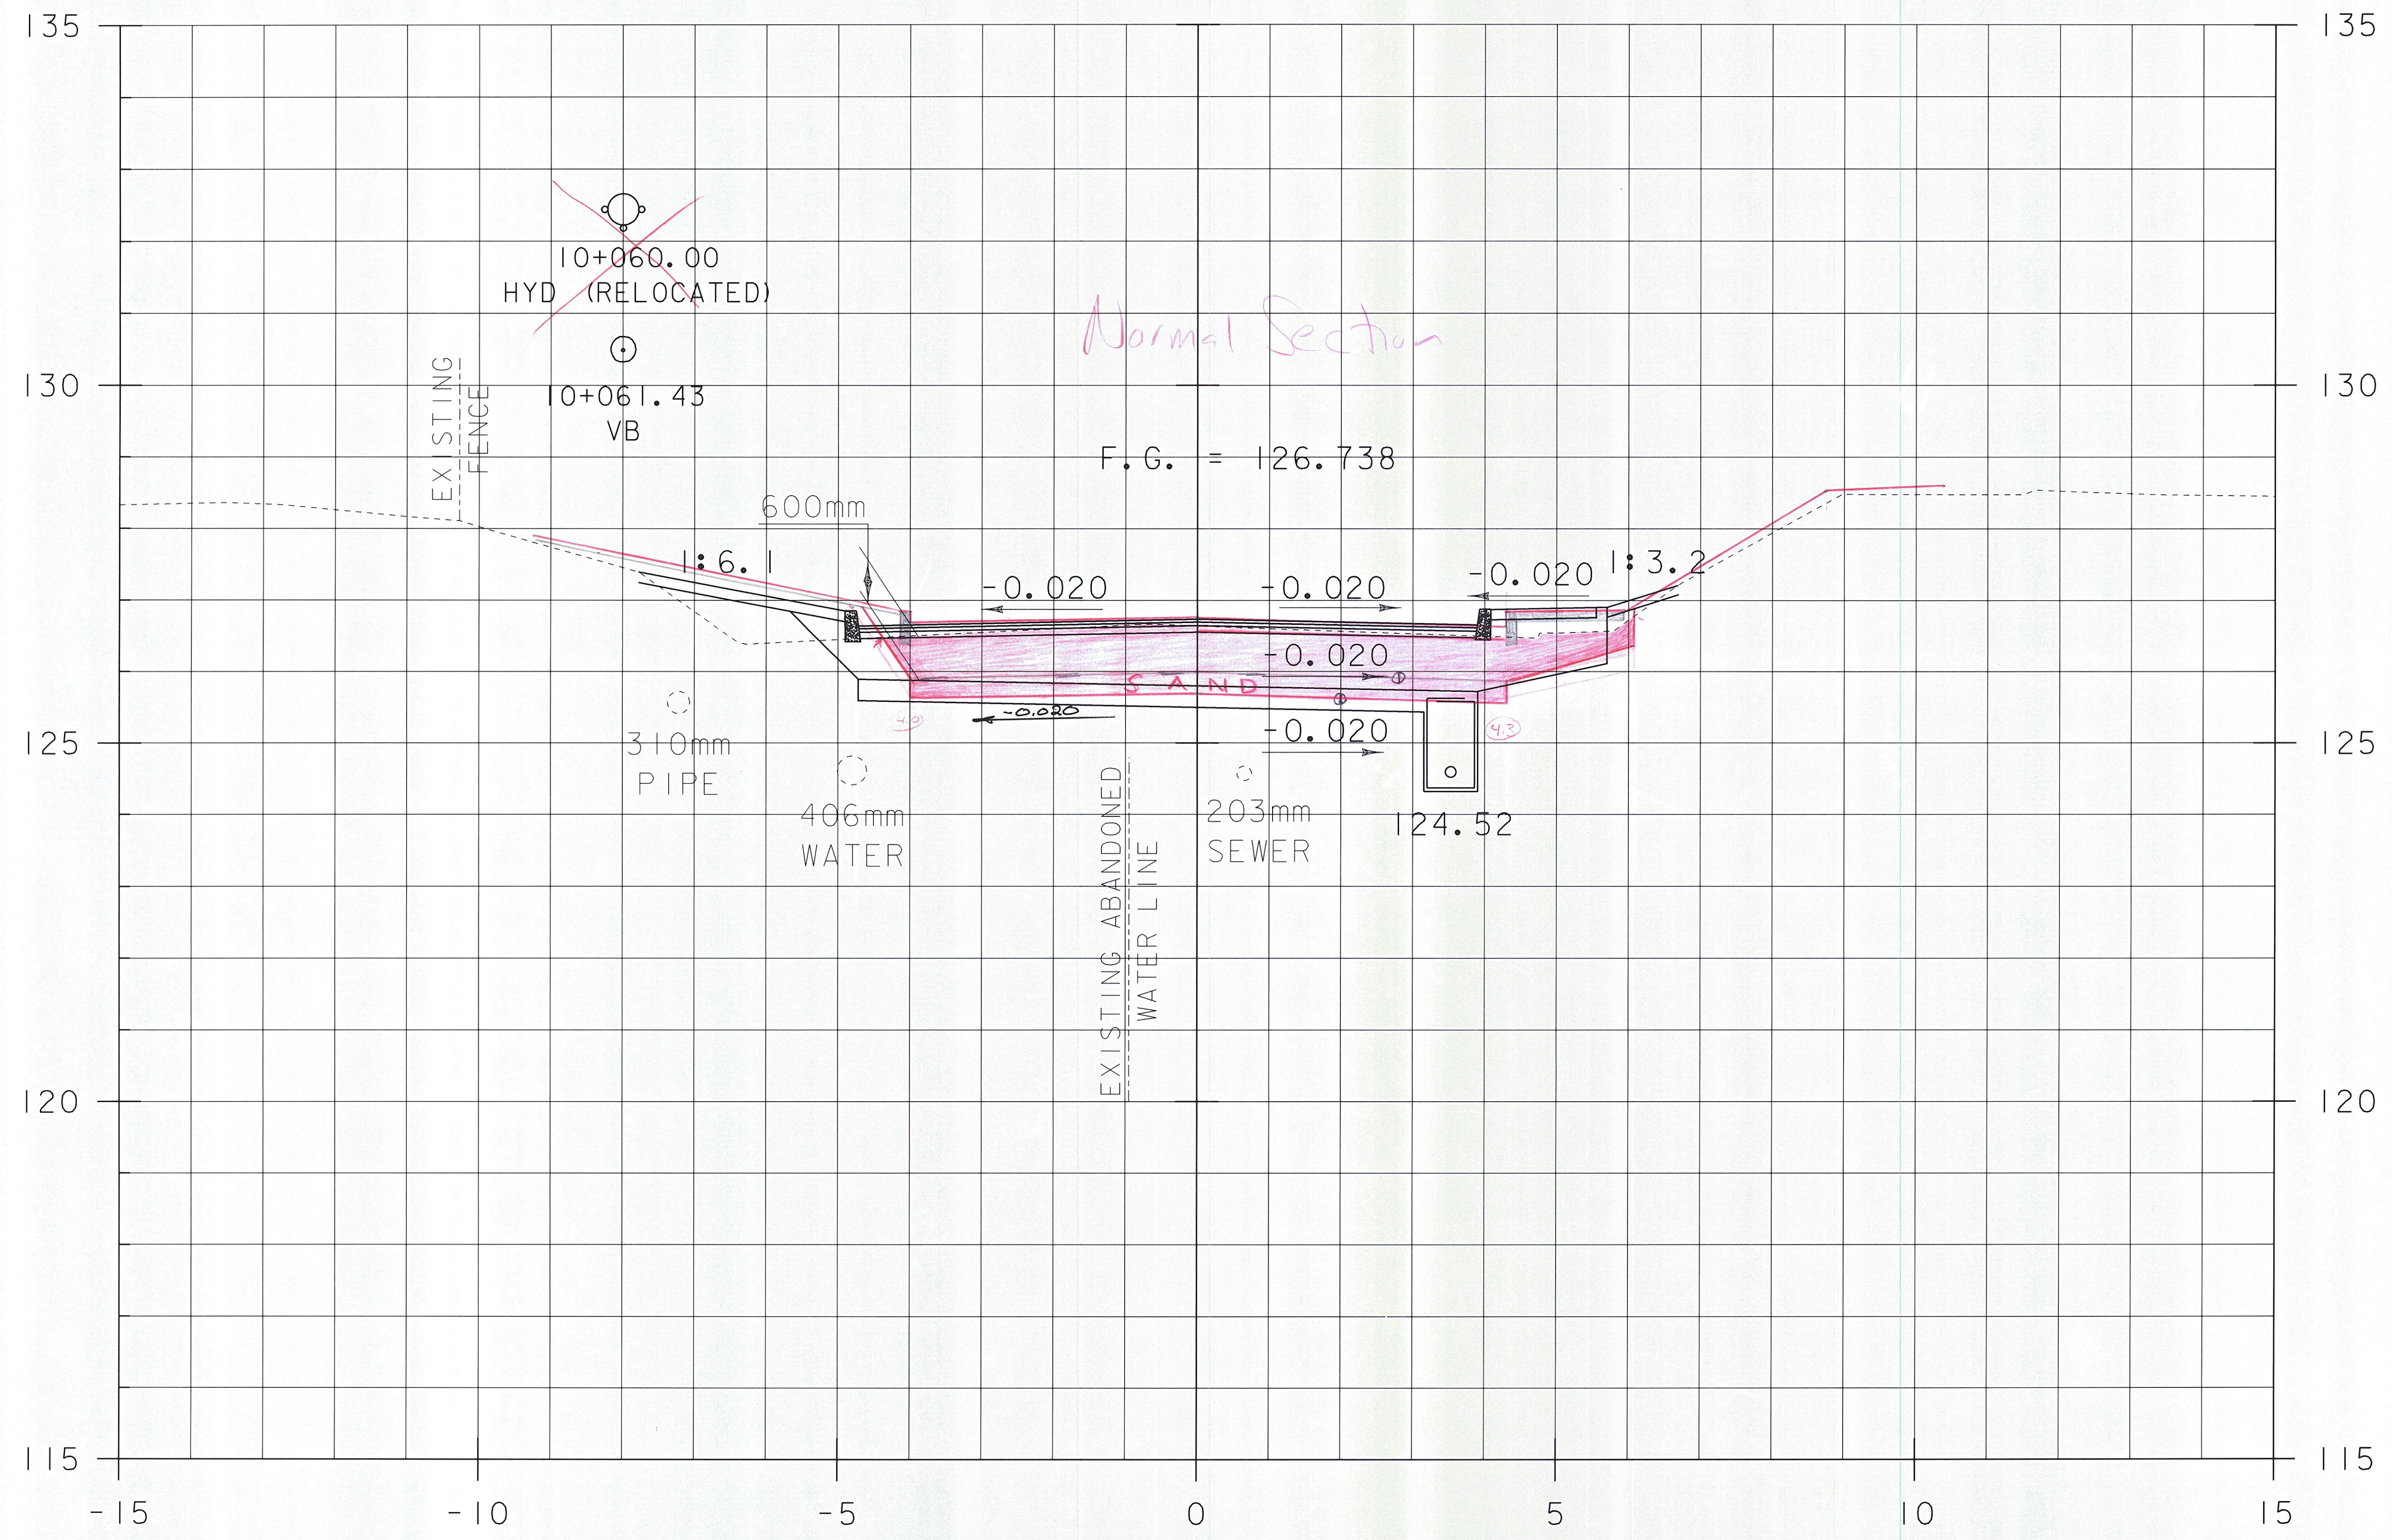

Normal Section

10+060.00

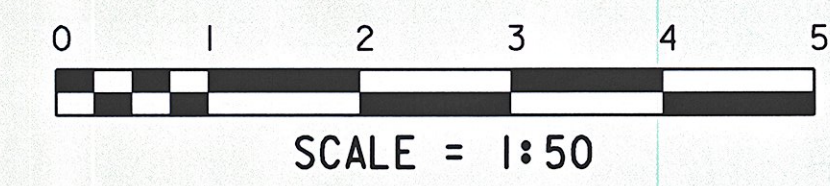

STA. 10+060 TO STA. 10+060

PROJECT NAME:	BRATTLEBORO	FILE NAME:	96J228/str/sj228xs_const.dgn	PLOT DATE:	16-FEB-2010
PROJECT NUMBER:	BRF 2000(2)S	PROJECT LEADER:	C. CARLSON	DRAWN BY:	C. MOONEY
		DESIGNED BY:	D. PETERSON	CHECKED BY:	C. CARLSON
		ML X-SECTION II - (MOD.)		SHEET	II OF 33