


Common 341' = 2.5'  
 Gravel 267' = 4.7'  
 Sand 0.3 x (40 + 4.4) = 2.5'  
 / Rev 10-13-10

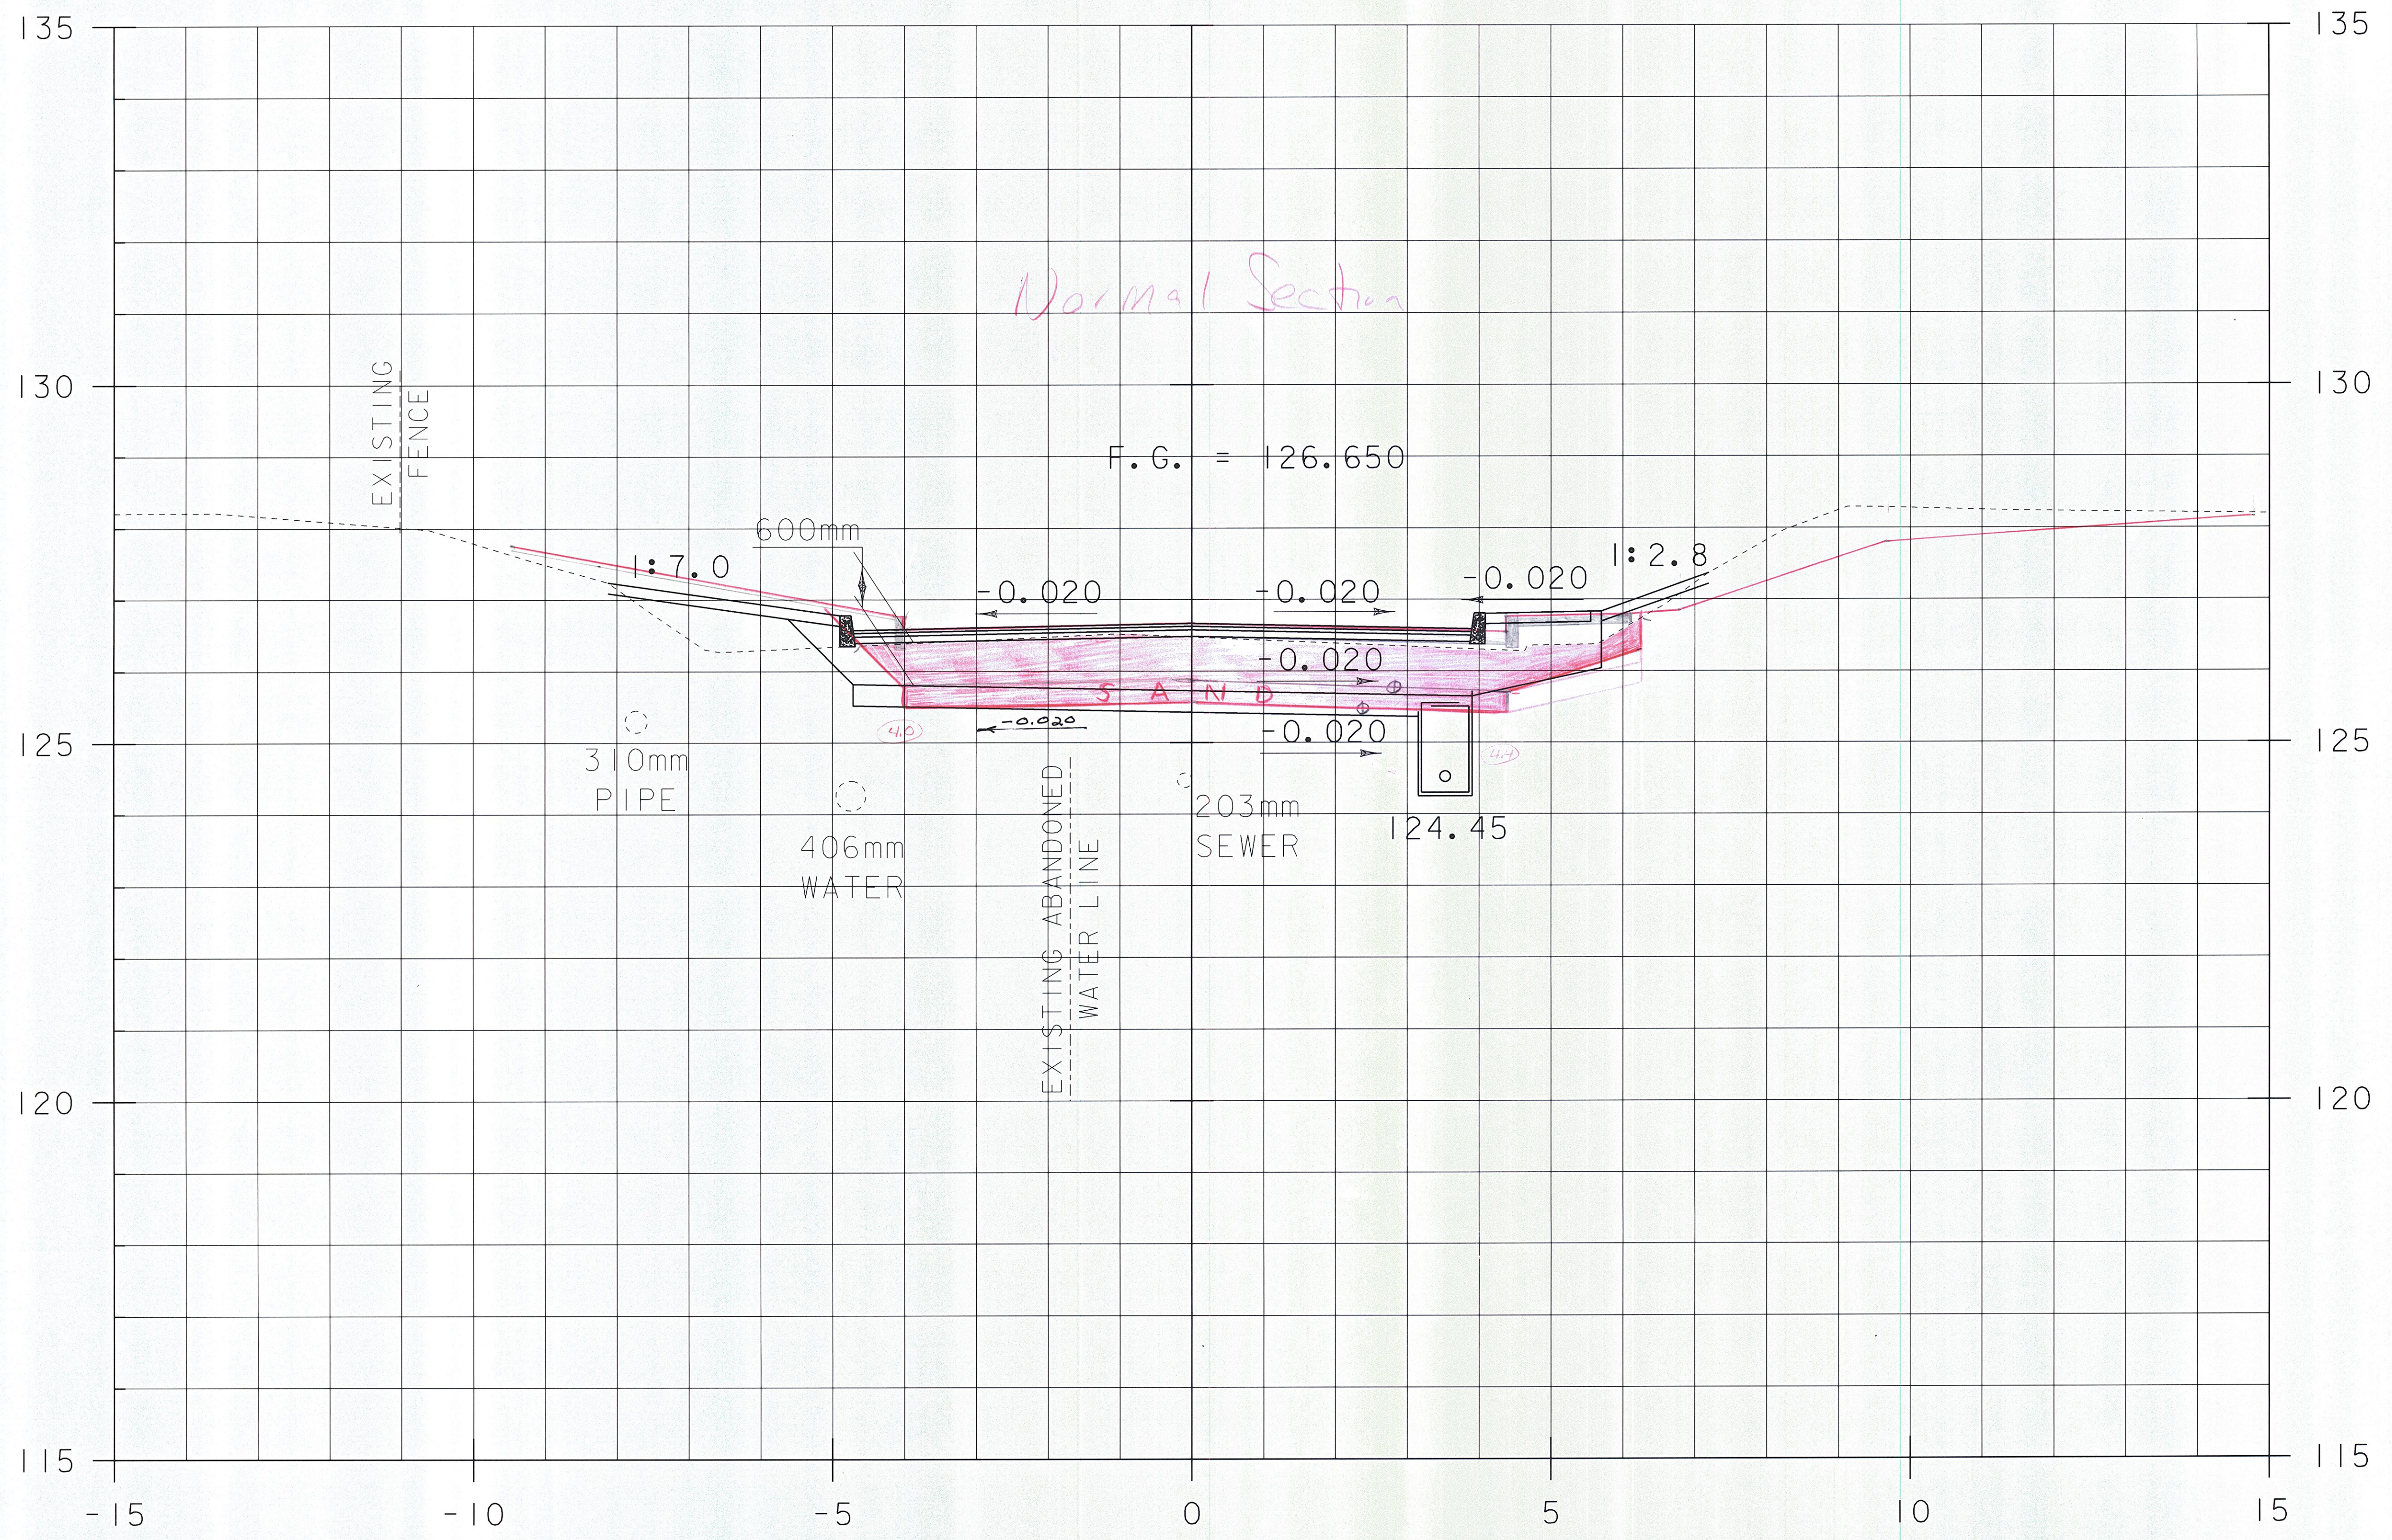

Normal Section

F.G. = 126.650

EXISTING FENCE

310mm PIPE


406mm WATER

EXISTING ABANDONED WATER LINE

203mm SEWER

124.45

10+065.00

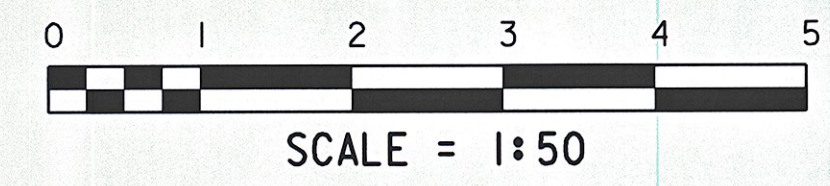

STA. 10+065 TO STA. 10+065

PROJECT NAME:	BRATTLEBORO
PROJECT NUMBER:	BRF 2000(2)S
FILE NAME:	96J228/str/sj228xs_const.dgn
PROJECT LEADER:	C. CARLSON
DESIGNED BY:	D. PETERSON
ML X-SECTION 12 - (MOD.)	
PLOT DATE:	16-FEB-2010
DRAWN BY:	C. MOONEY
CHECKED BY:	C. CARLSON
SHEET	12 OF 33