


Common 298 = 7.5  
 gravel 248 = 6.2  
 Sand 5.3 x (4.5 + 4.0) = 2.9  
 4.0 x 2 = 8.0

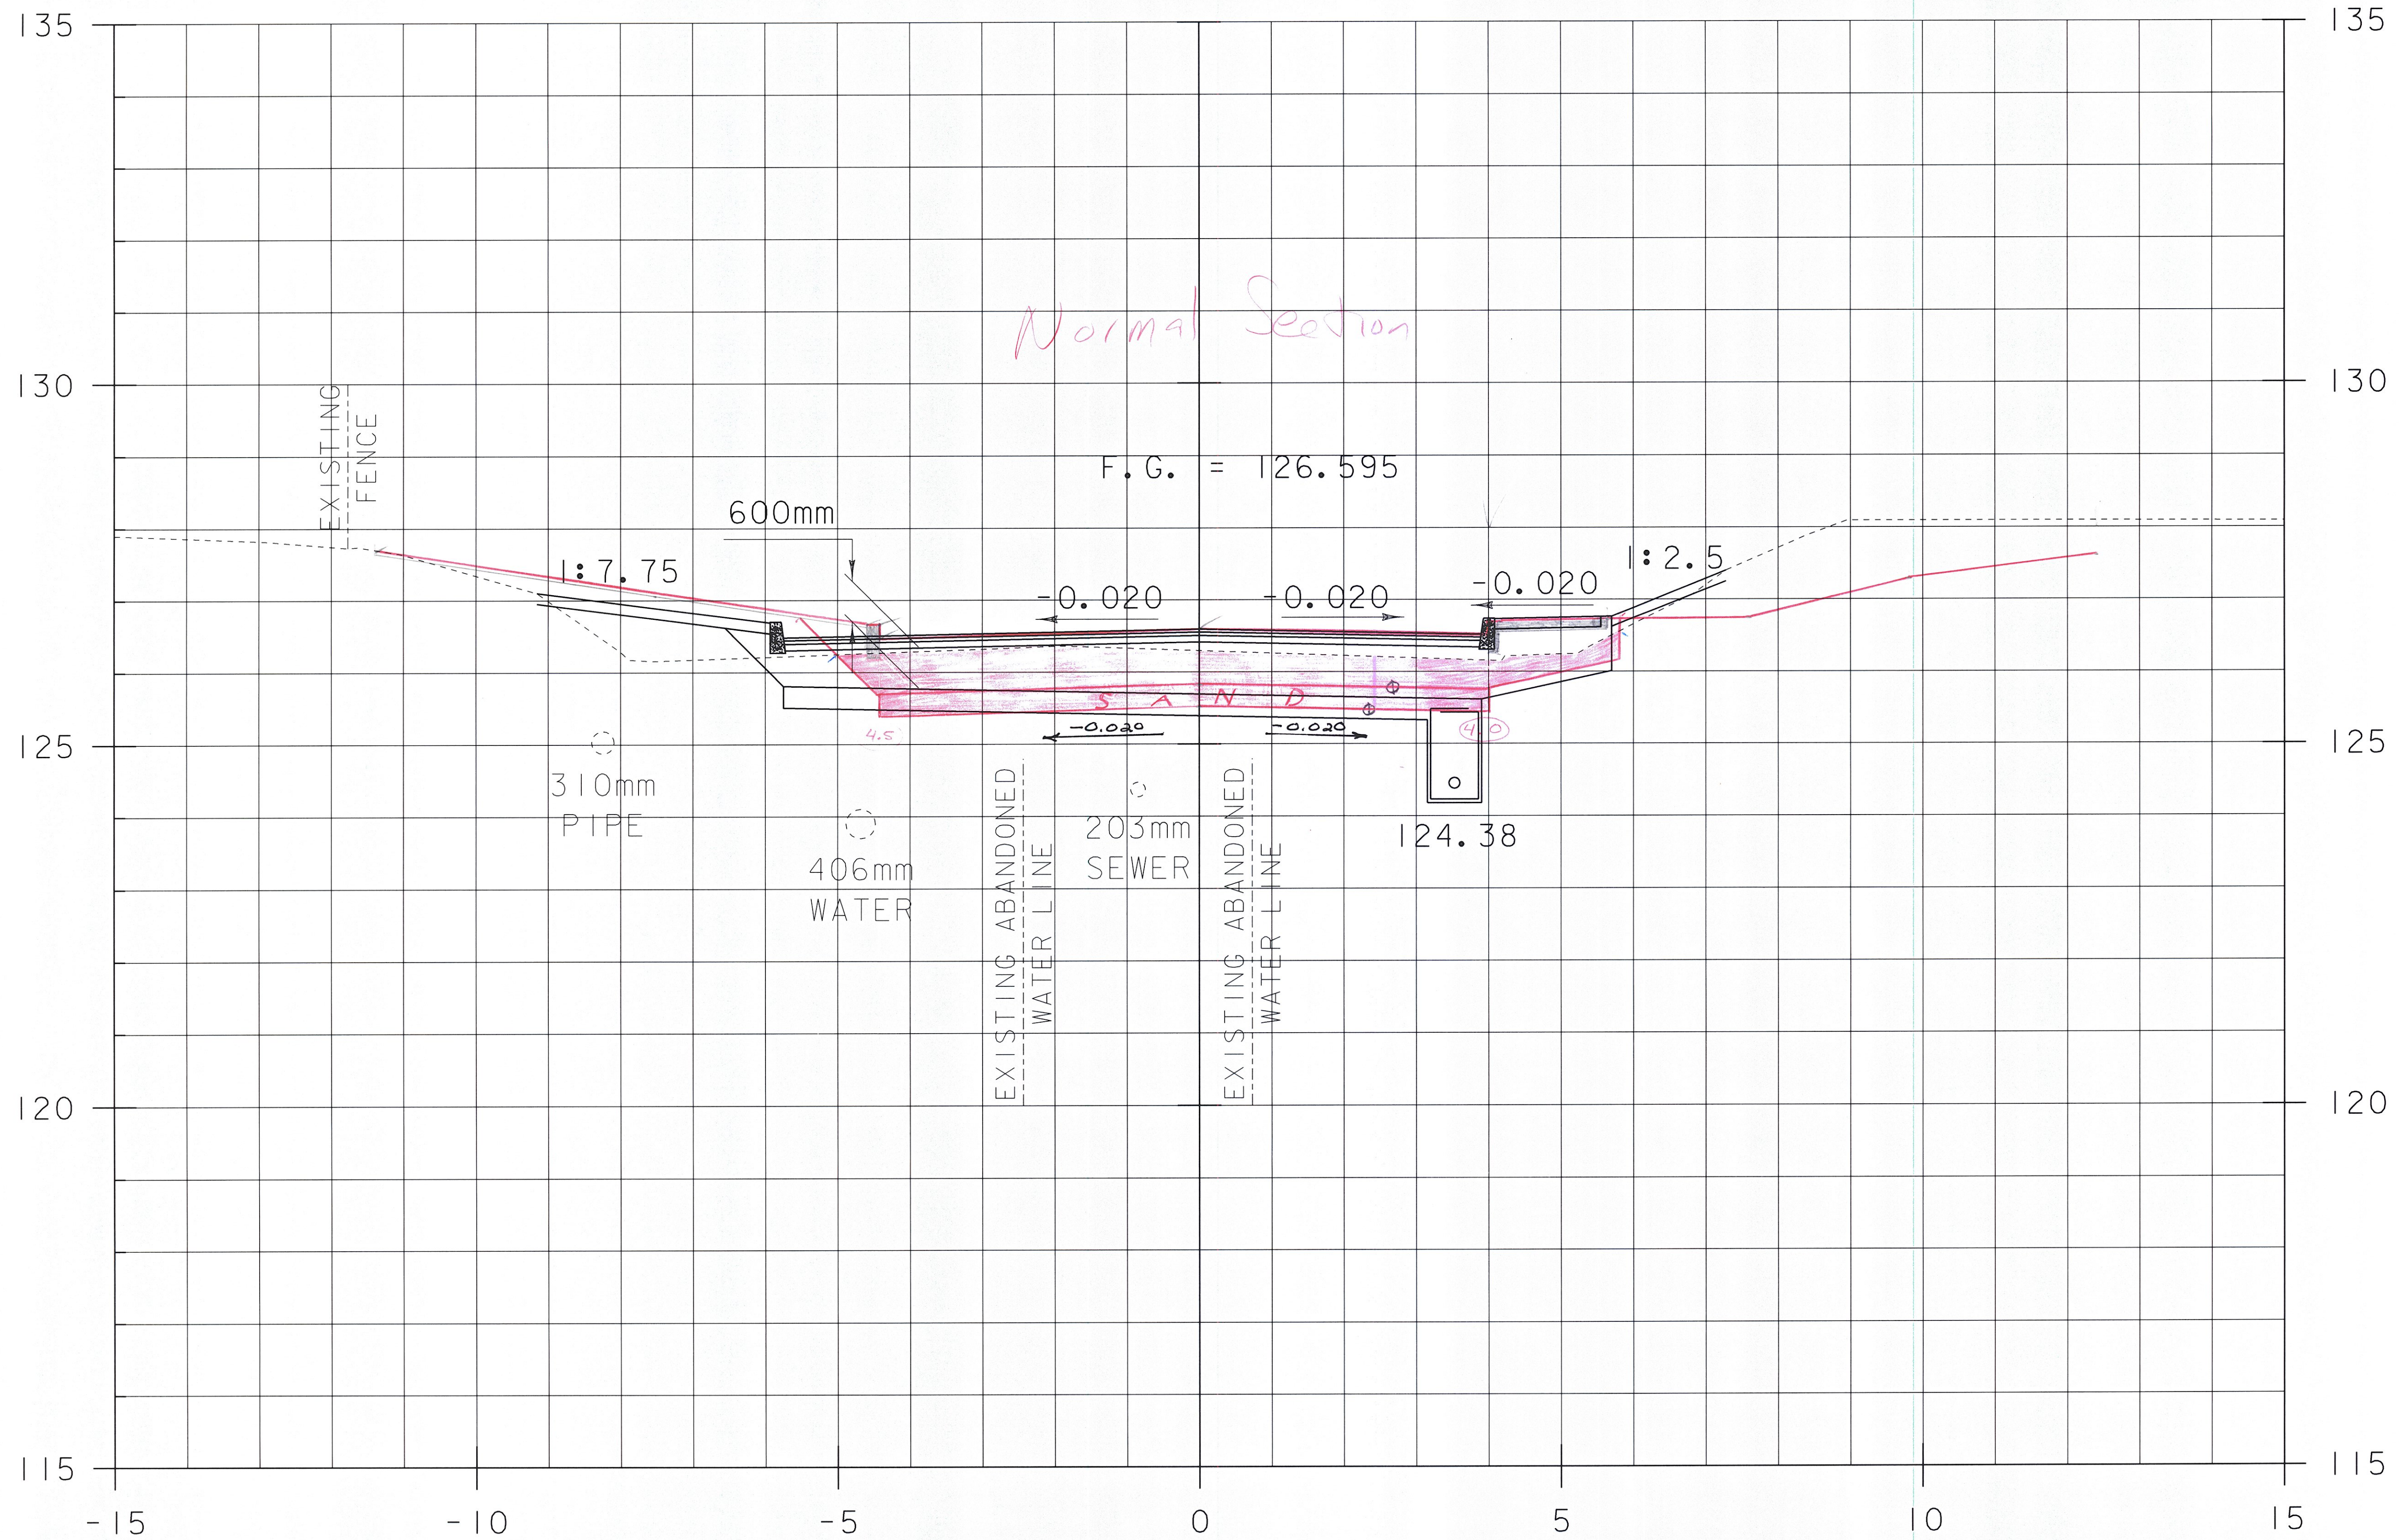

Normal Section


F.G. = 126.595

SAND

EXISTING ABANDONED WATER LINE

EXISTING ABANDONED WATER LINE

10+070.00

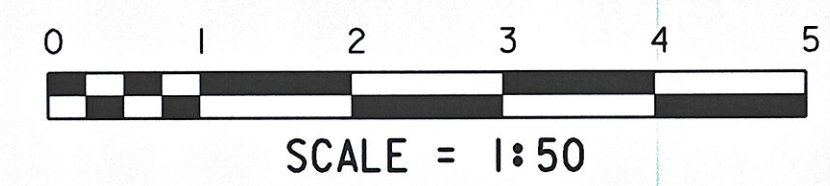

STA. 10+070 TO STA. 10+070

PROJECT NAME:	BRATTLEBORO
PROJECT NUMBER:	BRF 2000(2)S
FILE NAME:	96J228/str/sj228xs_const.dgn
PROJECT LEADER:	C. CARLSON
DESIGNED BY:	D. PETERSON
ML X-SECTION 13 - (MOD.)	
PLOT DATE:	16-FEB-2010
DRAWN BY:	C. MOONEY
CHECKED BY:	C. CARLSON
SHEET	13 OF 33