


Common 475 = 11.9'
 gravel 313 = 7.8'
 Sand 0.3 x (6.2 + 4.2) = 3.3'
 PRJ 10-13-10

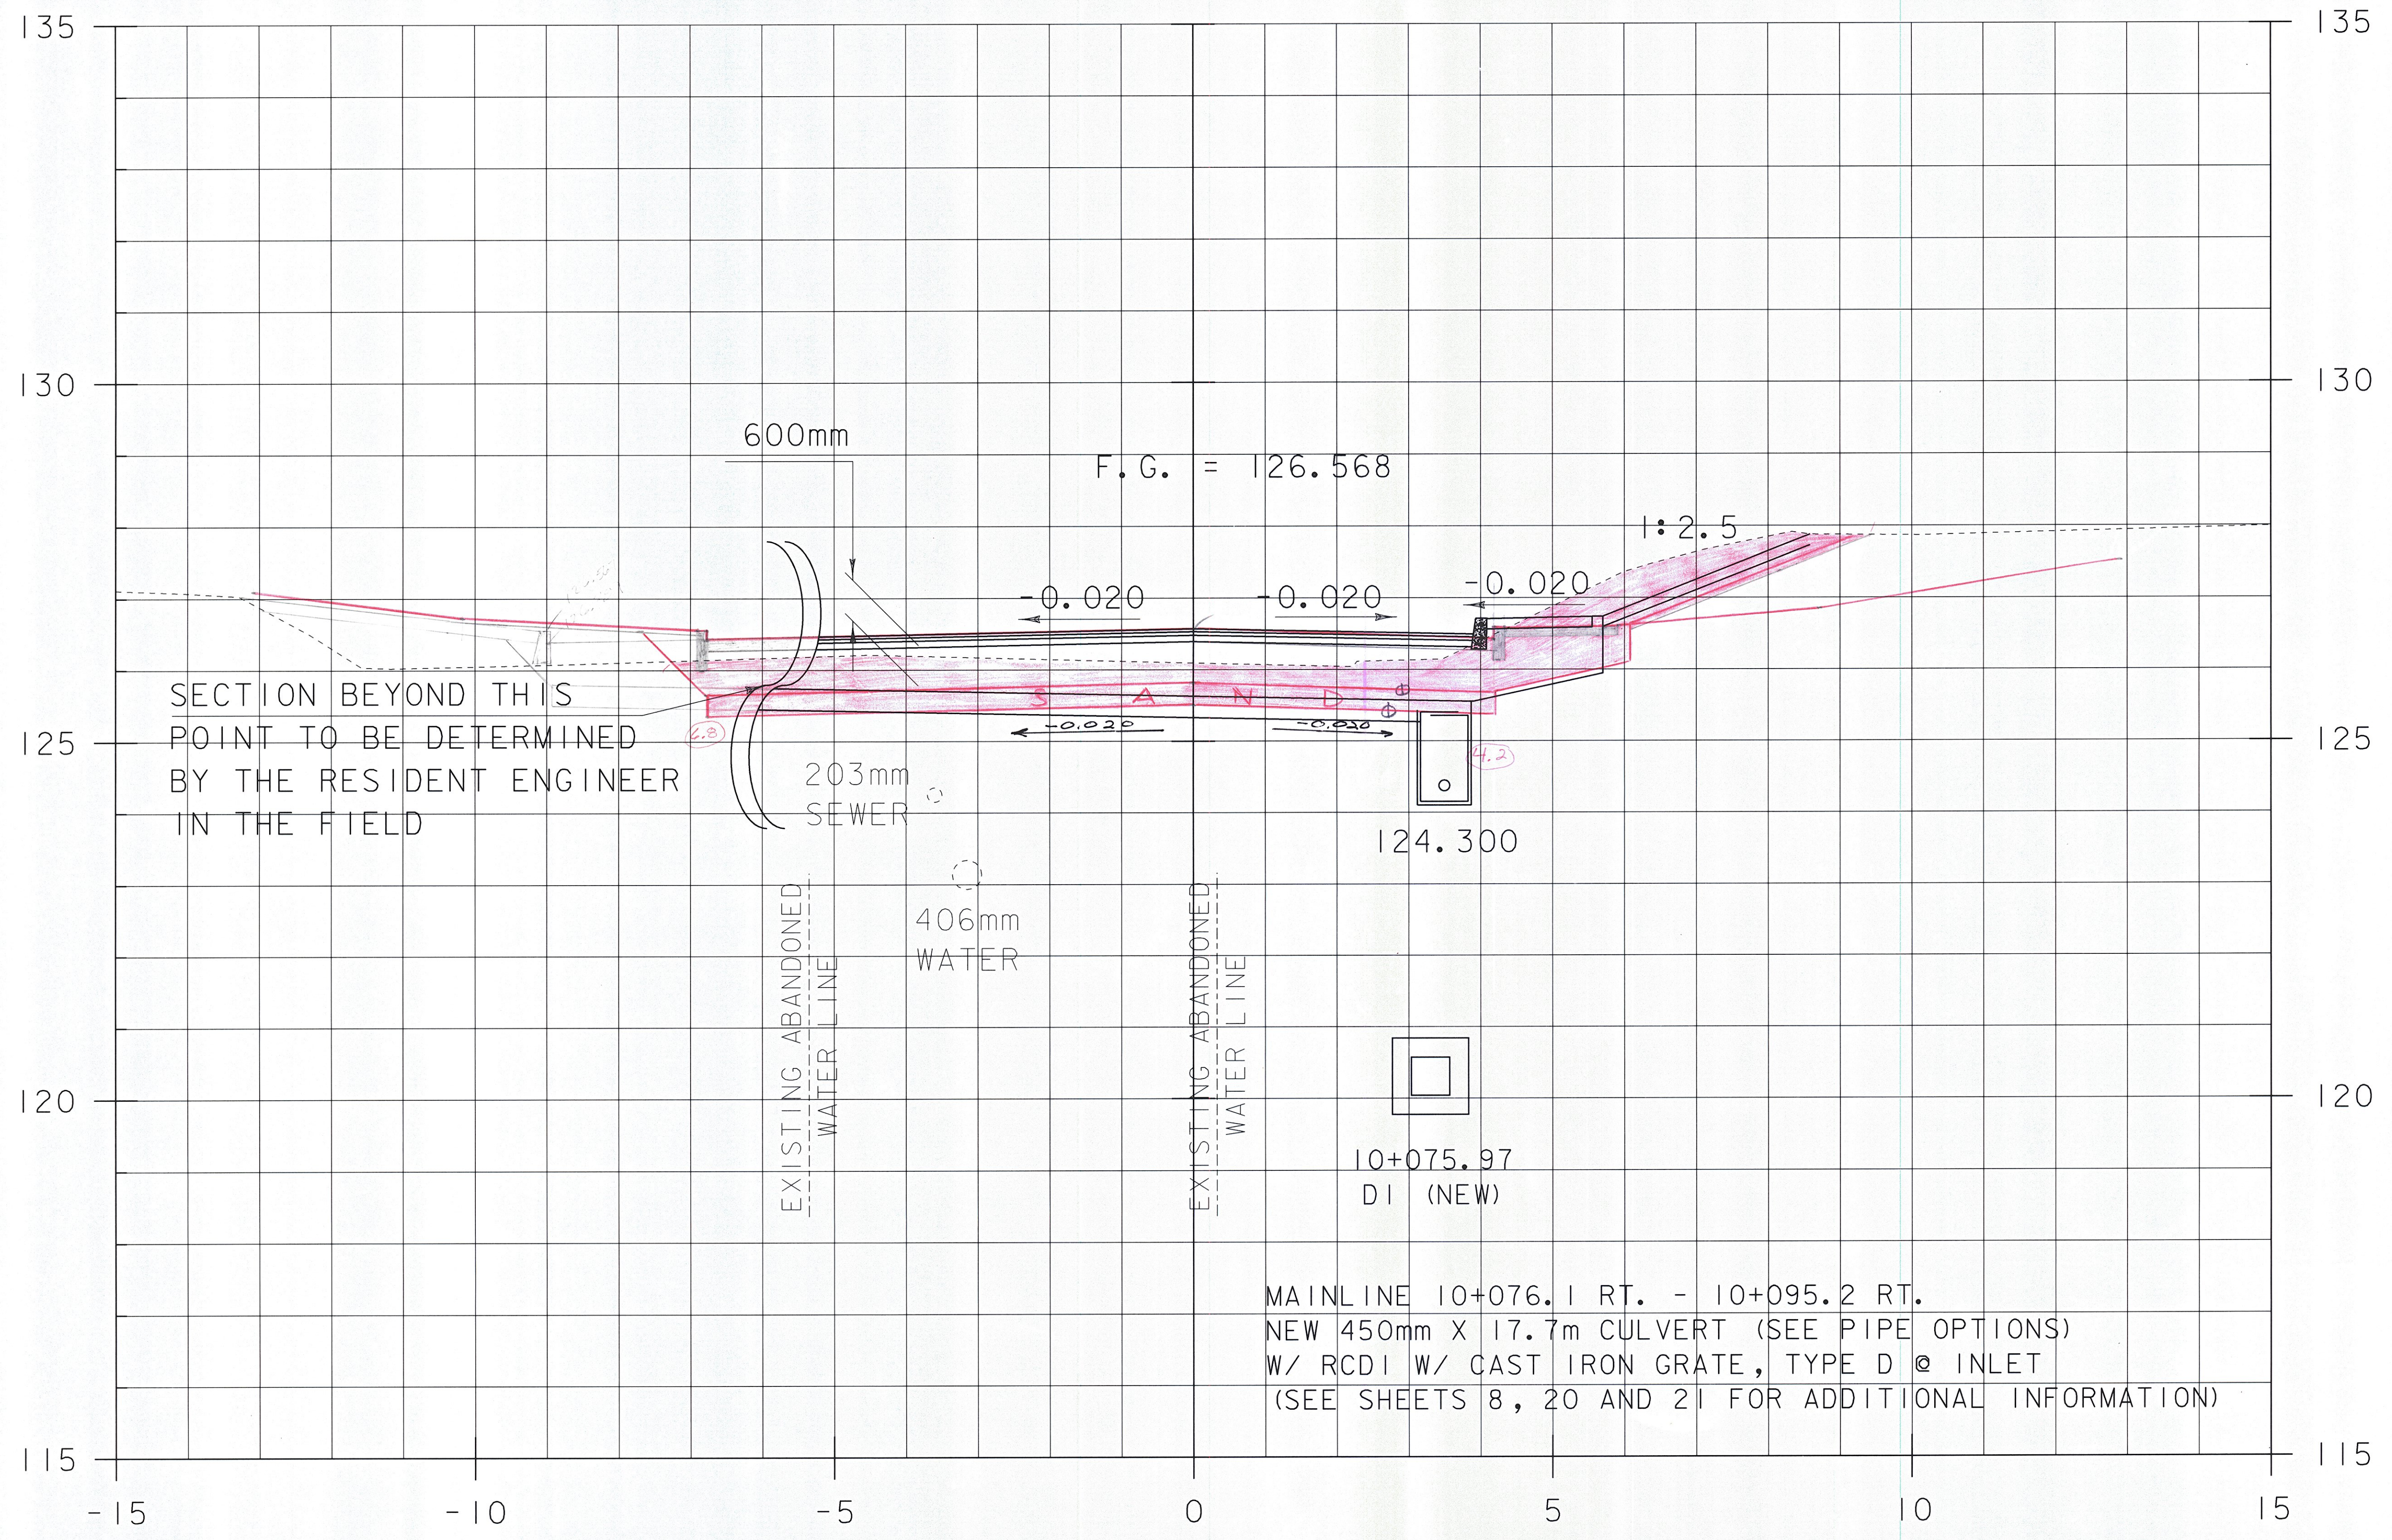


SECTION BEYOND THIS POINT TO BE DETERMINED BY THE RESIDENT ENGINEER IN THE FIELD

STA. 10+078.900 LT
 END CONCRETE CURB

10+075.00
 Sand - 1st Full Depth

MAINLINE 10+076.1 RT. - 10+095.2 RT.
 NEW 450mm X 17.7m CULVERT (SEE PIPE OPTIONS)
 W/ RCDI W/ CAST IRON GRATE, TYPE D @ INLET
 (SEE SHEETS 8, 20 AND 21 FOR ADDITIONAL INFORMATION)

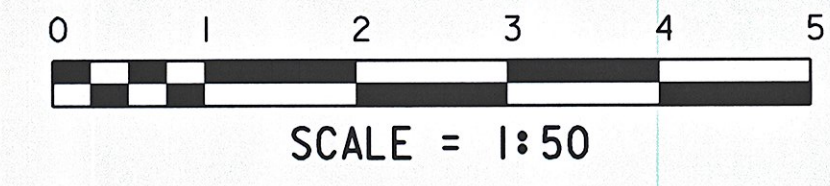

STA. 10+075 TO STA. 10+075

PROJECT NAME:	BRATTLEBORRO	PLOT DATE:	16-FEB-2010
PROJECT NUMBER:	BRF 2000(2)S	DRAWN BY:	C. MOONEY
FILE NAME:	96J228/s+tr/sj228xs_const.dgn	CHECKED BY:	C. CARLSON
PROJECT LEADER:	C. CARLSON	SHEET	14 OF 33
DESIGNED BY:	D. PETERSON		
ML X-SECTION 14 - (MOD.)			