



Common 2.96=7.4 ✓
 Gravel 3.28=8.2 ✓
 Sand 0.15*(3.9+4.2)= 1.2 ✓
 PRW 10-13-10

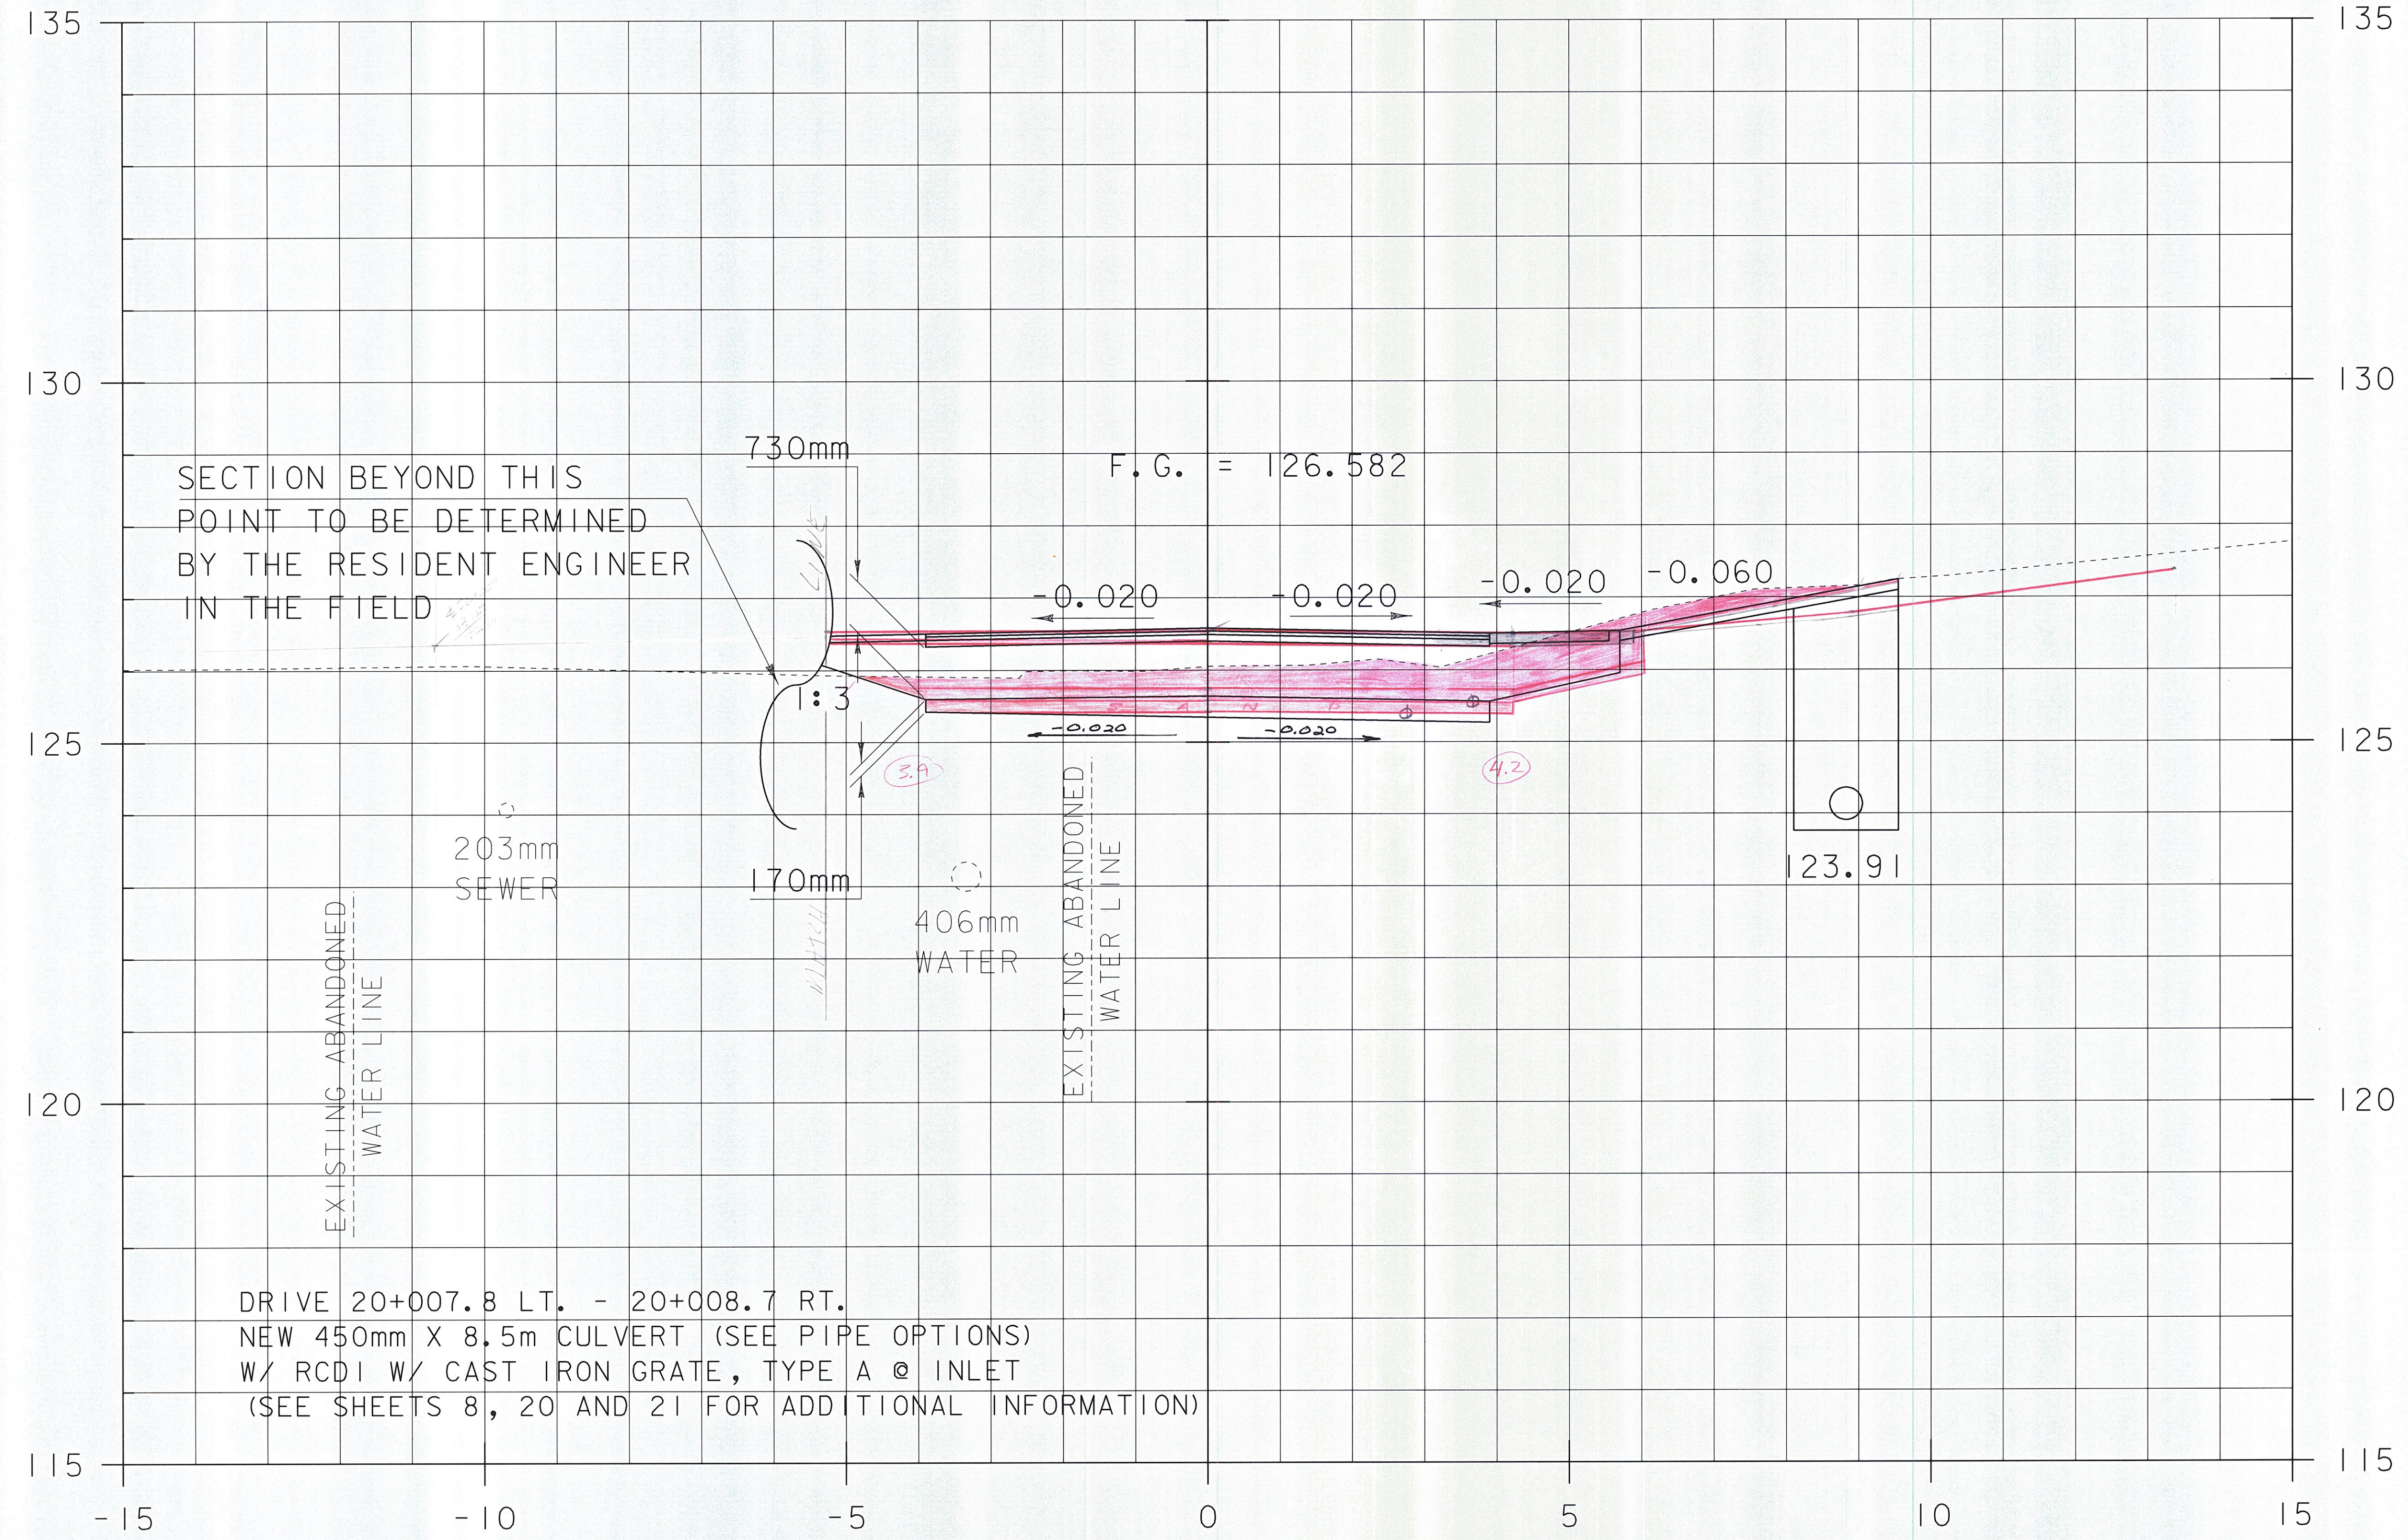

10+080.00

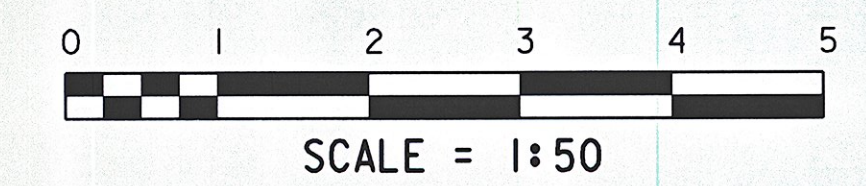

STA. 10+080 TO STA. 10+080

PROJECT NAME:	BRATTLEBORO	FILE NAME:	96J228/str/sj228xs_const.dgn	PLOT DATE:	16-FEB-2010
PROJECT NUMBER:	BRF 2000(2)S	PROJECT LEADER:	C. CARLSON	DRAWN BY:	C. MOONEY
		DESIGNED BY:	D. PETERSON	CHECKED BY:	C. CARLSON
		ML X-SECTION 15 - (MOD.)		SHEET	15 OF 33