


Common 0'
 Gravel (back) $\frac{373}{336} = 8.4$ 9.3 for 10/13
 (ahead) $249 = 6.2$
 Sand = 0'
 ✓ RRW 10-13-10

$\frac{1180}{.865} = 1045$
 $\frac{126.60}{-1.05} = 125.55$
 $\frac{126.00}{0.38} = 331.58$
 $\frac{126.22}{-0.09} = 126.13$

10+085.00 (use for 10+085.75)
 Zero Sand Barred
 Begin Approach Slab Head

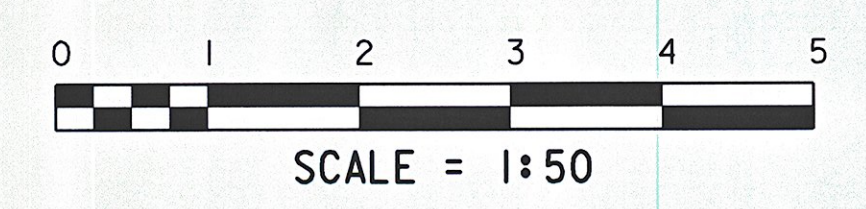

STA. 10+085 TO STA. 10+085

PROJECT NAME:	BRATTLEBORRO
PROJECT NUMBER:	BRF 2000(2)S
FILE NAME: 96J228/str/sj228xs_const.dgn	PLOT DATE: 16-FEB-2010
PROJECT LEADER: C. CARLSON	DRAWN BY: C. MOONEY
DESIGNED BY: D. PETERSON	CHECKED BY: C. CARLSON
ML X-SECTION 16 - (MOD.)	SHEET 16 OF 33