



Common 0/ ✓  
 Gravel 469 (BSA) = 12.2' for 10/11/10  
 (plus 10-13-10)

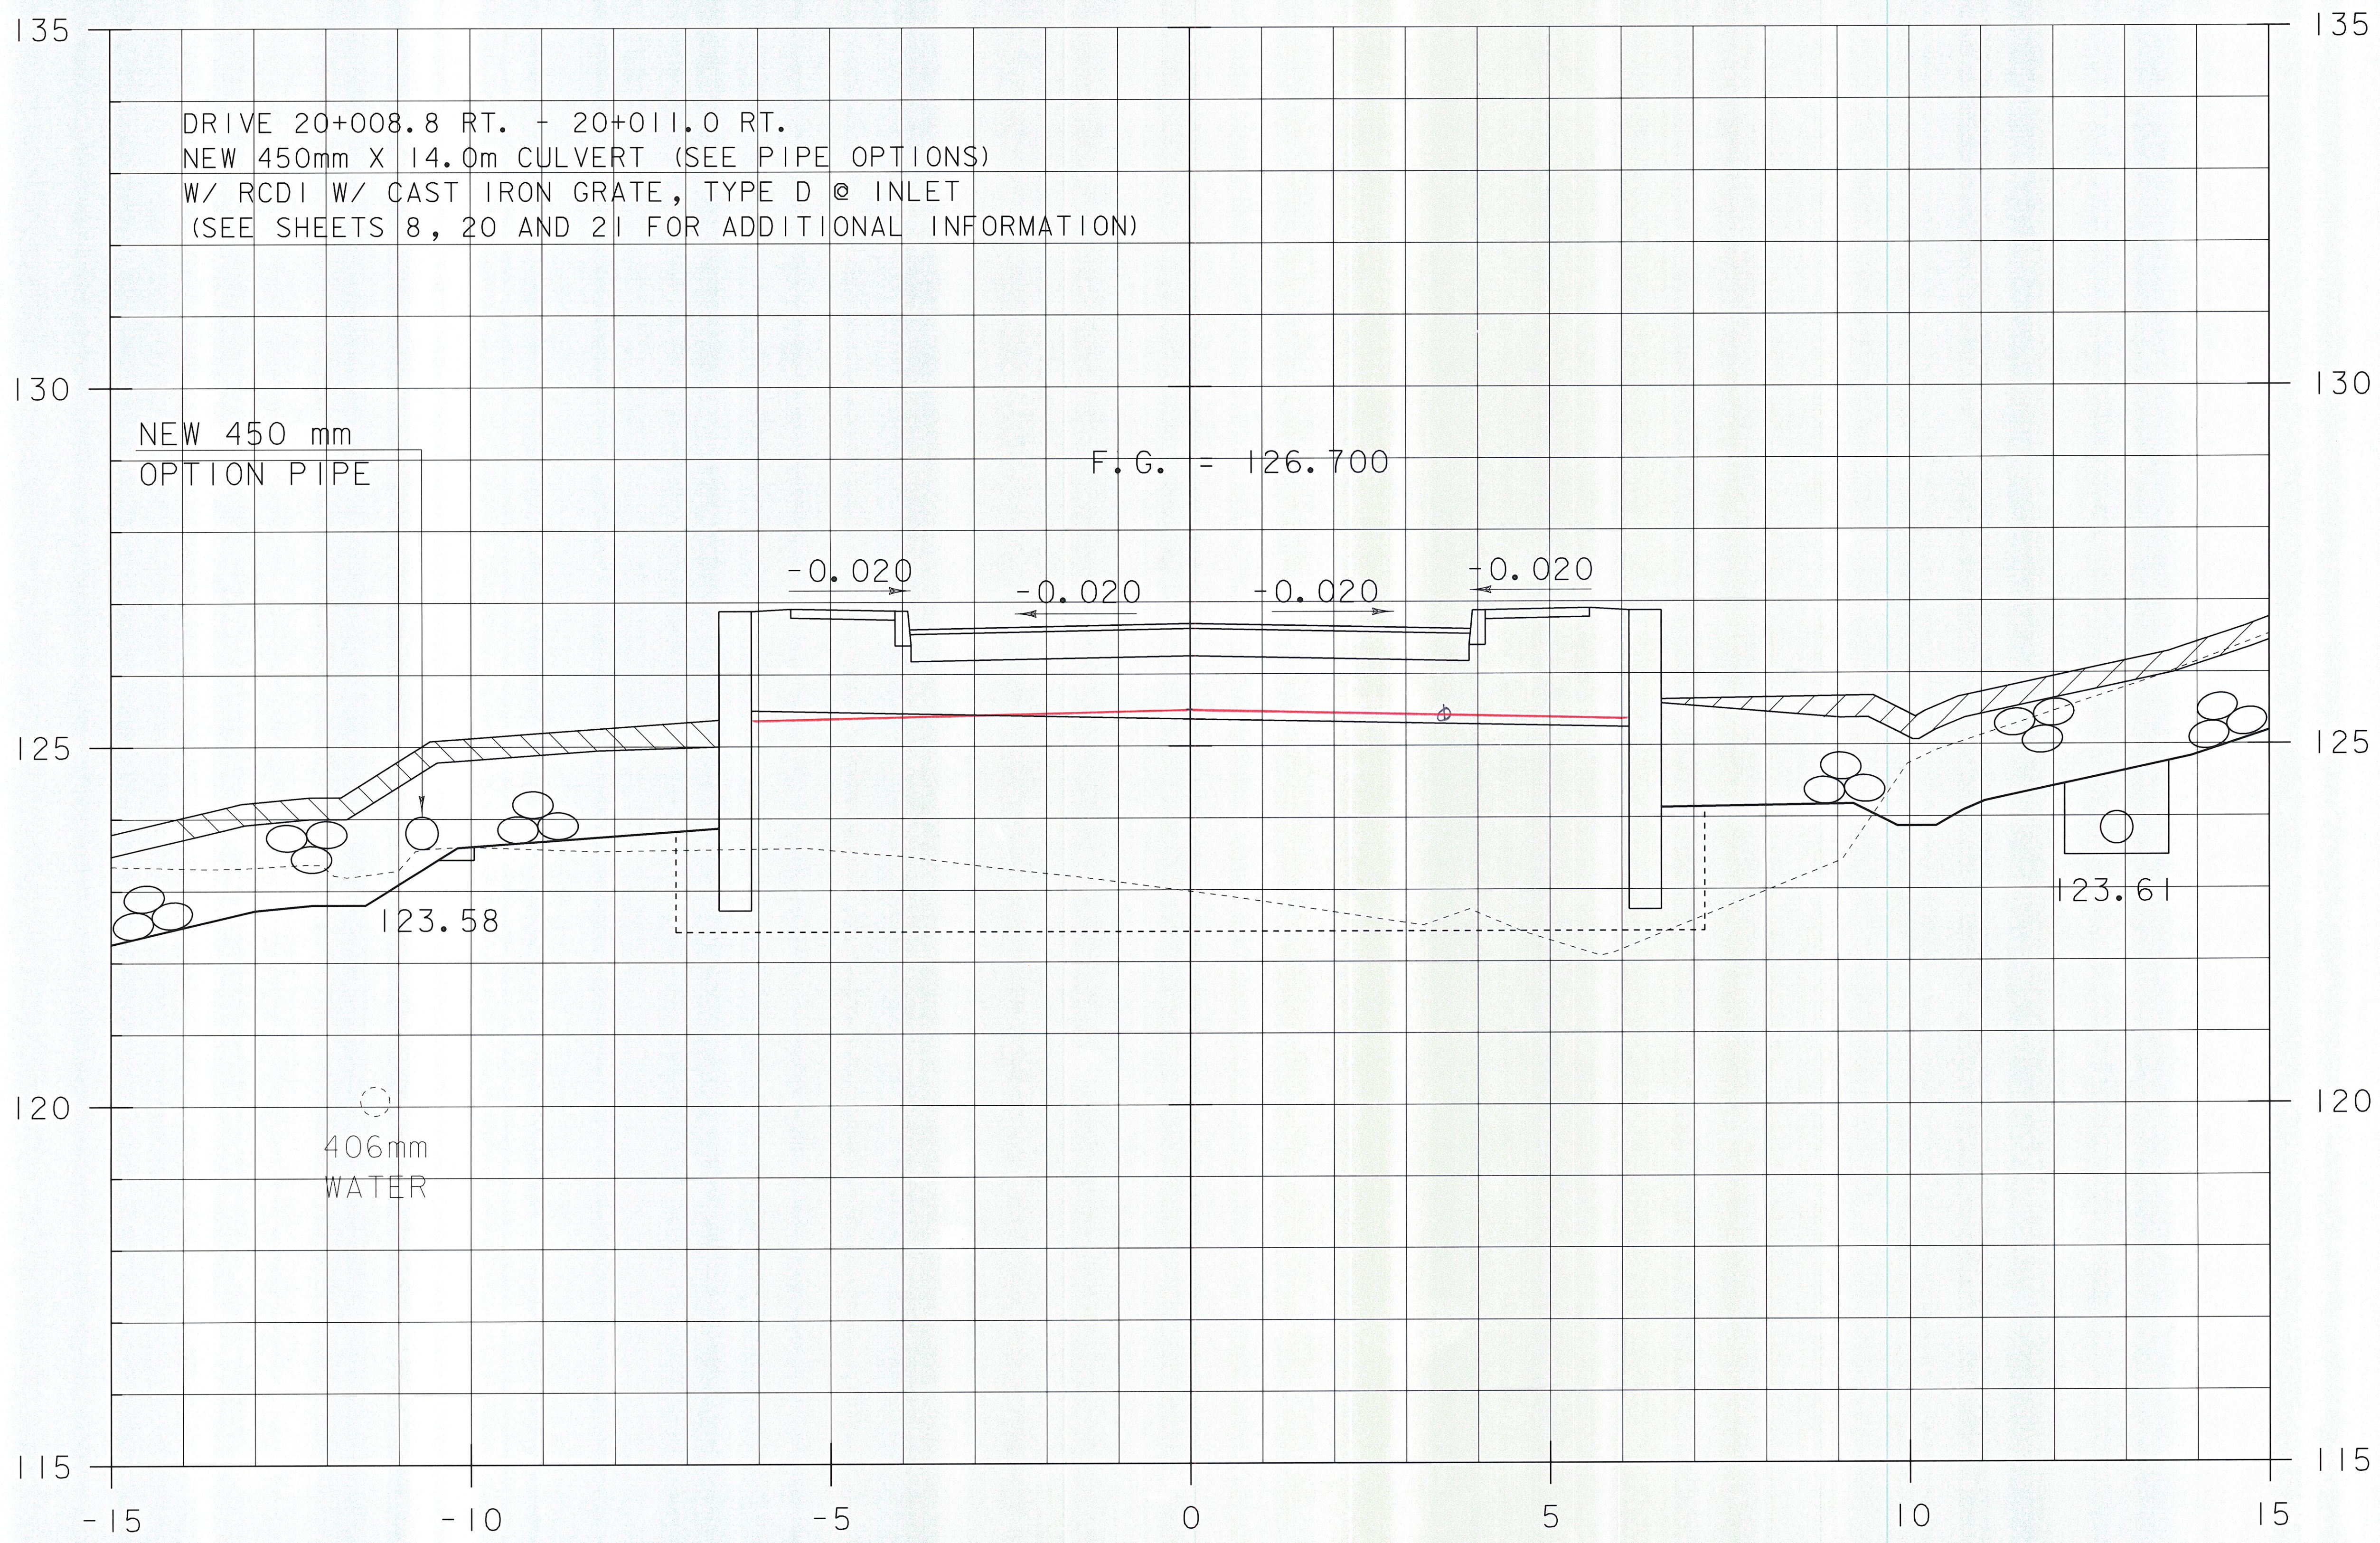

10+090.00 use for 10+091.05

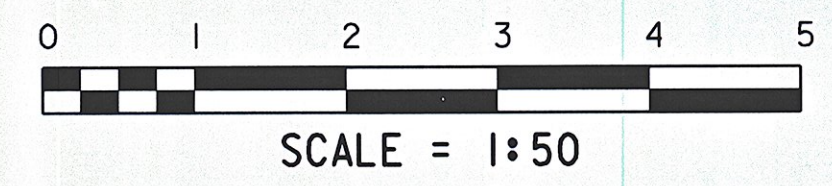

STA. 10+090 TO STA. 10+090

|                          |                              |
|--------------------------|------------------------------|
| PROJECT NAME:            | BRATTLEBORO                  |
| PROJECT NUMBER:          | BRF 2000(2)S                 |
| FILE NAME:               | 96J228/str/sj228xs_const.dgn |
| PROJECT LEADER:          | C. CARLSON                   |
| DESIGNED BY:             | D. PETERSON                  |
| ML X-SECTION 17 - (MOD.) |                              |
| PLOT DATE:               | 16-FEB-2010                  |
| DRAWN BY:                | C. MOONEY                    |
| CHECKED BY:              | C. CARLSON                   |
| SHEET                    | 17 OF 33                     |