



Common ✓  
 Gravel (B.H) 473' = 11.8 ✓  
 Sand ✓  
 ✓ 8/20/10-14-10

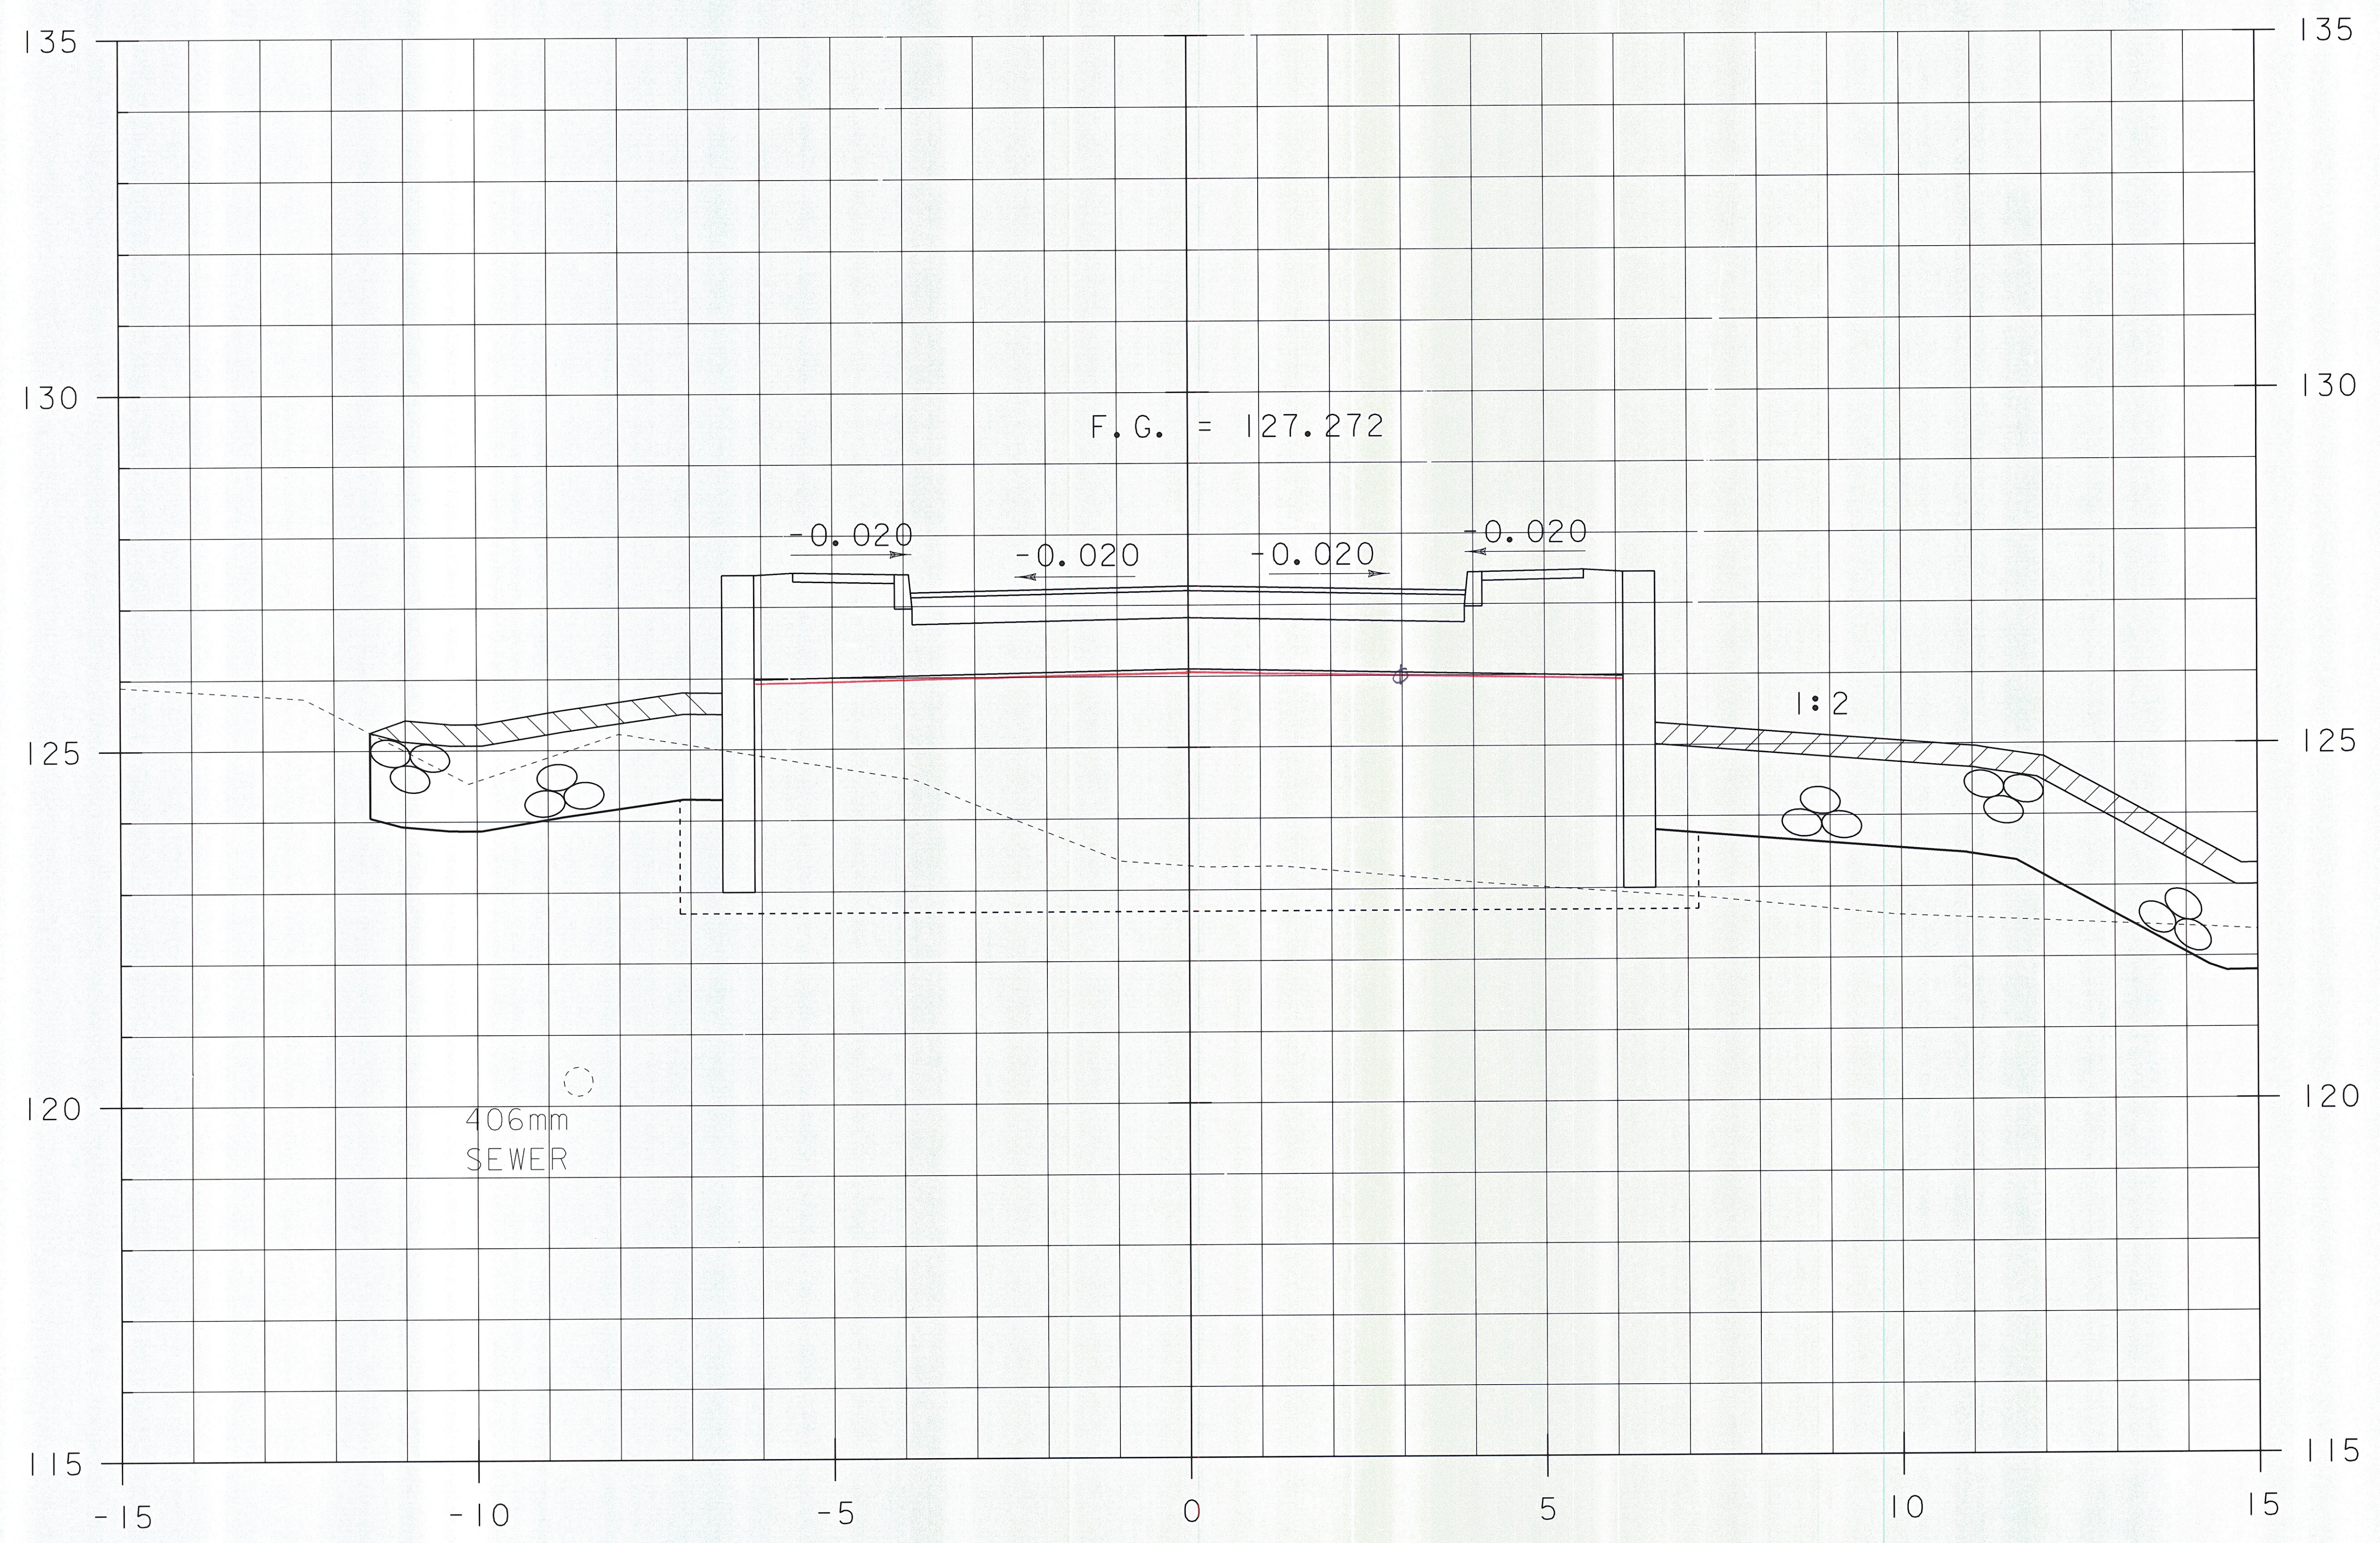

10+120.00 use for 10+119.45

STA. 10+119.250  
 END BRIDGE

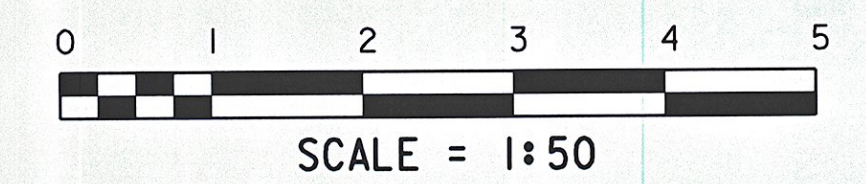

STA. 10+120 TO STA. 10+120

PROJECT NAME:	BRATTLEBORRO	FILE NAME:	96J228/str/sj228xs_const.dgn	PLOT DATE:	16-FEB-2010
PROJECT NUMBER:	BRF 2000(2)S	PROJECT LEADER:	C. CARLSON	DRAWN BY:	C. MOONEY
		DESIGNED BY:	D. PETERSON	CHECKED BY:	C. CARLSON
		ML X-SECTION 18 - (MOD.)		SHEET	18 OF 33