


Common 105' = 2.6
 Grave 1 (back) 306' = 7.7
 (ahead) 390' = 9.8
 sand 0
 10-14-10

MAINLINE 10+126.00 LT. - 10+126.00 RT.
 NEW 450mm X 6.90m CULVERT (SEE PIPE OPTIONS)
 W/ RCDI W/ CAST IRON GRATE, TYPE D @ INLET
 (SEE SHEETS 8, 20 AND 21 FOR ADDITIONAL INFORMATION)

MAINLINE 10+126.00 RT. - 10+120.24 RT.
 NEW 450mm X 9.30m CULVERT (SEE PIPE OPTIONS)
 W/ RCDI W/ CAST IRON GRATE, TYPE D @ INLET
 (SEE SHEETS 8, 20 AND 21 FOR ADDITIONAL INFORMATION)

10+125.00 use for 10+124.75
 end Approach Slab Back
 Begin Sand Barrow

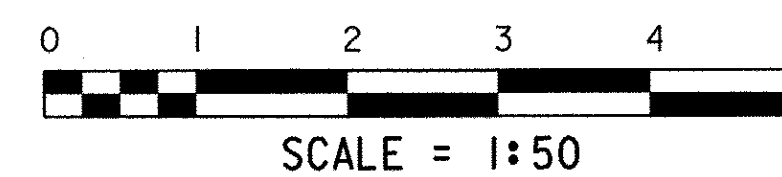

STA. 10+125 TO STA. 10+125

PROJECT NAME:	BRATTLEBORRO	PLOT DATE:	16-FEB-2010
PROJECT NUMBER:	BRF 2000(2)S	DRAWN BY:	C. MOONEY
FILE NAME:	96J228/str/sj228xs_const.dgn	DESIGNED BY:	D. PETERSON
		CHECKED BY:	C. CARLSON
		ML X-SECTION 19 - (MOD.)	SHEET 19 OF 33